



VILLAGE OF BEAVER SANITATION IMPROVEMENTS BATHROOM UPGRADES

MAY 2006

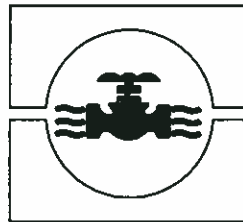

In Cooperation with the State of Alaska
Department of Environmental Conservation
VILLAGE SAFE WATER PROGRAM
U.S. Department of Agriculture, Rural
Economic and Community Development

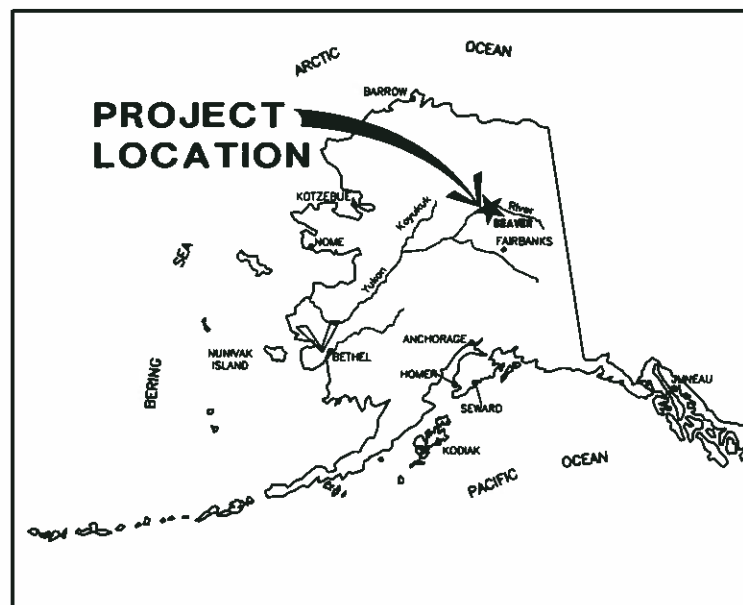

Location Map

Project Number (Consultant)	9966 (VSW) 16306
VSW Project Engineer	ROGER BURLEIGH
Onsite Construction Manager	BRIAN ROE / SHAWN TAYLOR
Final Design (Date)	MAY 2006
ADEC Approval (Date)	N/A
Construction Period (From) (To)	4/12/05 10/31/08
As-Built (Date)	2/13/09



Consultant

Status:
RECORD DRAWINGS

Date:
FEBRUARY 2009


Project Status

SHEET INDEX

DWG. NO.	TITLE
GENERAL	
G1	COVER SHEET
G2	GENERAL NOTES, LEGEND & ABBREVIATIONS
G3	GENERAL LAYOUT
G4	SCHEMATIC AND EQUIPMENT SCHEDULE
CIVIL	
C1	SEWAGE HOLDING TANK LAYOUT AND SECTIONS
C2	SEWAGE HOLDING TANK DETAILS
C3	DETAILS
C4	INTERIOR ADDITION PLAN AND ELEVATIONS
C5	EXTERIOR ADDITION PLAN AND ELEVATIONS
C6	INTERIOR HUD ADDITION PLAN AND ELEVATIONS
C7	BUILDING 2 & BUILDING 5
C8	BUILDING 7 & BUILDING 9
C9	BUILDING 11 & BUILDING 12
C10	BUILDING 13 & BUILDING 15
C11	BUILDING 17 & BUILDING 20
C12	BUILDING 22 & BUILDING 23
C13	BUILDING 25 & BUILDING 26
C14	BUILDING 27 & BUILDING 28
C15	BUILDING 32 & BUILDING 37
C16	BUILDING 47 & BUILDING 58
C17	BUILDING 66 & BUILDING 67
C18	BUILDING 69 & ANN FISHER
C19	BARBARA SOLARI 4 & CHARLOTTE CRUIKSHANK
C20	CHARLIE YATLIN 51
ELECTRICAL	
E1	INTERIOR BATHROOM ADDITION ELECTRICAL PLAN
E2	TYPICAL BATHROOM ADDITION ELECTRICAL PLANS
E3	HOUSE STATUS PANEL LAYOUT AND SCHEMATIC

EP1 PUNCH LIST & GENERAL NOTES
EP2 BUILDING 2 & BUILDING 4
EP3 BUILDING 5 & BUILDING 7
EP4 BUILDING 9 & BUILDING 11
EP5 BUILDING 12 & BUILDING 13
EP6 BUILDING 15 & BUILDING 17
EP7 BUILDING 20 & BUILDING 22
EP8 BUILDING 23 & BUILDING 24
EP9 BUILDING 25 & BUILDING 26
EP10 BUILDING 27 & BUILDING 28
EP11 BUILDING 32 & BUILDING 37
EP12 BUILDING 51 & BUILDING 58
EP13 BUILDING 66 & BUILDING 67
EP14 BUILDING 69 & BUILDING 70
EP15 BUILDING 71

1 LEVEL CONTROLS (CONTROL CRAFT ATTACHMENT)

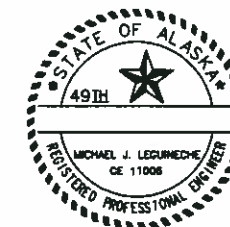

RECORD DRAWING CERTIFICATE

THESE DRAWINGS REFLECT
RECORDED INFORMATION OBTAINED
DURING CONSTRUCTION.
INFORMATION PROVIDED HEREIN
IS ACCURATE TO THE BEST OF
MY KNOWLEDGE.

M. Leguineche 2/09
NAME DATE

ABBREVIATIONS

ALUM	ALUMINUM
AWH	AUTOMATIC WATER HEATER
CAP	CORRUGATED ALUMINUM PIPE
CMP	CORRUGATED METAL PIPE
CO	CLEANOUT
CW	COLD WATER
DIA	DIAMETER
DWG	DRAWING
E	EAST
EL	ELEVATION
FLG	FLANGE
FT	FEET, FOOT
GA	GAGE
GALV	GALVANIZED
HB	HOSE BIB
HDPE	HIGH DENSITY POLYETHYLENE
HGR	HEATED GLYCOL RETURN
HGS	HEATED GLYCOL SUPPLY
HW	HOT WATER
ID	INSIDE DIAMETER
INV	INVERT
LF	LINEAR FEET
MAX	MAXIMUM
MIN	MINIMUM
N	NORTH
N.C.	NORMALLY CLOSED
N.O.	NORMALLY OPEN
NO	NUMBER
OD	OUTSIDE DIAMETER
P	PROPERTY LINE
PT	PRESSURE TANK
REQ'D	REQUIRED
SIM	SIMILAR
S	SOUTH
STA	STATION
TYP	TYPICAL
TW	TREATED WATER
W	WEST

GENERAL NOTES

1. PRIOR TO STARTING CONSTRUCTION AT ANY SITE CONTRACTOR SHALL:

A. OBTAIN ALL REQUIRED SIGNATURES ON HOMEOWNER AGREEMENT FORMS.


B. FIELD VERIFY THE FLOOR PLANS SHOWN ON THESE DRAWINGS AND ADVISE THE ENGINEER IF CHANGES ARE REQUIRED.

C. FIELD VERIFY THE SUITABILITY OF THE PROPOSED LOCATION FOR THE WATER AND SEWAGE HDLDING TANKS AND ADVISE THE ENGINEER IF CHANGES ARE REQUIRED.

D. COORDINATE THE PROPOSED LOCATION OF ANY GRAVEL DRIVEWAYS WITH THE HOMEOWNER.
2. ALL CONSTRUCTION SHALL BE DONE IN A WORKMANLIKE MANNER, TO INDUSTRY STANDARDS AND IN CONFORMANCE WITH APPLICABLE LOCAL, STATE AND FEDERAL CODES AND REGULATIONS.
3. THE CONTRACTOR SHALL BE RESPONSIBLE FOR MAINTAINING A CLEAN SET OF DRAWINGS SHOWING AS-BUILT INFORMATION. DRAWINGS SHALL BE KEPT CURRENT IN RED PENCIL ON A DAILY BASIS IN A NEAT, LEGIBLE FASHION. AS-BUILT DRAWINGS AND MANUFACTURER'S LITERATURE FROM INSTALLED EQUIPMENT SHALL BE GIVEN TO THE ENGINEER AT THE END OF THE PROJECT.
4. DISINFECT THE POTABLE WATER SYSTEM AFTER CONSTRUCTION AND PRIOR TO USE. FILL THE WATER HOLDING TANK WITH 100 GALLONS OF POTABLE WATER. ACTIVATE THE PRESSURE SYSTEM AND CHARGE THE WATER SYSTEM COMPONENTS. ADD 25 FLUID OUNCES OF CHLORINE BLEACH (5.25% AVAILABLE CHLORINE) TO THE WATER STORAGE TANK AND MIX WITH A CLEAN PADDLE. OPEN ALL TAPS AND FLUSH THE TOILET UNTIL THE CHLORINE SOLUTION IS PRESENT AT ALL PORTALS. CLOSE TAPS AND ALLOW THE CHLORINE SOLUTION TO CONTACT ALL INTERIOR SURFACES OF THE POTABLE WATER SYSTEM FOR A MINIMUM OF 3 HOURS. AT THE END OF THE CONTACT PERIOD DRAW APPROXIMATELY 1 QUART OF WATER FROM THE COLD WATER TAP AT THE LAVATORY AND DISCARD. TEST THE NEXT 2 OUNCE DRAW FROM THE COLD WATER TAP TO CONFIRM THAT AT LEAST 50 mg/L OF FREE CHLORINE RESIDUAL REMAINS AFTER THE 3 HOURS OF CONTACT. IF LESS THAN 50 mg/L OF FREE CHLORINE RESIDUAL REMAINS, REPEAT THE PREVIOUS STEPS UNTIL 50 mg/L REMAINS. AFTER THE COMPLETION OF THE TEST DISCHARGE ALL REMAINING WATER IN THE STORAGE TANK. RECHARGE THE STORAGE TANK WITH POTABLE WATER AND FLUSH TOILET AND OPEN PORTALS UNTIL A CHLORINE ODOR IS NO LONGER DETECTED AT EACH PORTAL. THE SYSTEM IS NOW READY FOR USE.
5. SECURE WATER TANKS WITH EARTHQUAKE STRAPS TO PROHIBIT MOVEMENT.
6. SEWAGE TANK PITS SHALL BE TEMPORARILY FENCED WHILE OPEN DURING CONSTRUCTION.

LEGEND

	BALL VALVE
	CHECK VALVE
	DIELECTRIC UNION
	REDUCER
	HOT WATER
	COLD WATER
	WATER LINE
	SEWER LINE
	WATER FILL LINE
	WATER OVER FLOW LINE
	EDGE OF GRAVEL
	TRAIL
	UTILITY POLE
	ITEM TO BE DEMOLISHED
	NEW WALL OR DOOR
	HOUSE TO RECEIVE BATHROOM UPGRADE
	VEGETATION
	BOLLARD
	HOT WATER HEATER
	ELECTRIC SERVICE

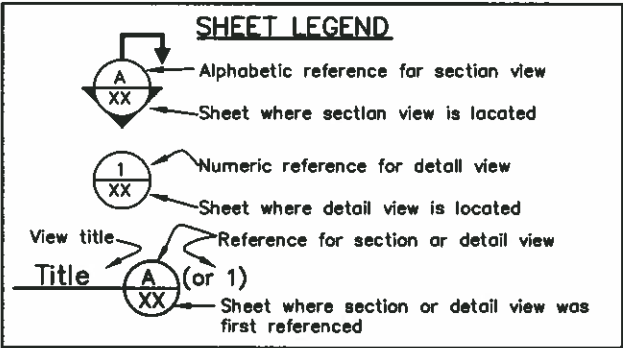

RECORD DRAWING CERTIFICATE

THESE DRAWINGS REFLECT RECORDED INFORMATION OBTAINED DURING CONSTRUCTION. INFORMATION PROVIDED HEREIN IS ACCURATE TO THE BEST OF MY KNOWLEDGE.

Michael Lezine
NAME
2/09
DATE

VILLAGE OF BEAVER

SANITATION IMPROVEMENTS

BATHROOM UPGRADES

GENERAL NOTES, LEGEND & ABBREVIATIONS

REVISION	BY	DATE


Project No.	Date	Designed	Drawn	Approved
	MAY 2006	M.L.	M.L.	M.L.

Sheet No.
SHEET G2 of G4

HOUSEHOLDS TO RECEIVE SERVICE										
BLDG	OWNER	TYPE	TOILET	SINK	TUB	SHOWER	WATER HEATER	WATER TANK	SEWAGE TANK	KITCHEN SINK
2	David Hope	A	X	X				X	X	
5	Paul Williams SR.	A	X	X				X	X	
7	Wilma Pitka	C	X	X				X	X	X
9	James Hope	B	X	X				X	X	X
11	Elsie Pitka	C	X	X		X	X	X	X	X
12	Mary Sam	C	X	X	X		X	X	X	X
13	George Yatlin	C	X	X	X		X	X	X	
15	Selina Petruska	A	X	X		X	X	X	X	
17	Vivian Jureaby	A	X	X		X	X	X	X	
20	Anna Joseph	A	X	X		X	X	X	X	
22	Hannah Adams	A	X	X		X	X	X	X	
23	Alvin Winer	C	X	X		X	X	X	X	X
24	William Henry	B	X	X		X	X	X	X	X
25	Nora Billy	B	X	X	X		X	X	X	X
26	Roy Henry	B	X	X		X	X	X	X	
27	Heather Joseph	C	X	X	X		X	X	X	X
28	Sam Joseph	C	X	X	X		X	X	X	X
32	Jennie Pitka	C	X	X		X	X	X	X	X
37	Charleen Fisher	B	X	X	X		X	X	X	
47	Clifford Adams	B	X	X		X	X	X	X	
51	Charlie Yatlin	?	X	X	X		X	X	X	X
58	Thomas Adams	C	X	X	X		X	X	X	
66	Michael Williams	A	X	X		X	X	X	X	
67	Birdie Billy	A	X	X		X	X	X	X	
69	Dorthea Adams	C	X	X	X		X	X	X	
UN	Ann Fisher	B	X	X	X		X	X	X	X
4	Barbara Solari	C	X	X	X		X	X	X	X
UN	Charlotte Cruikshank	?	X	X	X		X	X	X	X
70	Arthur Henry Jr.	?	X	X	X		X	X	X	X
Total Bathroom Fixtures			27	27	12	12	24	27	27	13
			23	23	9		21	23	24	11


35 BUILDING NUMBER
 UN UN-NUMBERED BUILDING
 EXISTING BUILDINGS
 BUILDINGS TO RECEIVE SERVICE

A INSIDE REMODEL - HUD HOME
B INSIDE REMODEL - NON HUD HOME
C OUTSIDE ADDITION

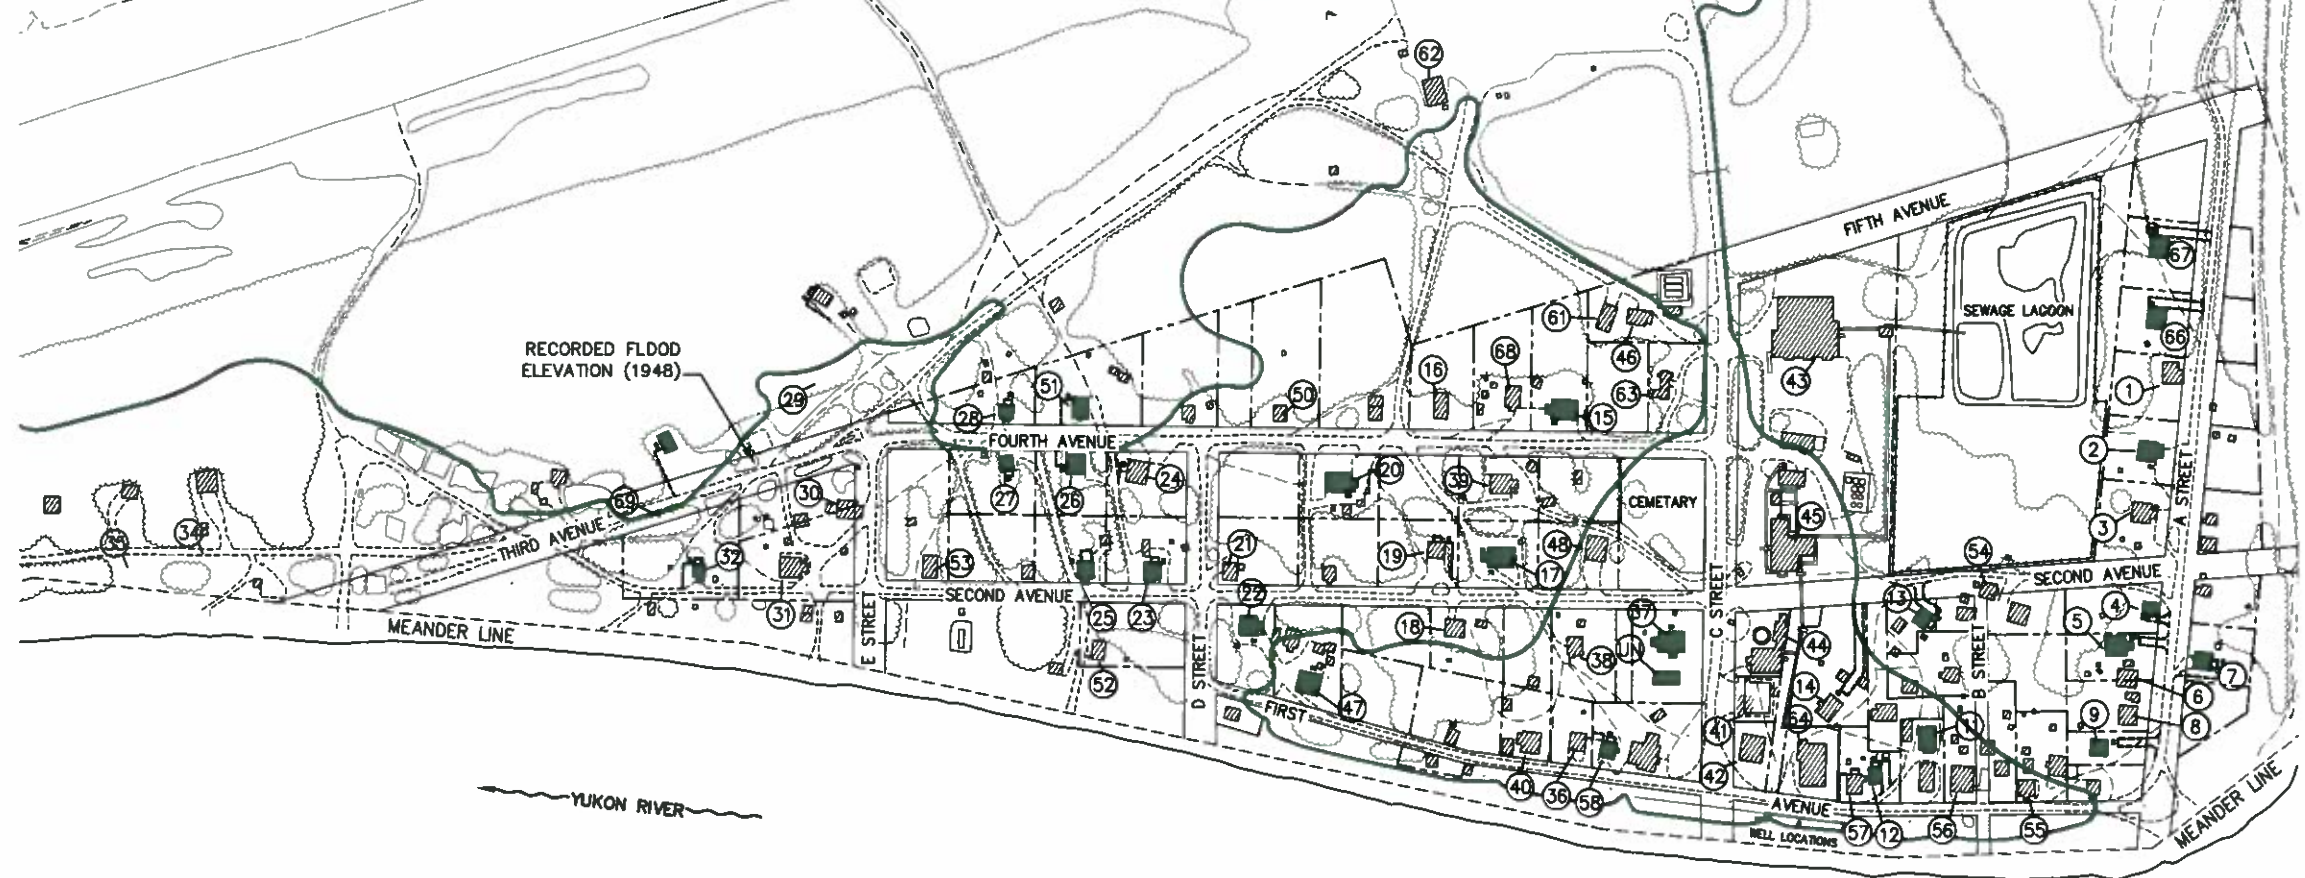

No.

 G3 OF G4

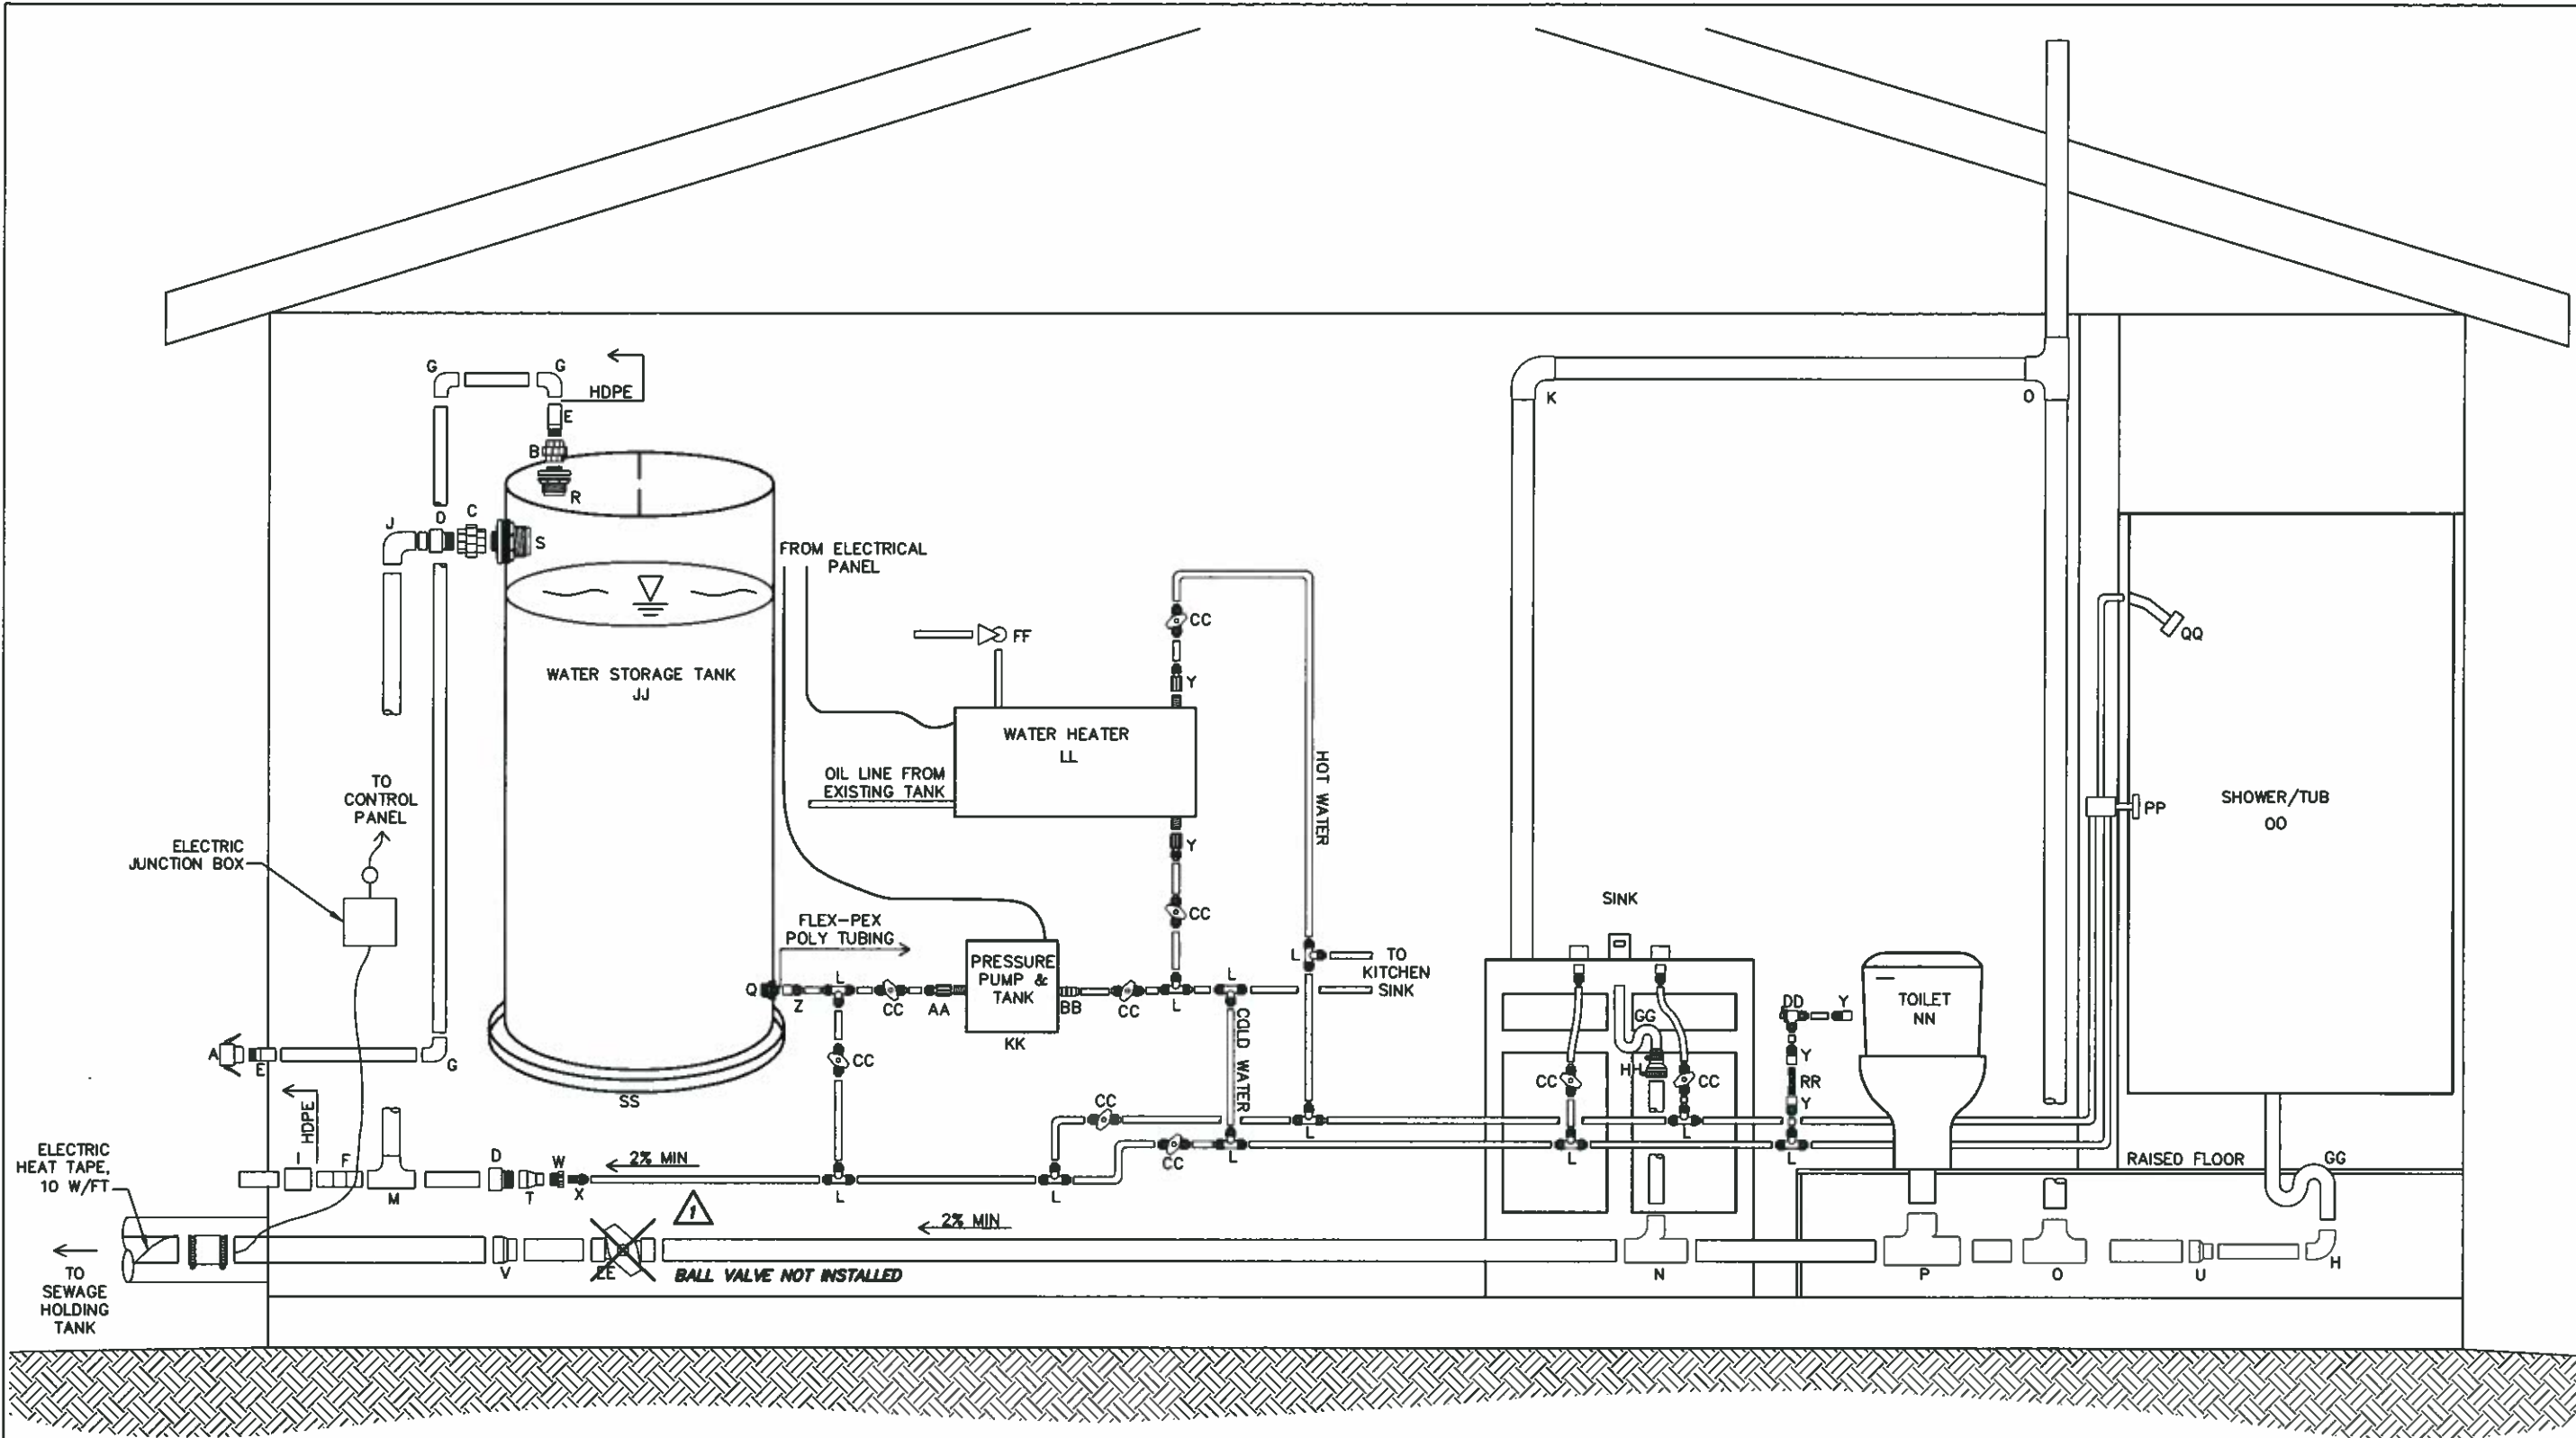

EQUIPMENT SCHEDULE

- A. ALUMINUM KAMLOCK ADAPTER: 1 1/2" FKAM X 1 1/2" MPT
- B. 1 1/2" SCH. 80 PVC UNION
- C. 3" SCH. 80 PVC UNION
- D. 3" SCH. 80 PVC MALE PIPE ADAPTER
- E. 1 1/2" POLY-CAM TRANSITION FITTING: PART NO. 710-0150-S6
- F. 3" POLY-CAM TRANSITION FITTING: PART NO. 730-0300/80-S6
- G. 1 1/2" HDPE ELECTROFUSION 90° EL
- H. 2" ABS 90° EL
- I. 3" HDPE ELECTROFUSION COUPLING
- J. 3" SCH. 80 PVC 90° EL
- K. 3" ABS 90° EL
- L. TEE: FLAIR-IT, PART NO. 07820 (1/2" P x 1/2" P x 1/2" P)
- M. 3" SCH. 80 PVC TEE
- N. 3x3x2 ABS SANITARY TEE
- O. 3x3x3 ABS TEE
- P. 3x3x3 ABS SANITARY TEE
- Q. 3/4" SCH. 80 PVC BULKHEAD FITTING (3/4" EXTERNAL MPT)

- R. 1 1/2" SCH. 80 PVC BULKHEAD FITTING (1 1/2" EXTERNAL MPT)
- S. 3" SCH. 80 PVC BULKHEAD FITTING (3" EXTERNAL MPT)
- T. 3x2 THREADED REDUCER
- U. 3x2 ABS REDUCING COUPLING
- V. 4x3 ABS REDUCING COUPLING
- W. THREADED FITTING: 2" NPT OUTSIDE & 1/2" NPT INSIDE
- X. MALE PIPE ADAPTER: FLAIR-IT, PART NO. 07842 (1/2" P x 1/2" MPT)
- Y. FEMALE PIPE ADAPTER: FLAIR-IT, PART NO. 07841 (1/2" P x 1/2" MPT)
- Z. SWIVEL COUPLING: FLAIR-IT, PART NO. 08856 (1/2" P x 1/2" P)
- AA. FLOJET 1820-001 (3/8" PEX x PUMP PLUG IN PORT)
- BB. FLOJET 1820-003 (3/8" PEX x 3/8" NPT)
- CC. STRAIGHT STOP VALVE: FLAIR-IT, PART NO. 07800 (1/2" P x 1/2" P)
- DD. ANGLE STOP VALVE: FLAIR-IT, PART NO. 07805 (1/2" P x 1/2" P)
- EE. 3" ABS BALL VALVE
- FF. PVC SCH. 80 PRESSURE RELIEF VALVE (TERMINATE 6" ABOVE FLOOR)
- GG. P TRAP
- HH. DRAIN AND TRAP CONNECTOR

- II. 4"x4" 12" LONG KENAFLEX EPDM RUBBER HOSE AND 4 SS CLAMPS
- JJ. 200 GALLON, 31" X 68" HIGH, COVERED POLYETHYLENE VERTICAL STORAGE TANK WITH HINGED LID
- KK. FLOJET 2840-000 WATER PRESSURE SYSTEM
- LL. TOYOTOMI OIL MISER INSTANTANEOUS OIL-FIRED WATER HEATER (BS 36UFF)
- MM. 24" VANITY WITH ONE PEICE WHITE COUNTER TOP AND SINK
- NN. CAROMA CARAVELLE 270 (MODEL # 989760 WHITE)
- OO. TWO PEICE FIBERGLASS SHOWER OR THREE PEICE FIBERGLASS TUB
- PP. MIXING VALVE
- QQ. SHOWER HEAD
- RR. QUICKCHECK CHECK VALVE (1/2" MPT x 1/2" MPT)
- SS. 36" X 2" HIGH 24 GAUGE GALVANIZED STEEL DRIP PAN

NOTE:
ALL FLEX-PEX TUBING AND FLAIR-IT FITTINGS WERE SUBSTITUTED WITH AQUAPEX PARTS.

- NOTE:
- ALL FLEX-PEX TUBING SHALL BE 1/2" ID, SDR9 PEX-a B137.5 REINFORCED POLY-TUBING. USE TUBING WITH BLUE MARKINGS FOR ALL COLD WATER LINES, PART NO. 06063. USE TUBING WITH RED MARKINGS FOR ALL HOT WATER LINES, PART NO. 06163.
 - ALL HOPE PIPING SHALL BE SDR-11.
 - ALL STEEL FITTINGS SHALL BE 316 STAINLESS STEEL

RECORD DRAWING CERTIFICATE
THESE DRAWINGS REFLECT
RECORDED INFORMATION OBTAINED
DURING CONSTRUCTION.
INFORMATION PROVIDED HEREIN
IS ACCURATE TO THE BEST OF
MY KNOWLEDGE.
M. Layman 2/09
NAME DATE

STATE OF ALASKA
40 21
REGISTERED PROFESSIONAL ENGINEER
CE 11008

VILLAGE SAFE WATER

STATE OF ALASKA
40 21
REGISTERED PROFESSIONAL ENGINEER
CE 11008
MICHAEL LUDWIG
REGISTERED PROFESSIONAL


CRW
ENGINEERING GROUP LLC
3000 ARCTIC BLVD, SUITE 203
ANCHORAGE, ALASKA 99503
PHONE: (907) 582-3222
FAX: (907) 581-2273

VILLAGE OF BEAVER
SANITATION IMPROVEMENTS
BATHROOM UPGRADES
SCHEMATIC & EQUIPMENT
SCHEDULE


BY DATE
REVISION
AS-BUILT
1
2/09

Project No. 9966
Date MAY 2006
Designed MLL
Drawn MLL
Approved DSY



Sheet No.
SHEET G4 OF G4

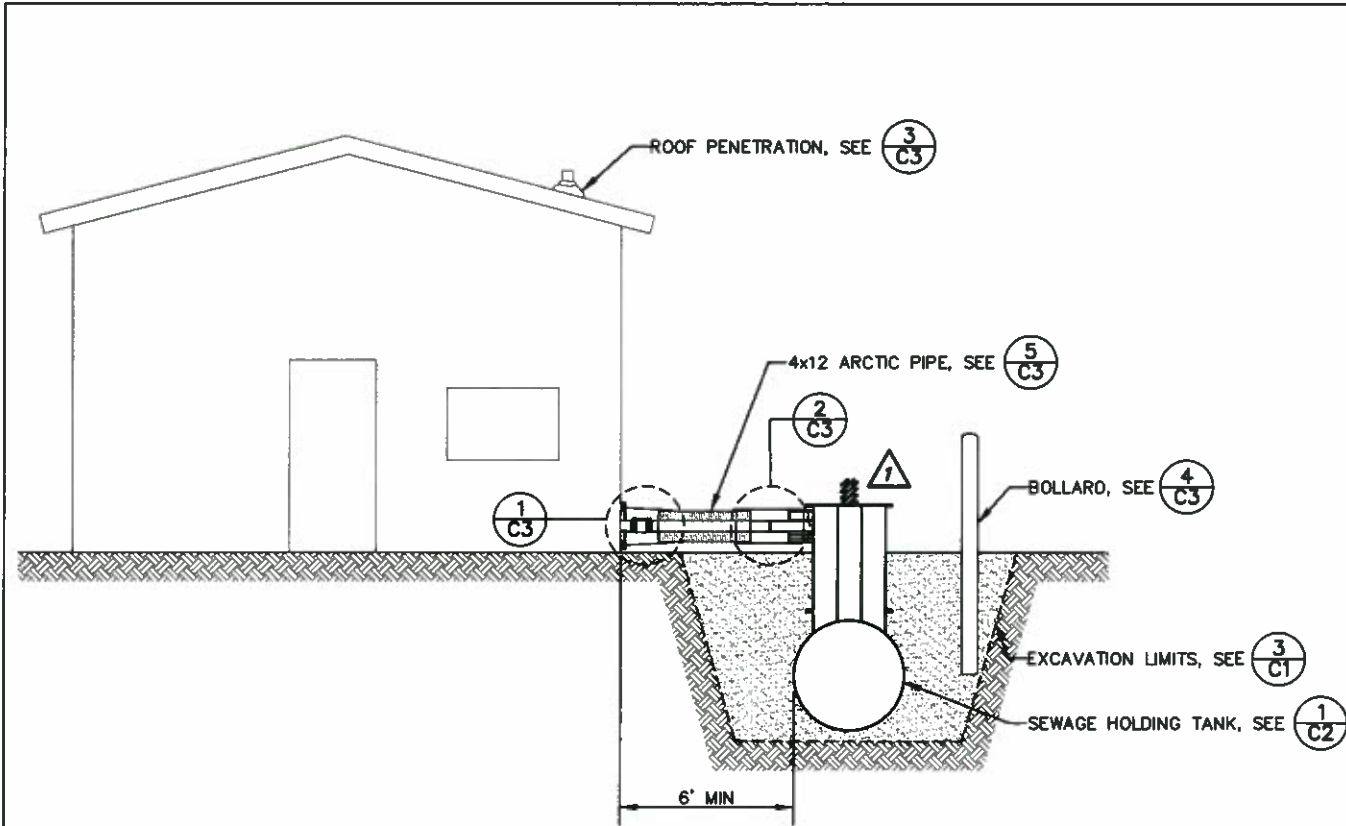

1
—
NTS
HOLDING TANK LAYOUT - HOUSE AT GRADE

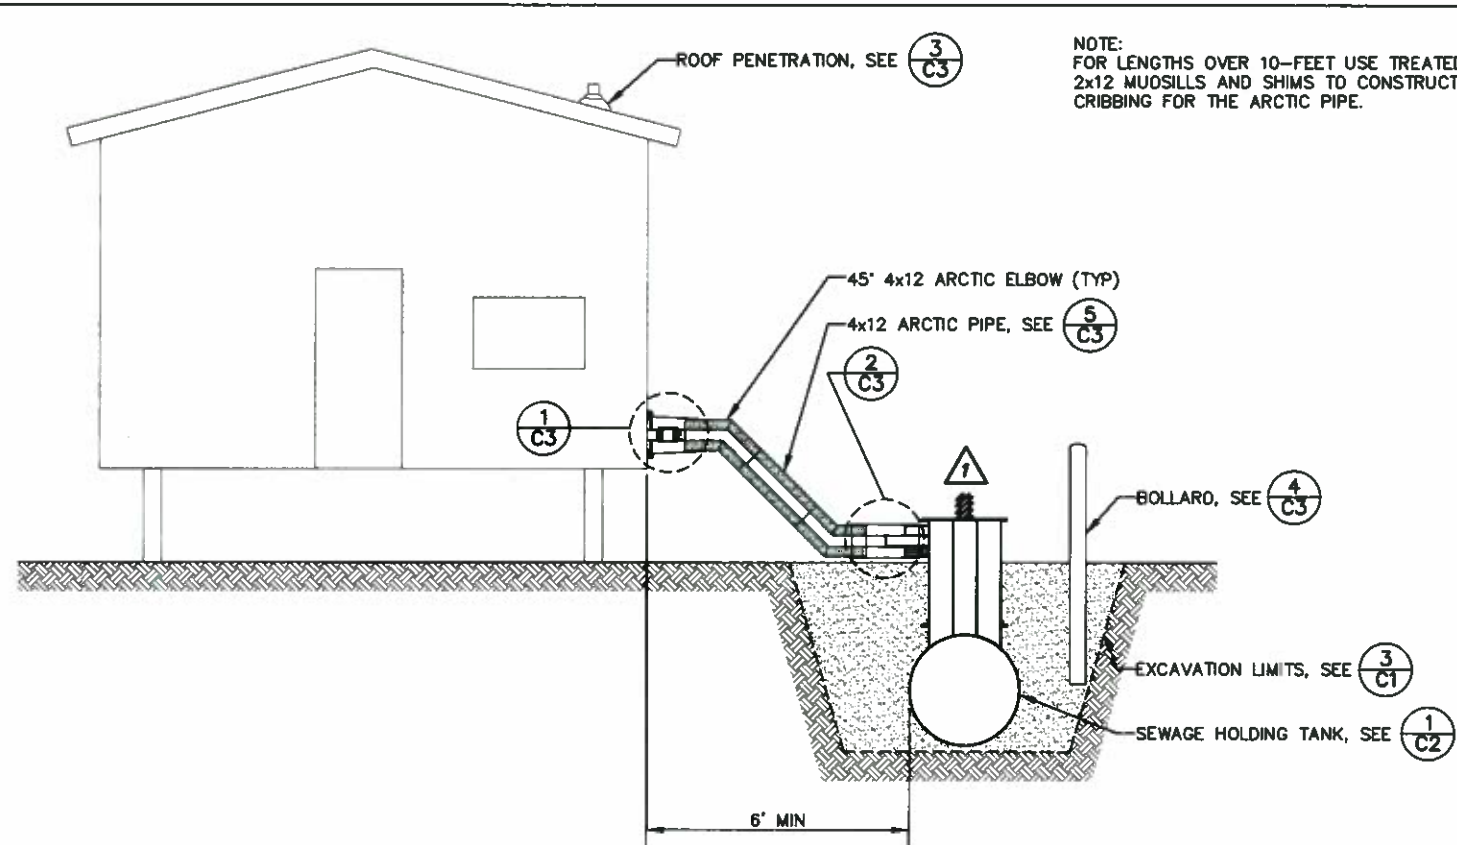


2
—
NTS
HOLDING TANK LAYOUT - HOUSE ON PILES

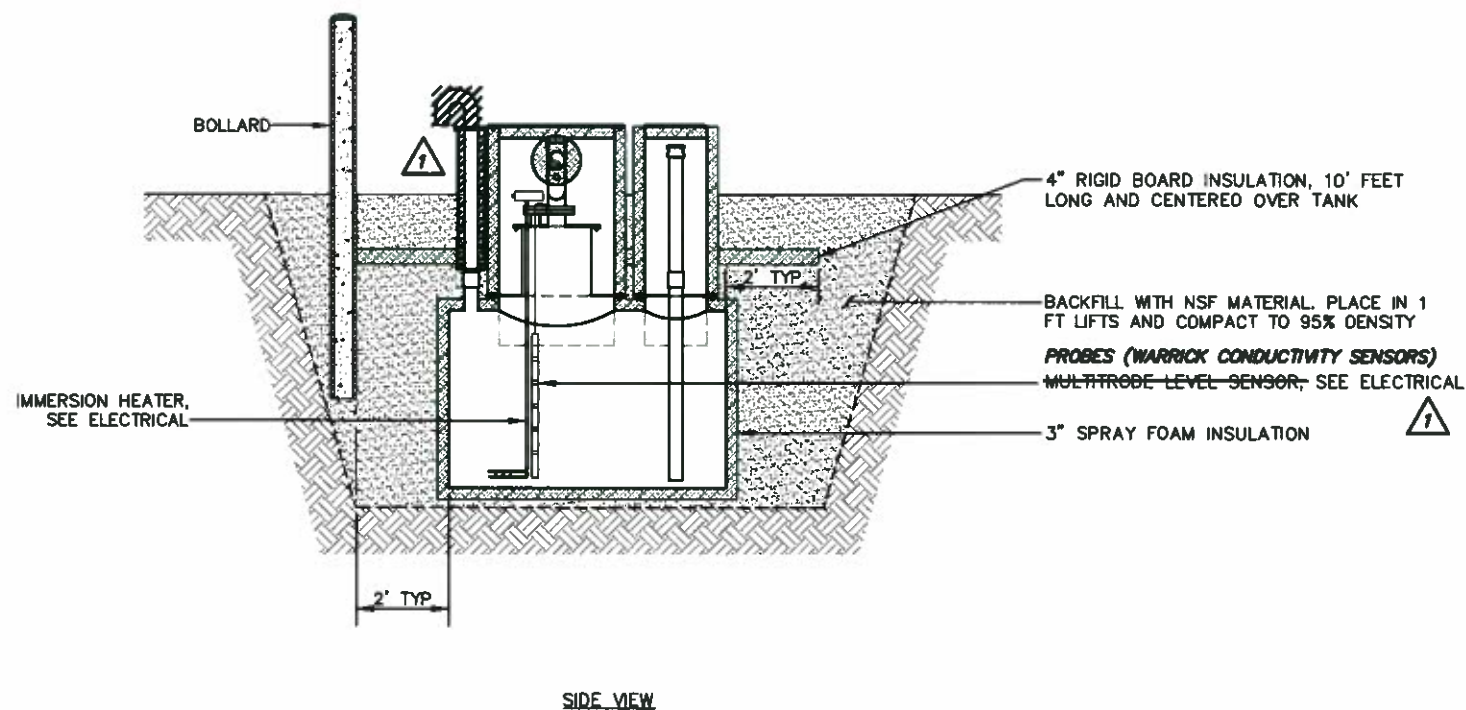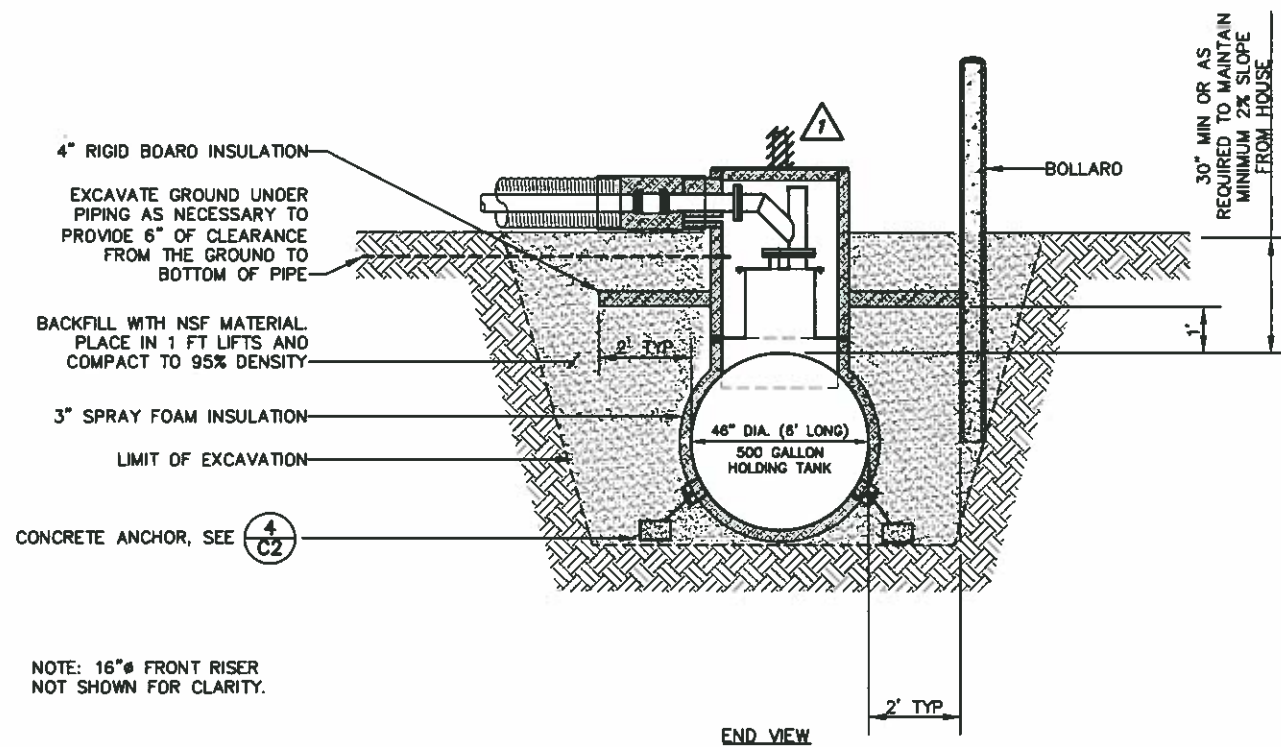

3
—
NTS
SEWAGE HOLDING TANK SECTIONS

RECORD DRAWING CERTIFICATE
THESE DRAWINGS REFLECT
RECORDED INFORMATION OBTAINED
DURING CONSTRUCTION.
INFORMATION PROVIDED HEREIN
IS ACCURATE TO THE BEST OF
MT KNOWLEDGE.
M. J. Jorgensen 2/09
NAME DATE

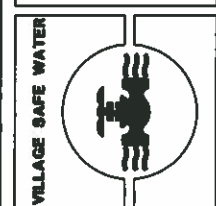


VILLAGE OF BEAVER
SANITATION IMPROVEMENTS
BATHROOM UPGRADES
HOLDING TANK LAYOUT &
HOLDING TANK SECTIONS


REVISION	BY	DATE
AS-BUILT	ML	2/09

Project No.	Date	Designed	Drawn	Approved
	MAY 2006	ML	ML	DSY

 Sheet No.
SHEET C1 OF C20



1. TANK SHALL BE CONSTRUCTED FROM A MINIMUM 10 GAUGE A36 MILD STEEL.
2. TANK SHALL BE CONSTRUCTED TO UL STANDARDS.
3. COAT INTERIOR AND EXTERIOR OF THE TANK, NOZZLES AND ALL ASSOCIATED PIPING WITH CORROCOTE II CLASSIC.
4. PROVIDE ½"Ø X 3" GALVANIZED BOLTS AND NUTS FOR STANDARD FLANGES. PROVIDE ½" x 1½" BOLTS AND NUTS FOR THE MANWAY AND RISER FLANGES.
5. PROVIDE GASKETS BETWEEN ALL FLANGES.

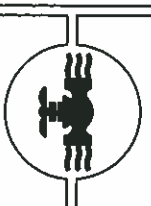

**VILLAGE OF BEAVER
SANITATION IMPROVEMENTS**


BATHROOM UPGRADES

SEWAGE HOLDING TANK DETAILS


[illegible]

No.	MAY 2006
Designed	M.J.L.
Drawn	M.J.L.
Approved	DSY




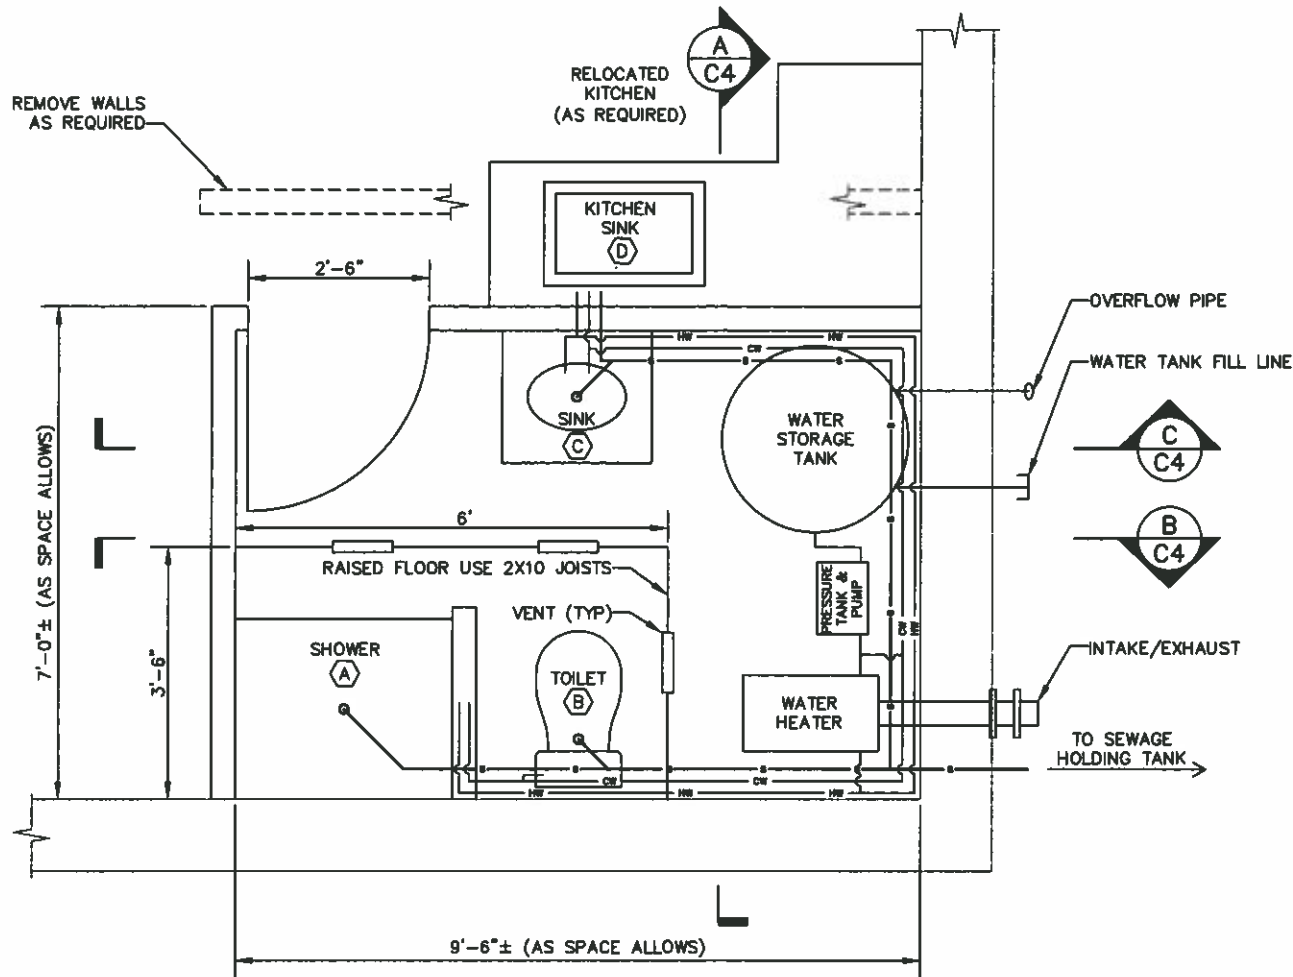

1 INTERIOR BATHROOM ADDITION PLAN
NTS

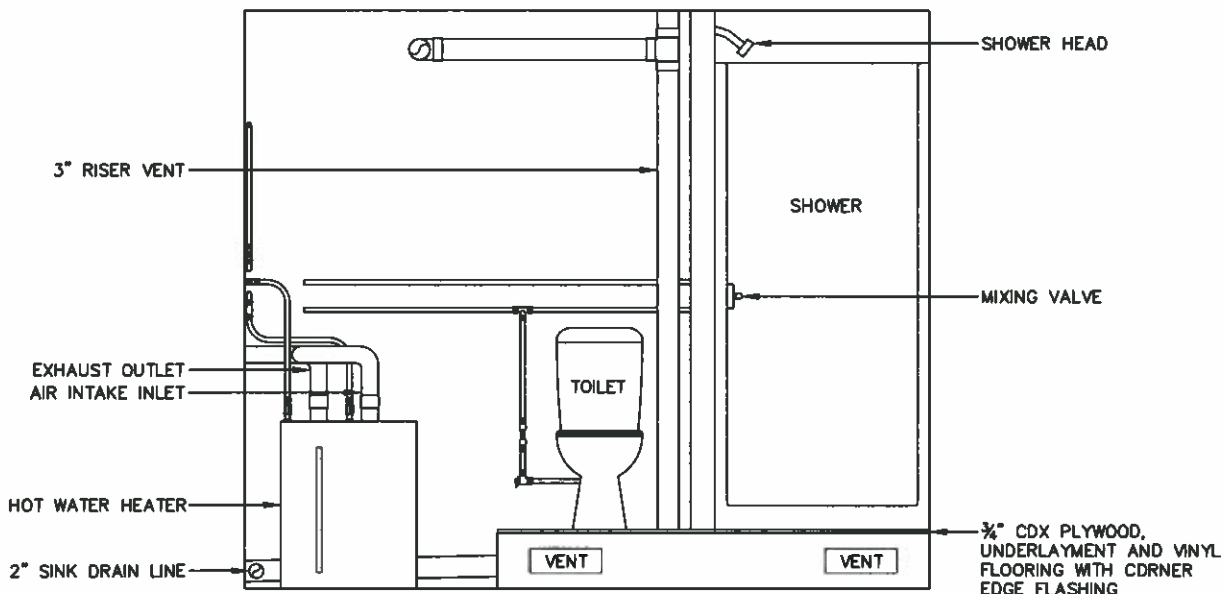

B SECTION B
NTS

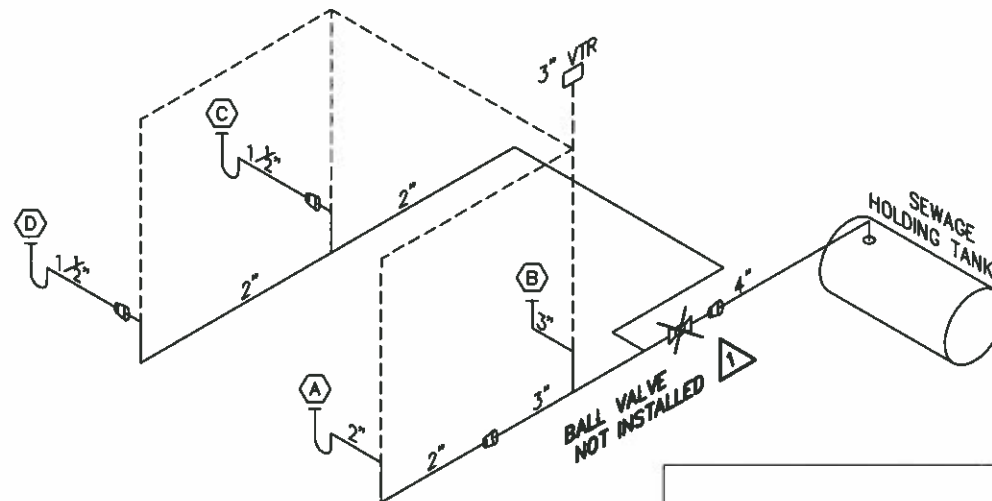

2 SEWER ISOMETRIC
NTS


NOTES:

1. WATER AND SEWER LINE LOCATIONS ARE REPRESENTATIVE ONLY. LOCATE LINES IN THE FIELD AS NECESSARY.
2. CUT 2-INCH Ø HOLES IN INTERIOR FLOOR JOISTS OF RAISED FLOOR AT 18-INCHES ON CENTER.


1 1/2" FILL LINE, MAY EXIT OUT OF SIDE WALL OR BACK WALL OF BATHROOM AS NECESSARY

3" OVERFLOW LINE, MAY EXIT OUT OF SIDE WALL OR BACK WALL OF BATHROOM AS NECESSARY

2" SINK DRAIN LINE

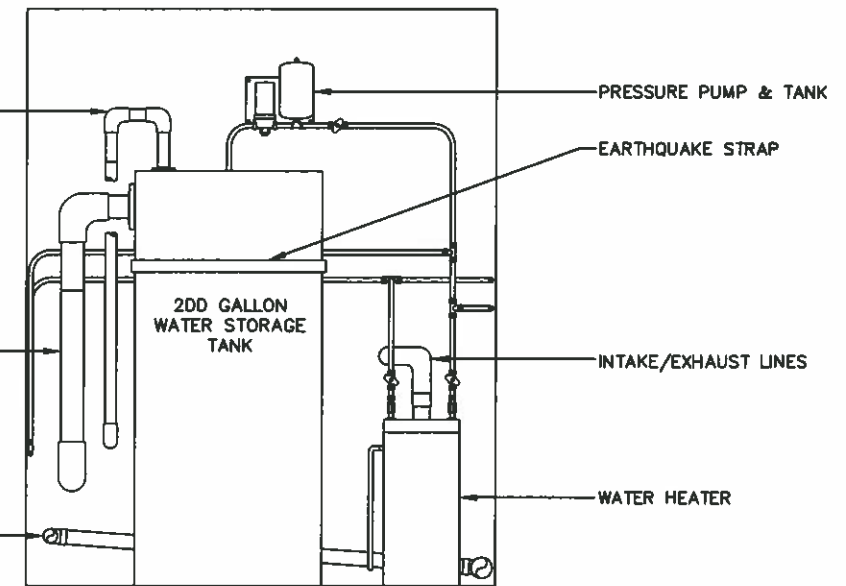

A SECTION A
NTS

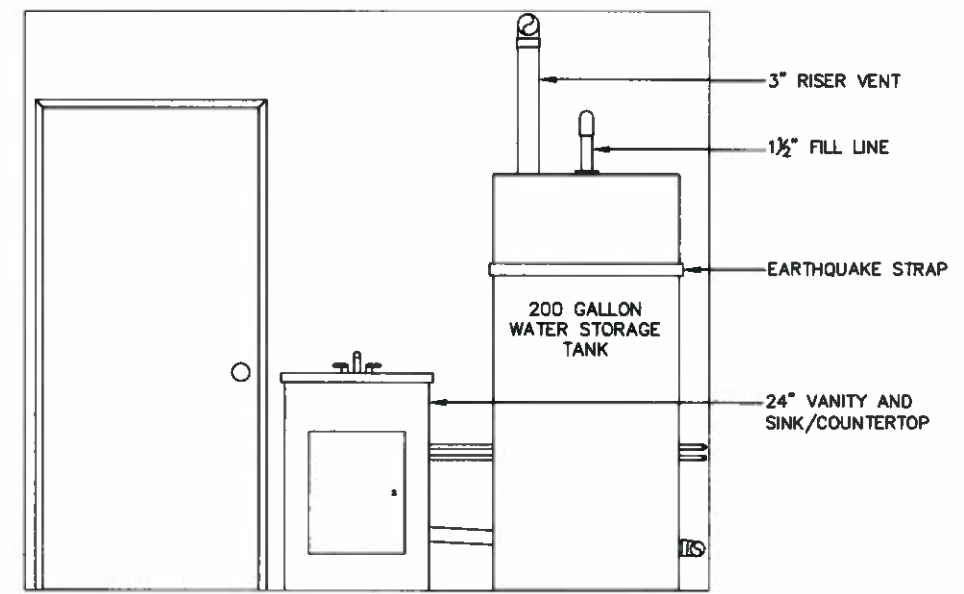

C SECTION C
NTS

RECORD DRAWING CERTIFICATE

THESE DRAWINGS REFLECT RECORDED INFORMATION OBTAINED DURING CONSTRUCTION. INFORMATION PROVIDED HEREIN IS ACCURATE TO THE BEST OF MY KNOWLEDGE.

NAME: *M. Laguarda* DATE: *2/20*




VILLAGE OF BEAVER
SANITATION IMPROVEMENTS
BATHROOM UPGRADES
INTERIOR BATHROOM ADDITION
LAYOUT, ELEVATIONS AND ISOMETRIC

REVISION	BY	DATE
AS-BUILT	ML	2/20


Project No. 9966	Date MAY 2006	Designed M.L.	Drawn M.L.	Approved DSY
------------------	---------------	---------------	------------	--------------

Sheet No. SHEET C4 OF C20


File: 9966 Beaver_Record_C4-C8 Bathroom Layouts.dwg

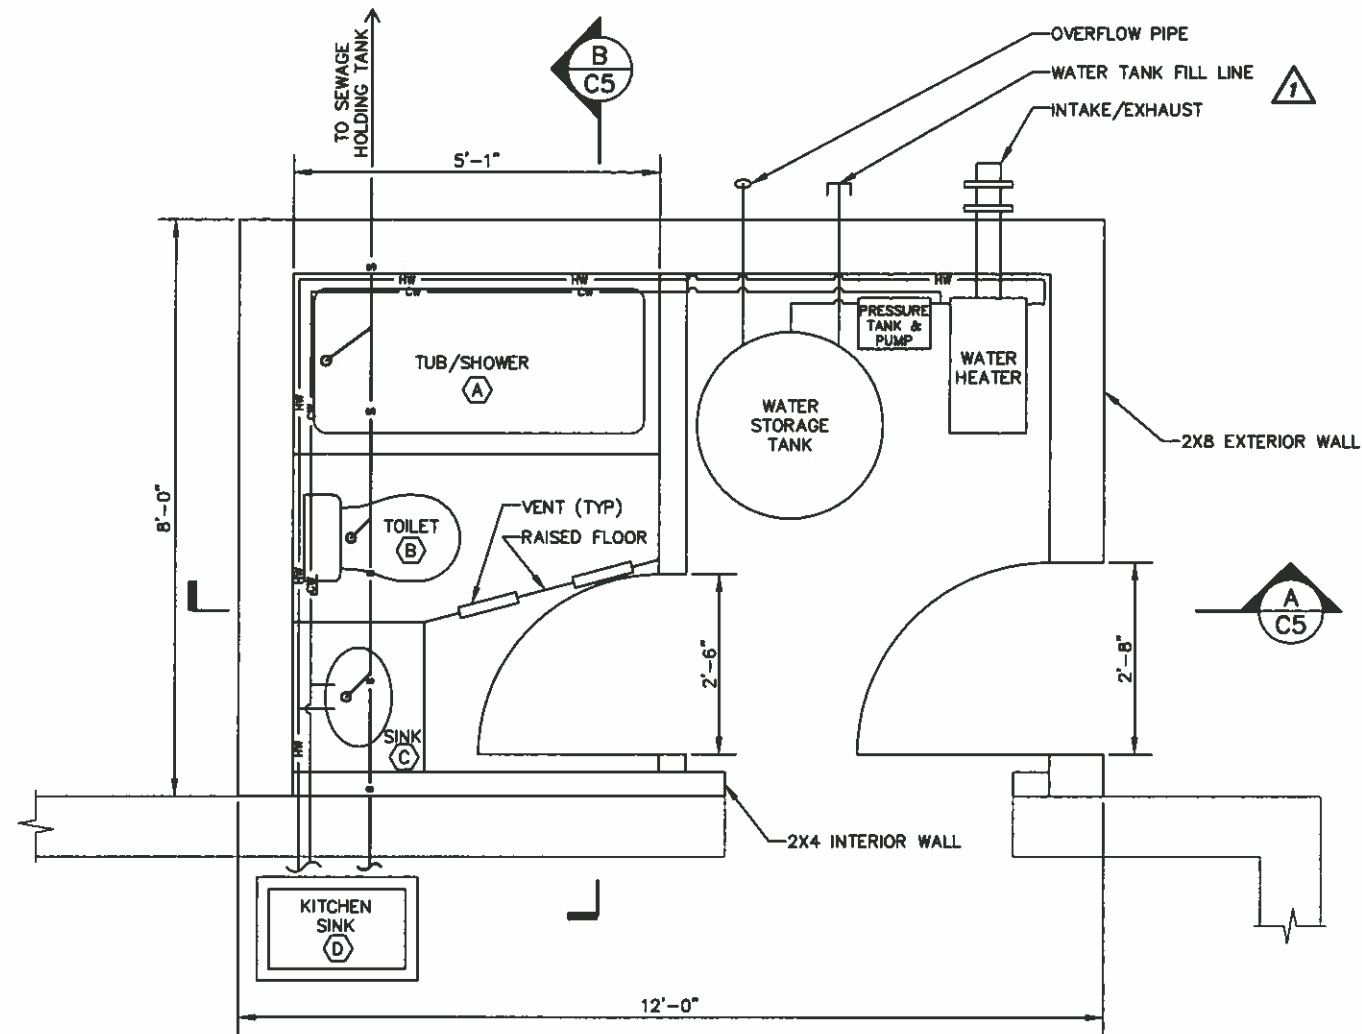


1 EXTERIOR BATHROOM ADDITION
NTS

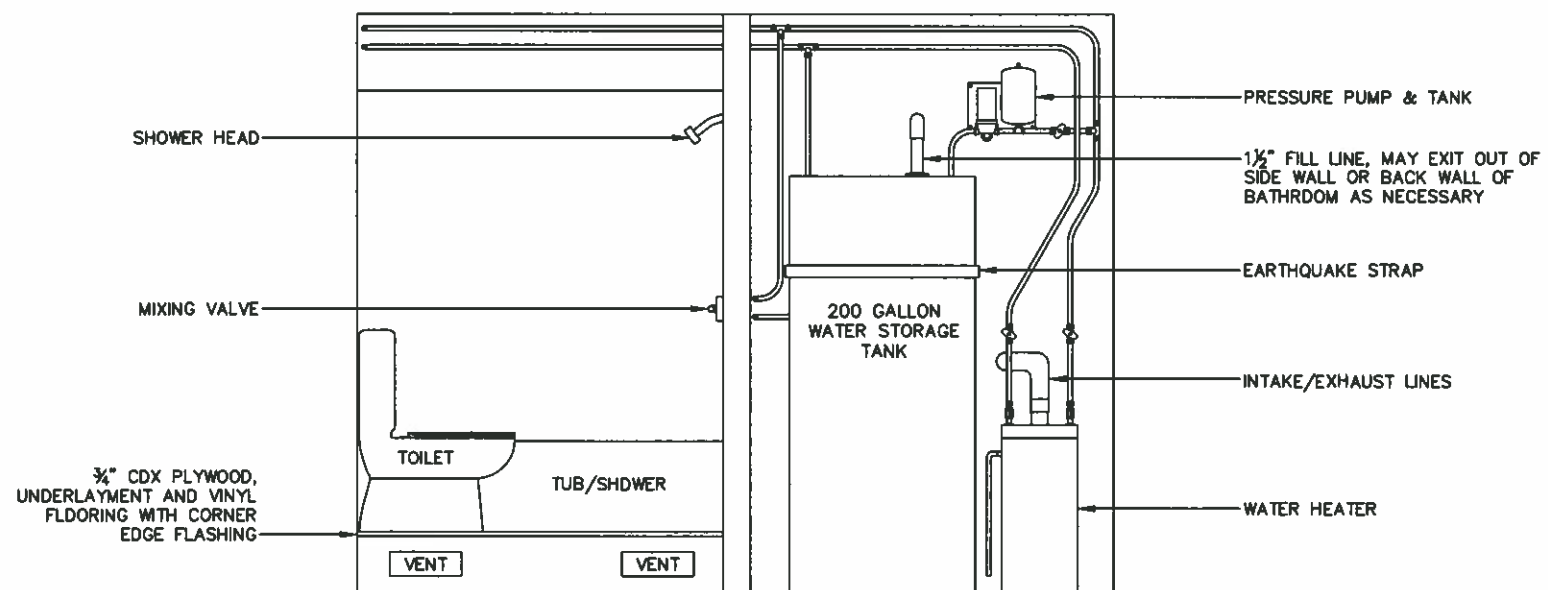

A SECTION A
NTS

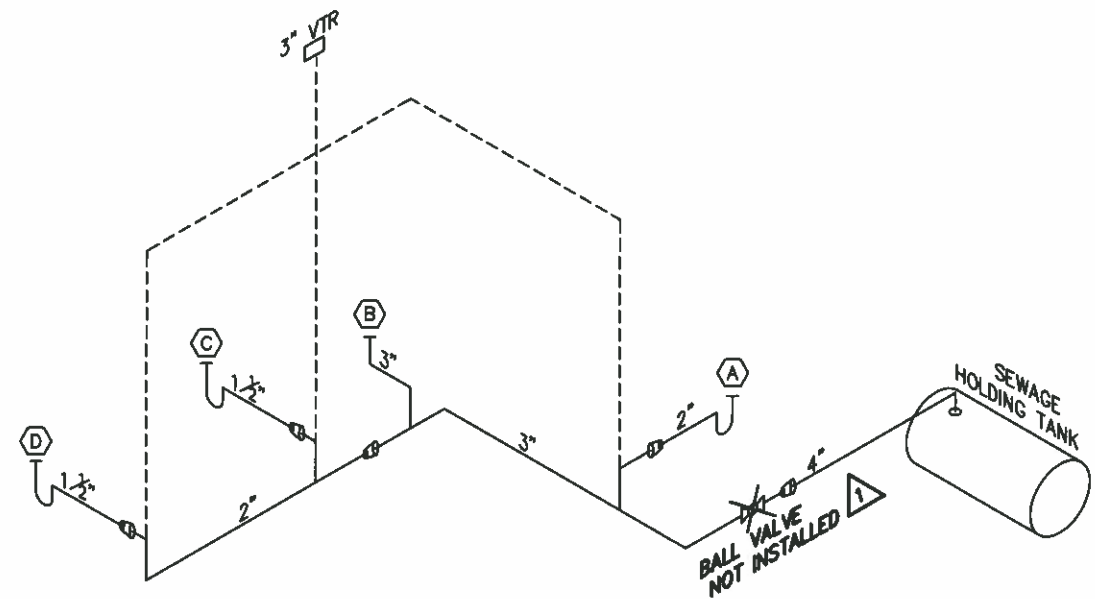

2 SEWER ISOMETRIC
NTS

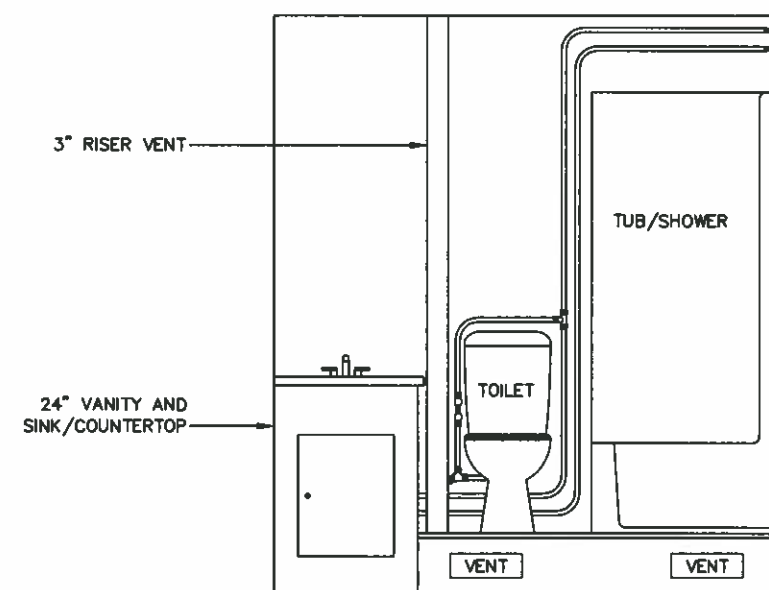


B SECTION B
NTS

NOTES:

1. WATER AND SEWER LINE LOCATIONS ARE REPRESENTATIVE ONLY. LOCATE LINES IN THE FIELD AS NECESSARY.
2. CUT 2-INCHØ HOLES IN INTERIOR FLOOR JOISTS OF RAISED FLOOR AT 18-INCHES ON CENTER.

RECORD DRAWING CERTIFICATE
THESE DRAWINGS REFLECT
RECORDED INFORMATION OBTAINED
DURING CONSTRUCTION.
INFORMATION PROVIDED HEREIN
IS ACCURATE TO THE BEST OF
MY KNOWLEDGE.
NAME: *M. Ledunichuk* DATE: *2/09*

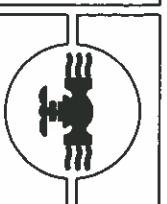


VILLAGE OF BEAVER
SANITATION IMPROVEMENTS
BATHROOM UPGRADES
EXTERIOR BATHROOM ADDITION
LAYOUT, ELEVATIONS AND ISOMETRIC

REVISION	BY	DATE
AS-BUILT	ML	2/09


Project No.	9966	Date	MAY 2006	Designed	ML	Drawn	ML	Approved	DSY
-------------	------	------	----------	----------	----	-------	----	----------	-----

Sheet No.
SHEET C5 OF C20


- NOTES:
1. WATER AND SEWER LINE LOCATIONS ARE REPRESENTATIVE ONLY. LOCATE LINES IN THE FIELD AS NECESSARY.
 2. CUT 2-INCHØ HOLES IN INTERIOR FLOOR JOISTS OF RAISED FLOOR AT 18-INCHES ON CENTER.

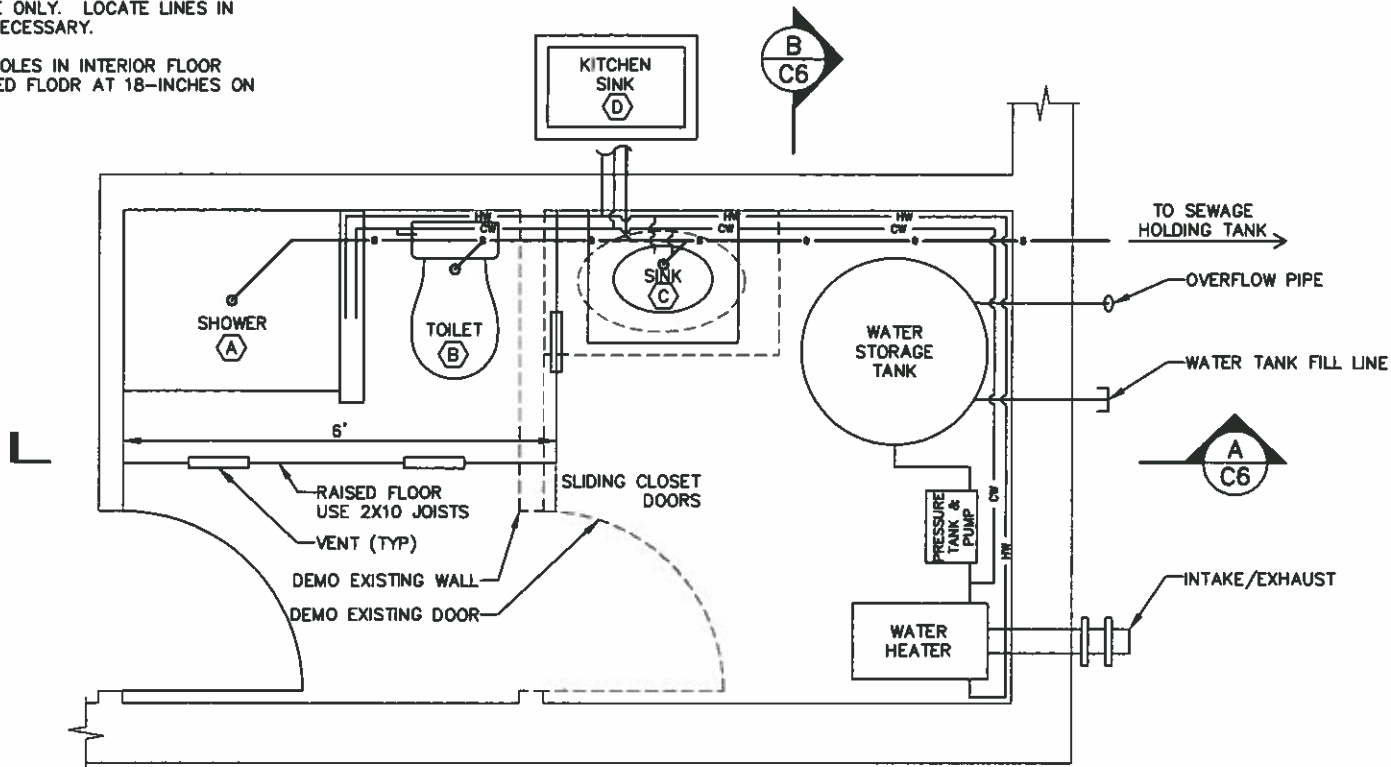


1 INTERIOR HUD HOME BATHROOM ADDITION
NTS

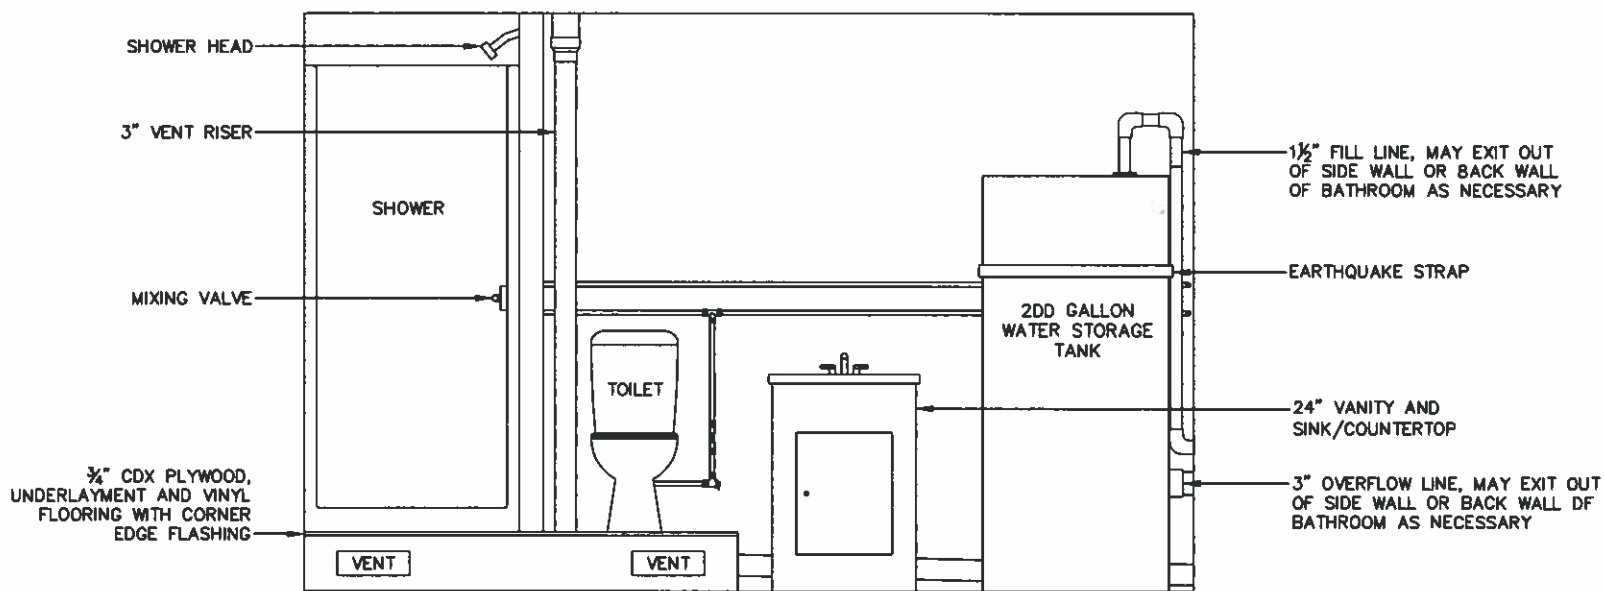

A SECTION A
NTS

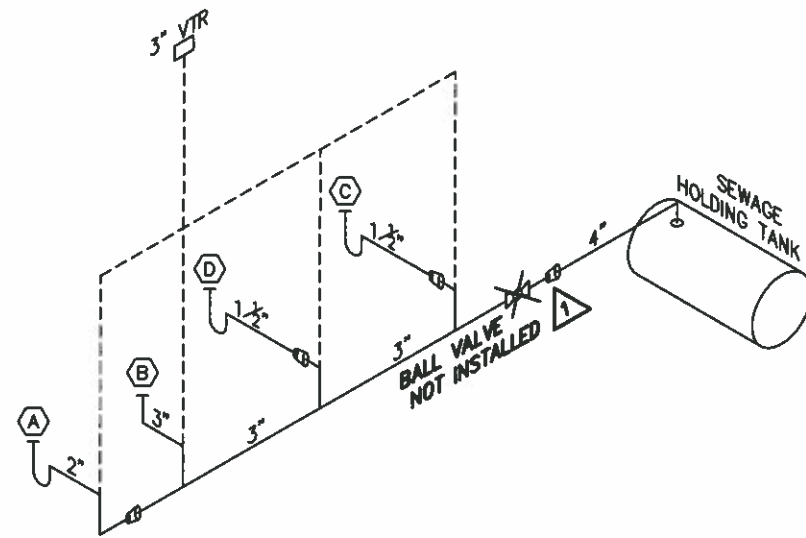

2 SEWER ISOMETRIC
NTS

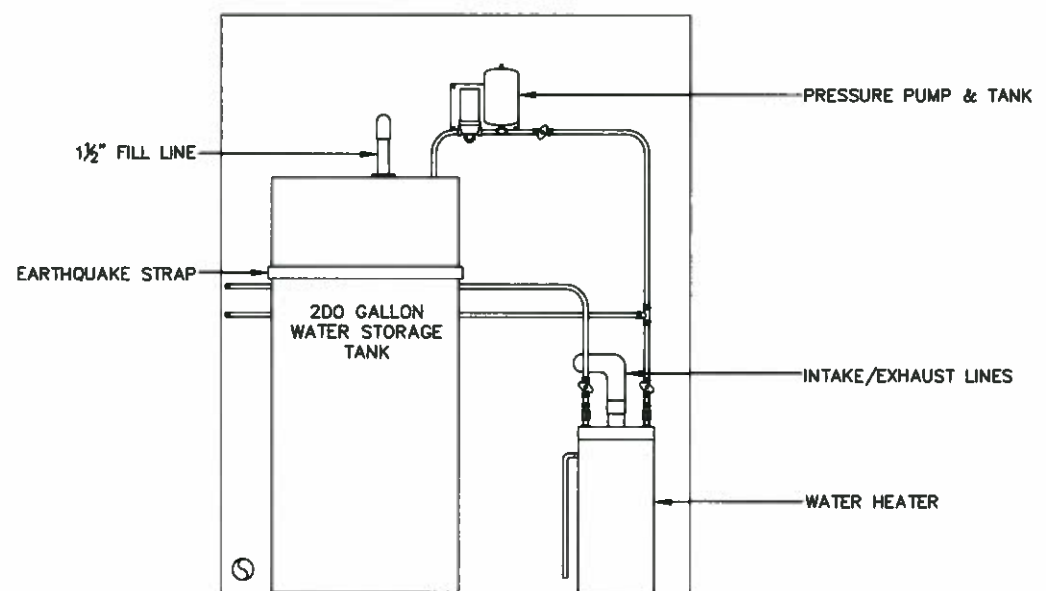

B SECTION B
NTS

RECORD DRAWING CERTIFICATE

THESE DRAWINGS REFLECT RECORDED INFORMATION OBTAINED DURING CONSTRUCTION. INFORMATION PROVIDED HEREIN IS ACCURATE TO THE BEST OF MY KNOWLEDGE.

NAME: *M. J. J. J.* DATE: *2/09*

VILLAGE SAFE WATER

STATE OF ALASKA
40 JUL
MICHAEL LEXANDER
CE 11008
REGISTERED PROFESSIONAL

CRW
ENGINEERING GROUP LLC
3000 ARCTIC BLVD, SUITE 203
ANCHORAGE, ALASKA 99503
PHONE: (907) 582-3223
FAX: (907) 581-2273


VILLAGE OF BEAVER
SANITATION IMPROVEMENTS
BATHROOM UPGRADES
HUD HOME BATHROOM ADDITION
LAYOUT, ELEVATIONS AND ISOMETRIC

REVISION	BY	DATE
AS-BUILT	ML	2/09


Project No.	Date	Designed	Drawn	Approved
9966	MAY 2006	M.L.	M.L.	DSY

Sheet No. **C6** OF **C20**

File: 9966 Beaver_Record_C7-C20 Base.dwg


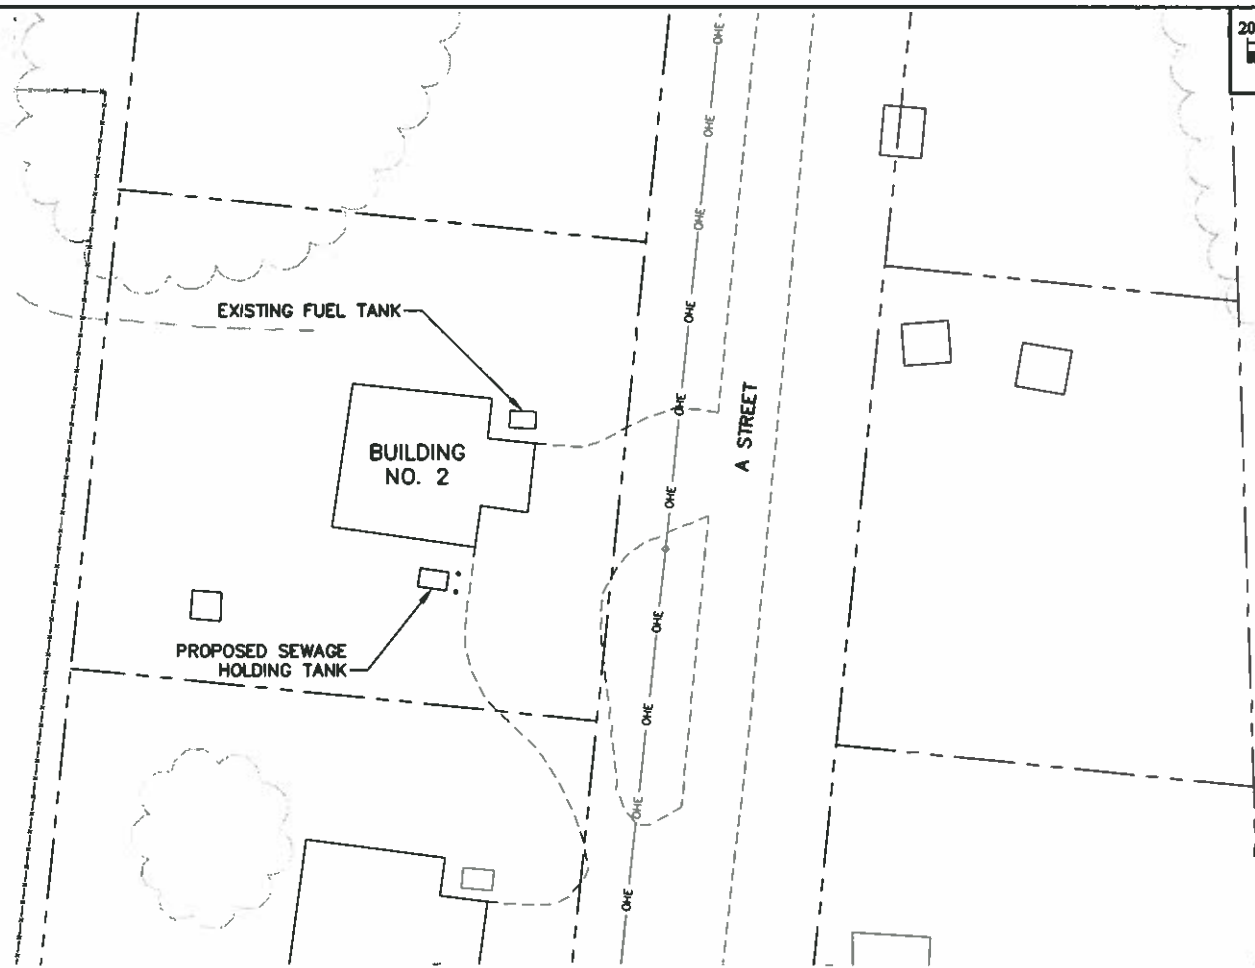


SITE PLAN

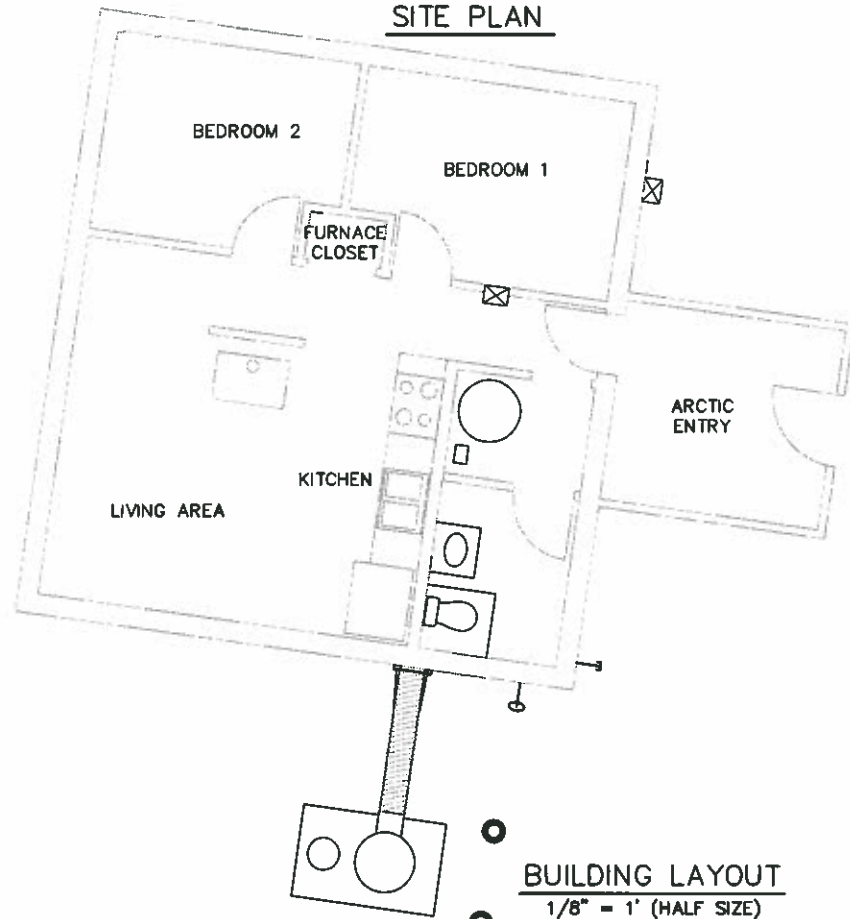


BUILDING LAYOUT
1/8" = 1' (HALF SIZE)

1
—
BUILDING 2 - DAVID HOPE
AS SHOWN

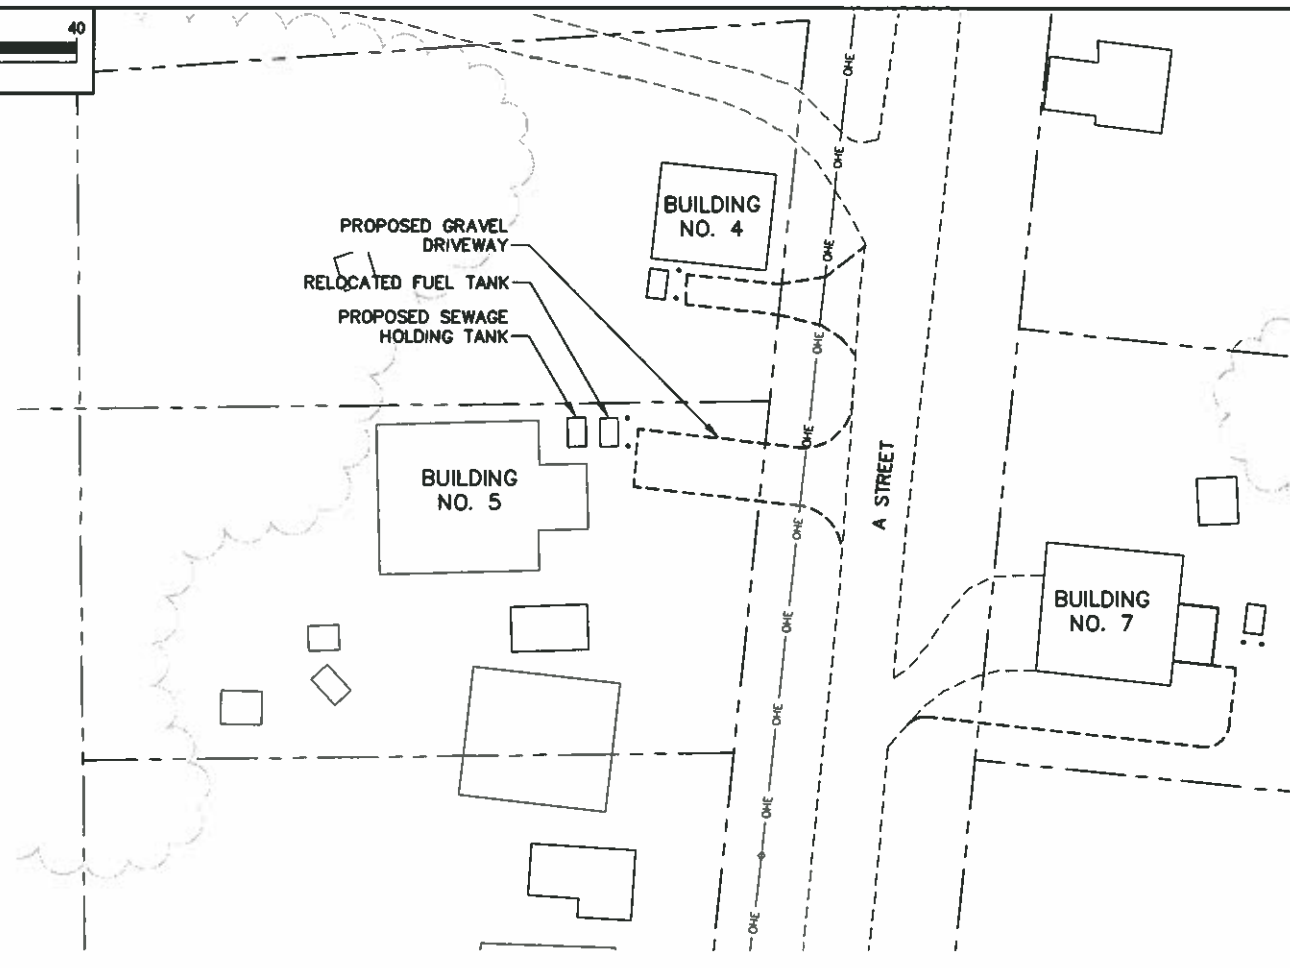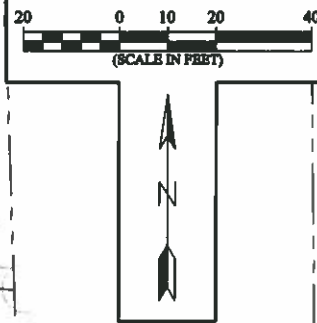

SITE PLAN

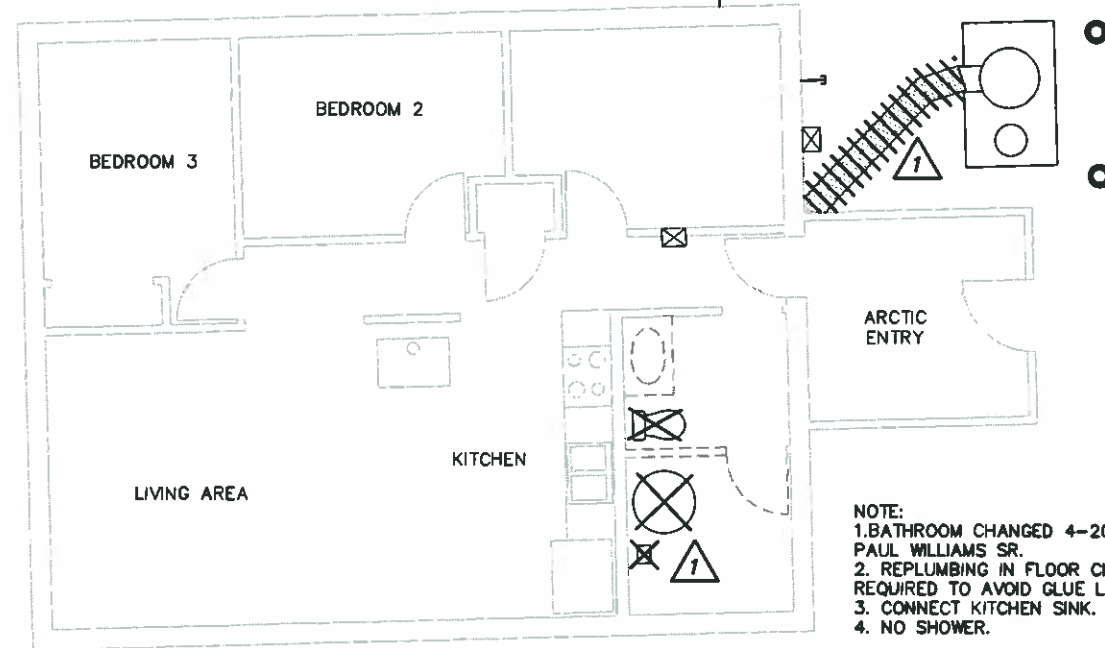


BUILDING LAYOUT
1/8" = 1' (HALF SIZE)

2
—
BUILDING 5 - PAUL WILLIAMS SR.
AS SHOWN

NOTE:
1. BATHROOM CHANGED 4-20-06 PER
PAUL WILLIAMS SR.
2. REPLUMBING IN FLOOR CHASE
REQUIRED TO AVOID GLUE LAM.
3. CONNECT KITCHEN SINK.
4. NO SHOWER.

NOTE:
1. SEWAGE HOLDING TANK INSTALLED.
NO OTHER COMPONENTS INSTALLED.

RECORD DRAWING CERTIFICATE
THESE DRAWINGS REFLECT
RECORDED INFORMATION OBTAINED
DURING CONSTRUCTION.
INFORMATION PROVIDED HEREIN
IS ACCURATE TO THE BEST OF
MY KNOWLEDGE.
M. Leggett 2/09
NAME DATE

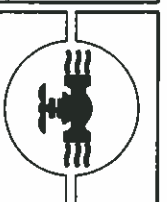


VILLAGE OF BEAVER
SANITATION IMPROVEMENTS
BATHROOM UPGRADES
SITE PLAN & BATHROOM LAYOUT
DAVID HOPE - BUILDING 2
PAUL WILLIAMS, SR. - BUILDING 5

REVISION	BY	DATE
AS-BUILT	ML	2/09


Project No.	9966
Date	MAY 2006
Designed	ML
Drawn	ML
Approved	ML

Sheet No.
SHEET C7 OF C20

File: 9966 Beaver_Record_C7-C20 Base.dwg

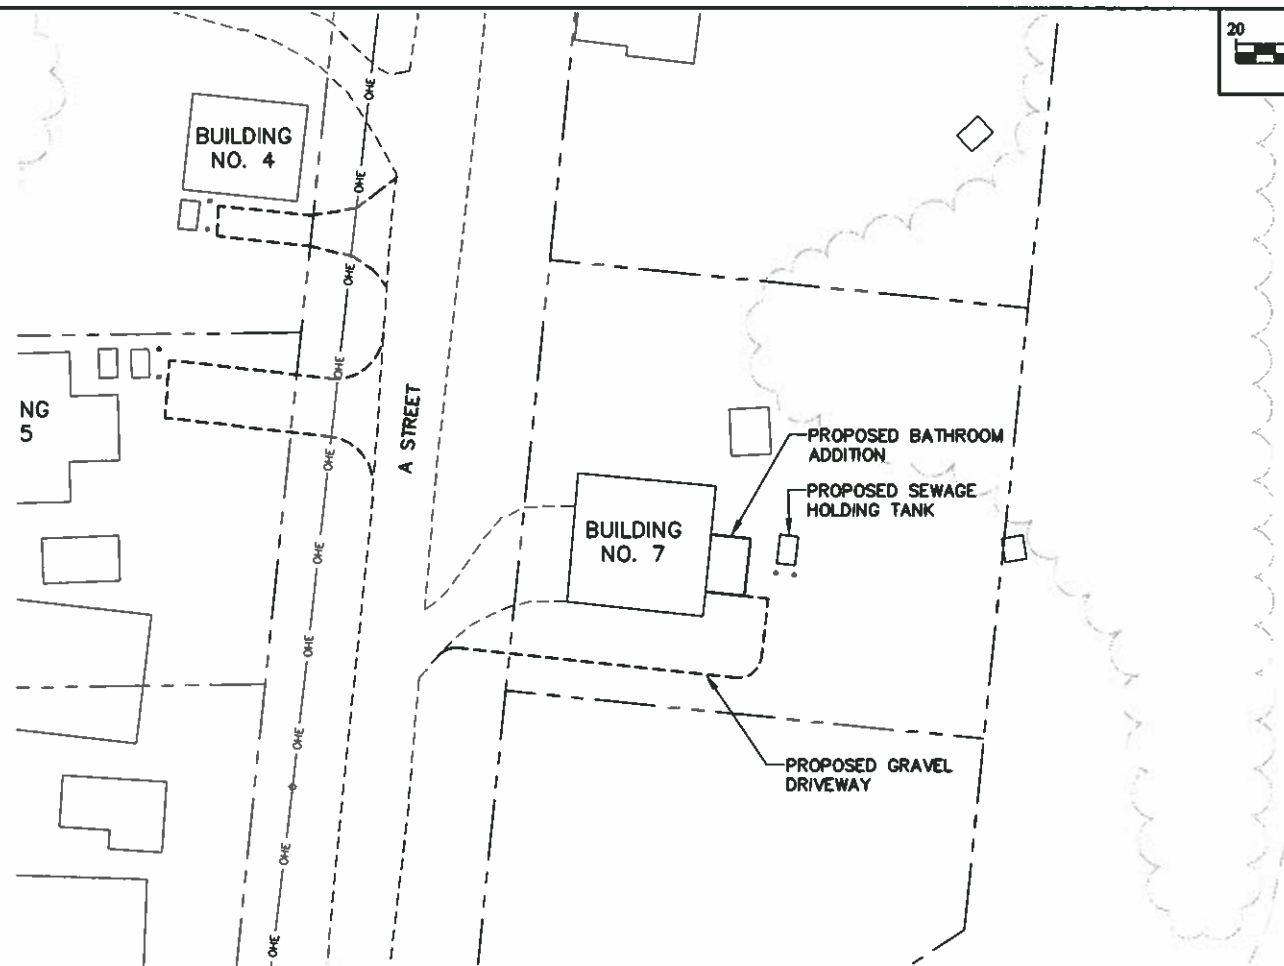


SITE PLAN

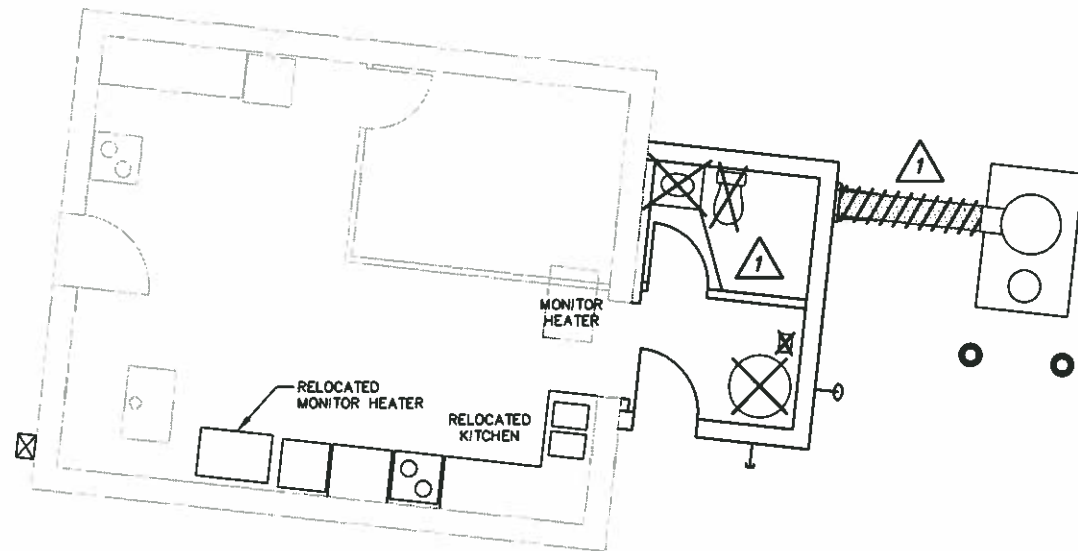


BUILDING LAYOUT
1/8" = 1' (HALF SIZE)

NOTE:
SEWAGE HOLDING TANK INSTALLED.
NO OTHER COMPONENTS INSTALLED.

1
—
BUILDING 7 - WILMA PITKA
AS SHOWN

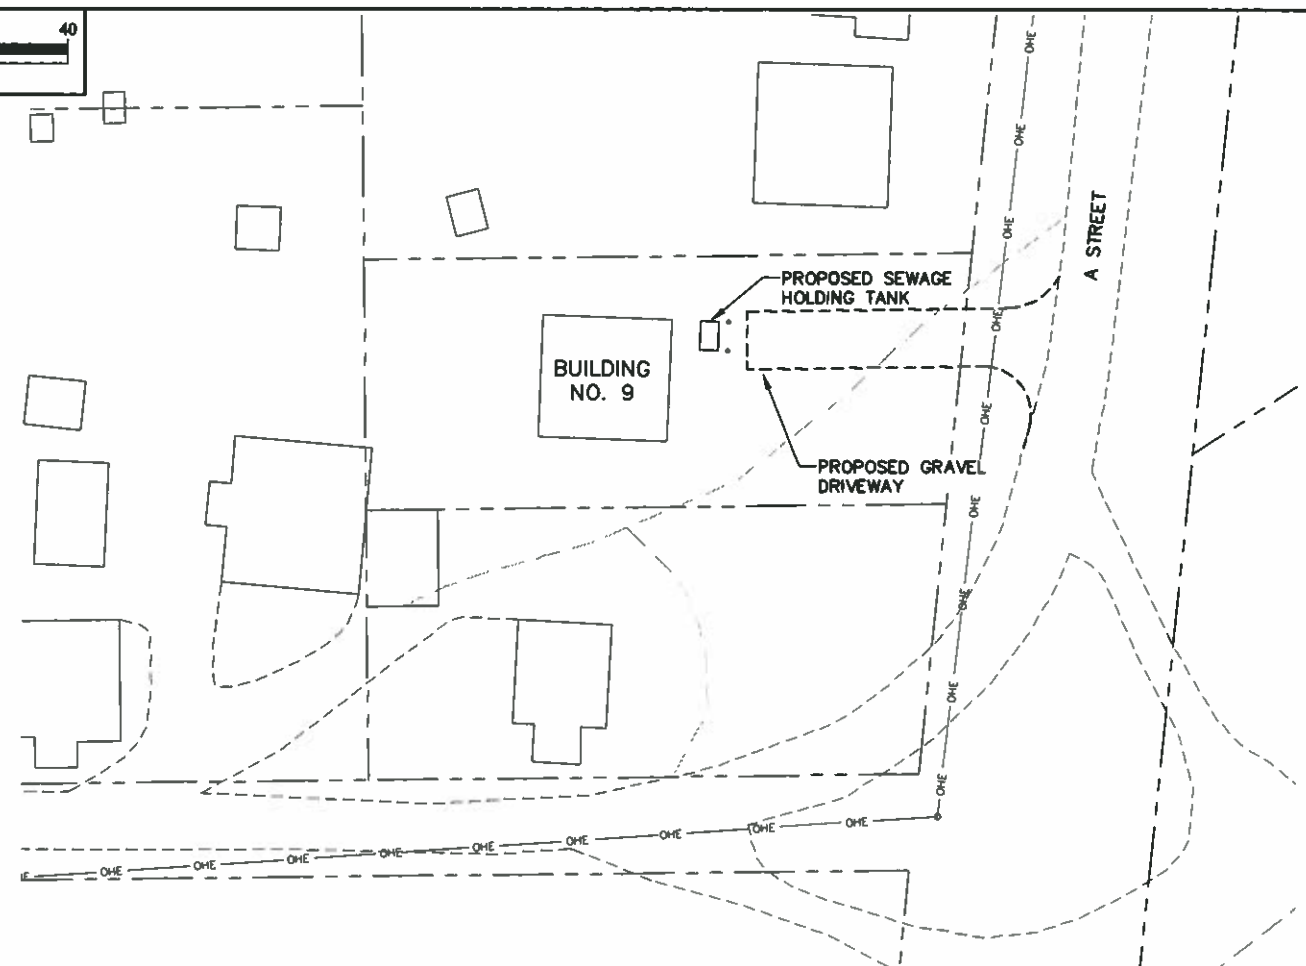


SITE PLAN

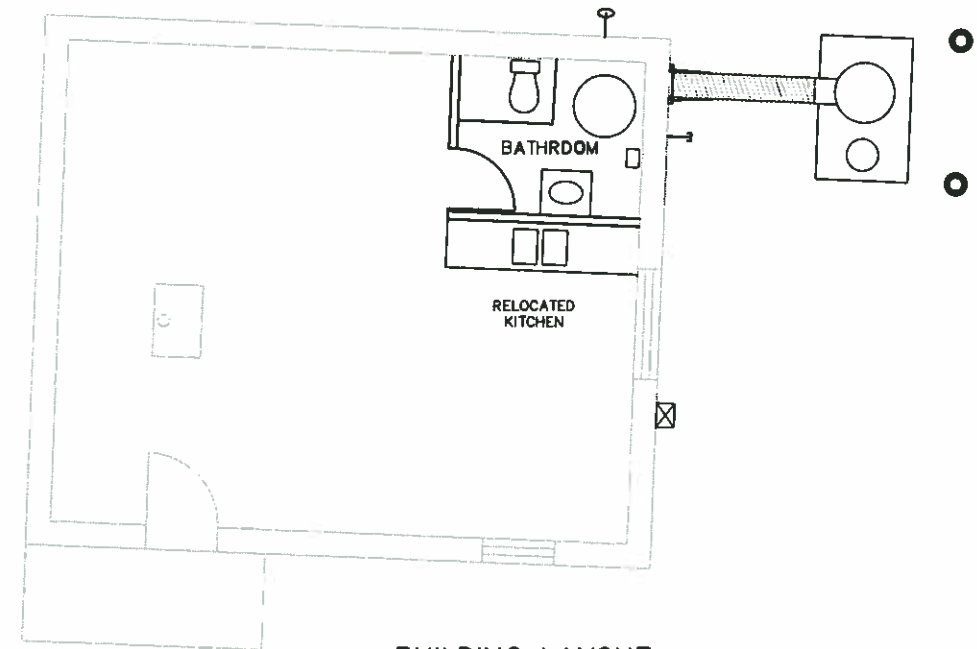

BUILDING LAYOUT
1/8" = 1' (HALF SIZE)

2
—
BUILDING 9 - JAMES HOPE
AS SHOWN

RECORD DRAWING CERTIFICATE
THESE DRAWINGS REFLECT
RECORDED INFORMATION OBTAINED
DURING CONSTRUCTION.
INFORMATION PROVIDED HEREIN
IS ACCURATE TO THE BEST OF
MY KNOWLEDGE.
NAME: M. Lapierre 2/09
DATE:

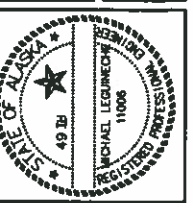


VILLAGE OF BEAVER
SANITATION IMPROVEMENTS
BATHROOM UPGRADES
SITE PLAN & BATHROOM LAYOUT
WILMA PITKA -- BUILDING 7
JAMES HOPE -- BUILDING 9

REVISION	BY	DATE
AS-BUILT	ML	2/09


Project No.	9966
Date	MAY 2006
Designed	ML
Drawn	ML
Approved	ML

Sheet No.
SHEET C8 OF C20

File: 9966 Beaver_Record_C7-C20 Base.dwg

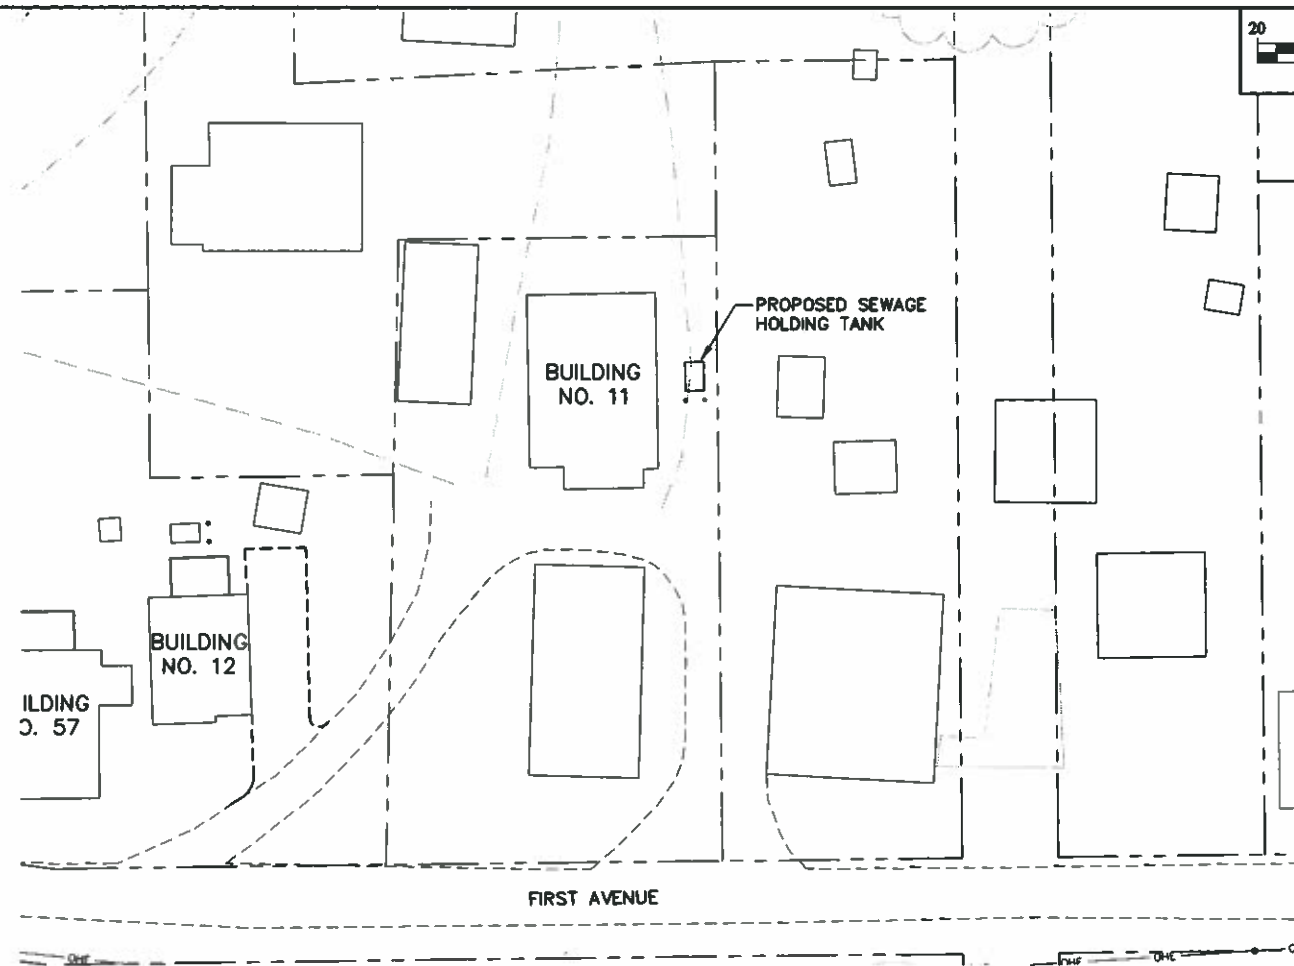


SITE PLAN

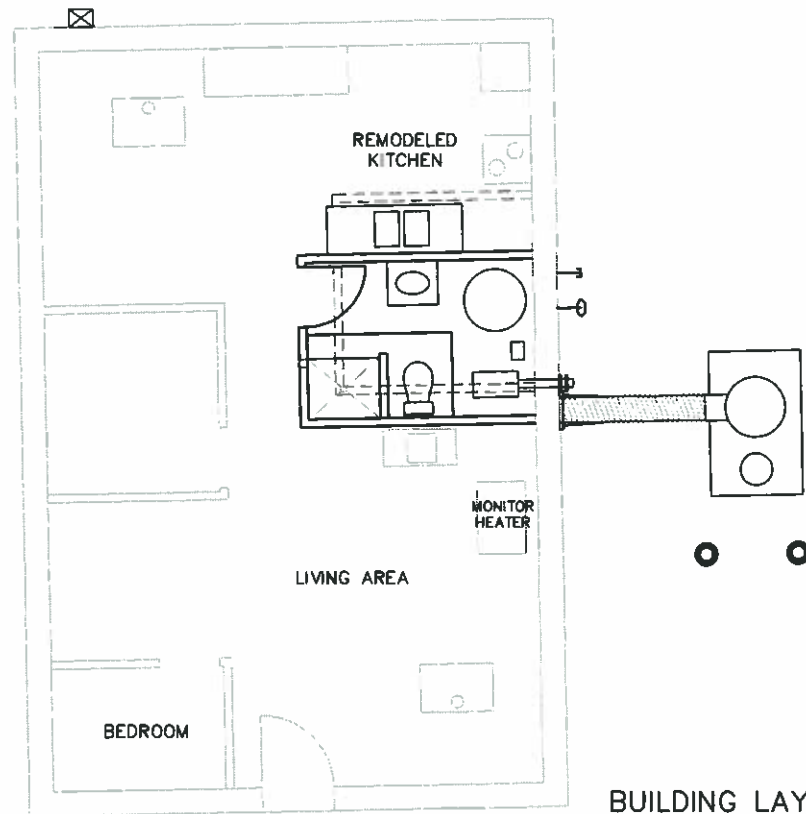


BUILDING LAYOUT
1/8" = 1' (HALF SIZE)

1
-
AS SHOWN

BUILDING 11 - ELSIE PITKA

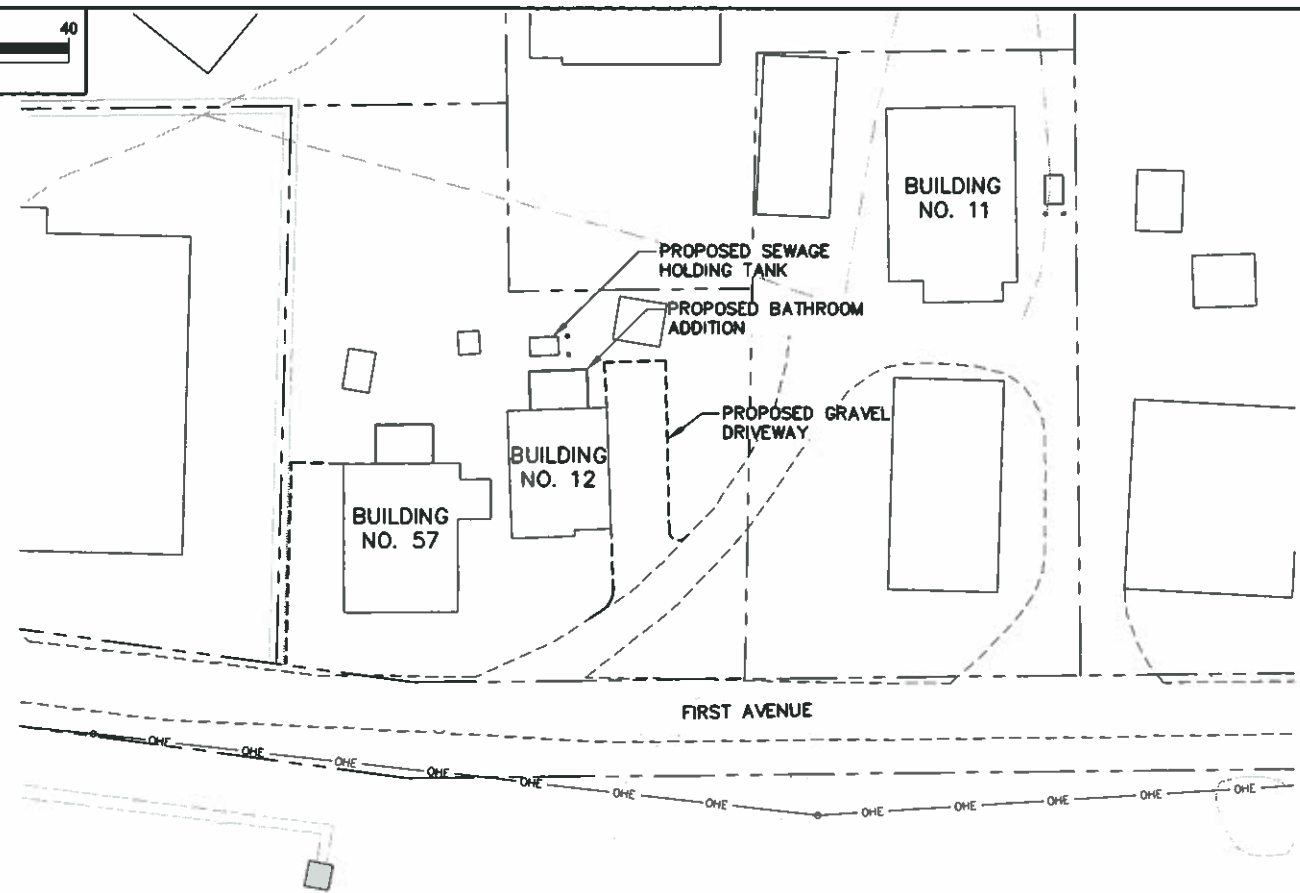

SITE PLAN

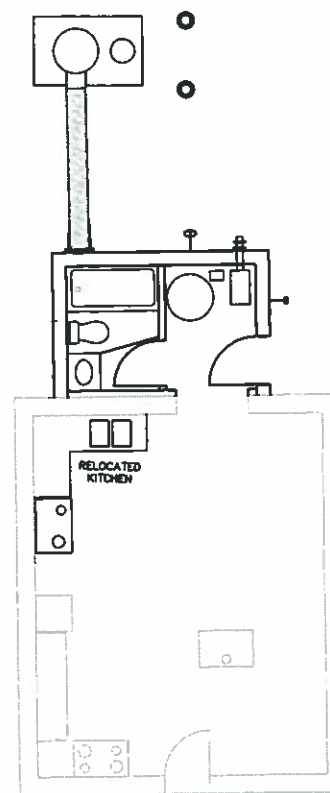


BUILDING LAYOUT
3/32" = 1' (HALF SIZE)

2
-
AS SHOWN

BUILDING 12 - MARY SAM

RECORD DRAWING CERTIFICATE
THESE DRAWINGS REFLECT
RECORDED INFORMATION OBTAINED
DURING CONSTRUCTION.
INFORMATION PROVIDED HEREIN
IS ACCURATE TO THE BEST OF
MY KNOWLEDGE.
NAME: *M. L. L. L.* DATE: *2/09*


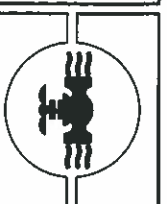


VILLAGE OF BEAVER
SANITATION IMPROVEMENTS
BATHROOM UPGRADES
SITE PLAN & BATHROOM LAYOUT
ELSE PITKA - BUILDING 11
MARY SAM - BUILDING 12

REVISION	BY	DATE




Project No.	9966
Date	MAY 2006
Designed	M.L.
Drawn	M.L.
Approved	M.L.

Sheet No.
SHEET C9 OF C20

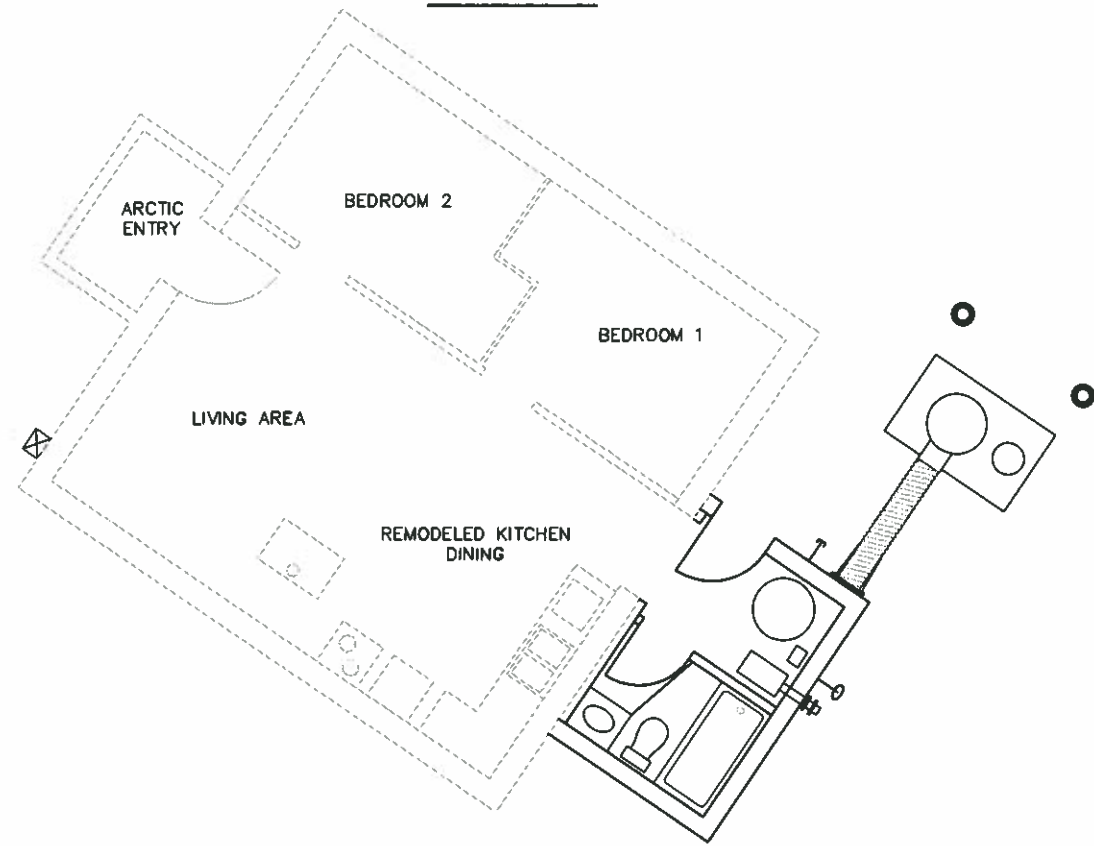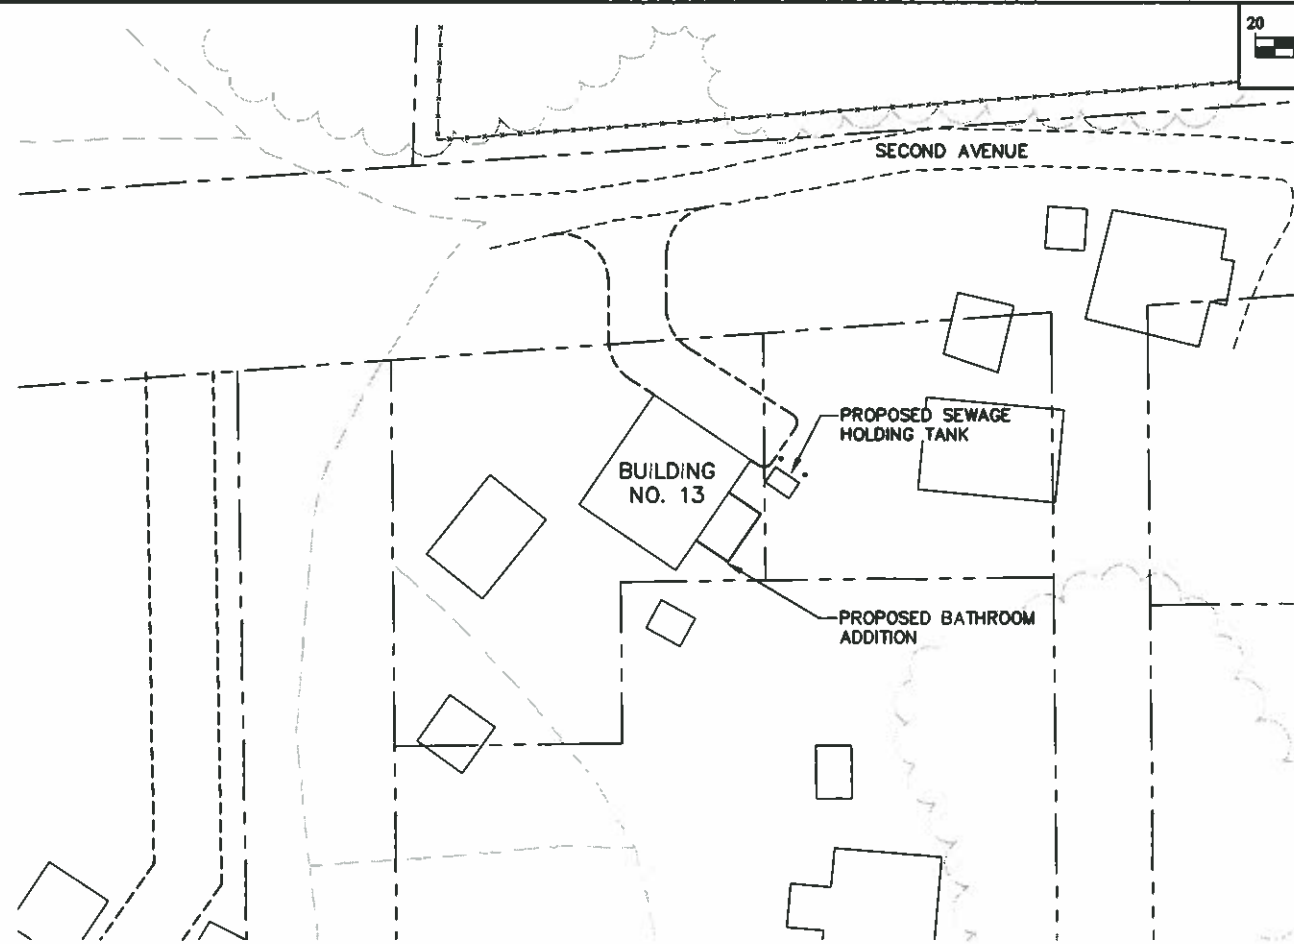

1
—
—

BUILDING 13 - GEORGE YATLIN
AS SHOWN

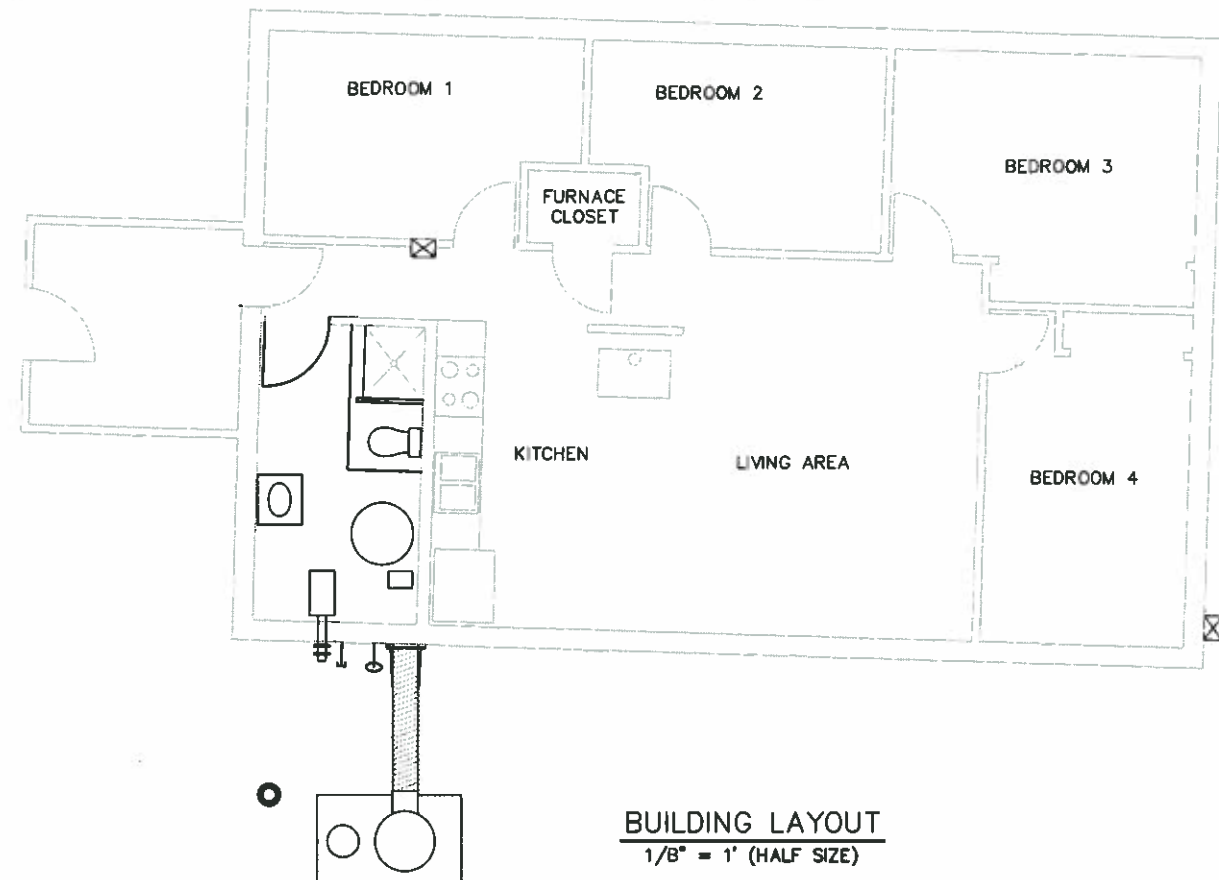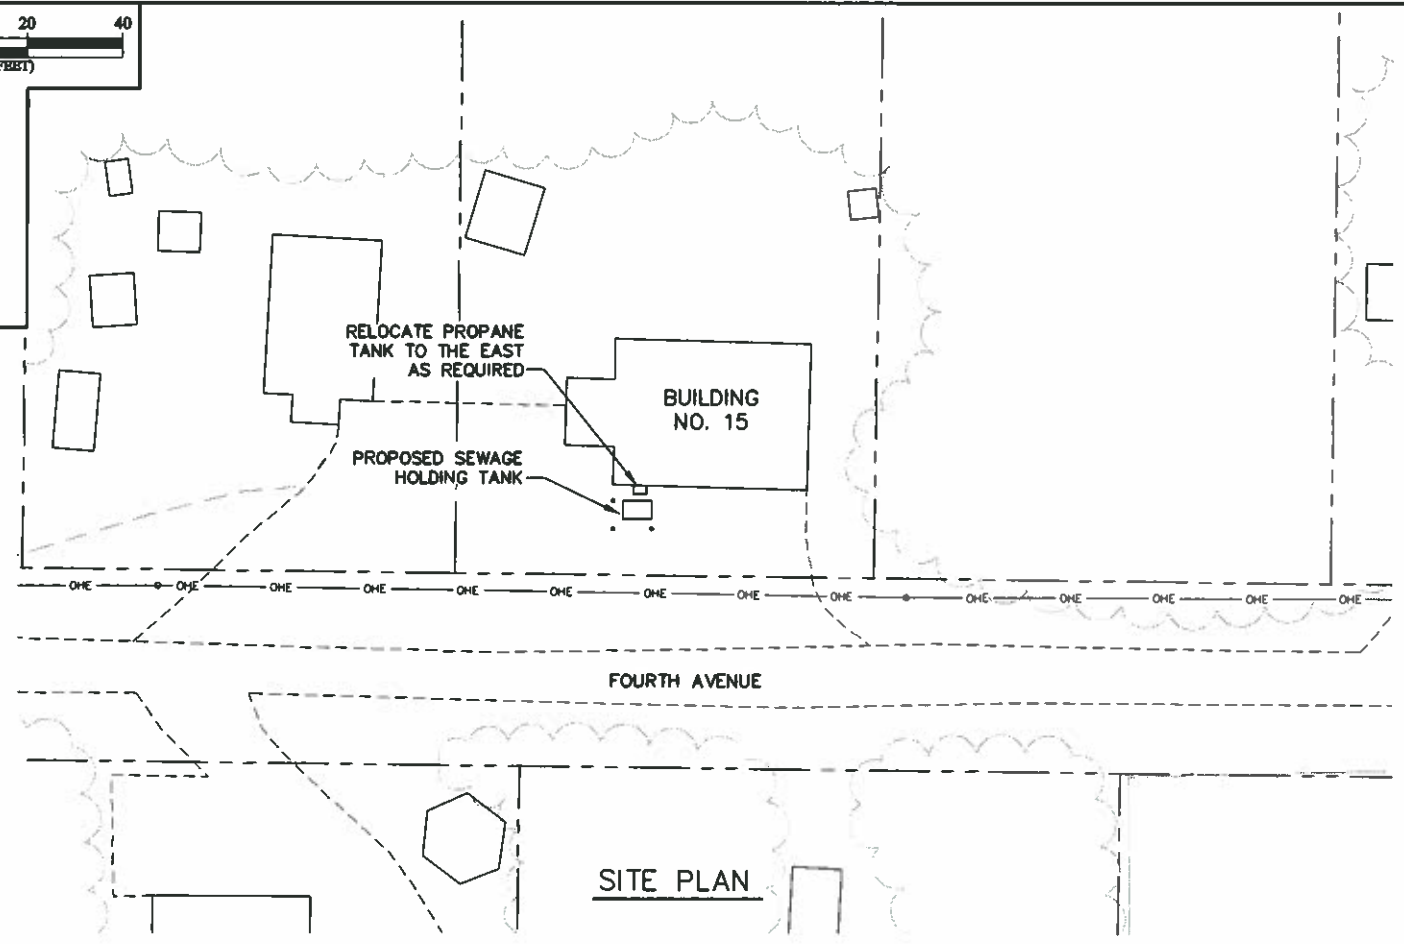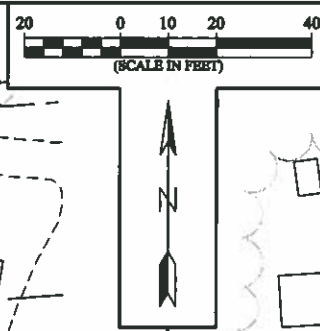

2
—
—

BUILDING 15 - SELENA PETRUSKA
AS SHOWN

RECORD DRAWING CERTIFICATE
THESE DRAWINGS REFLECT
RECORDED INFORMATION OBTAINED
DURING CONSTRUCTION.
INFORMATION PROVIDED HEREIN
IS ACCURATE TO THE BEST OF
MY KNOWLEDGE.
M. Reynolds 2/07
NAME DATE





VILLAGE OF BEAVER
SANITATION IMPROVEMENTS
BATHROOM UPGRADES
SITE PLAN & BATHROOM LAYOUT
GEORGE YATLIN - BUILDING 13
SELENA PETRUSKA - BUILDING 15

REVISION	BY	DATE



Project No. 9966	Date MAY 2006	Designed M.L.	Drawn M.L.	Approved M.L.
------------------	---------------	---------------	------------	---------------

Sheet No.
SHEET C10 OF C20

File: 9966 Beaver_Record_C7-C20 Base.dwg

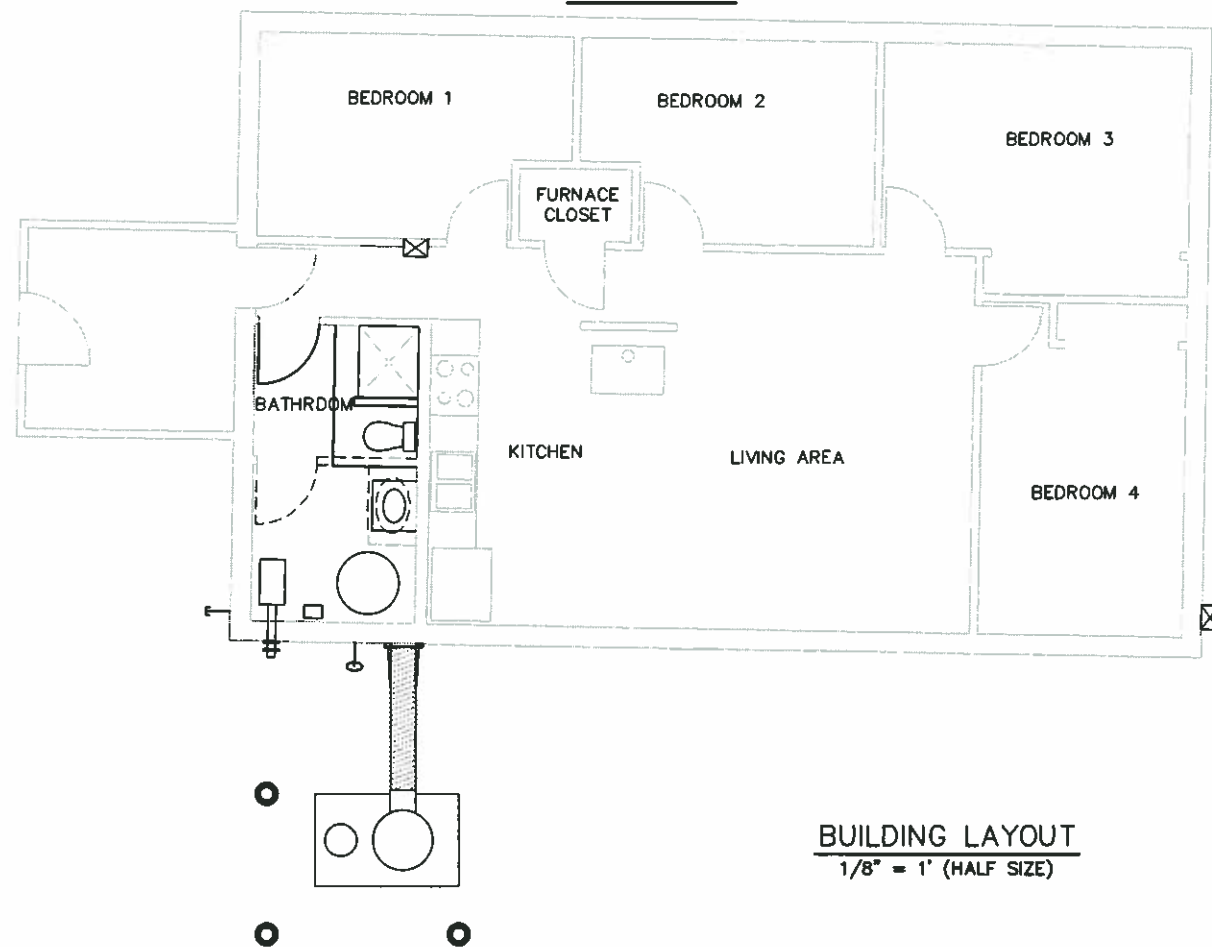
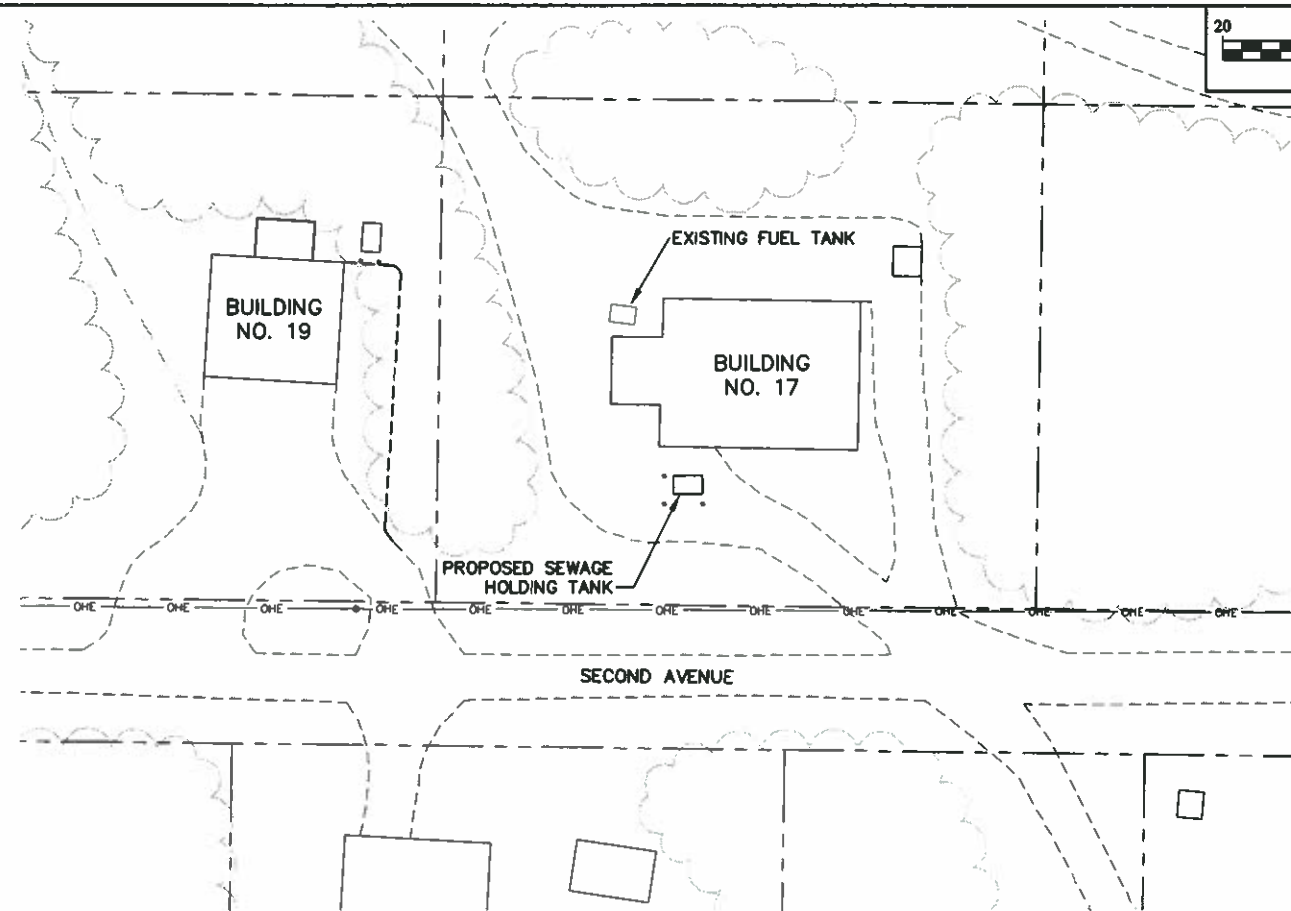




1 **BUILDING 17 - VIVIAN JUMEABY**
AS SHOWN

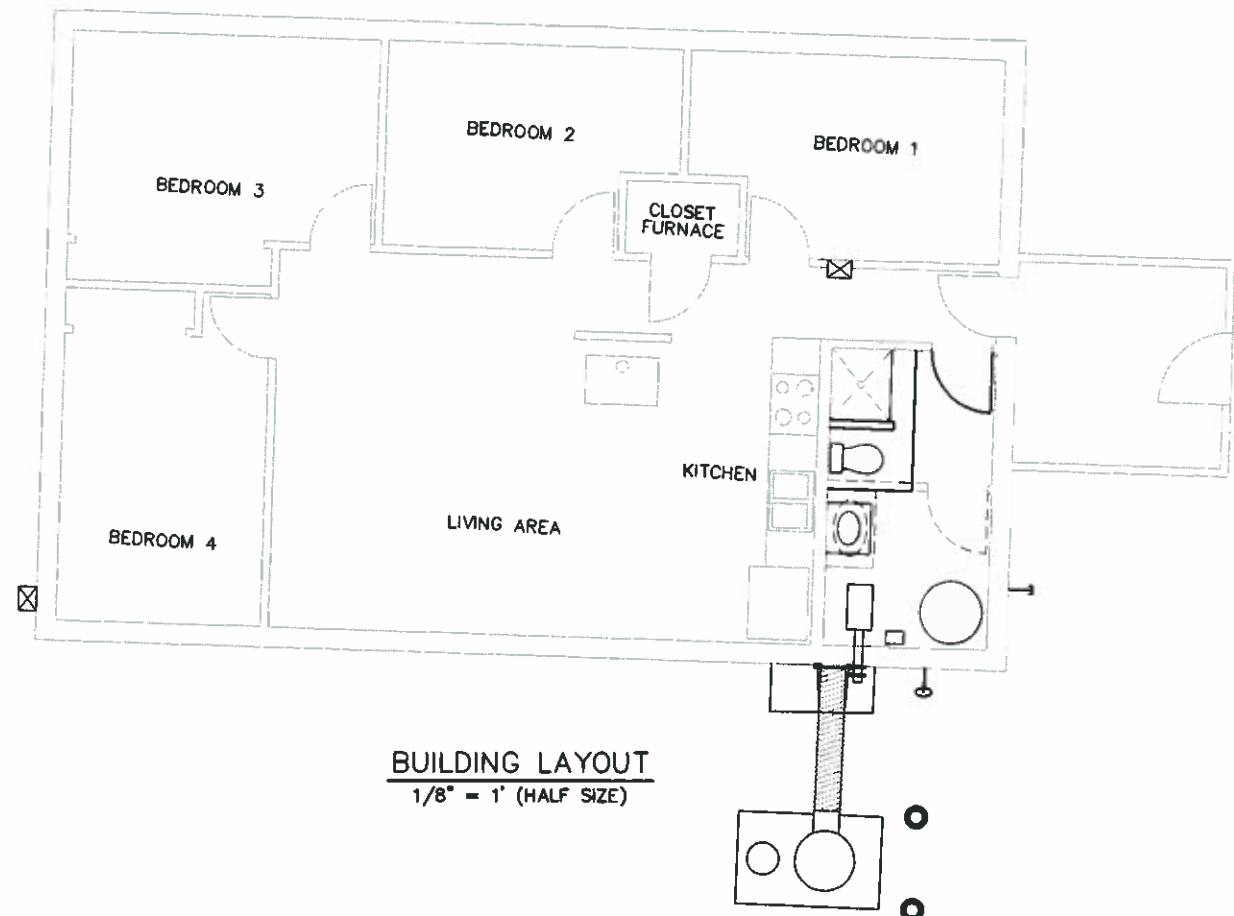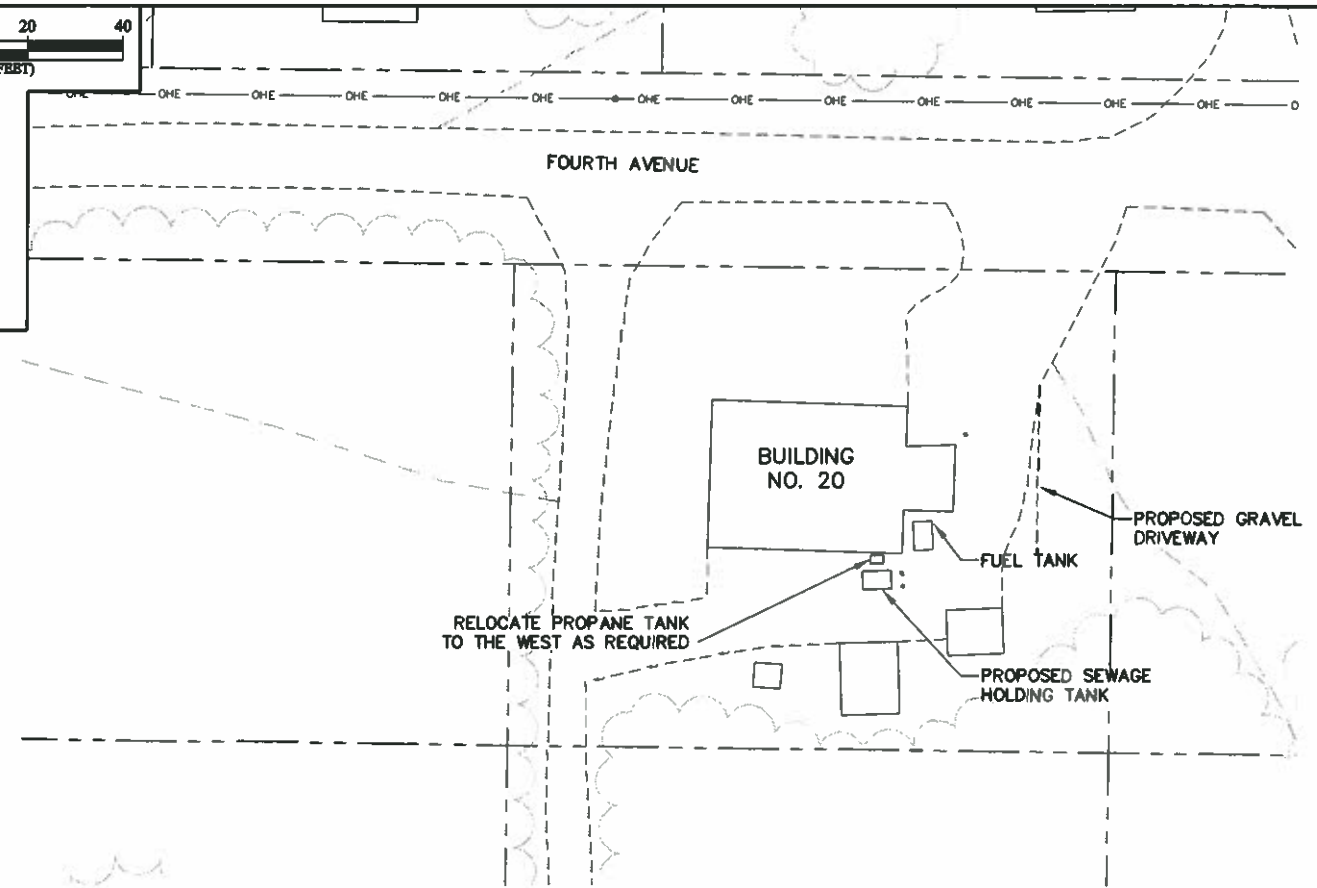

2 **BUILDING 20 - ANNA JOSEPH**
AS SHOWN



RECORD DRAWING CERTIFICATE	
THESE DRAWINGS REFLECT RECORDED INFORMATION OBTAINED DURING CONSTRUCTION. INFORMATION PROVIDED HEREIN IS ACCURATE TO THE BEST OF MY KNOWLEDGE.	
NAME: <i>m. Joseph</i> DATE: <i>2/10/07</i>	
STATE OF ALASKA 49th MICHAEL LEGUMINCH REGISTERED PROFESSIONAL ENGINEER 11006	
VILLAGE SAFE WATER	
STATE OF ALASKA 49th MICHAEL LEGUMINCH REGISTERED PROFESSIONAL ENGINEER 11006	
CRW ENGINEERING GROUP LLC 3900 ARCTIC BLVD, SUITE 203 ANCHORAGE, ALASKA 99503 PHONE: (907) 562-3322 FAX: (907) 561-2273	
VILLAGE OF BEAVER SANITATION IMPROVEMENTS BATHROOM UPGRADES SITE PLAN & BATHROOM LAYOUT VIVIAN JUMEABY -- BUILDING 17 ANNA JOSEPH -- BUILDING 20	
Project No. 9966	BY DATE
Date MAY 2006	
Designed M.L.	
Drawn M.L.	
Approved M.L.	
Sheet No.	
SHEET C11 OF C20	

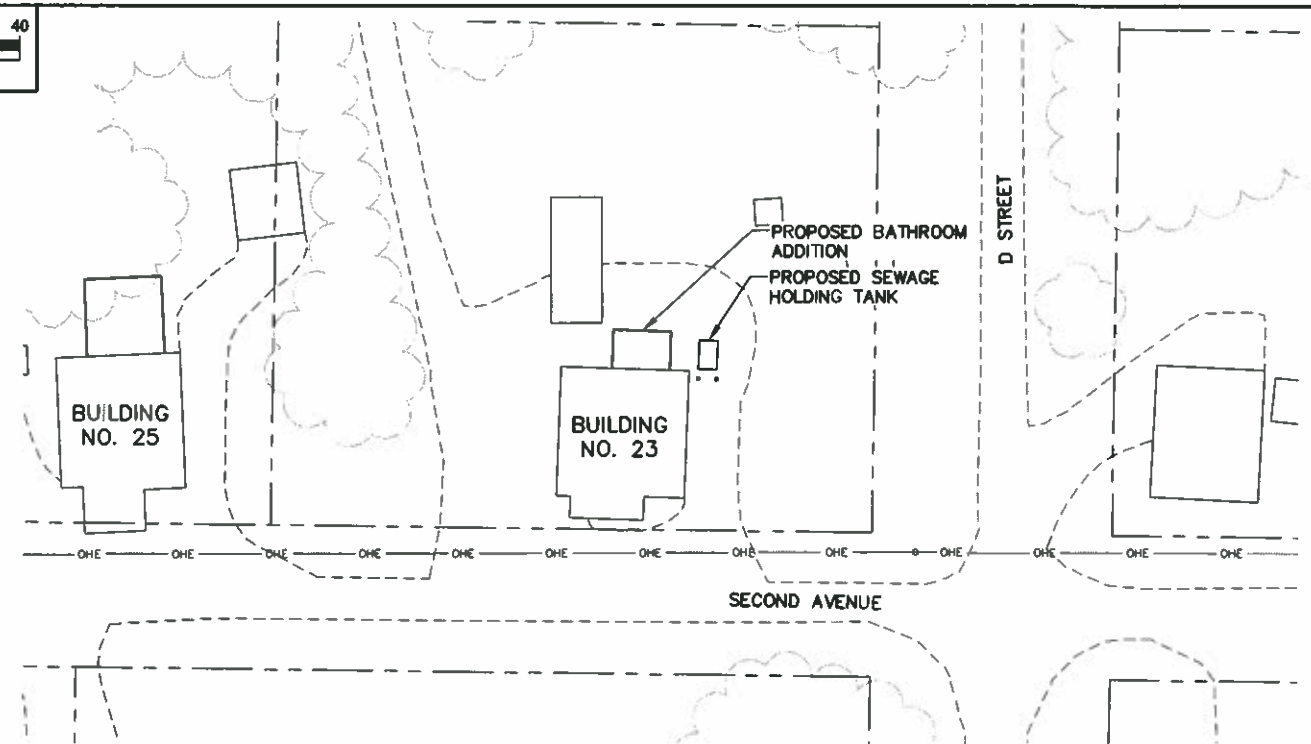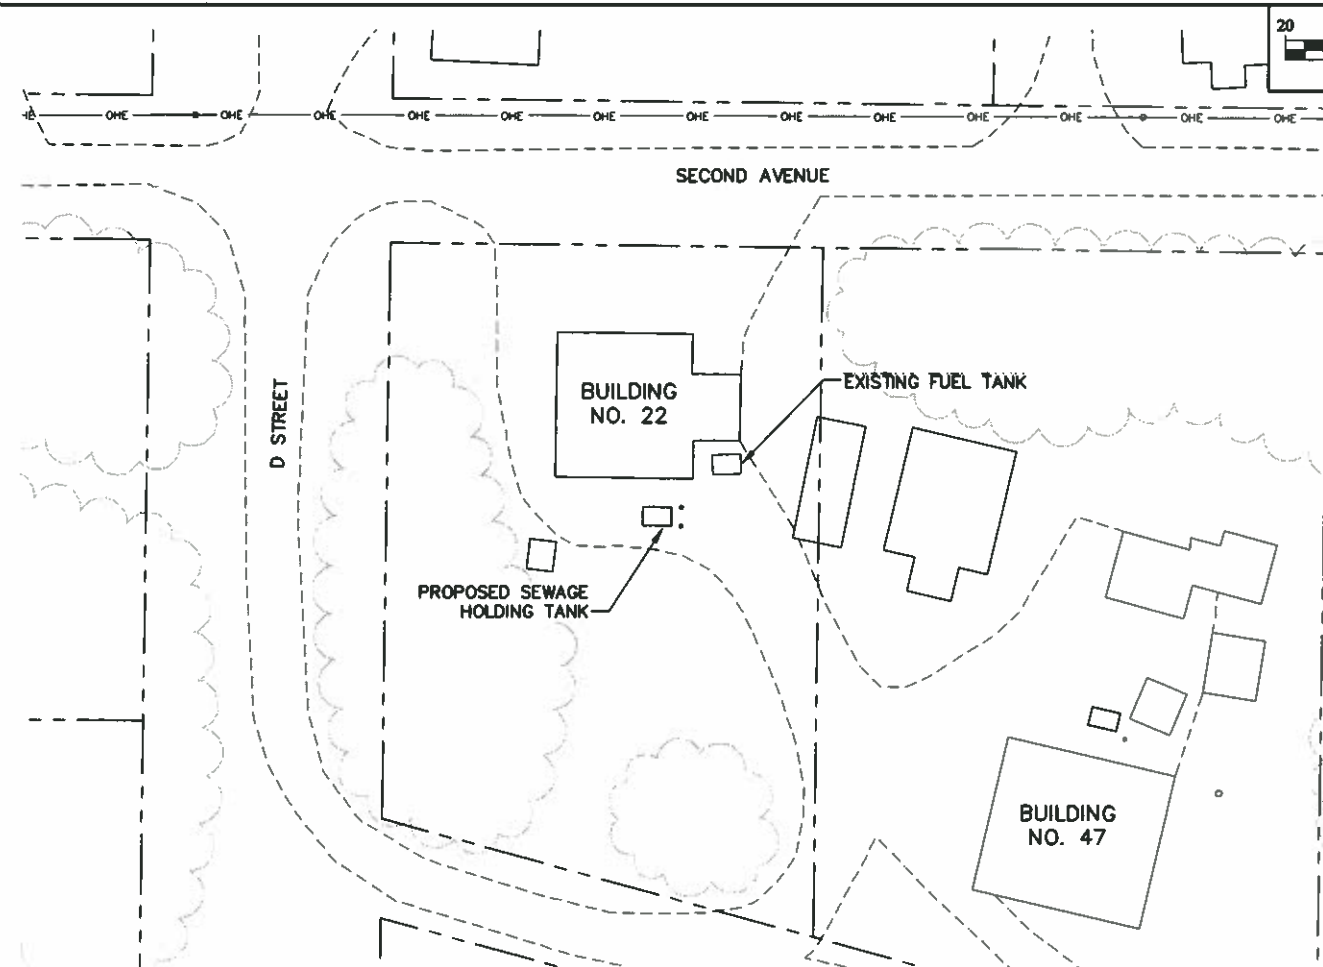[illegible]

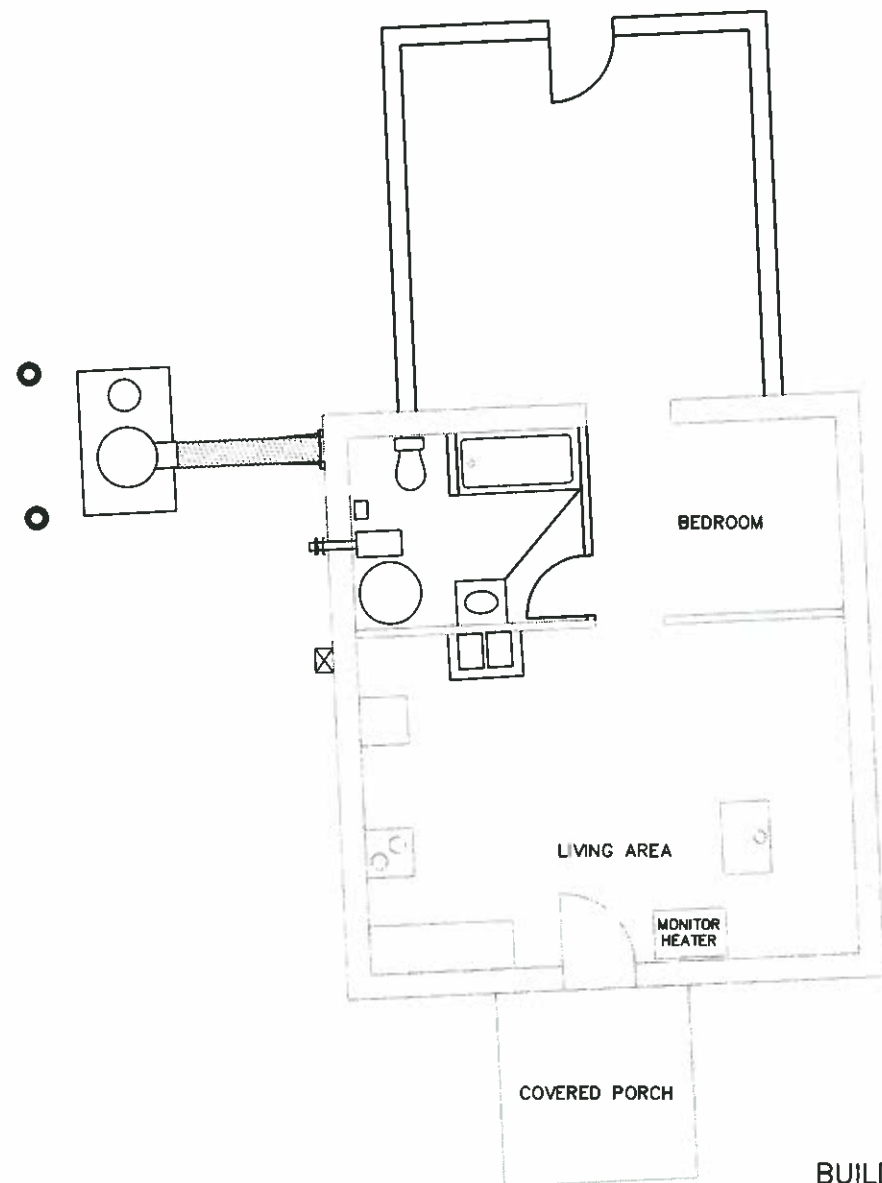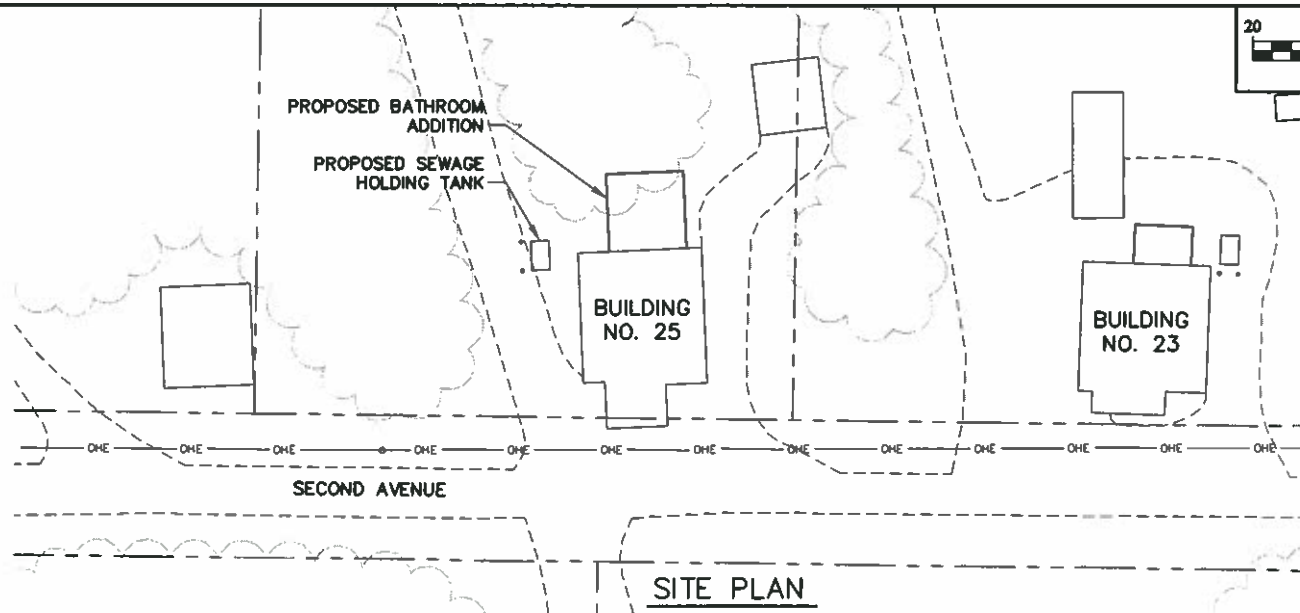

BUILDING LAYOUT
1/8" = 1' (HALF SIZE)


1 BUILDING 25 - NORA BILLY
AS SHOWN

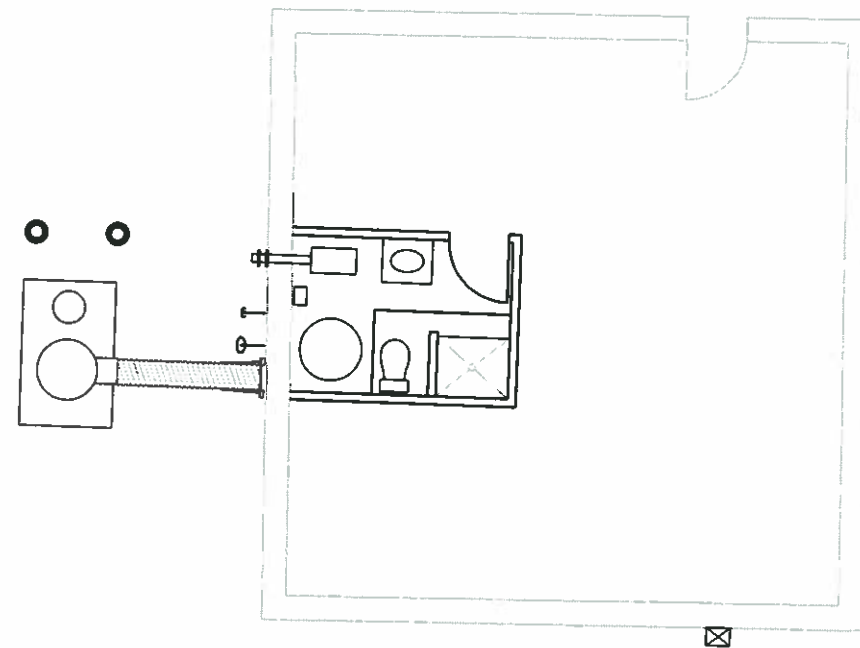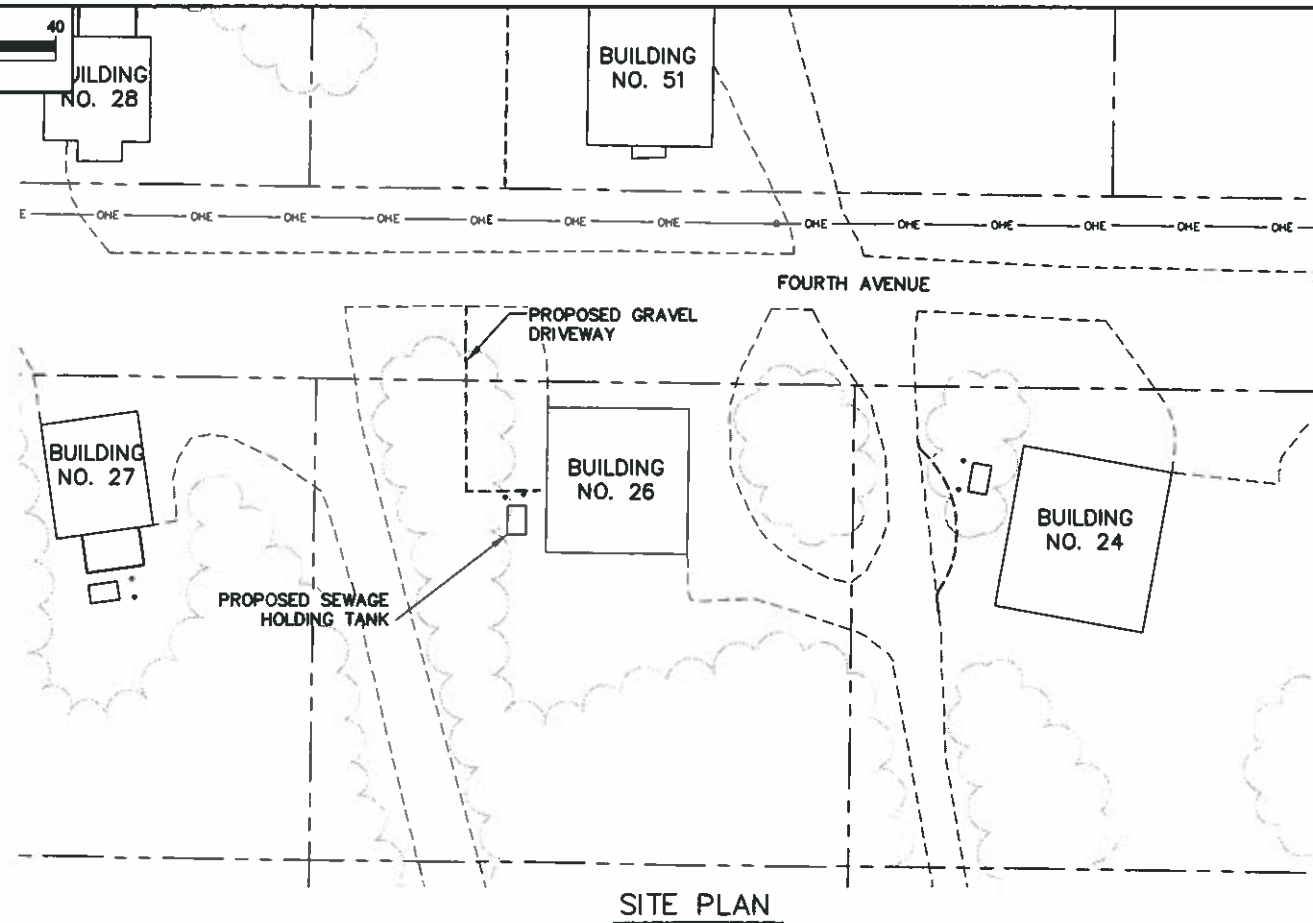

BUILDING LAYOUT
1/8" = 1' (HALF SIZE)

2 BUILDING 26 - ROY HENRY
AS SHOWN

RECORD DRAWING CERTIFICATE
THESE DRAWINGS REFLECT
RECORDED INFORMATION OBTAINED
DURING CONSTRUCTION
INFORMATION PROVIDED HEREIN
IS ACCURATE TO THE BEST OF
MY KNOWLEDGE.

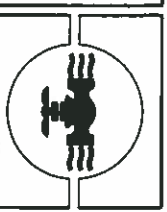



VILLAGE OF BEAVER
SANITATION IMPROVEMENTS
BATHROOM UPGRADES
SITE PLAN & BATHROOM LAYOUT
NORA BILLY - BUILDING 25
ROY HENRY - BUILDING 26

REVISION	BY	DATE

Project No.	9966
Date	MAY 2006
Designed	M.L.
Drawn	M.L.
Approved	M.L.



Sheet No.
SHEET C13 OF C20

File: 9966 Beaver_Record_C7-C20 Base.dwg

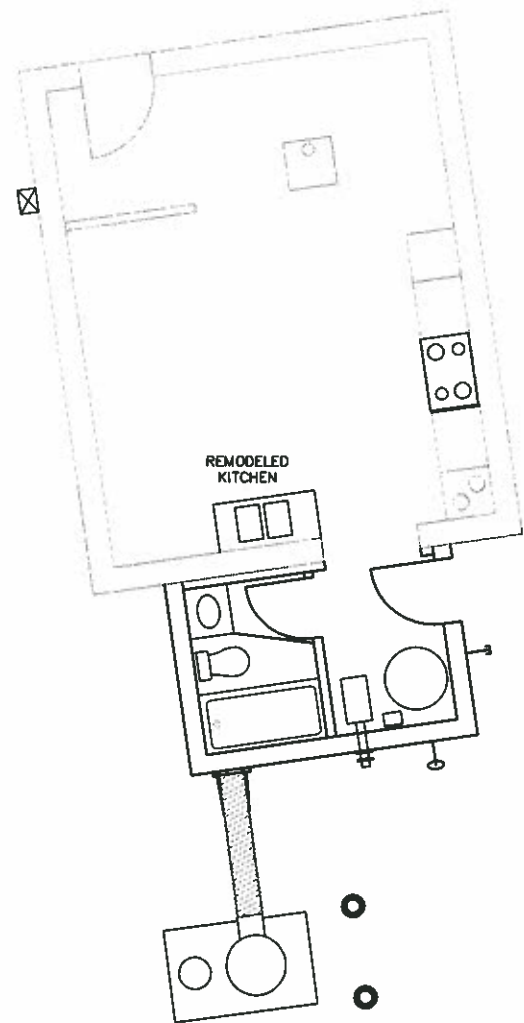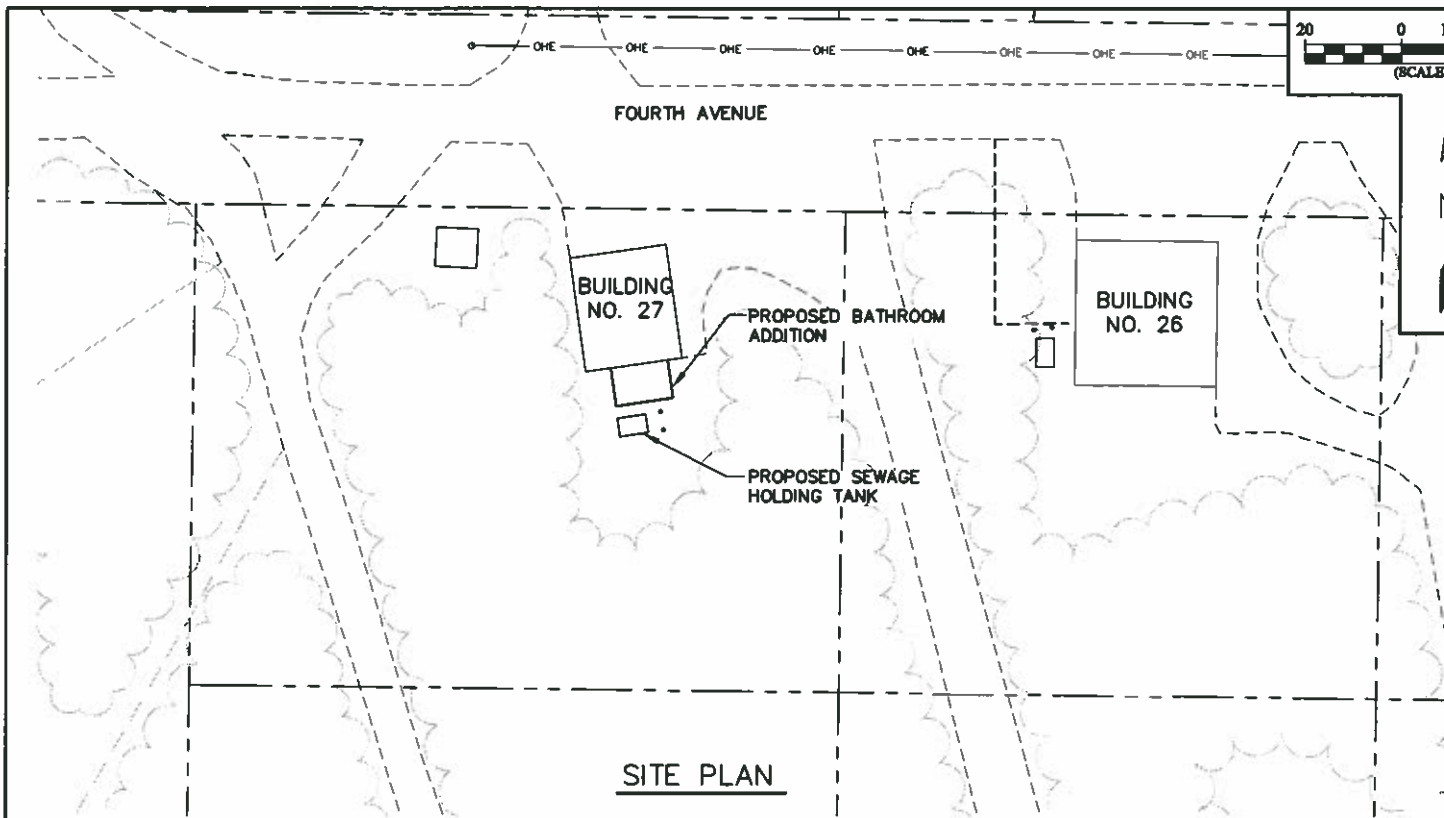

BUILDING LAYOUT
1/8" = 1' (HALF SIZE)

1
-
BUILDING 27 - HEATHER JOSEPH
AS SHOWN

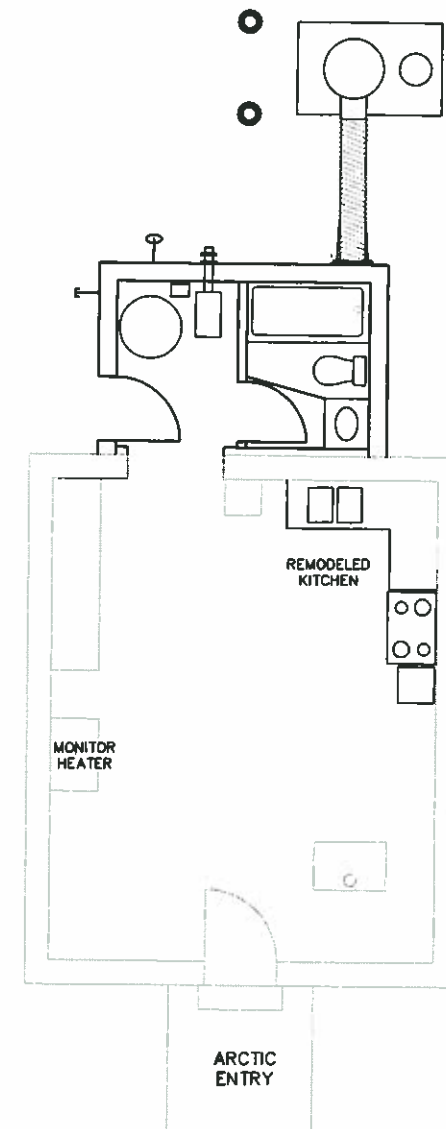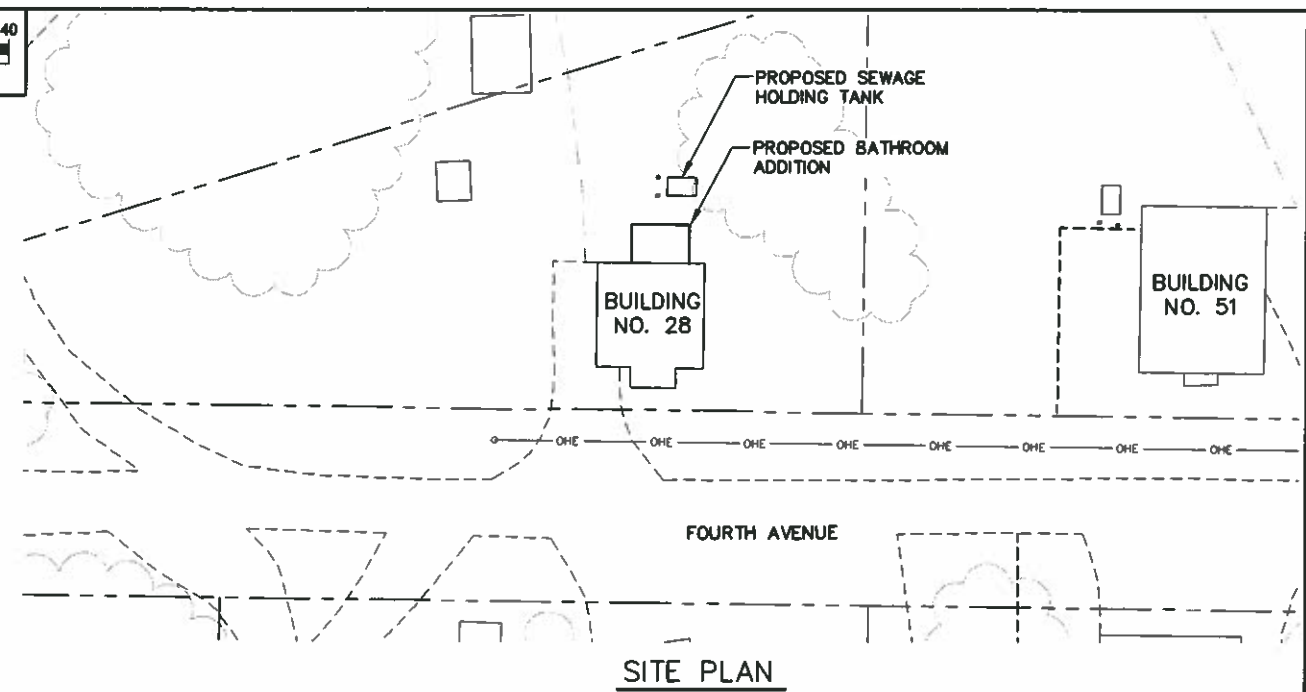

BUILDING LAYOUT
1/8" = 1' (HALF SIZE)

2
-
BUILDING 28 - SAM JOSEPH
AS SHOWN

RECORD DRAWING CERTIFICATE	
THESE DRAWINGS REFLECT RECORDED INFORMATION OBTAINED DURING CONSTRUCTION. INFORMATION PROVIDED HEREIN IS ACCURATE TO THE BEST OF MY KNOWLEDGE.	
STATE OF ALASKA 40 JUL MICHAEL LEQUINCH REGISTERED PROFESSIONAL 11006	NAME: <i>M. Joseph</i> 2101 DATE:




**VILLAGE OF BEAVER
SANITATION IMPROVEMENTS
BATHROOM UPGRADES
SITE PLAN & BATHROOM LAYOUT**
HEATHER JOSEPH - BUILDING 27
SAM JOSEPH - BUILDING 28

REVISION	BY	DATE


Project No.	9966
Date	MAY 2006
Designed	M.J.
Drawn	M.J.
Approved	M.J.

Sheet No.
SHEET C14 OF C20

File: 9966 Beaver_Record_C7-C20 Base.dwg

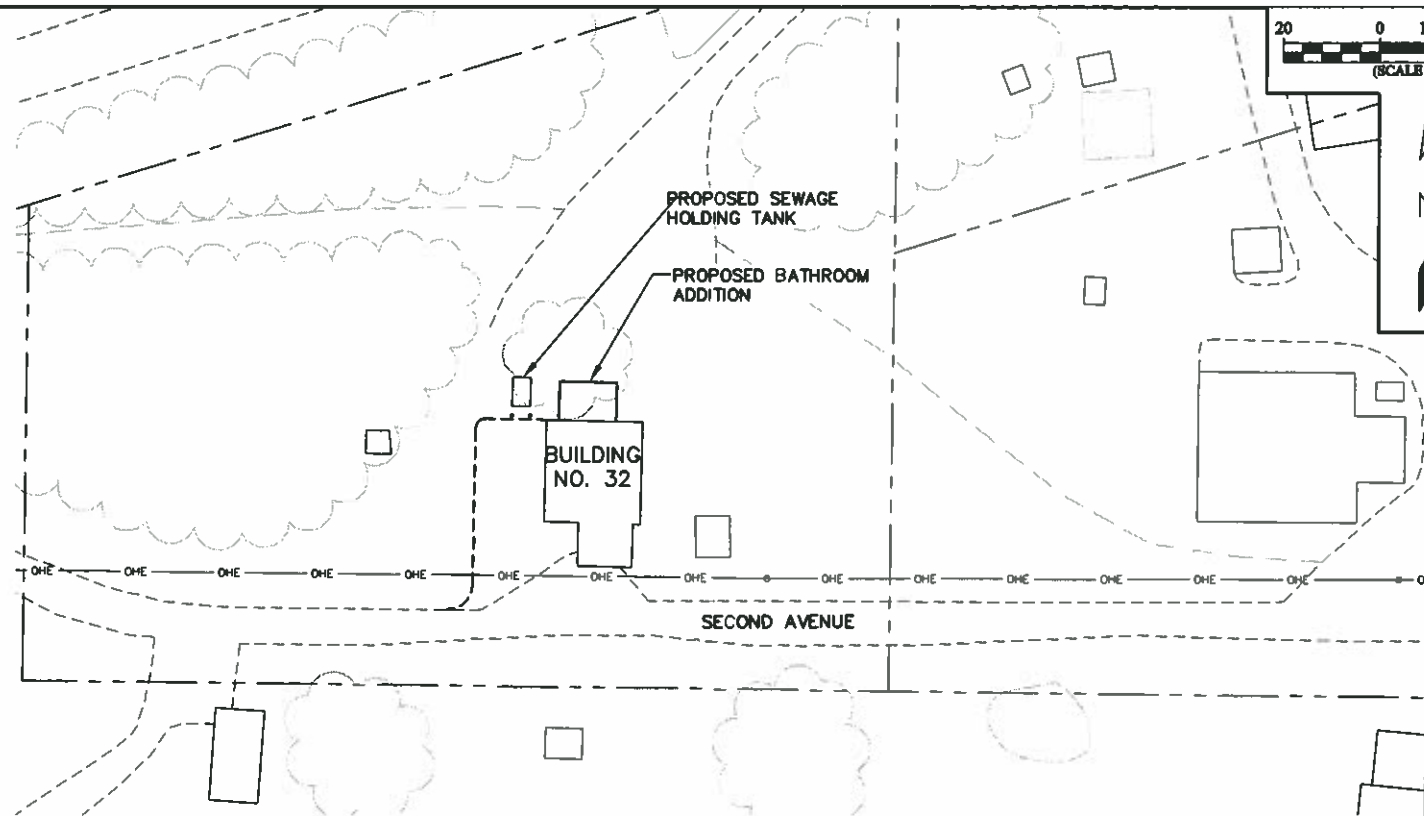



SITE PLAN

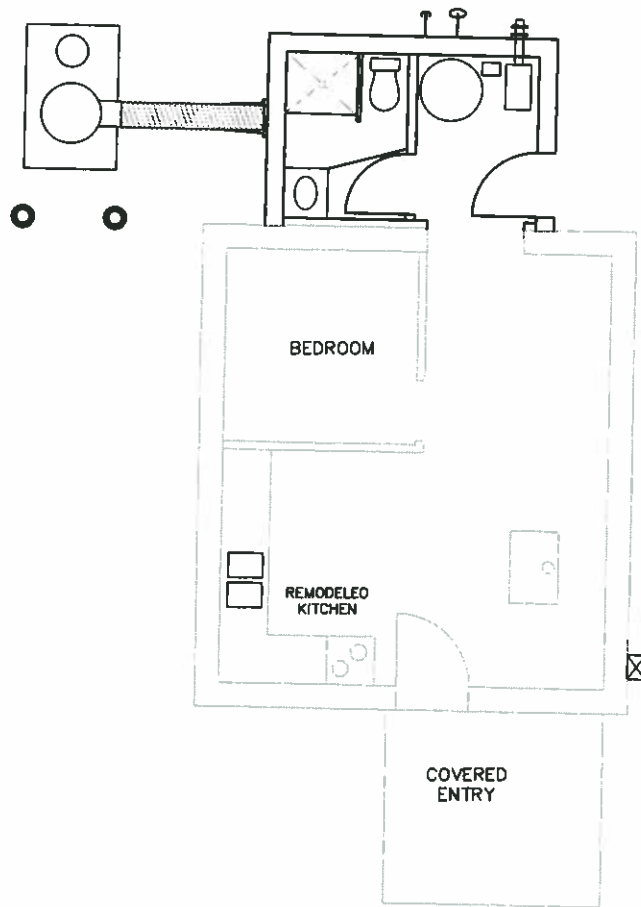


BUILDING LAYOUT
1/8" = 1' (HALF SIZE)

1

BUILDING 32 - JENNIE PITKA
AS SHOWN

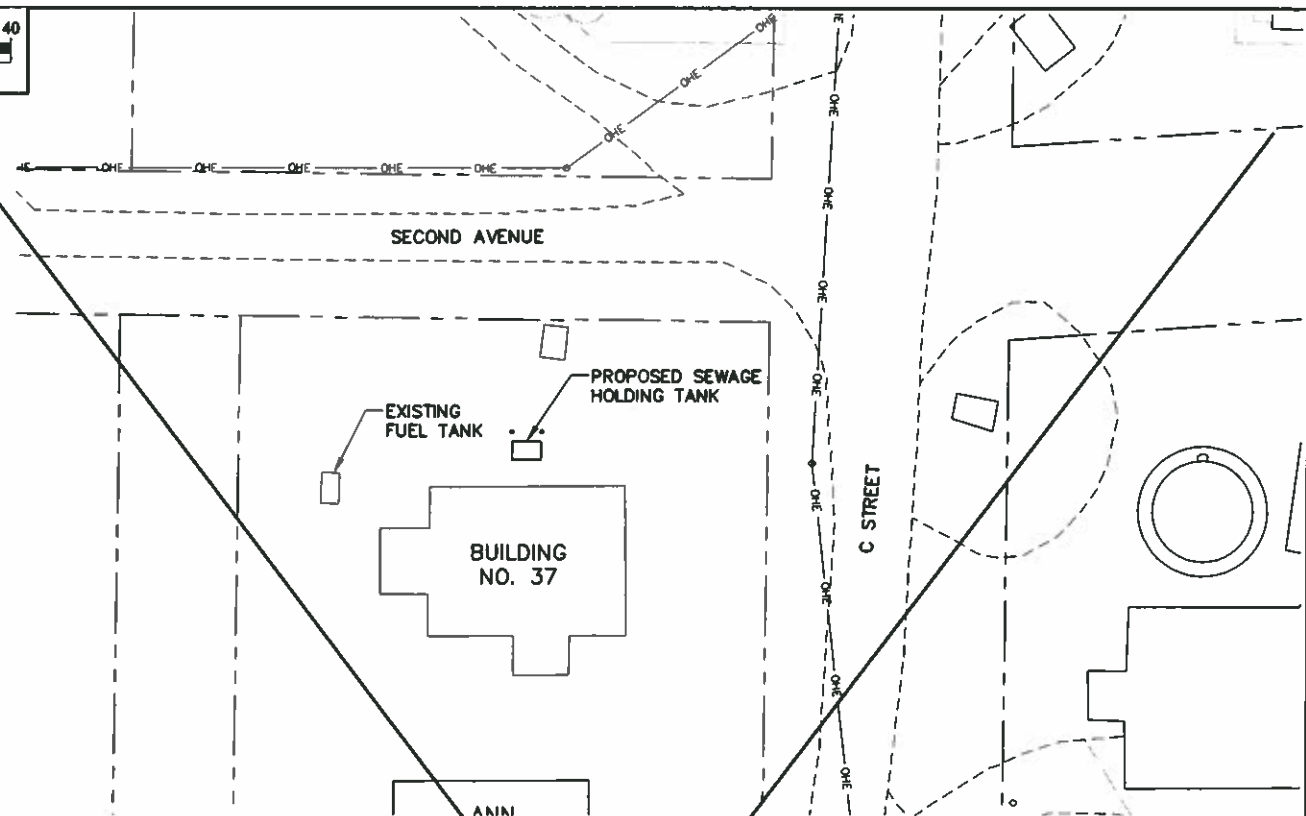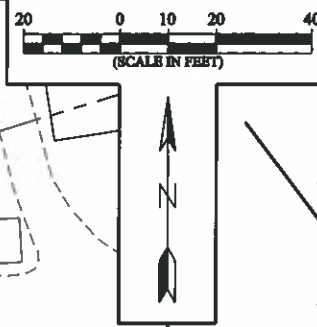

SITE PLAN

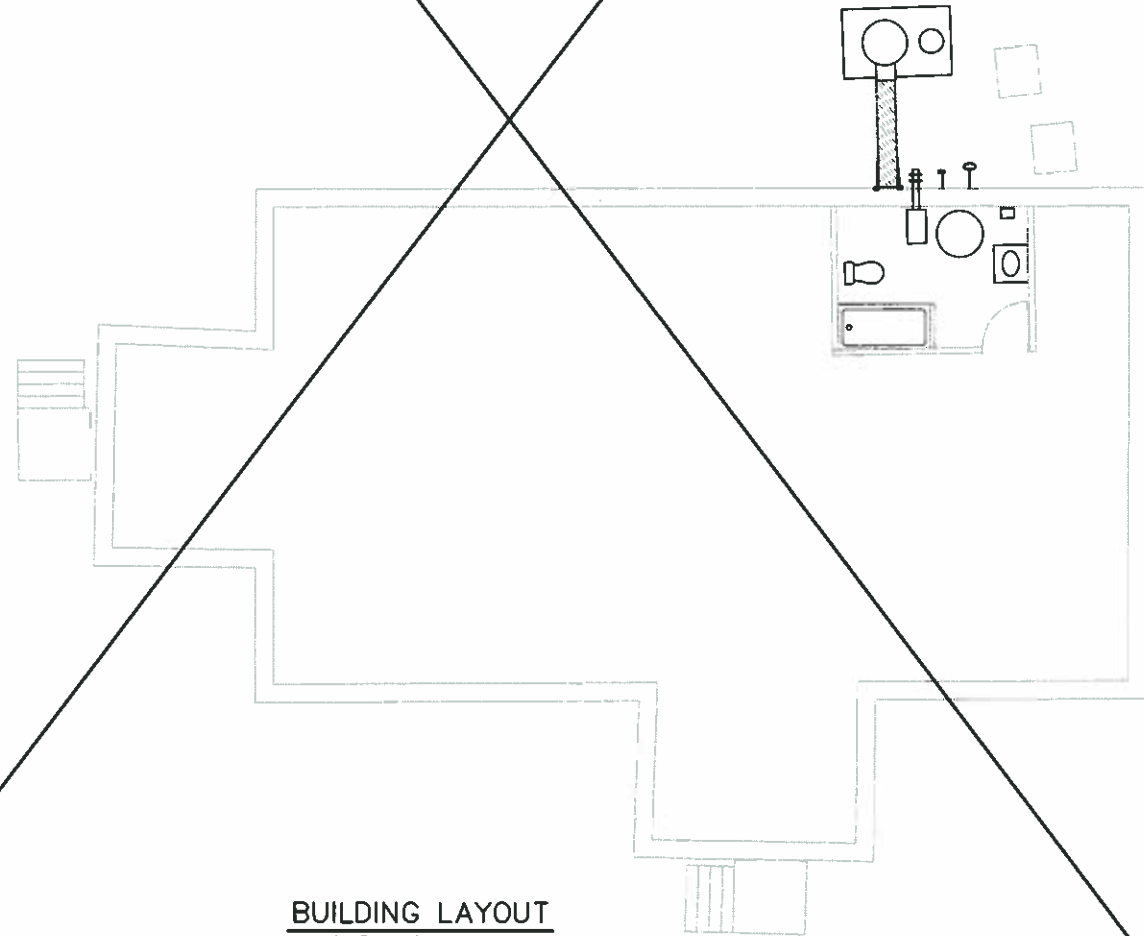


BUILDING LAYOUT
3/32" = 1' (HALF SIZE)

2


BUILDING 37 - CHARLEEN FISHER
AS SHOWN

RECORD DRAWING CERTIFICATE	
THESE DRAWINGS REFLECT RECORDED INFORMATION OBTAINED DURING CONSTRUCTION. INFORMATION PROVIDED HEREIN IS ACCURATE TO THE BEST OF MY KNOWLEDGE.	
NAME: <i>M. Legrand</i> DATE: <i>2/09</i>	
STATE OF ALASKA 49 31 MICHAEL LEGANECHE REGISTERED PROFESSIONAL ENGINEER 11006	
VILLAGE SAFE WATER	
STATE OF ALASKA 49 31 MICHAEL LEGANECHE REGISTERED PROFESSIONAL ENGINEER 11006	
CRW ENGINEERING GROUP LLC 3900 ARCTIC BLVD, SUITE 203 ANCHORAGE, ALASKA 99503 PHONE: (907) 582-3323 FAX: (907) 581-2273	
VILLAGE OF BEAVER SANITATION IMPROVEMENTS BATHROOM UPGRADES SITE PLAN & BATHROOM LAYOUT JENNIE PITKA - BUILDING 32 CHARLEEN FISHER - BUILDING 37	
Project No. 9966	BY DATE
Date MAY 2006	M.L. 2/09
Designed M.L.	
Drawn M.L.	
Approved M.L.	
Sheet No.	
SHEET C15 OF C20	

File: 9966 Beaver_Record_C7-C20 Base.dwg


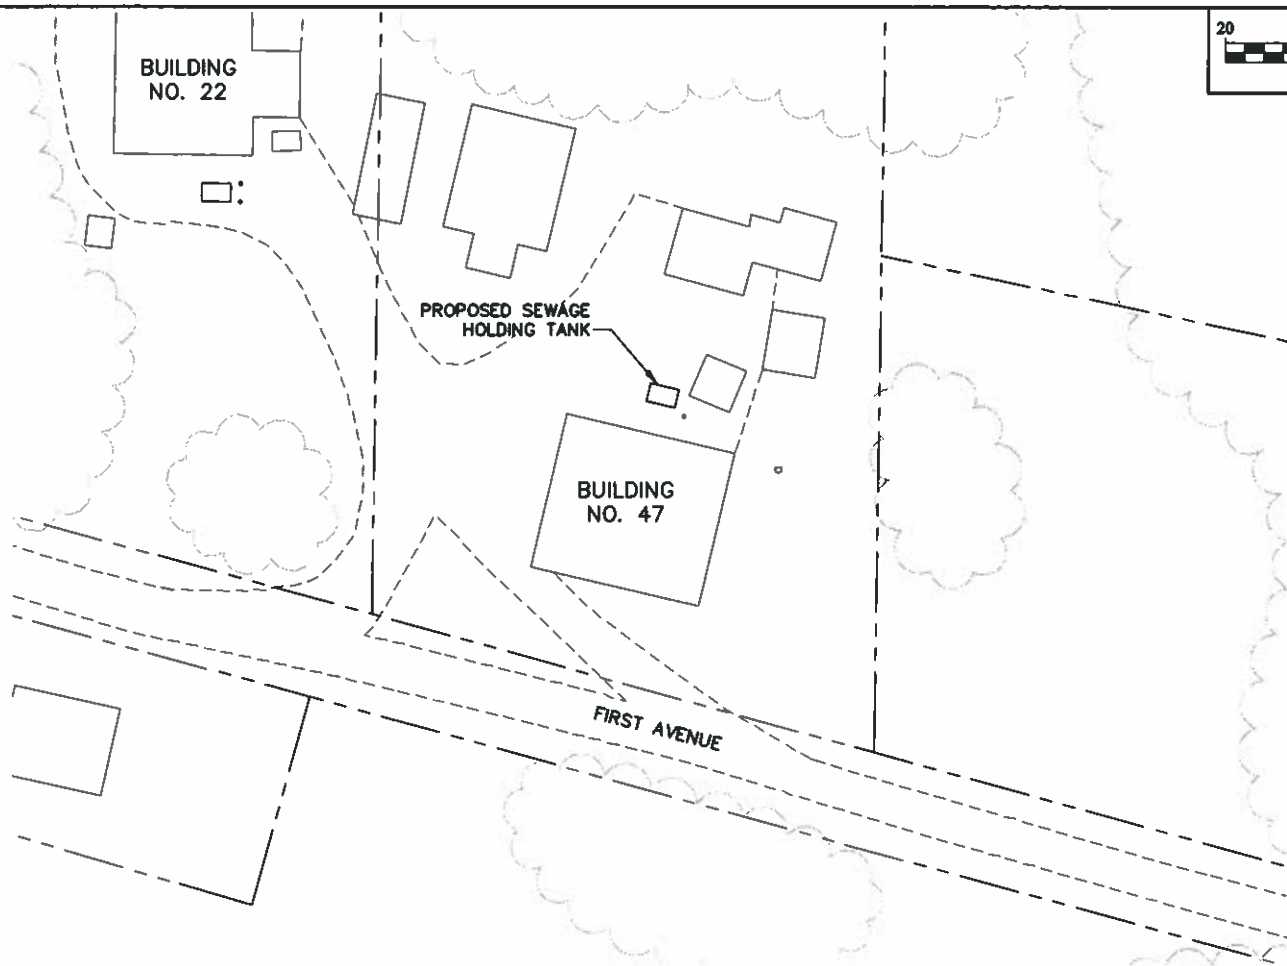


SITE PLAN

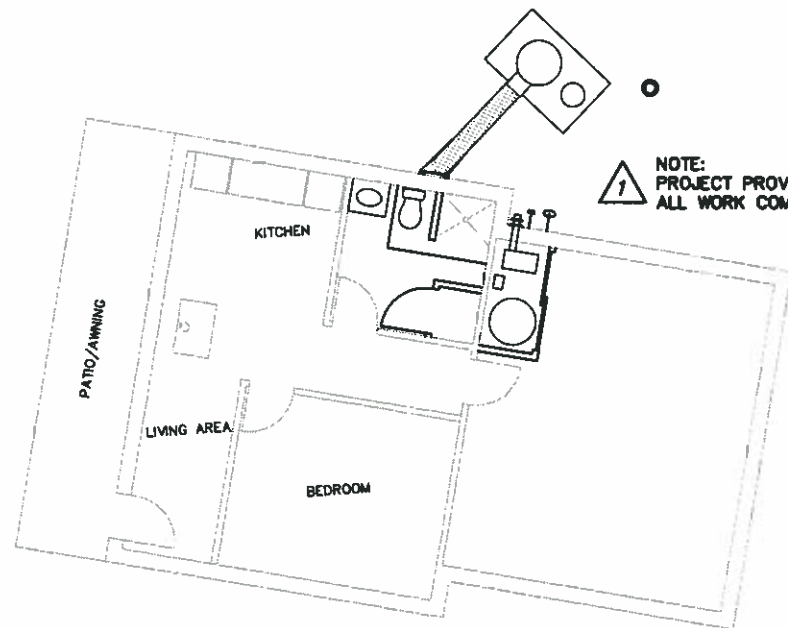


BUILDING LAYOUT
3/32" = 1' (HALF SIZE)

1
—
BUILDING 47 - CLIFFORD ADAMS
AS SHOWN

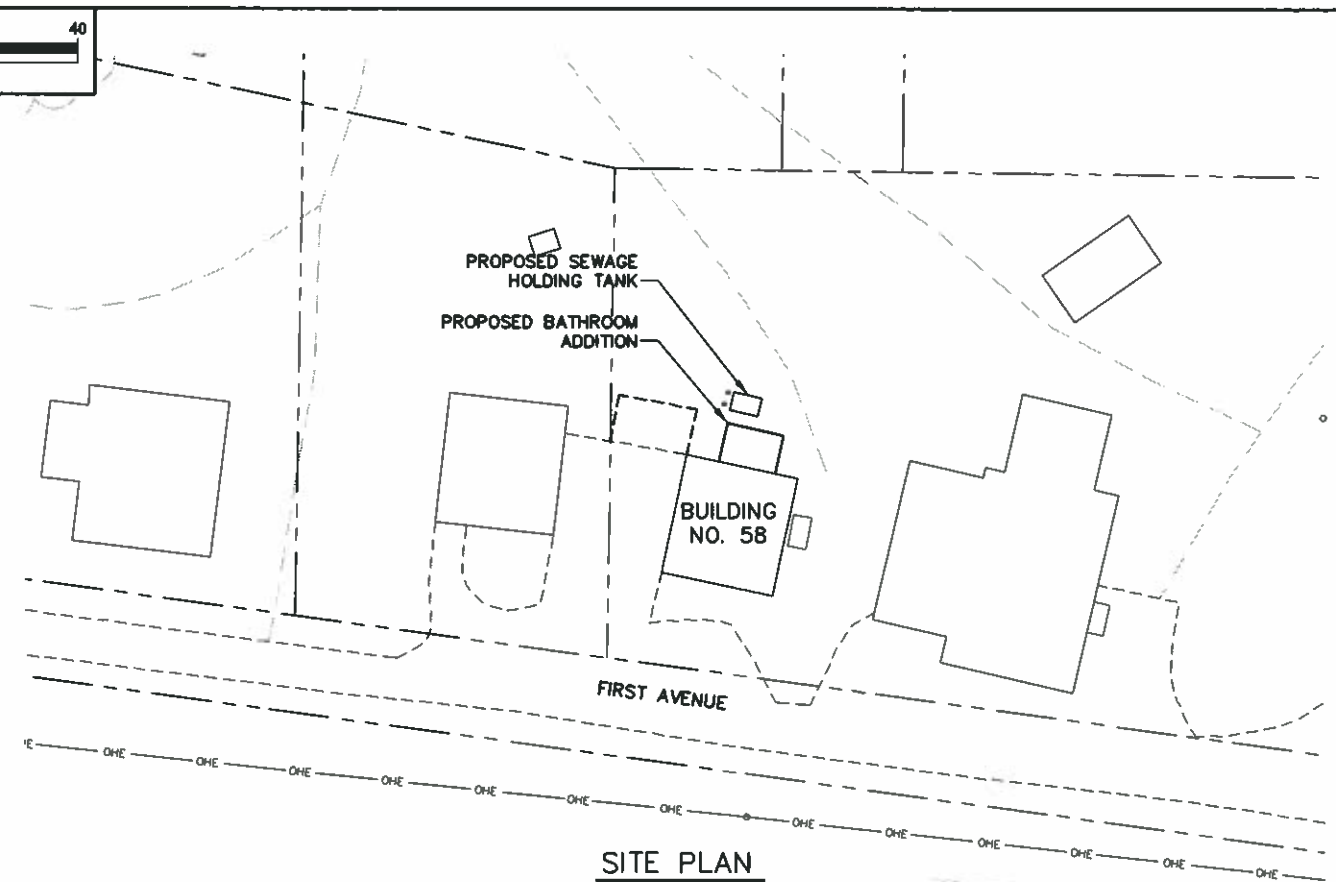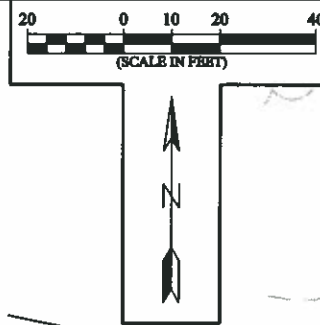


SITE PLAN

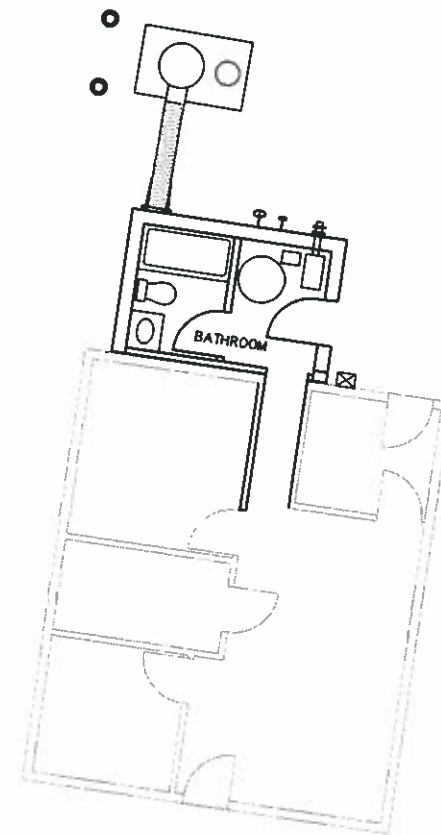

BUILDING LAYOUT
3/32" = 1' (HALF SIZE)

2
—
BUILDING 58 - THOMAS ADAMS
AS SHOWN

RECORD DRAWING CERTIFICATE
THESE DRAWINGS REFLECT
RECORDED INFORMATION OBTAINED
DURING CONSTRUCTION.
INFORMATION PROVIDED HEREIN
IS ACCURATE TO THE BEST OF
MY KNOWLEDGE.
M. Legrand 2/09
NAME DATE

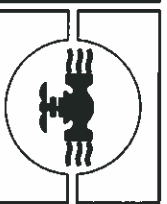

VILLAGE OF BEAVER
SANITATION IMPROVEMENTS
BATHROOM UPGRADES
SITE PLAN & BATHROOM LAYOUT
CLIFFORD ADAMS - BUILDING 47
THOMAS ADAMS - BUILDING 58

REVISION	BY	DATE
AS-BUILT	ML	2/09

Project No. 9966	Date MAY 2006	Designed M.L.	Drawn M.L.	Approved M.L.
------------------	---------------	---------------	------------	---------------

Sheet No.

SHEET C16 OF C20


File: 9966 Beaver_Record_C7-C20 Base.dwg

SITE PLAN

PROPOSED GRAVEL DRIVEWAY
PROPOSED SEWAGE HOLDING TANK


BUILDING NO. 66

A STREET

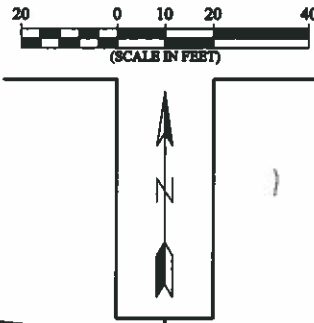

NOTE:
SEWAGE HOLDING TANK INSTALLED.
NO OTHER COMPONENTS INSTALLED.

BUILDING LAYOUT
3/32" = 1' (HALF SIZE)

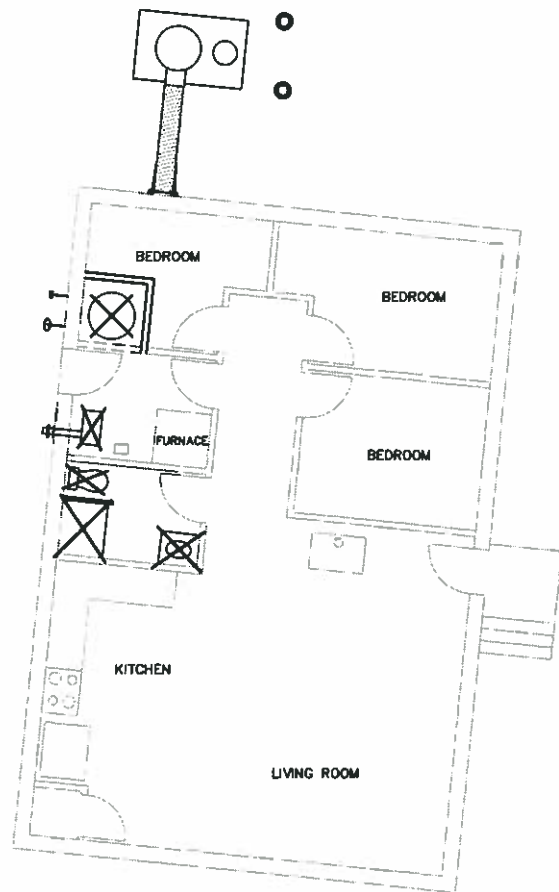

1
—

BUILDING 66 - MICHAEL WILLIAMS
AS SHOWN


SITE PLAN

PLACE GRAVEL FILL AROUND TANK AS NECESSARY TO PROVIDE ADEQUATE COVER
PROPOSED SEWAGE HOLDING TANK
EXISTING FUEL TANK
PROPOSED GRAVEL DRIVEWAY

BUILDING NO. 67

A STREET

BUILDING LAYOUT
3/32" = 1' (HALF SIZE)

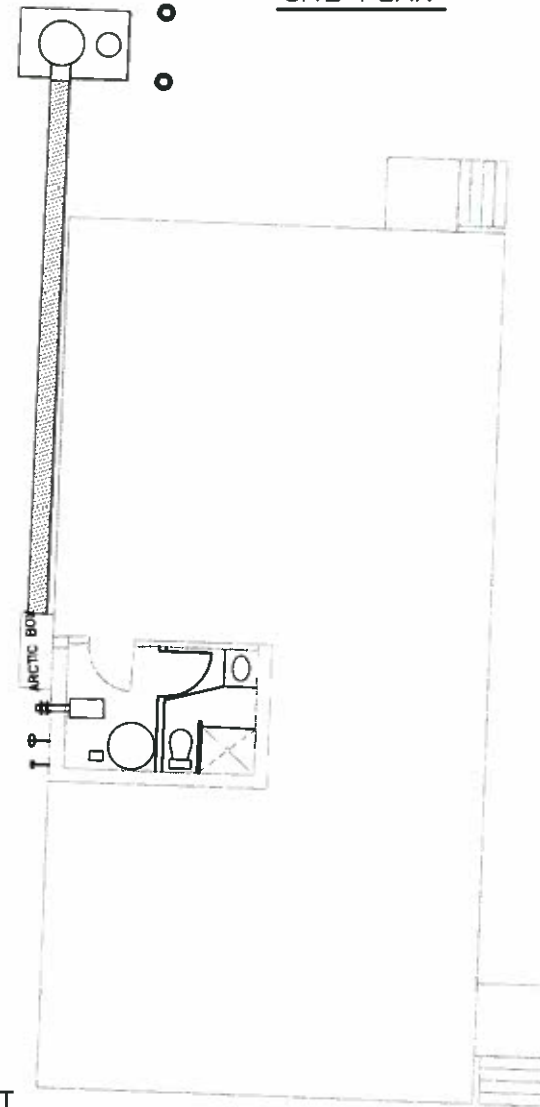

2
—

BUILDING 67 - BIRDIE BILLY
AS SHOWN

RECORD DRAWING CERTIFICATE
THESE DRAWINGS REFLECT
RECORDED INFORMATION OBTAINED
DURING CONSTRUCTION.
INFORMATION PROVIDED HEREIN
IS ACCURATE TO THE BEST OF
MY KNOWLEDGE.
NAME *M. Williams* DATE *2/09*



VILLAGE OF BEAVER
SANITATION IMPROVEMENTS
BATHROOM UPGRADES
SITE PLAN & BATHROOM LAYOUT
MICHAEL WILLIAMS - BUILDING 66
BIRDIE BILLY - BUILDING 67

REVISION	BY	DATE
AS-BUILT	ML	2/09

Project No. 9966	Date MAY 2006	Designed M.L.	Drawn M.L.	Approved M.L.
------------------	---------------	---------------	------------	---------------

Sheet No.

SHEET C17 OF C20

P:\16: 9966 Beaver_Record_C7-C20 Base.dwg

PROPOSED SEWAGE
HOLDING TANK
PROPOSED GRAVEL
DRIVEWAY

BUILDING
NO. 69

SITE PLAN

THIRD AVENUE

BEDROOM

BEDROOM

LIVING ROOM

KITCHEN


FUEL TANK

BUILDING LAYOUT
1/8" = 1' (HALF SIZE)

1
—

BUILDING 69 - DORTHEA ADAMS
AS SHOWN

20 0 10 20 40
(SCALE IN FEET)

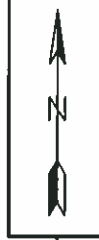

BUILDING
NO. 37

ANN
FISHER

SITE PLAN

HOUSE INFORMATION UNAVAILABLE
FIELD LOCATE IMPROVEMENTS

BUILDING LAYOUT
1/8" = 1' (HALF SIZE)

2
—

BUILDING UN - ANN FISHER
AS SHOWN

RECORD DRAWING CERTIFICATE

THESE DRAWINGS REFLECT
RECORDED INFORMATION OBTAINED
DURING CONSTRUCTION.
INFORMATION PROVIDED HEREIN
IS ACCURATE TO THE BEST OF
MY KNOWLEDGE.



VILLAGE OF BEAVER
SANITATION IMPROVEMENTS
BATHROOM UPGRADES
SITE PLAN & BATHROOM LAYOUT
DORTHEA ADAMS - BUILDING 69
ANN FISHER - BUILDING UN


REVISION	BY	DATE
AS-BUILT	ML	2/09

Project No.	9966
Date	MAY 2006
Designed	ML
Drawn	ML
Approved	ML

Sheet No.



SHEET C18 OF C20

File: 9966 Beaver_Record_C7-C20 Bases.dwg

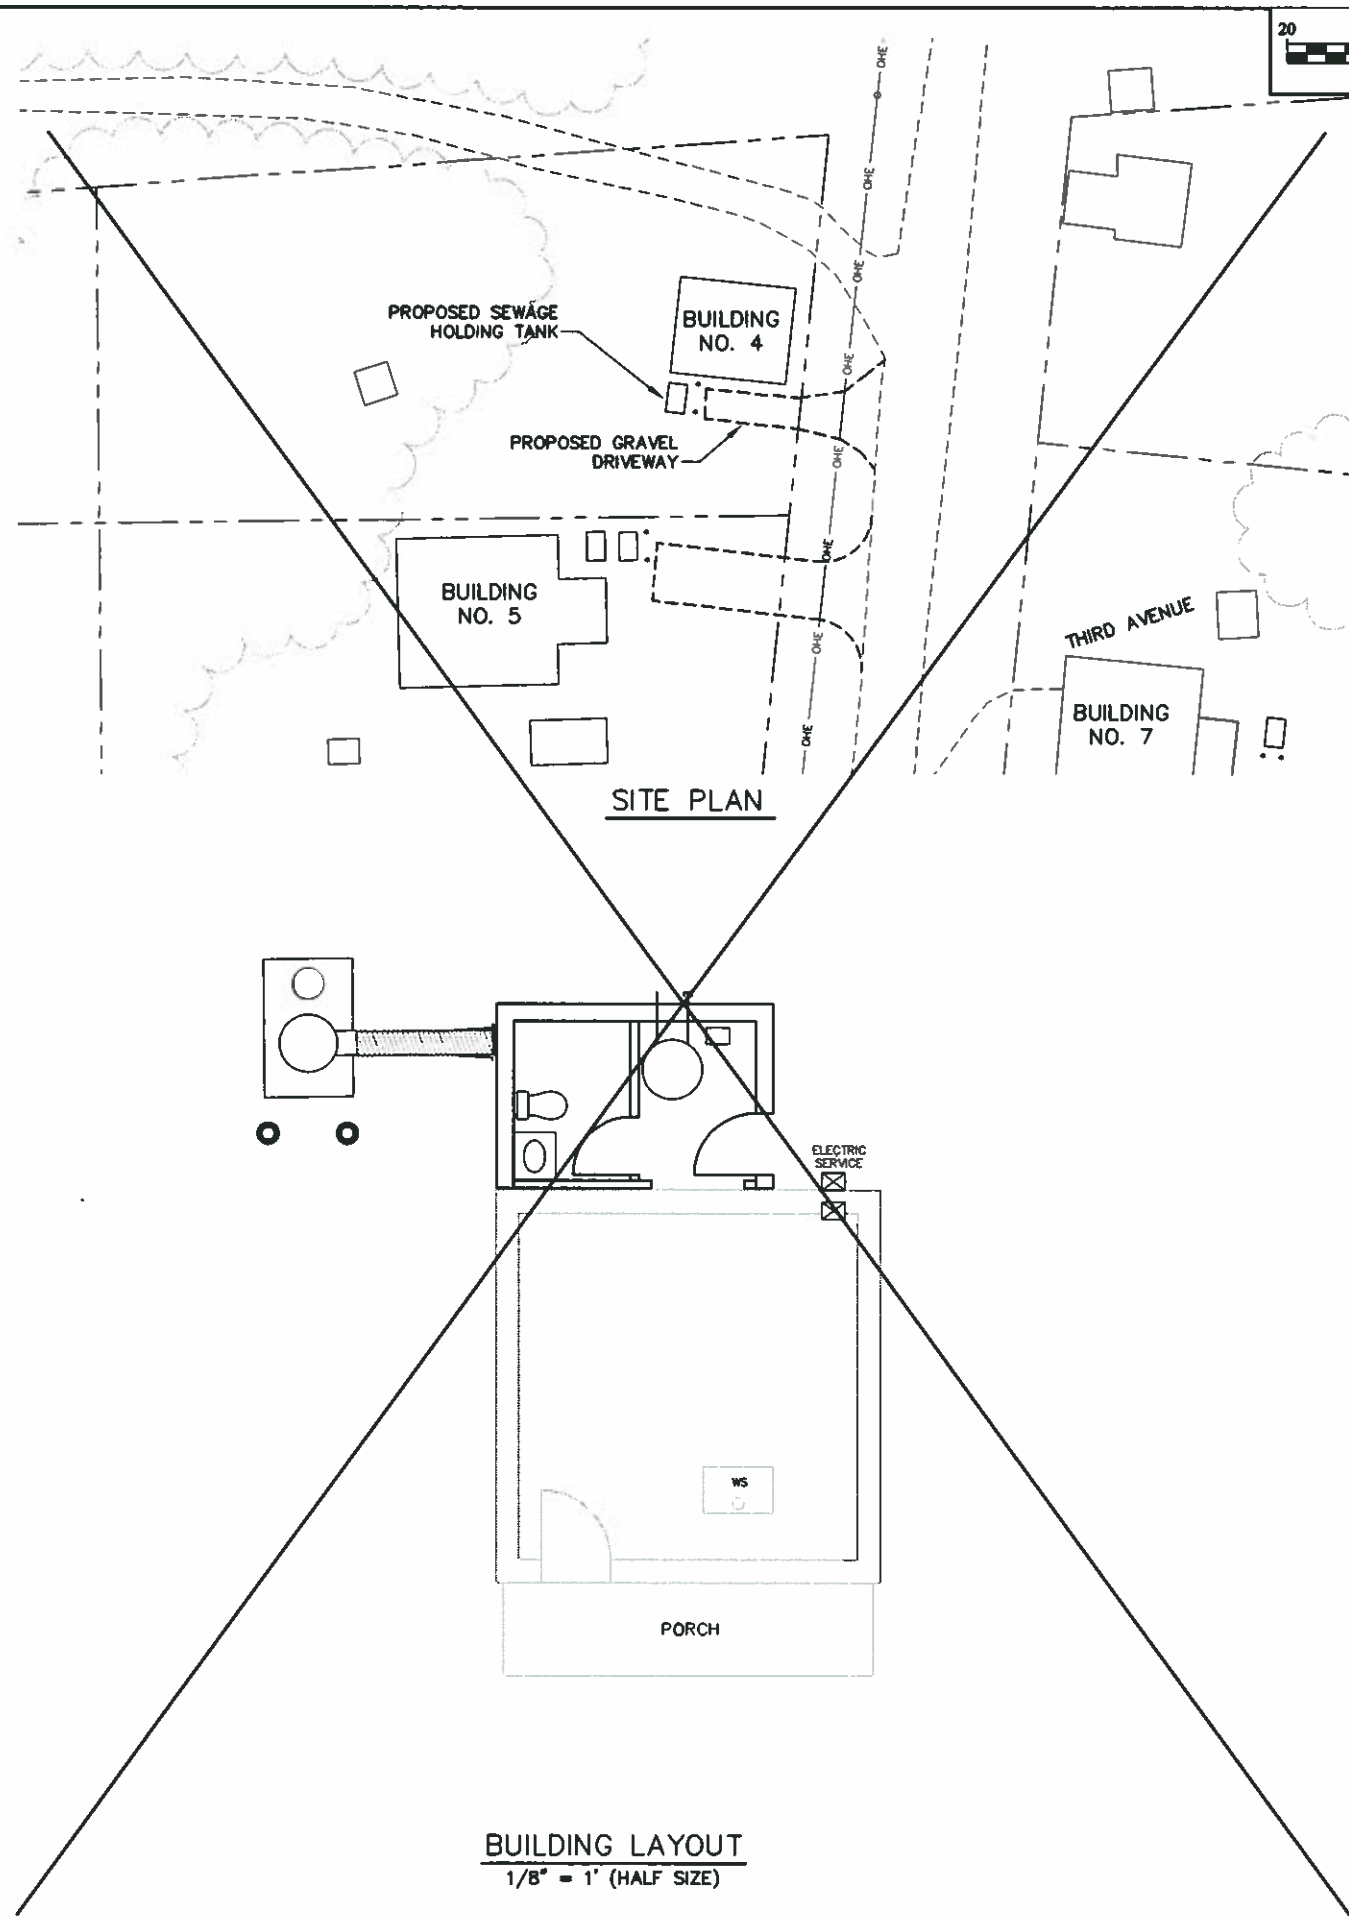

1
—


BUILDING 4 - BARBARA SOLARI
AS SHOWN

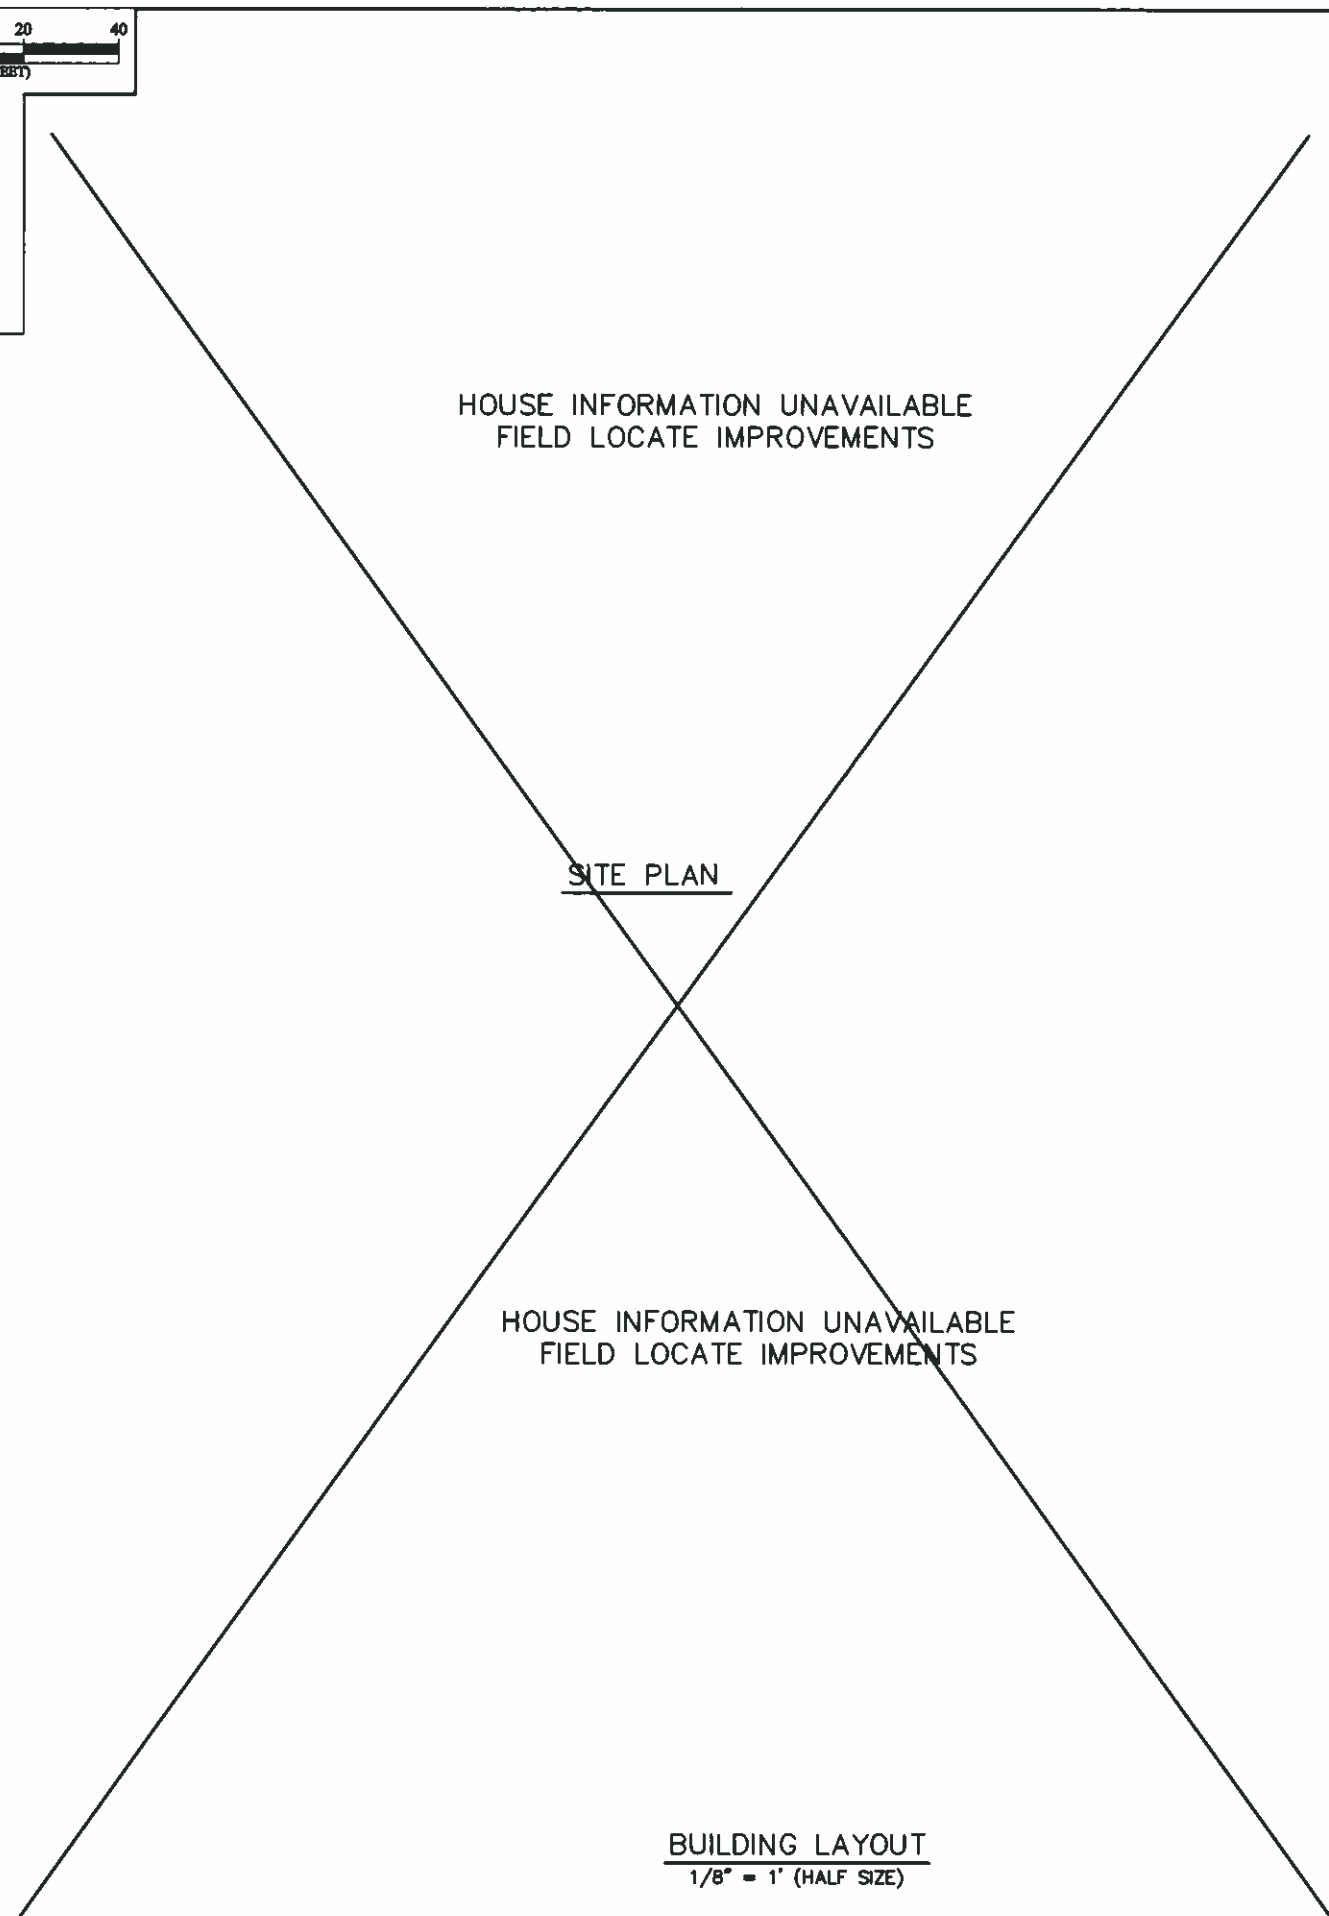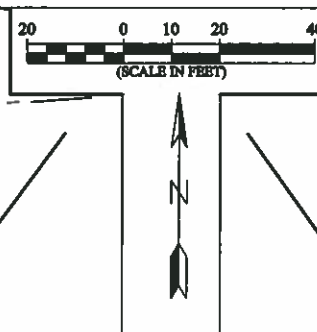

2
—

BUILDING UN - CHARLOTTE CRUIKSHANK
AS SHOWN

RECORD DRAWING CERTIFICATE
THESE DRAWINGS REFLECT
RECORDED INFORMATION OBTAINED
DURING CONSTRUCTION
INFORMATION PROVIDED HEREIN
IS ACCURATE TO THE BEST OF
MY KNOWLEDGE.
M. Agnew
NAME
DATE

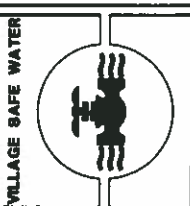


VILLAGE OF BEAVER
SANITATION IMPROVEMENTS
BATHROOM UPGRADES
SITE PLAN & BATHROOM LAYOUT
BARBARA SOLARI - BUILDING 4
CHARLOTTE CRUIKSHANK - BUILDING UN

REVISION	BY	DATE
AS-BUILT	ML	2/09

Project No.	9966
Date	MAY - 2006
Designed	ML
Drawn	ML
Approved	ML

Sheet No.
SHEET C19 OF C20

File: 9966 Beaver_Record_C7-C20 Base.dwg

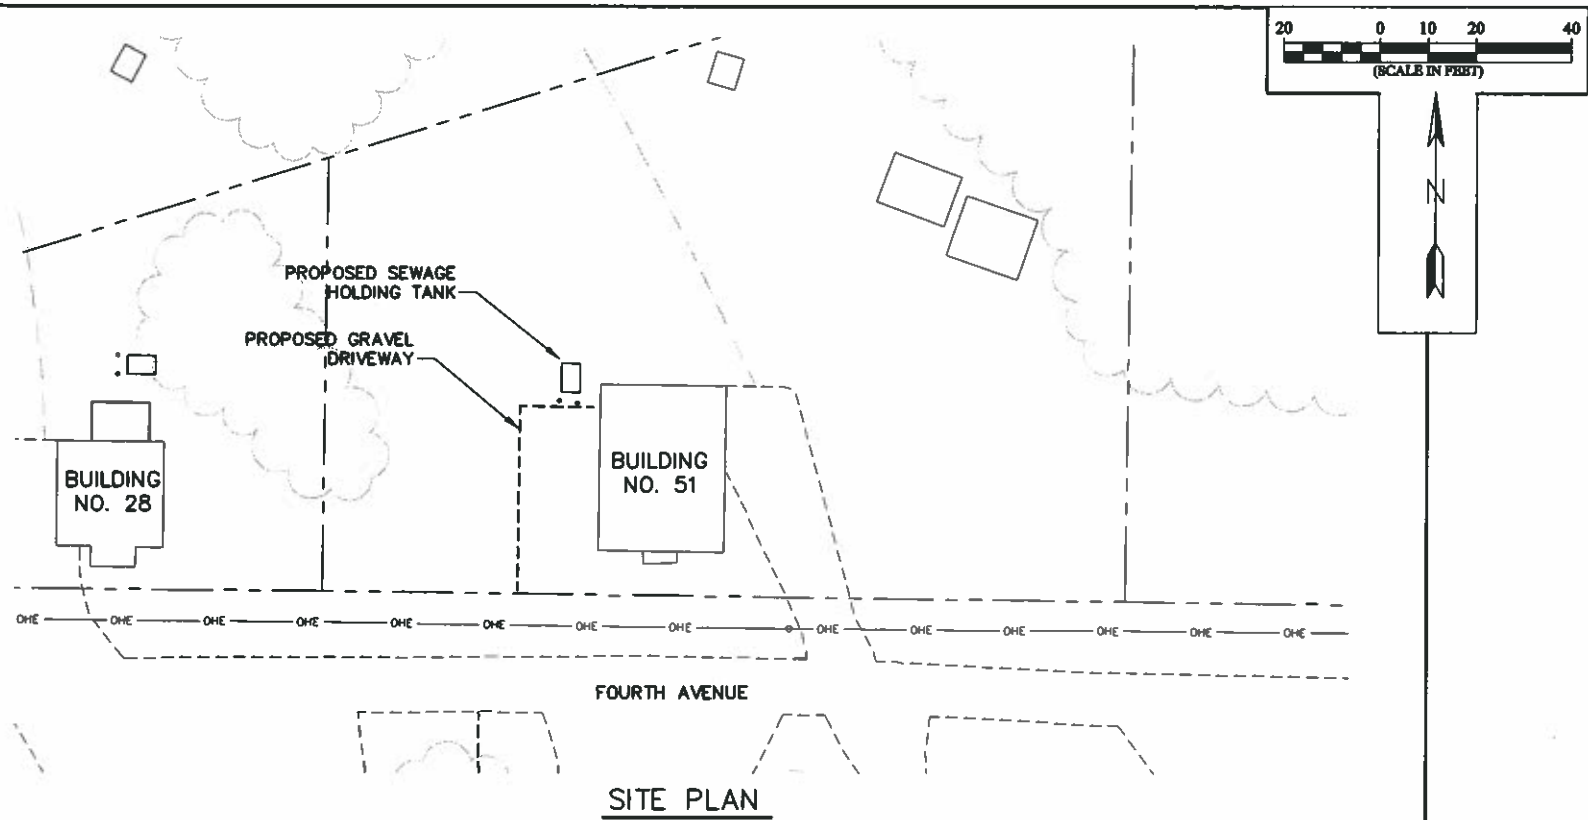

SITE PLAN

HOUSE INFORMATION UNAVAILABLE
FIELD LOCATE IMPROVEMENTS

BUILDING LAYOUT
1/8" = 1' (HALF SIZE)

1
—

BUILDING 51 - CHARLIE YATLIN
AS SHOWN

RECORD DRAWING CERTIFICATE
THESE DRAWINGS REFLECT
RECORDED INFORMATION OBTAINED
DURING CONSTRUCTION.
INFORMATION PROVIDED HEREIN
IS ACCURATE TO THE BEST OF
MY KNOWLEDGE.
M. Legum
NAME: DATE: 2/10

STATE OF ALASKA
49 TH
MICHAEL LEGUM
REGISTERED PROFESSIONAL ENGINEER
11006

VILLAGE OF BEAVER


CRW
ENGINEERING GROUP, LLC
3800 ARCTIC BLVD. SUITE 203
ANCHORAGE, ALASKA 99503
PHONE: (907) 582-3232
FAX: (907) 581-2273

VILLAGE OF BEAVER
SANITATION IMPROVEMENTS
BATHROOM UPGRADES
SITE PLAN & BATHROOM LAYOUT
CHARLIE YATLIN - BUILDING 51

REVISION	BY	DATE
AS-BUILT	ML	2/09

Project No. 9966	Date MAY 2006	Designed M.J.L.	Drawn M.J.L.	Approved M.J.L.
------------------	---------------	-----------------	--------------	-----------------

Sheet No.
SHEET C20 OF C20

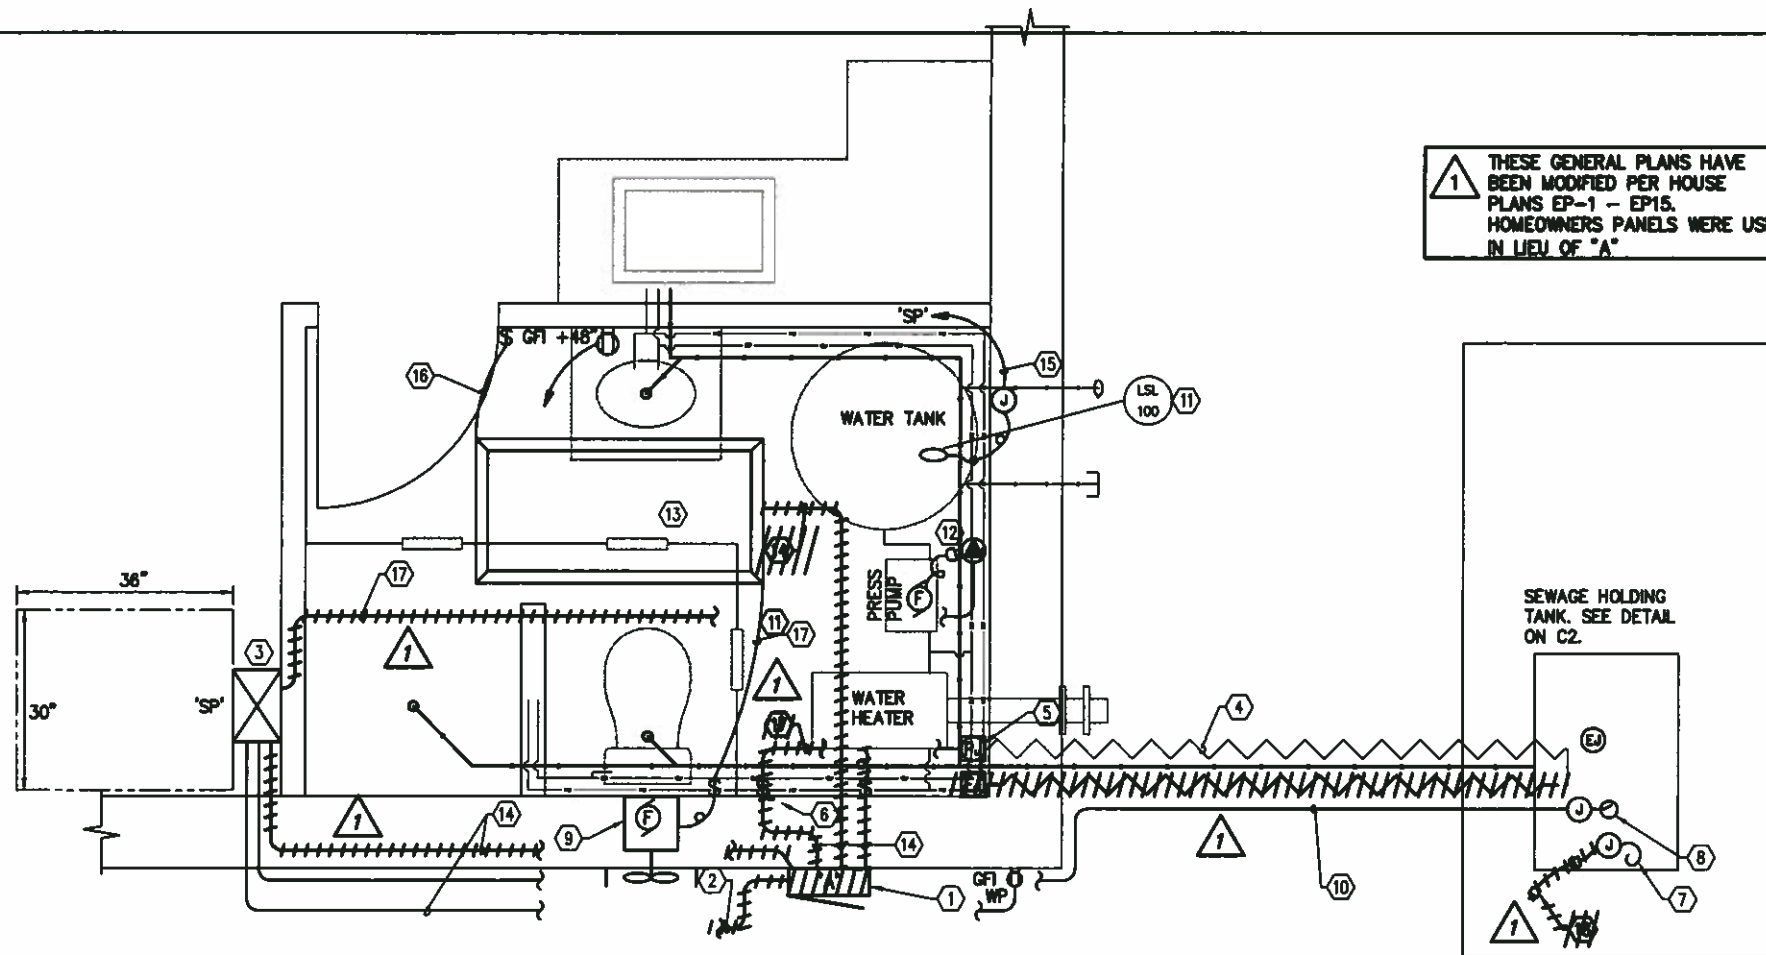

1 INTERIOR BATHROOM ADDITION ELECTRICAL PLAN
SCALE: 3/4" = 1' - 0"

GENERAL SPECIFICATIONS
ALL WIRING SHALL BE PERFORMED IN ACCORDANCE WITH THE LATEST ADOPTED VERSION OF THE NATIONAL ELECTRICAL CODE (NFPA 70) BY OR UNDER THE SUPERVISION OF STATE OF ALASKA LICENSED JOURNEYMEN ELECTRICIANS.

ALL WIRING SHALL BE IN METALLIC CONDUIT IN ACCORDANCE WITH THE FOLLOWING SCHEDULE:

ALL EXTERIOR WIRING SHALL BE GALVANIZED RIGID METAL CONDUIT.

ALL EXPOSED INTERIOR WIRING SHALL BE IN EMT, AC OR LIQUIDTIGHT FLEXIBLE METALLIC CONDUIT. INTERIOR WIRING CONCEALED IN WALLS MAY BE MC CABLE OR NON-METALLIC SHEATHED CABLE.

CONDUIT SUPPORT SHALL BE PROVIDED WITH 2-HOLE STRAPS (INTERIOR AND EXTERIOR). PINCH TYPE (CADDY) CLAMPS ARE APPROVED FOR USE ON EMT OR GRC ON INTERIOR WALLS AND CEILING ONLY.

CONDUCTORS FOR USE ON THIS PROJECT SHALL BE STRANDED COPPER WITH THWN-2 INSULATION FOR INTERIOR AND XHHW-2 INSULATION FOR EXTERIOR. COLOR CODE AS FOLLOWS:
120/240V WIRING- PHASE A=BLACK, PHASE B=RED, NEUTRAL=WHITE, GROUND=GREEN OR BARE COPPER.

CONTROL WIRING- ANY COLOR OTHER THAN RED, BLACK, BLUE GREEN OR WHITE AS ALLOWED UNDER U/L AND NFPA 79.

UNLESS OTHERWISE NOTED, ALL WIRING SHOWN SHALL CONSIST OF 1/2" C, 3#12. ONE OF THE #12 IS A GREEN (OR BARE) GROUND.

FITTINGS - ALL NON-HUB CONDUIT TERMINATIONS SHALL BE BUSHED EITHER WITH NON-METALLIC BUSHINGS ON THREADED CONDUITS OR INSULATED THROAT CONNECTORS ON EMT AND FLEXIBLE CONDUITS. EMT COUPLINGS AND CONNECTORS SHALL BE COMPRESSION TYPE - NO SETSCREW TYPE ALLOWED.

BOXES SHALL BE PROVIDED IN ACCORDANCE WITH THE FOLLOWING SCHEDULE:
EXTERIOR WITH GRC: NEMA 4, TYPE FS OR FD DEVICE CAST BOXES WITH GASKETED COVER.
INTERIOR WITH EMT: PRESSED STEEL WITH APPROPRIATE GALVANIZED DEVICE COVER.

ALL DEVICES SHALL BE SERVED FROM ABOVE UNLESS SPECIFICALLY SHOWN OTHERWISE ON THE DRAWINGS.

ALL COMPONENTS FURNISHED FOR THIS PROJECT SHALL BE LISTED OR LABELED BY AN AGENCY ACCEPTABLE TO THE STATE OF ALASKA DEPARTMENT OF LABOR MECHANICAL INSPECTIONS DIVISION. U/L (UNDERWRITERS LABORATORIES) ETL (EDISON TEST LAB) FM (FACTORY MUTUAL) ARE ACCEPTABLE. NOTE THAT NRTL APPROVAL IS REQUIRED FOR CSA LABELS.

INSTALLATION OF CONTROLS AND CALIBRATION SHALL BE PERFORMED IN ACCORDANCE WITH THE MANUFACTURERS REQUIREMENTS. PROVIDE COPIES OF ALL CUT SHEETS AND DOCUMENTATION RECEIVED DURING SHIPPING TO OWNERS REPRESENTATIVE UPON COMPLETION.

COORDINATE INSTALLATION WITH OTHER TRADES PRIOR TO ROUGH-IN. MAINTAIN CLEARSPACE AT ALL COMPONENTS THAT MAY REQUIRE ADJUSTING OR TROUBLE SHOOTING WHILE ENERGIZED.

IDENTIFICATION
MARK ALL CONDUITS ENTERING OR LEAVING PANELBOARDS WITH INEDIBLE BLACK MARKER WITH THE CIRCUIT NUMBERS OF THE CIRCUITS CONTAINED INSIDE. MARK CIRCUIT NUMBERS ON ALL JUNCTION BOX COVERS. ALL CONTROL CONDUCTORS TO CONTROL PANELS, INSTRUMENTS, STARTERS, etc., SHALL BE IDENTIFIED WITH A UNIQUE NUMBERING SYSTEM.

TESTING
TEST ALL CONDUCTORS PRIOR TO TERMINATION WITH A 500VDC MEGOHMMETER. REPLACE ALL CONDUCTORS EXHIBITING LESS THAN 10 MEGOHM IMPEDANCE. REPEAT TEST.

MATERIALS
GENERAL COMPONENTS SHALL BE AS CALLED OUT ON THE PLANS AND LEGEND. PROVIDE AS SPECIFIED AND SHOWN. MANUFACTURER AND PART NUMBER DESIGNATIONS INDICATE THE MINIMUM PERFORMANCE AND QUALITY REQUIRED ON THIS PROJECT.

SUBMITTALS
SUBMIT FOR APPROVAL MANUFACTURER'S CATALOG DATA ON ALL ELECTRICAL MATERIAL INTENDED FOR USE ON THIS PROJECT. SUBMITTALS SHALL CLEARLY IDENTIFY THE MODEL, PROPERTIES, OPTIONAL ACCESSORIES, ETC. OF THE COMPONENT BEING PROVIDED.


THESE GENERAL PLANS HAVE BEEN MODIFIED PER HOUSE PLANS EP-1 - EP15. HOMEOWNERS PANELS WERE USED IN LIEU OF "A"

LEGEND

- EXPOSED CONDUIT, GRC UNLESS OTHERWISE SHOWN
- MOLDED CASE CIRCUIT BREAKER, X=AMPERE RATING, Y=NO. OF POLES
- HOMERUN TO PANEL "X", CIRCUITS NO. Y AND Z, CONDUITS NOT OTHERWISE DEFINED ARE 3/4" C WITH 3#12.
- LIQUID-TIGHT FLEXIBLE CONDUIT
- PANELBOARD
- STATUS PANEL
- JUNCTION BOX OR FITTING
- SINGLE POLE SWITCH, BRYANT #4901
- SINGLE POLE SWITCH WITH PILOT LIGHT
- 120V, 20A DPDT SNAP SWITCH, BRYANT #CS8220B1
- 120V DUPLEX RECEPTACLE, NEMA CONFIGURATION 5 - 20R, BRYANT #5282
- 120V DUPLEX GROUND FAULT INTERRUPT RECEPTACLE, NEMA CONFIGURATION 5 - 20R, BRYANT #GFR52FT
- SIMPLEX RECEPTACLE, 120V, 15A, LEVITON #5088
- HEAT TRACE POWER POINT
- HEAT TRACE END POINT
- HEAT TRACE
- FLOAT SWITCH



NOTES

- 1 120/240V, 1#, 100A, 8 SPACE, NEMA 3R, LOAD CENTER. SQUARE D # Q0612L100TRB.
- 2 3/4" C, 3#8 (2H,N) & 1#10 (G). ROUTE TO NEW 50A, 2-POLE CIRCUIT BREAKER INSTALLED HOMEOWNER'S PANELBOARD OR METER/MAIN DEVICE IF SPACE IS AVAILABLE. IF SPACE IS UNAVAILABLE IN EXISTING EQUIPMENT FOR NEW BREAKER, PROVIDE A 50A/240V, 2-POLE, NEMA 3R, SELF-ENCLOSED CIRCUIT BREAKER SQUARE D #FAL22050 & #FA100RB AND TAP OFF OF LOAD SIDE OF METER/MAIN DEVICE.
- 3 STATUS PANEL 'SP'. SEE DWG E3. LOCATE PANEL SO THAT IT HAS A CLEAR SPACE OF 30" WIDE, 36" DEEP AND 72" HIGH IN FRONT OF THE PANEL.
- 4 120V, 10W/FT SELF-LIMITING HEAT TRACE. NELSON TYPE LT1D-J. ROUTE INSIDE CARRIER PIPE OF SEWER LINE ARCTIC PIPE.
- 5 HEAT TRACE POWER CONNECTION KIT. NELSON # LT-BC.
- 6 120V, 20A, WALL SWITCH WITH RED PILOT LIGHT. LEVITON #1221-PLR OR EQUAL. PROVIDE WITH 'HEAT TRACE' LABEL.
- 7 IMMERSION HEATER, 120V, 2KW, W/ CIRCULAR ELEMENTS, SLUDGE LEGS & SPLIT RISER. CHROMALOX # KTLJ-220A-063XX.
- 8 LEVEL PROBE. SEE COMPONENT SCHEDULE, ITEM 5 ON SHEET E3. ADJUST HEIGHT OF PROBE SO THAT THE SETPOINTS SHOWN ON E3 ARE ACHIEVED.
- 9 BATHROOM EXHAUST FAN, THROUGH-THE-WALL TYPE, 120V. NUTONE MODEL 8870. FAN TO TURN ON WITH LIGHT.
- 10 1/2" C, W/LEVEL PROBE CABLE.
FLOAT SWITCH. SJE SIGNALMASTER SPDT 1006098. HANG FLOAT TO OPERATE JUST ABOVE WATER INTAKE LINE.
- 12 120V, 20A SIMPLEX RECEPTACLE.
- 13 120V FLUORESCENT FIXTURE, 2-LAMP, SURFACE MOUNT. LITHONIA #DM232120.
- 14 1/2" C, 3#12 (H,N,G)
- 15 1/2" C, 4#14 (H,2 SIG,G)
- 16 1/2" C, 3#12 (H,SWITCHLEG,G)
- 17 1/2" C, 3#12 (SWITCHLEG,N,G)
- 18 GFI-EQUIPPED GROUND AND PLUG ASSEMBLY FOR IMMERSION HEATER. HUBBELL GFI1031-W/HELS38-WV-PLUG-AND-HLD-GAP.

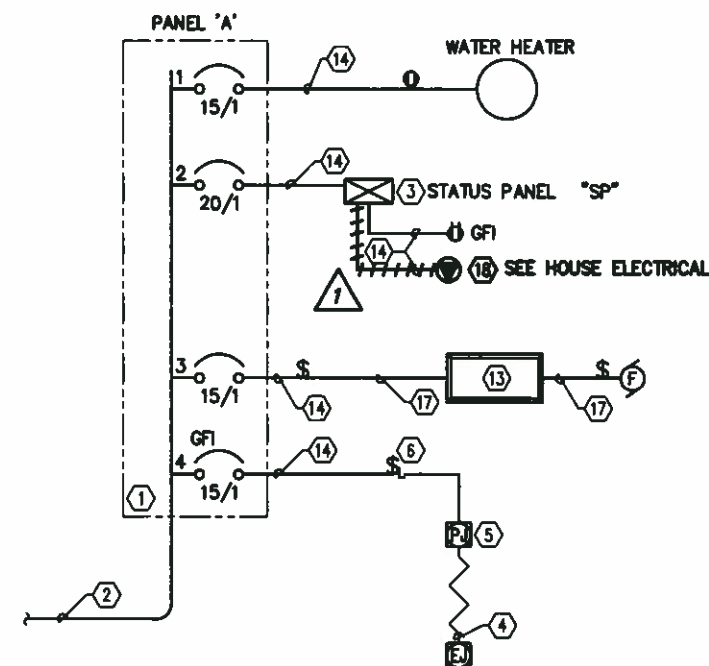

2 POWER ONE-LINE
SCALE: NONE

RECORD DRAWING CERTIFICATE
THESE DRAWINGS REFLECT
RECORDED INFORMATION OBTAINED
DURING CONSTRUCTION.
INFORMATION PROVIDED HEREIN
IS ACCURATE TO THE BEST OF
MY KNOWLEDGE.
DATE 11/11/08
NAME

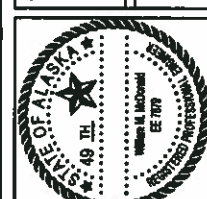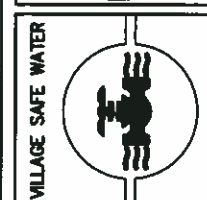


EDC, Inc.
213 W. FIREWED LANE
ANCHORAGE, AK 99503
(907) 276-7933


VILLAGE OF BEAVER
SANITATION IMPROVEMENTS
BATHROOM UPGRADES
INTERIOR BATHROOM ADDITION
ELECTRICAL PLAN AND ONE-LINE

REVISION	DATE	BY	DATE	BY
1	10/07	AF	10/07	AF
2	11/08	AF	11/08	AF
3	11/08	AF	11/08	AF
4	11/08	AF	11/08	AF
5	11/08	AF	11/08	AF
6	11/08	AF	11/08	AF
7	11/08	AF	11/08	AF
8	11/08	AF	11/08	AF
9	11/08	AF	11/08	AF
10	11/08	AF	11/08	AF

Project No.	Drawn	Checked	Date	Approved
1000000000	AF	AF	11/08	AF

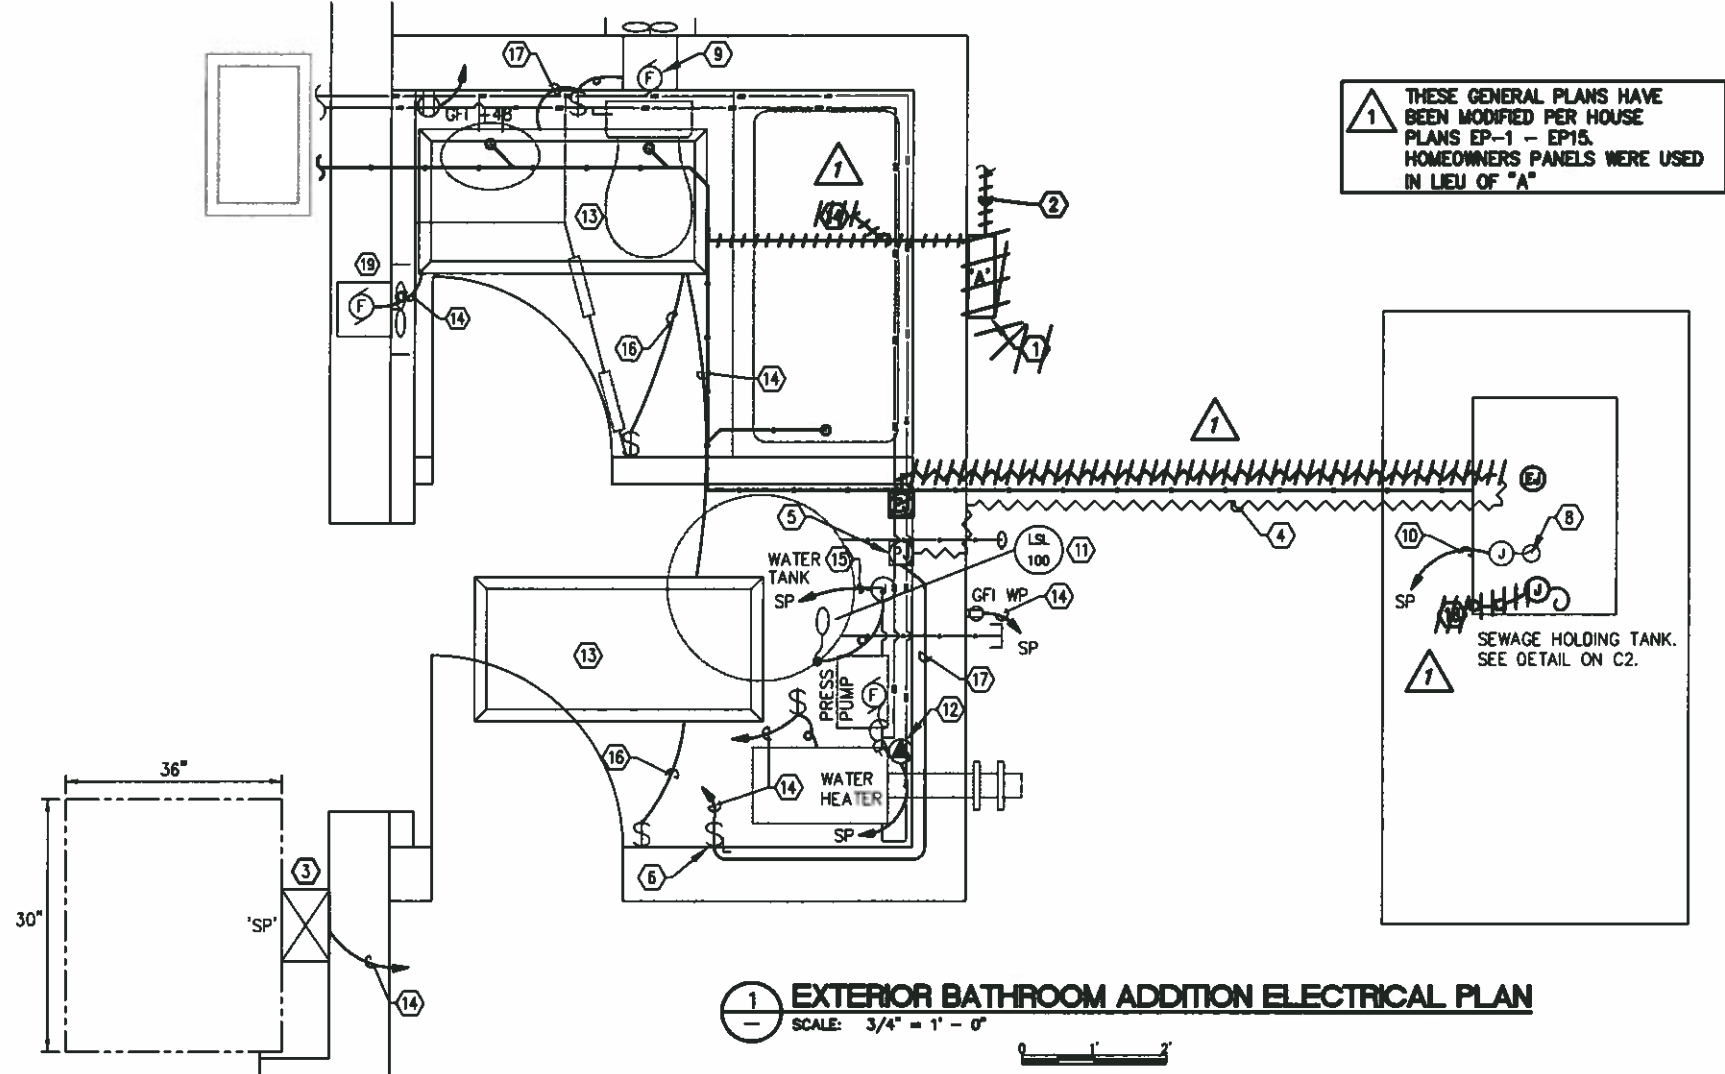


1 EXTERIOR BATHROOM ADDITION ELECTRICAL PLAN
SCALE: 3/4" = 1' - 0"

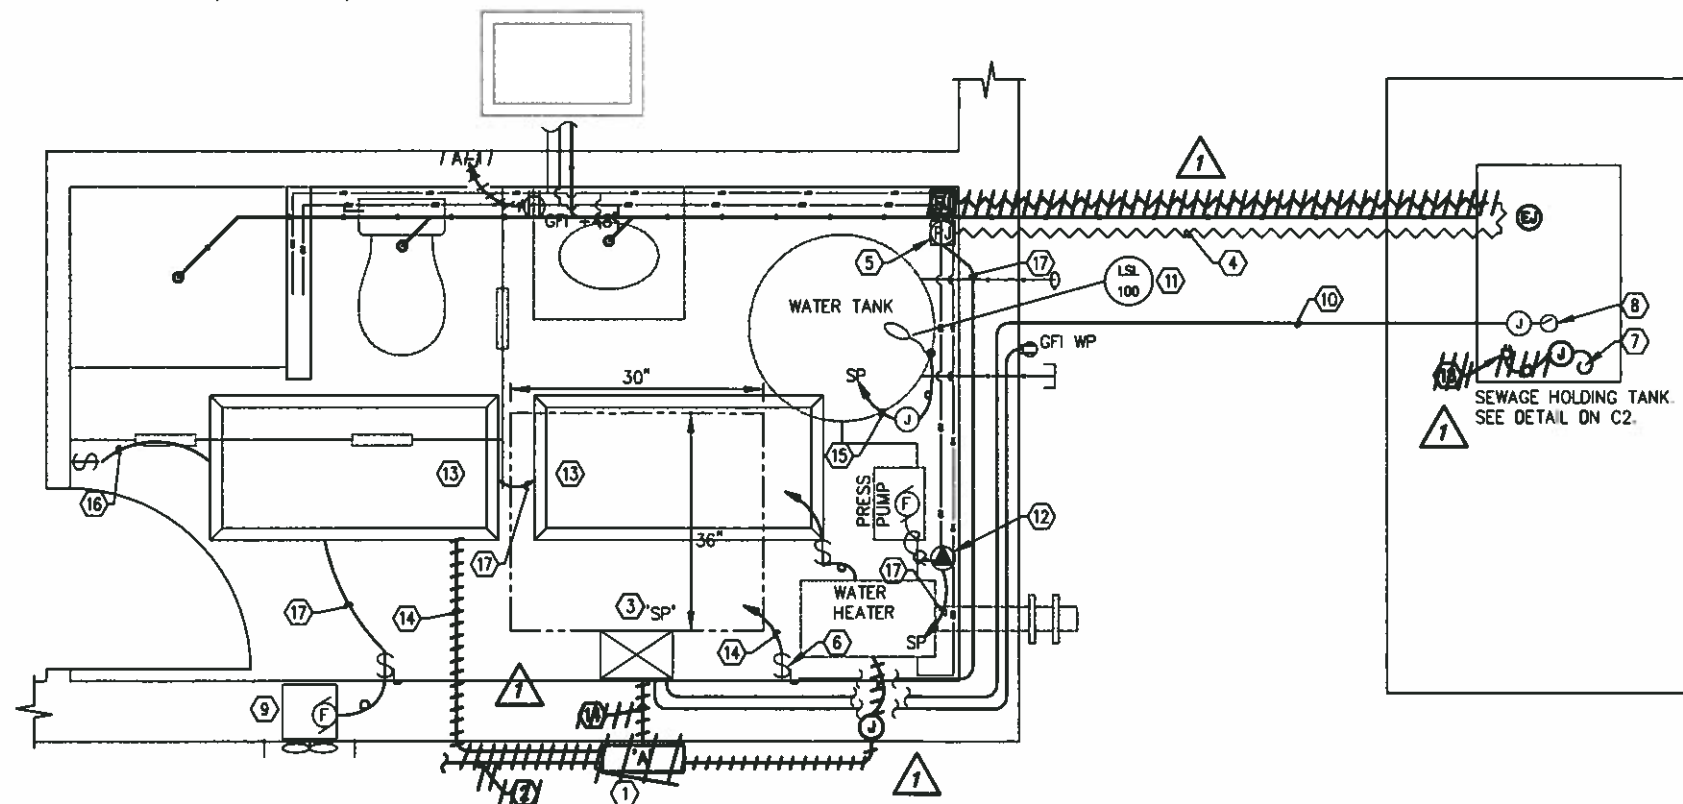

2 INTERIOR HUD HOME BATHROOM ADDITION ELECTRICAL PLAN
SCALE: 3/4" = 1' - 0"

- NOTES**
- 120/240V, 1 ϕ , 100A, 6 SPACE, NEMA 3R, LOAD CENTER. SQUARE D # Q0612L100TRB.
 - 3/4" C, 3/8 (2H,N) & 1/10 (G). ROUTE TO NEW 50A, 2-POLE CIRCUIT BREAKER INSTALLED HOMEOWNER'S PANELBOARD OR METER/MAIN DEVICE IF SPACE IS AVAILABLE. IF SPACE IS UNAVAILABLE IN EXISTING EQUIPMENT FOR NEW BREAKER, PROVIDE A 50A/240V, 2-POLE, NEMA 3R, SELF-ENCLOSED CIRCUIT BREAKER SQUARE D #FAL22050 & #FA100RB AND TAP OFF OF LOAD SIDE OF METER/MAIN DEVICE.
 - STATUS PANEL 'SP'. SEE DWG E3. LOCATE PANEL SO THAT IT HAS A CLEAR SPACE OF 30" WIDE, 36" DEEP AND 72" HIGH IN FRONT OF THE PANEL.
 - 120V, 10W/FT SELF-LIMITING HEAT TRACE. NELSON TYPE LT10-J. ROUTE INSIDE CARRIER PIPE OF SEWER LINE ARCTIC PIPE.
 - HEAT TRACE POWER CONNECTION KIT. NELSON # LT-BC.
 - 120V, 20A, WALL SWITCH WITH RED PILOT LIGHT. LEVITON #1221-PLR OR EQUAL. PROVIDE WITH 'HEAT TRACE' LABEL.
 - IMMERSION HEATER, 120V, 2KW CIRCULAR ELEMENTS, SLUDGE LEGS & SPLIT RISER, CHROMALOX CAT# KTUJ-220A-063XX.
 - LEVEL PROBE. SEE COMPONENT SCHEDULE, ITEM 5 ON SHEET E3. ADJUST HEIGHT OF PROBE SO THAT THE SETPOINTS SHOWN ON E3 ARE ACHIEVED.
 - BATHROOM EXHAUST FAN, THROUGH-THE-WALL TYPE, 120V. NUTONE MODEL 8870. FAN TO TURN ON WITH LIGHT.
 - 1/2" C, W/LEVEL PROBE CABLE.
 - FLOAT SWITCH. SEE SIGNALMASTER SPDT 1006098. HANG FLOAT TO OPERATE JUST ABOVE WATER INTAKE LINE.
 - 120V, 20A SIMPLEX RECEPTACLE.
 - 120V FLUORESCENT FIXTURE, 2-LAMP, SURFACE MOUNT. LITHONIA #DM232120.
 - 1/2" C, 3/12 (H,N,G)
 - 1/2" C, 4/14 (H,2 SIG,G)
 - 1/2" C, 3/12 (H,SWTCHLEG,G)
 - 1/2" C, 3/12 (SWTCHLEG,N,G)
 - ~~GFI EQUIPPED GROUND AND PLUG ASSEMBLY FOR IMMERSION HEATER. HUBBELL GFI1301-W/1BL530-WV-PLUG AND WLD-GAP.~~
 - BATHROOM WARM AIR CIRC FAN, THROUGH-THE-WALL TYPE, 120V, PENN MODEL TRANSFAN. USED IN EXTERIOR BATHROOM (DETAIL 1) ONLY.

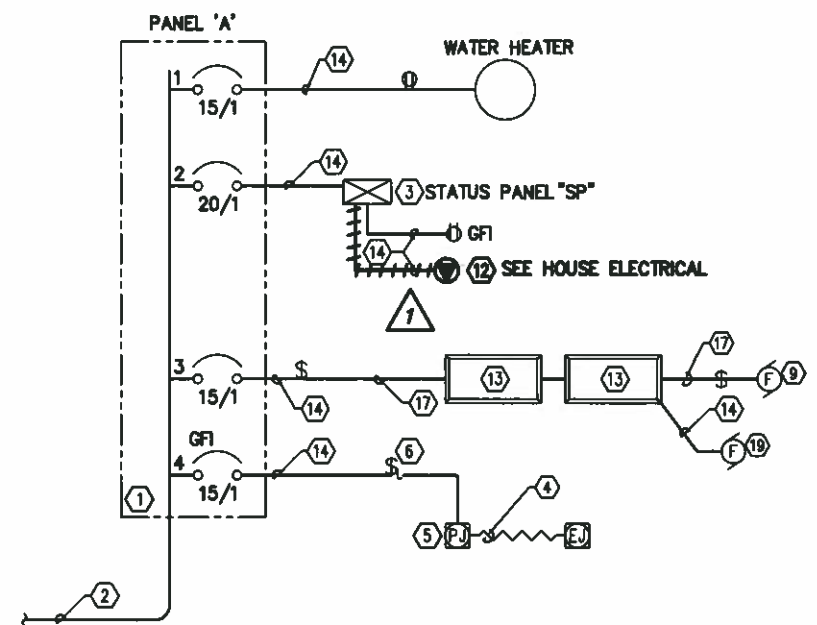

3 POWER ONE-LINE
SCALE: NONE

RECORD DRAWING CERTIFICATE

THESE DRAWINGS REFLECT RECORDED INFORMATION OBTAINED DURING RECORDING CONSTRUCTION. INFORMATION PROVIDED HEREIN IS ACCURATE TO THE BEST OF MY KNOWLEDGE.

DATE 11/11/08

VILLAGE SAFE WATER

STATE OF ALASKA

EDC, Inc.
213 W. FIREWED LANE
ANCHORAGE, AK 99503
(907) 276-7933

VILLAGE OF BEAVER
SANITATION IMPROVEMENTS
BATHROOM UPGRADES

TYPICAL BATHROOM ADDITION
ELECTRICAL PLANS AND ONE-LINE

BY	DATE	REVISION	DESCRIPTION
AF	10/07	1	AS-BUILT

Project No. _____


Date MARCH 2008

Designed JFE

Drawn ANH

Approved _____

SHEET E2 OF E3

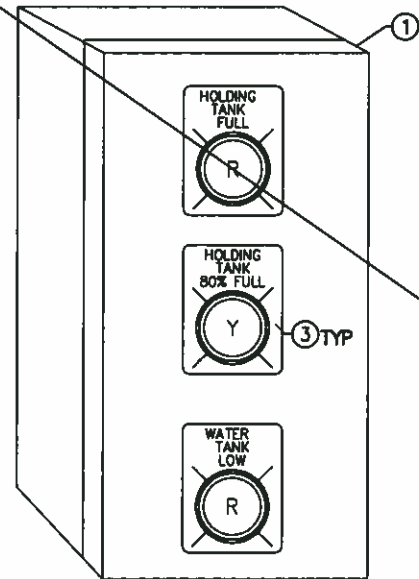

1 STATUS PANEL LAYOUT
SCALE: NONE

FUNCTIONAL NARRATIVE

THE STATUS PANEL DISPLAYS SEWAGE HOLDING TANK 80% FULL AND FULL CONDITIONS, AND A WATER TANK LOW LEVEL CONDITION. THE PANEL PREVENTS THE OPERATION OF THE WATER PRESSURE PUMP WHENEVER A WATER TANK LOW LEVEL OR FULL SEWAGE HOLDING TANK CONDITION OCCURS. IT ALSO PREVENTS THE OPERATION OF THE SEWAGE HOLDING TANK IMMERSION HEATER WHENEVER THE LEVEL IN THE TANK IS SUCH THAT THE HEATER IS NOT FULLY IMMERSED.


SEWAGE HOLDING TANK LEVEL SETPOINTS

LEVELS SHOWN ARE IN INCHES MEASURED FROM THE BOTTOM OF THE TANK.

TANK FULL - 38"
TANK 80% FULL - 32"
IMMERSION HEATER DISABLE - 8" OR BELOW


LEGEND

- FIELD WIRING TERMINAL
- OR • PANEL OR DEVICE TERMINAL
- FIELD DEVICE

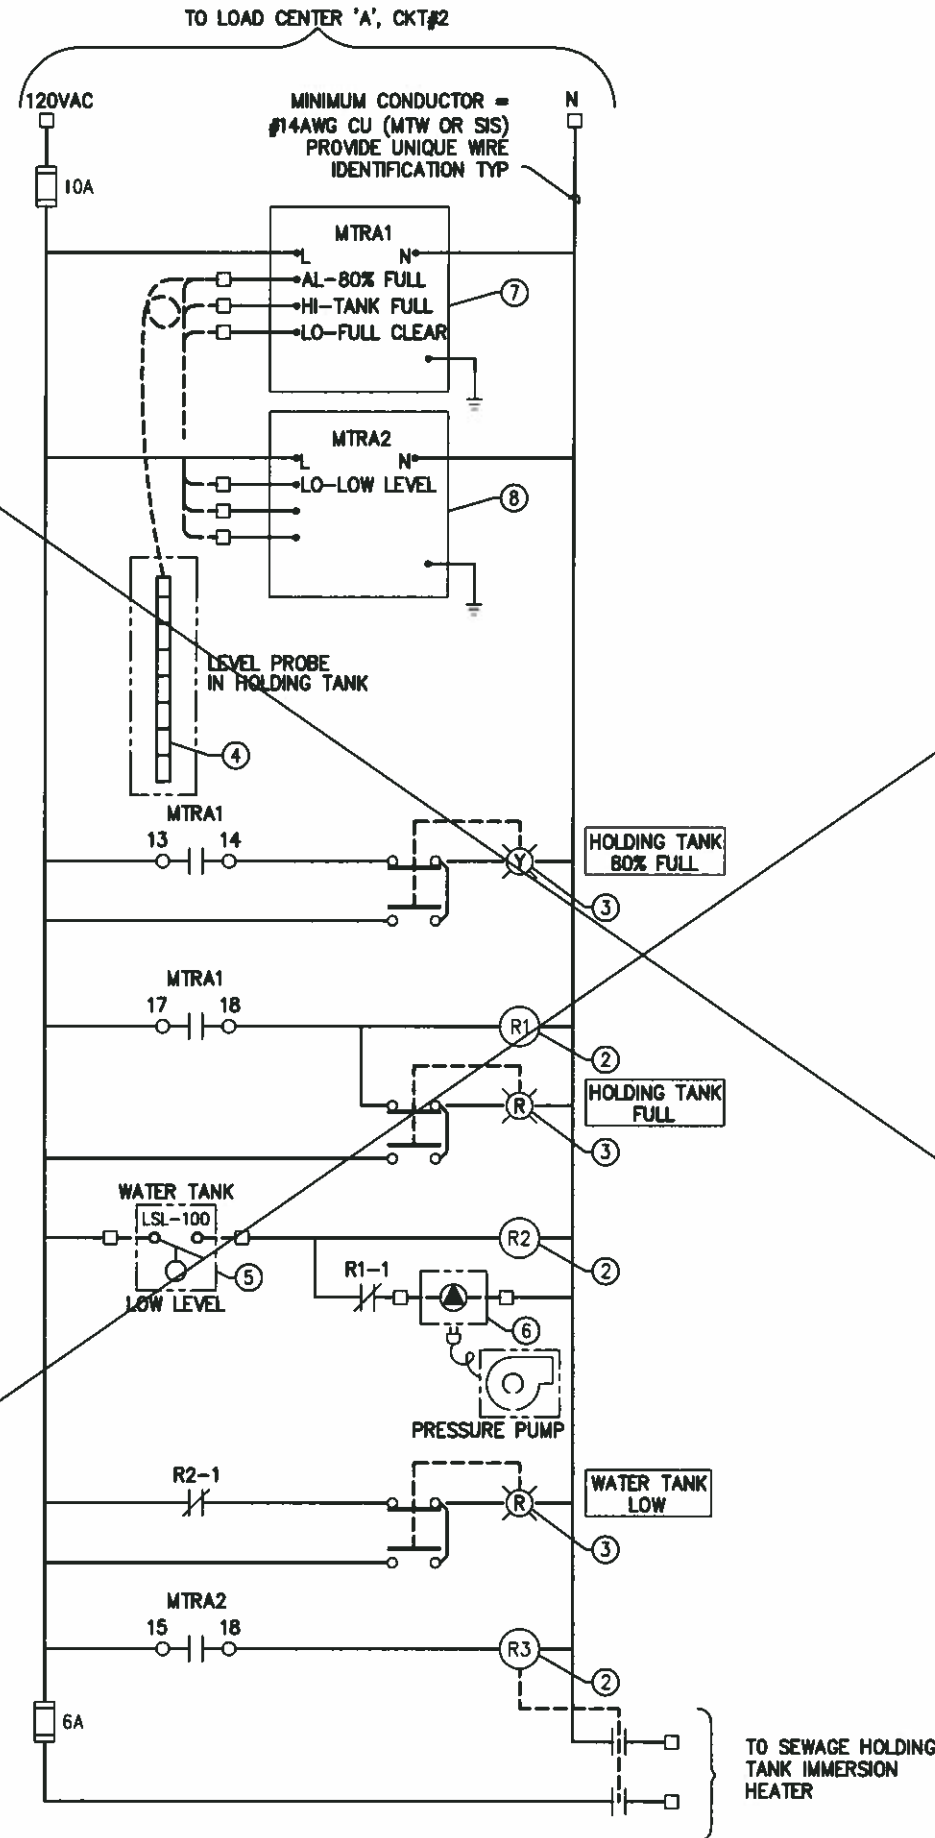

2 STATUS PANEL SCHEMATIC
SCALE: NONE

#	COMPONENT SCHEDULE
1	NEMA 1, ENCLOSURE W/ HINGED LOCKABLE DOOR AND REMOVABLE BACKPLATE FOR MOUNTING COMPONENTS. SIZE AS REQUIRED. HOFFMAN OR EQUAL.
2	120V RELAY, 3PDT, 11-PIN OCTAL SOCKET MOUNT W/ PILOT LIGHT. SQUARE D TYPE KP13P1HV20
3	PILOT LIGHT, PUSH TO TEST, 120V, LED, NEMA 4X, LENS TINT AS SHOWN SQUARE O TYPE SKT, CLASS 9001
4	MULTITRODE LIQUID LEVEL SENSOR, 40 INCHES LONG WITH 10 SENSOR POINTS AT 4 INCH SPACINGS (FLYGT #40/10-33).
5	N.O., 120V, 5A, FLOAT SWITCH SJE RHOMBUS SIGNALMASTER PART # 10SGMPC08.
6	120V, 15A, SIMPLEX RECEPTACLE. LEVITON # 5088.
7	LEVEL RELAY W/ ALARM, 120V, 2 N.O. CONTACTS (FLYGT #MTRA-3)
8	LEVEL ALARM RELAY, 120V, SPOT (FLYGT #MTR-3)

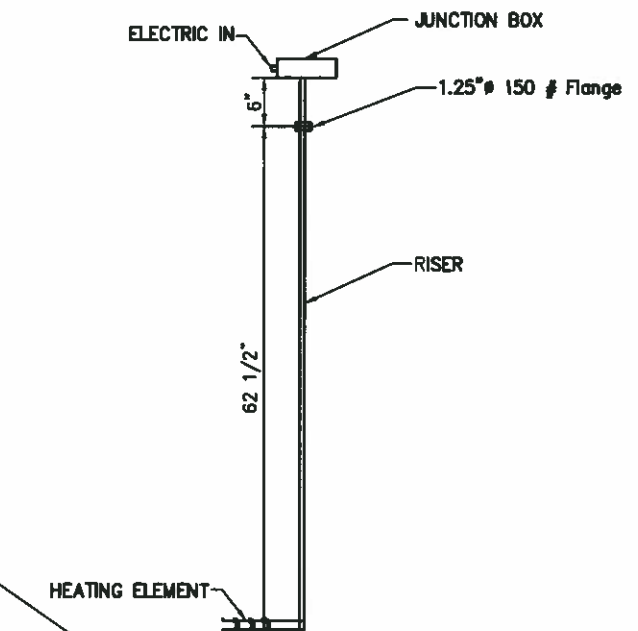

3 IMMERSION HEATER DETAIL
SCALE: 1" = 1'-0"

RECORD DRAWING CERTIFICATE
THESE DRAWINGS REFLECT
RECORDED INFORMATION OBTAINED
DURING CONSTRUCTION
INFORMATION PROVIDED HEREIN
IS ACCURATE TO THE BEST OF
MY KNOWLEDGE
DATE 11/11/08
NAME *[Signature]*

VILLAGE SAFE WATER

VILLAGE OF BEAVER
SANITATION IMPROVEMENTS
BATHROOM UPGRADES

EDC, Inc.
213 W. FIREWEED LANE
ANCHORAGE, AK 98503
(807) 276-7933

HOUSE STATUS PANEL
LAYOUT AND SCHEMATIC

REVISION	DATE	BY	DATE
IMMERSION HTR CONNECTION	10/07	JAF	

Project No.	CRWBEVR	Date	MARCH 2009	Designed	JAF	Drawn	JAF	Approved	
-------------	---------	------	------------	----------	-----	-------	-----	----------	--

SHEET **E3** OF **E3**

RESIDENTIAL INSTALLATION NOTES

Unless otherwise noted, all wiring consists of 1/2" EMT and 3/4" 12.

STATUS PANEL SP

Function
Monitors Septic Tank levels using probes and conductance type relays
Displays Septic tank level at 80% and FULL conditions with front panel pilot lights
Monitors the water tank with a low-level float.
Displays Water Tank LOW condition with front panel pilot light
Provides controlled power for the water pump. Water pump is disabled when septic tank shows FULL or when the water tank is low.

Installation
Serve from dedicated 20A circuit breaker except
Use same circuit for the exterior GFCI receptacle, and on installations where the homeowners panel is used for power, power the Water Heater receptacle from SP (on TB L1A and N).
See CONTROL PANEL Drawings E3 and CONTROL CRAFT AS_BUILT for septic tank probes, water tank float and powered circuit terminations.

Requirements
Panels with direct connected cords will have the cords removed.
The Status Panels will serve receptacles only.
Status Panel will require clear space per NEC but has no externally operable controls so there is no mounting height restriction when relocating.

WATER PUMP

Function
Self contained.
Provides domestic water pressure.

Installation
Cord and plug connected to dedicated outlet served from SP.

Requirements
Dedicated simplex receptacle must be located adjacent to water pump location, 172W, 120V

WATER HEATER

Function
Self Contained,
Oil fired, Provides Domestic hot water.

Installation
Cord and plug connected to outlet that may be served from SP, or local outlet (GFCI outlet if located in bathroom).

Requirements
120W (max), 120VAC

SEWER LINE HEAT TAPE

Function
Freeze protection for sewer line
Provides supplementary heating of probe riser and holder assembly at septic tank.

Installation
Must be served from GFCI protected circuit, downstream of bathroom GFCI receptacle is acceptable.
Controlled by a pilot switch. Switch has placard "SEWER LINE HEAT TAPE".
Where installed, heat tape ends at septic tank manhole. See heat tape extension instructions
Heat tape must be guarded where run within residence. PVC chase to be installed at all exposed locations.


Requirements
120VAC, 15 / 20A GFCI protected circuit. Approx max demand = 500W

COMPLETION CHECKLIST


- Status Panel**
Verify Panel has required access and clear space (30"Wx36"Dx78"H)
Verify that all connections made to the enclosure are installed using approved wiring methods (connectors etc) and all unused penetrations are sealed.
Verify Panel is operational by simulating rising liquid levels of the septic tank probe holder.
- Homeowners Distribution panel**
Verify all of the breakers associated with the Bathroom Upgrade project have been identified in the panel schedule.
- Water Pump**
Verify that the water pump is cord and plug connected to a simplex receptacle, powered from the Status Panel terminals "N", "G", and "4".
- Sewer Line Heat Tape**
Verify that the heat tape is on a GFCI protected circuit.
Verify that there is a heat tape pilot switch and that the switch has a label stating "SEWER LINE HEAT TAPE"
Verify that the sewer line heat tape has been extended to the probe holder and flanged riser.
Verify the heat tape extension splice point is insulated and that an end kit has been installed.
- Water Heater**
Verify that it has a local outlet - no extension cords. If located in bathroom, receptacle must be either on a GFCI breaker or GFCI receptacle.
- Water Tank Float**
Verify that the float cord runs directly to either a j-box or the status panel and is connected using an approved cord connector.
Verify cord is not attached to the building structure and routed in a way that will expose it to mechanical damage.
- Sewage Holding Tank Heater power supply**
Verify cable connectors are secure and secure the cable.
Verify the connector box is mounted firmly.
Verify that residence has been provided with a 20A rated extension cord and that it reaches the outside outlet.
Verify the heater works when plugged in. Either monitor current or observe kWh meter.
- Verify that the manhole cover gasket is in place and all of the bolts are tight.

SHEET NOTES


- 1 Power inlet in weather proof junction box with cover. Mount on Ballard nearest house. BELL P/N 5385-0 box, HUBBELL P/N HBL5378C 20A/120V inlet, BELL P/N 5029-0 cover. See Detail 2.
- 2 1/2" Liquidtight, Non-metallic UF cable fitting T&B 2827.
- 3 1/2" with ground UF Cable.
- 4 1/2" non-metallic bushing.
- 5 1/2" Liquidtight flexible metal conduit, extend 1/2" below finished grade. Use insulated throat connectors and install non-metallic bushing on buried end (BRIDGEPORT 321-B).
- 6 Unistrut 1-5/8" x 1/32" pre-galvanized steel, B-LINE P/N P4000.
- 7 6" Unistrut straps B-LINE P/N P1124.
- 8 Existing heater terminal junction box.
- 9 Install UF connector in existing threaded hole. use a 1/2" bushing on connector thread as it exits the outer manhole wall. If the threaded fitting is not accessible, drill 7/8" hole and use UF connector with lock ring and insulated bushing on outer wall.
- 10 Existing Heat Tape (NELSON LT10-JT) run in sewer line carrier pipe (Pipe not shown). See Note 13.
- 11 Probe holder and flange/riser (Existing).
- 12 Heat Tape Splice kit NELSON LT-SS.
- 13 Provide a 10' extension to the existing heat tape (See Note 10). Wrap heat tape around sewer line riser, probe riser tube and flange and probe holder. Secure heat tape using 2" weatherproof aluminum tape (3M NASHUA 330, GRAINGER 6JD44). Do not apply tape to probe holder cover but wrap with heat tape.
- 14 Heat Tape End Kit NELSON LT-SE.

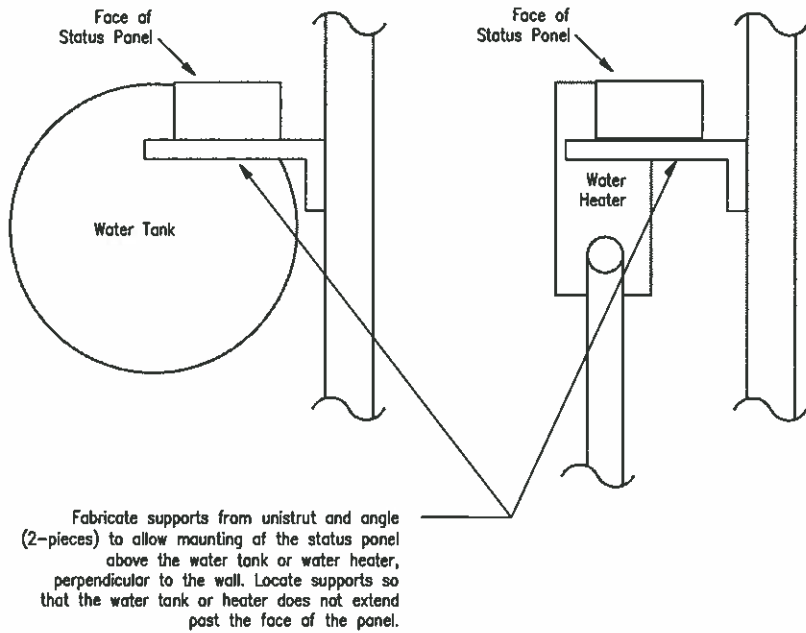

1 ALTERNATE SP MOUNTING METHOD
NO SCALE

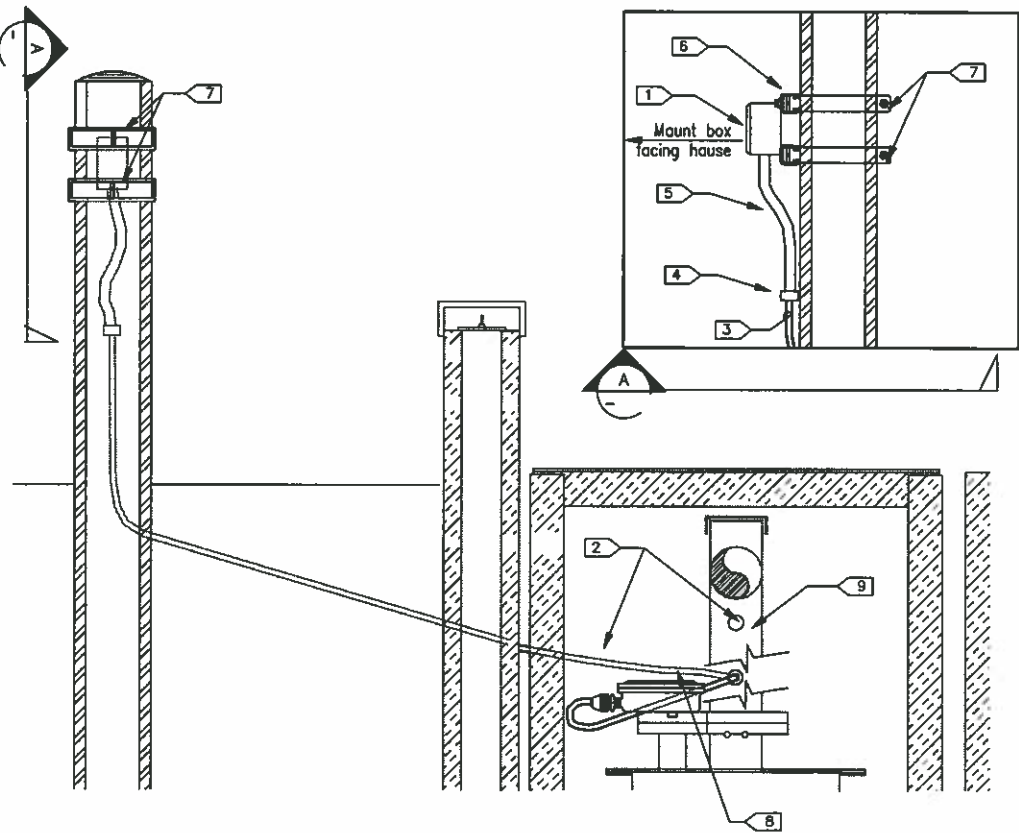

2 TANK HEATER POWER SUPPLY
NO SCALE

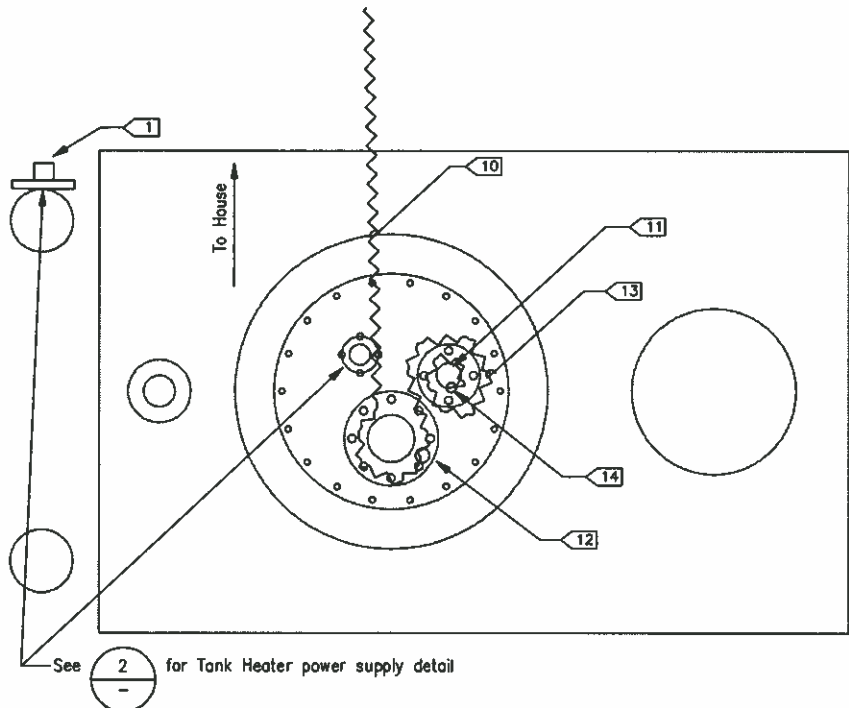

3 PROBE HEAT TAPE EXTENSION
NO SCALE

RECORD DRAWING CERTIFICATE

THESE DRAWINGS REFLECT RECORDED INFORMATION OBTAINED DURING CONSTRUCTION. INFORMATION PROVIDED HEREIN IS ACCURATE TO THE BEST OF MY KNOWLEDGE.

DATE 11/11/08

NAME [Signature]

VILLAGE OF BEAVER

CRW ENGINEERING GROUP LLC

3000 ARCTIC BLVD., SUITE 203
ANCHORAGE, ALASKA 99503
PHONE: (907) 562-3252
FAX: (907) 561-2273

VILLAGE OF BEAVER
SANITATION IMPROVEMENTS
BATHROOM UPGRADES
ELECTRICAL

PUNCH LIST
GENERAL NOTES

REVISION	BY	DATE
AS-BUILT	WM	11/08


Project No.	Date	Designed	Drawn	Approved
9866	AUGUST 2008	WM	WM	WM

Sheet No. EP 1

SHEET 1 of 15

RESIDENCE # 2 NOTES

1. Provide dedicated circuits in homeowner's panel for SP and sewer line heat tape.
 - 1.a. Use a 20/1 circuit breaker for SP.
 - 1.b. Use a GFCI 20/1 or 15/1 circuit breaker for the sewer line heat tape.
 - 1.c. Identify the circuit used for the water heater (if installed) and
 - 1.d. Update new circuits on the panel schedule with the following descriptions: "Water/Sewer Panel", "Sewer Line Heat Tape", or "Water Heater"
2. Disconnect, remove Status Panel (SP), and re-install in location shown.
 - 2.a. Serve SP on a dedicated circuit from Homeowner's Panel.
 - 2.b. Re-route probe conductors to new location for SP.
 - 2.c. SP to supply circuits for outside GFCI receptacle (Note 4) and water pump simplex receptacle (NOTE 3). Water pump receptacle is controlled by SP.
3. Provide a simplex receptacle for the water pump. Locate near water pump. Provide label on cover plate: "WATER PUMP ONLY". Serve with 3#12(N, G, Switch leg) on controlled circuit from SP. Install a 3P plug (HUBBELL HBL596SVBK or equal) on the water pump pigtail.
4. Exterior GFCI receptacle in weatherproof box with lockable cover. Locate near sewer line. Serve from SP circuit.
5. Remove end kit from heat tape at septic monhole. Splice on additional 10 feet of heat tape and install new end kit. Wrap the new section of heat tape around the probe holder junction box, flange and riser.
6. Provide Placard at Heat Tape pilot switch: "SEWER LINE HEAT TAPE".
7. Provide new light fixture in bathroom. Serve from existing switched circuit for light in corridor leading to bathroom.
8. Provide GFCI receptacle adjacent to sink in bathroom.

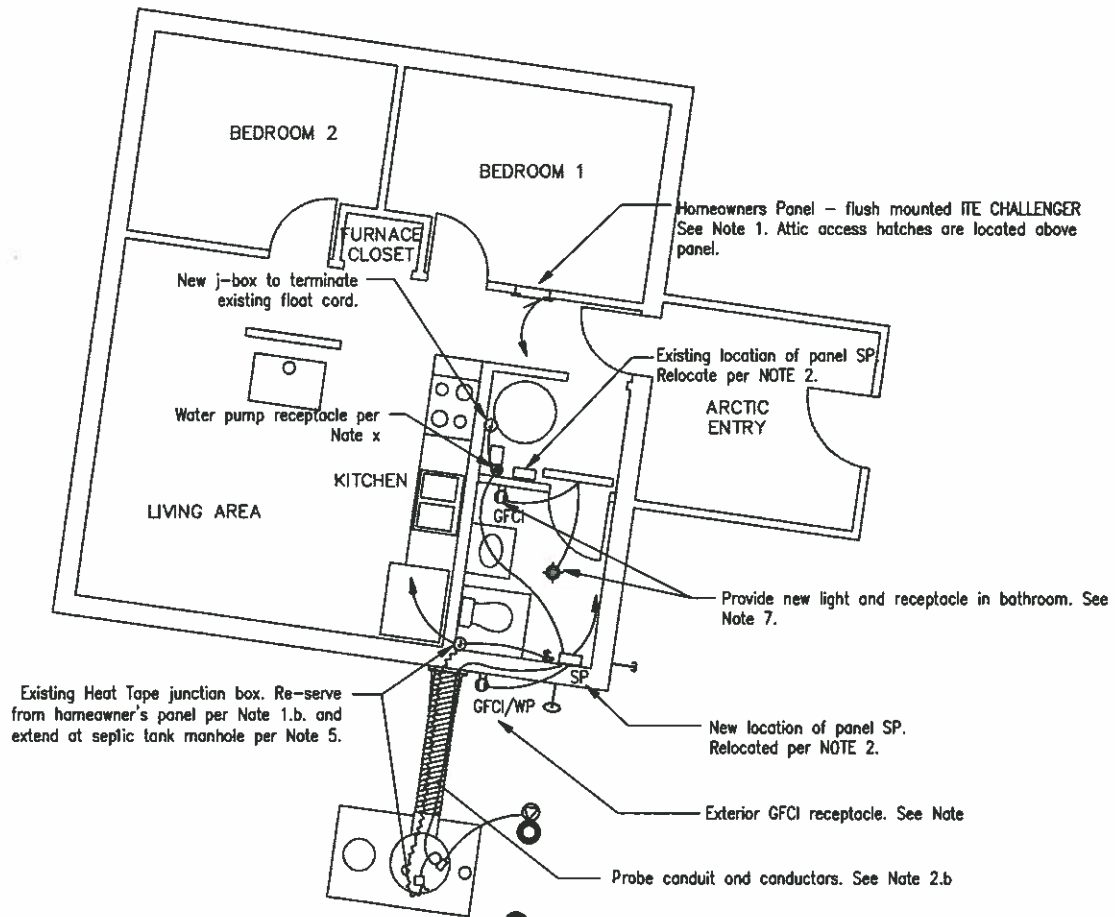

1
—
BUILDING 2 - DAVID HOPE
SCALE AS SHOWN

0 1 2
SCALE IN FEET



This home was not inspected. Review completion checklist (EP 1) and correct as needed..

⚠ Homeowner refused access and stated she d'd not want the improvements.

1
—
BUILDING 4 - BARBARA SOLARI
AS SHOWN

RECORD DRAWING CERTIFICATE
THESE DRAWINGS REFLECT
RECORDED INFORMATION OBTAINED
DURING CONSTRUCTION
INFORMATION PROVIDED HEREIN
IS ACCURATE TO THE BEST OF
MY KNOWLEDGE
NAME: *Barbara Solari*
DATE: 11/11/08

VILLAGE SAFE WATER

3000 ARCTIC BLVD., SUITE 203
ANCHORAGE, ALASKA 99503
PHONE: (907) 362-3252
FAX: (907) 361-2273

VILLAGE OF BEAVER
SANITATION IMPROVEMENTS
BATHROOM UPGRADES
ELECTRICAL
DAVID HOPE - BUILDING 2
BARBARA SOLARI - BUILDING 4

REVISION	BY	DATE
AS-BUILTS	WMM	11/08


Project No. 9966	Date: AUG 2008	Designed: WMM	Drawn: WMM	Approved: WMM
------------------	----------------	---------------	------------	---------------

Sheet No. **EP 2**
SHEET 2 of 15

RESIDENCE # 5 NOTES

1. Provide Bathroom installation per Detail 2 Sheet E2 of the original design in accordance with the Specifications on Pt and with the modifications listed below.
2. Locate the Status Panel and Panel A as shown on this sheet.
3. HEAT TAPE Item 4 Detail 2, E2. Do not provide dual heat tape runs shown but terminate the single run of heat tape at the septic tank manhole. Include a 10 foot length of heat tape in the septic manhole and wrap the probe holder junction box, flange and riser.
4. Provide Septic Tank Heat power supply point as shown on Detail 2, EP 1.

⚠ Homeowner refused access and stated she did not want the improvements.

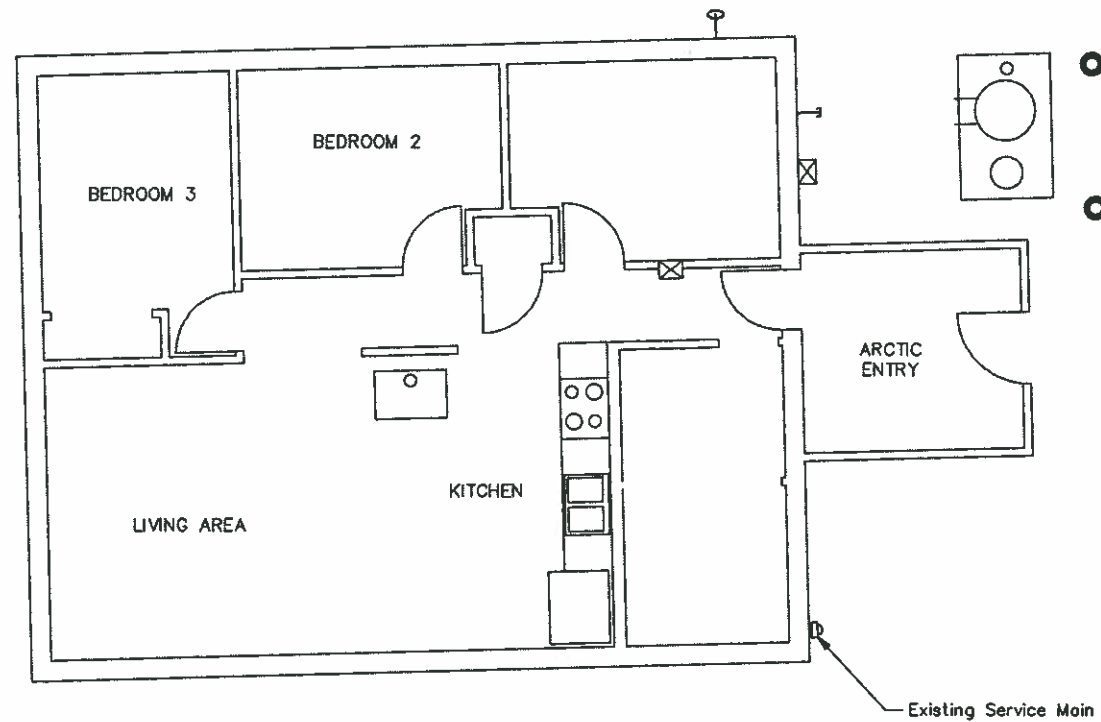

NOTE:
1. BATHROOM CHANGED 4-20-06 PER PAUL WILLIAMS SR.
2. REPLUMBING IN FLOOR CHASE REQUIRED TO AVOID GLUE LAM.
3. CONNECT KITCHEN SINK.
4. NO SHOWER.

1
—

BUILDING 5 - PAUL WILLIAMS SR.
AS SHOWN


0 1 2
SCALE IN FEET



RESIDENCE #7 NOTES

1. Provide Bathroom installation per Detail 1 Sheet E2 of the original design in accordance with the Specifications on E1 and with the modifications listed below.
2. Locate the Status Panel and Panel A as shown on this sheet.
3. HEAT TAPE Item 4 Detail 2, E2. Do not provide dual heat tape runs shown but terminate the single run of heat tape at the septic tank manhole. Include a 10 foot length of heat tape in the septic manhole and wrap the probe holder junction box, flange and riser.
4. Provide 3ea 20/t circuit breakers serving the 2 Kitchen counter receptacles and the Range/hood/refrigerator receptacles as shown. Locate GFCI kitchen counter receptacles 6" above countertop, and refrigerator/range receptacles at 12" AFF and provide a pigtail at 72" for the range hood.

⚠ Homeowner refused access and stated she did not want the improvements.

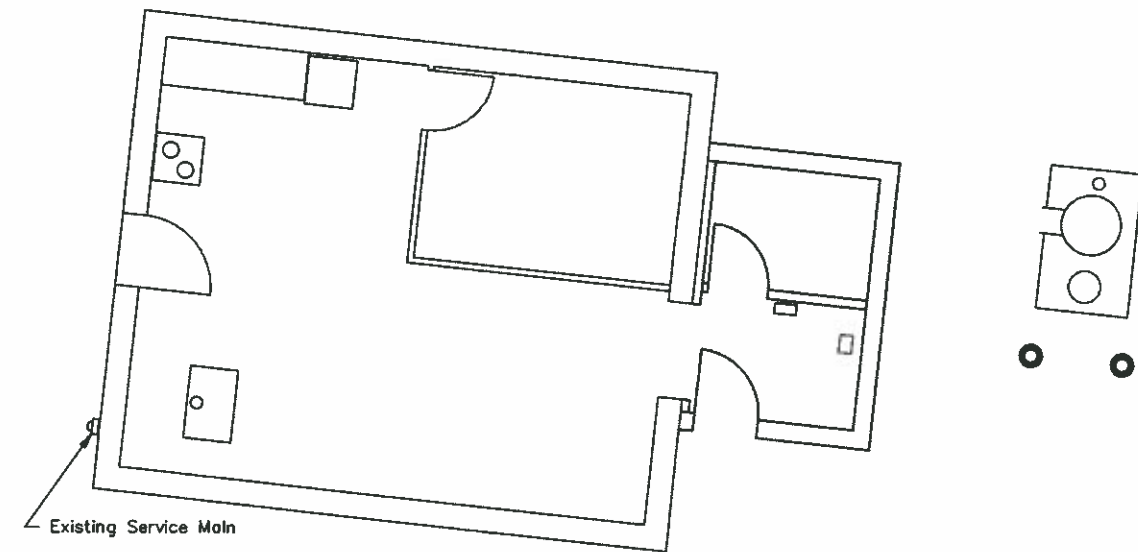

2
—

BUILDING 7 - WILMA PITKA
AS SHOWN

RECORD DRAWING CERTIFICATE
THESE DRAWINGS REFLECT
RECORDED INFORMATION OBTAINED
DURING CONSTRUCTION
INFORMATION PROVIDED HEREIN
IS ACCURATE TO THE BEST OF
MY KNOWLEDGE
DATE 11/11/08
NAME




VILLAGE OF BEAVER
SANITATION IMPROVEMENTS
BATHROOM UPGRADES
ELECTRICAL
PAUL WILLIAMS SR. - BUILDING 5
WILMA PITKA - BUILDING 7

REVISION	BY	DATE
AS-BUILT	WM	11/08


Project No.	9966
Date	AUG 2008
Designed	wm
Drawn	wm
Approved	wm

Sheet No. EP 3
SHEET 3 of 15

1. Provide dedicated circuits in homeowner's panel for SP and sewer line heat tape.
 - t.a. Provide a 20/1 circuit breaker for SP,
 - t.b. Provide a GFCI 20/t or 15/t circuit breaker for the sewer line heat tape,
 - t.c. Provide 2 20/1 circuits for the relocated kitchen (use existing and odd as needed).
 - t.d. Identify the circuit used for the water heater (if installed) and
 - t.e. Update new circuits on the panel schedule with the following descriptions: "Water/Sewer Panel", "Sewer Line Heat Tape".
2. Disconnect, remove Status Panel (SP), and re-install in location shown.
 - 2.a. Serve SP on a dedicated circuit from Homeowner's Panel (Note 1.a.).
 - 2.b. Intercept, splice (in new J-box) and extend probe conductors to new location for SP.
 - 2.c. SP to supply circuits for outside GFCI receptacle (Note 4) and water pump simplex receptacle (NOTE 3). Water pump receptacle is controlled by SP.
3. Provide a simplex receptacle for the water pump. Locate near water pump. Provide label on cover plate: "WATER PUMP ONLY". Serve with 3/12(N, G, Switch leg) on controlled circuit from SP. Install a 3P plug (HUBBELL HBL5965VBK or equal) on the water pump pigtail.
4. Exterior GFCI receptacle in weatherproof box with lockable cover. Locate near sewer line. Serve from SP circuit.
5. Remove end kit from heat tape at septic manhole. Splice on additional 10 feet of heat tape and install new end kit. Wrap the new section of heat tape around the probe holder junction box, flange and riser.
6. Provide 2 GFCI receptacles. One on either side of the sink, 6" above the counter top.
7. Provide GFCI receptacle adjacent to sink in bathroom. Serve on existing bathroom circuit
8. Move light switch to location by door.
9. Provide Placard at Heat Tape pilot switch: "SEWER LINE HEAT TAPE".

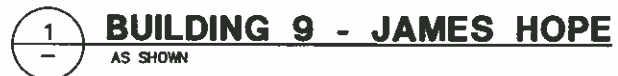


1. Provide dedicated circuits in homeowner's panel for Kitchen, SP and sewer line heat tape/water heater.
 - 1.a. Provide a 20/t circuit breaker for SP,
 - 1.b. Provide a GFCI 20/t or 15/1 circuit breaker for the sewer line heat tape,
 - 1.c. Provide 2 20/1 circuit breakers for the Kitchen
 - 1.d. Use existing Bathroom circuit for new GFCI receptacle at sink, and
 - 1.e. Update new circuits on the panel schedule with the following descriptions: "Water/Sewer Panel", "Sewer Line Heat Tape", "Kitchen".
2. Disconnect, remove Status Panel (SP) and re-install as shown.
 - 2.a. Serve SP on a dedicated circuit from Homeowner's Panel (Note 1.a.).
 - 2.b. Intercept, splice (in new J-box) and extend probe conductors to new location for SP.
 - 2.c. SP to supply circuits for outside GFCI receptacle (Note 4), water heater receptacle and water pump simplex receptacle (NOTE 3). Water pump receptacle is controlled by SP.
 - 2.d. Patch any holes that remain in SP enclosure after conduit installation is completed.
3. Provide a simplex receptacle for the water pump. Locate near water pump. Provide label on cover plate: "WATER PUMP ONLY". Serve with 3#12(N, G, Switch leg) on controlled circuit from SP. Install a 3P plug (HUBBELL HBL5965VBK or equal) on the water pump pigtail.
4. Exterior GFCI receptacle in weatherproof box with lockable cover. Locate near sewer line. Serve from SP circuit.
5. Remove end kit from heat tape at septic manhole. Splice on additional 10 feet of heat tape and install new end kit. Wrap the new section of heat tape around the probe holder junction box, flange and riser.
6. Provide 2 GFCI receptacles. One on either side of the sink, 6" above the counter top.
7. Provide GFCI receptacle adjacent to sink in bathroom. Serve on existing bathroom circuit.
8. Move light switch to location by door.
9. Provide Placard at Heat Tape pilot switch: "SEWER LINE HEAT TAPE".

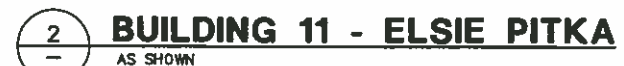


Sheet No. EP 4
SHEET 4 OF 15

RESIDENCE #12 NOTES

- Provide dedicated circuits in homeowner's panel for SP and sewer line heat tape.
 - Provide a 20/1 circuit breaker for SP.
 - Provide a GFCI 20/1 or 15/1 circuit breaker for the sewer line heat tape.
 - Update new circuits on the panel schedule with the following descriptions: "Water/Sewer Panel", "Sewer Line Heat Tape"
- Disconnect, remove Status Panel (SP), and re-install in location shown (approx. 6" to the left).
 - Serve SP on a dedicated circuit from Homeowner's Panel (Note 1.a.).
 - Extend conduit for probe conductors to SP and to the probe holder in the septic tank manhole. Terminate per control drawing. See Note B.
 - SP to supply circuits for outside GFCI receptacle (Note 4), water heater receptacle and water pump simplex receptacle (NOTE 3). Water pump receptacle is controlled by SP.
- Provide a simplex receptacle for the water pump. Locate near water pump. Provide label on cover plate: "WATER PUMP ONLY". Serve with 3#12(N, G, Switch leg) on controlled circuit from SP. Install a 3P plug (HUBBELL HBL5965VBK or equal) on the water pump pigtail.
- Exterior GFCI receptacle in weatherproof box with lockable cover. Locate near sewer line. Serve from SP circuit.
- Remove end kit from heat tape at septic manhole. Splice an additional 10 feet of heat tape and install new end kit. Wrap the new section of heat tape around the probe holder junction box, flange and riser.
- Provide Placard at Heat Tape pilot switch: "SEWER LINE HEAT TAPE".
- Provide GFCI receptacle adjacent to sink in bathroom. Serve on existing bathroom circuit
- Provide control connections for the level probes. conduit is partially installed. Complete the installation and terminate conductors per the control panel drawing (See Sheet SP-1).

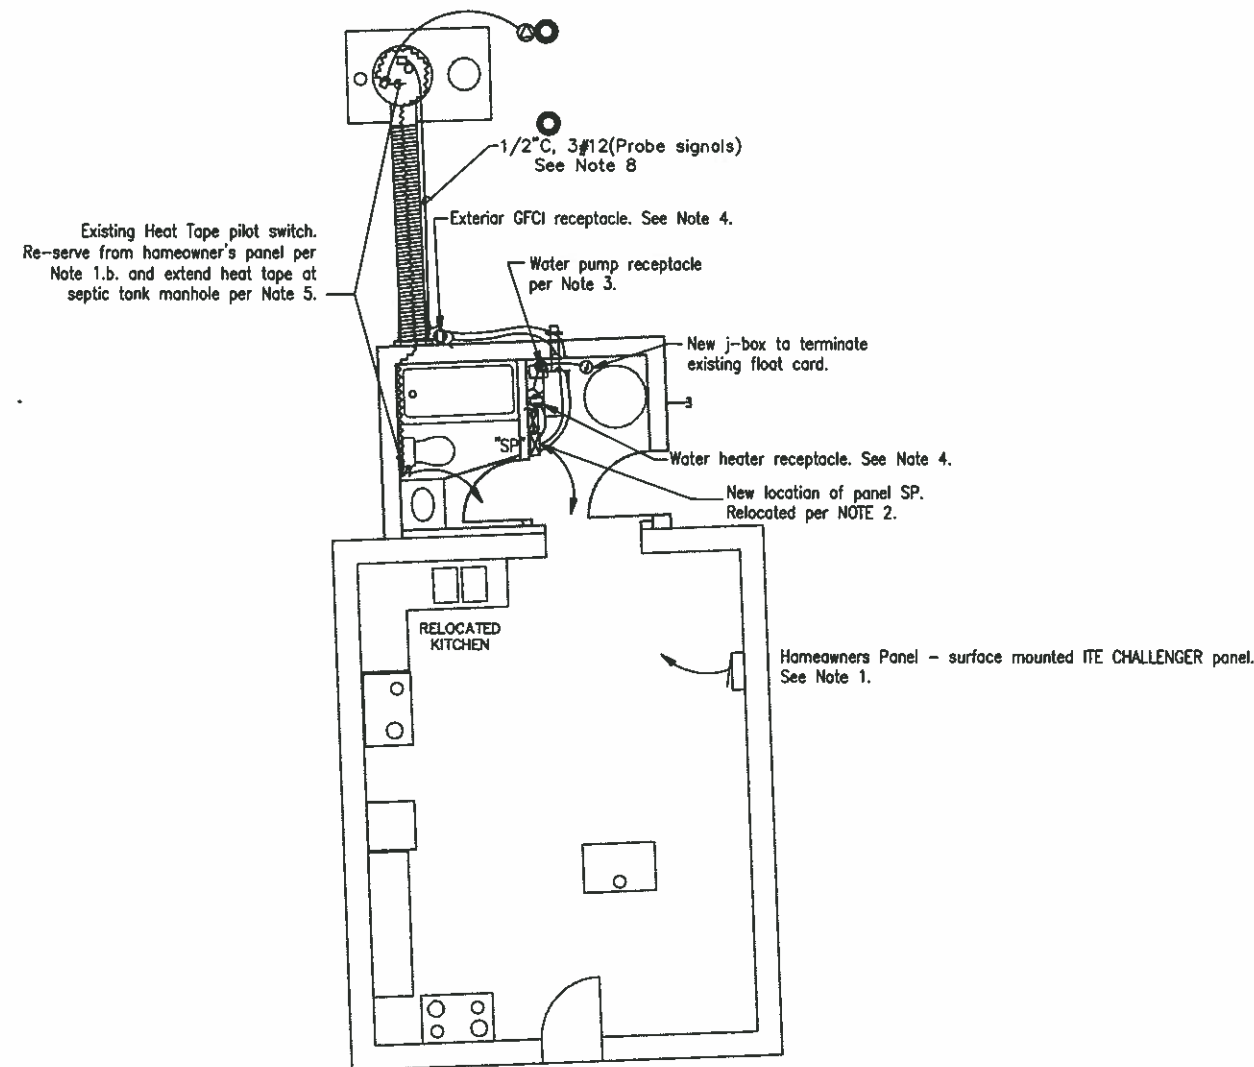


1 BUILDING 12 - MARY SAM (PAUL JR.)
AS SHOWN

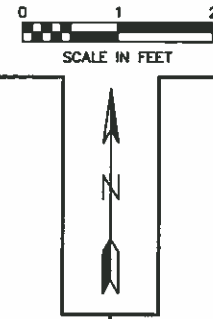

RESIDENCE #13 NOTES

- Provide dedicated circuits in homeowner's panel for SP and sewer line heat tape.
 - Provide a 20/1 circuit breaker for SP.
 - Provide a GFCI 20/1 or 15/1 circuit breaker for the sewer line heat tape.
 - Update new circuits on the panel schedule with the following descriptions: "Water/Sewer Panel", "Sewer Line Heat Tape".
- Disconnect, Status Panel (SP) and re-install as shown.
 - Serve SP on a dedicated circuit from Homeowner's Panel (Note 1.a.).
 - Intercept, splice (in new J-box) and extend probe conductors to new location for SP.
 - SP to supply circuits for outside GFCI receptacle (Note 4), water heater receptacle and water pump simplex receptacle (NOTE 3). Water pump receptacle is controlled by SP.
 - Patch any holes that remain in SP enclosure after conduit installation is completed.
- Provide a simplex receptacle for the water pump. Locate near water pump. Provide label on cover plate: "WATER PUMP ONLY". Serve with 3#12(N, G, Switch leg) on controlled circuit from SP. Install a 3P plug (HUBBELL HBL5965VBK or equal) on the water pump pigtail.
- Exterior GFCI receptacle in weatherproof box with lockable cover. Locate near sewer line. Serve from SP circuit.
- Remove end kit from heat tape at septic manhole. Splice an additional 10 feet of heat tape and install new end kit. Wrap the new section of heat tape around the probe holder junction box, flange and riser. See Detail 1/EP1.
- Provide tank heater power supply extension. See Detail 2/EP1.
- Provide Placard at Heat Tape pilot switch: "SEWER LINE HEAT TAPE".

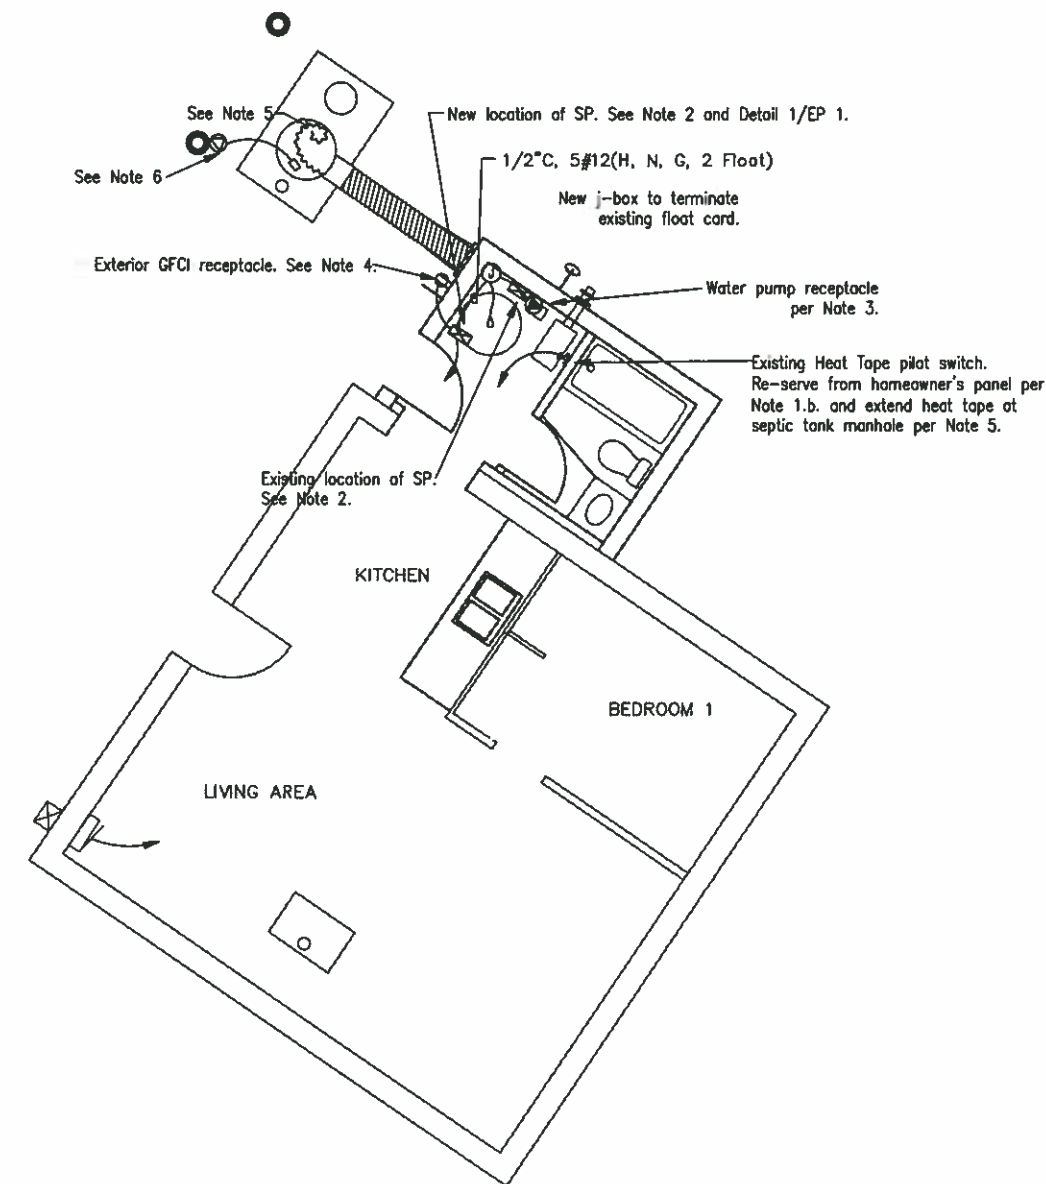

2 BUILDING 13 - GEORGE YATLIN
AS SHOWN

RECORD DRAWING CERTIFICATE
THESE DRAWINGS REFLECT
RECORDED INFORMATION OBTAINED
DURING CONSTRUCTION. HEREIN
IS ACCURATE TO THE BEST OF
MY KNOWLEDGE.
DATE 11/11/08
NAME



VILLAGE OF BEAVER
SANITATION IMPROVEMENTS
BATHROOM UPGRADES
ELECTRICAL
MARY SAM (PAUL JR.) - BUILDING 12
GEORGE YATLIN - BUILDING 13

REVISION	BY	DATE
AS-BUILTS	WMH	11/08


Project No.	9966
Date	AUG 2008
Designed	WMH
Drawn	WMH
Approved	WMH

Sheet No. EP 5
SHEET 5 of 15

RESIDENCE #15 NOTES

- Provide dedicated circuits in homeowner's panel for SP and sewer line heat tape.
 - Provide a 20/1 circuit breaker for SP.
 - Provide a GFCI 20/1 or 15/1 circuit breaker for the sewer line heat tape.
 - Update new circuits on the panel schedule with the following descriptions: "Water/Sewer Panel", "Sewer Line Heat Tape".
- Disconnect, remove Status Panel (SP) and re-install as shown.
 - Serve SP on a dedicated circuit from Homeowner's Panel (Note 1.a.).
 - Intercept, splice (in new J-box) and extend probe conductors to new location for SP.
 - SP to supply circuits for outside GFCI receptacle (Note 4), water heater receptacle and water pump simplex receptacle (NOTE 3). Water pump receptacle is controlled by SP.
 - Patch any holes that remain in SP enclosure after conduit installation is completed.
- Provide a simplex receptacle for the water pump. Locate near water pump. Provide label on cover plate: "WATER PUMP ONLY". Serve with 3#12(N, G, Switch leg) on controlled circuit from SP. Install a 3P plug (HUBBELL HBL5965VBK or equal) on the water pump pigtail.
- Exterior GFCI receptacle in weatherproof box with lockable cover. Locate near sewer line. Serve from SP circuit.
- Remove end kit from heat tape at septic manhole. Splice an additional 10 feet of heat tape and install new end kit. Wrap the new section of heat tape around the probe holder junction box, flange and riser. See Detail 1/EP1.
- Extend tank heater power source to inlet on riser. See Detail 2/EP 1.
- Provide Placard at Heat Tape pilot switch: "SEWER LINE HEAT TAPE".

0 1 2
SCALE IN FEET

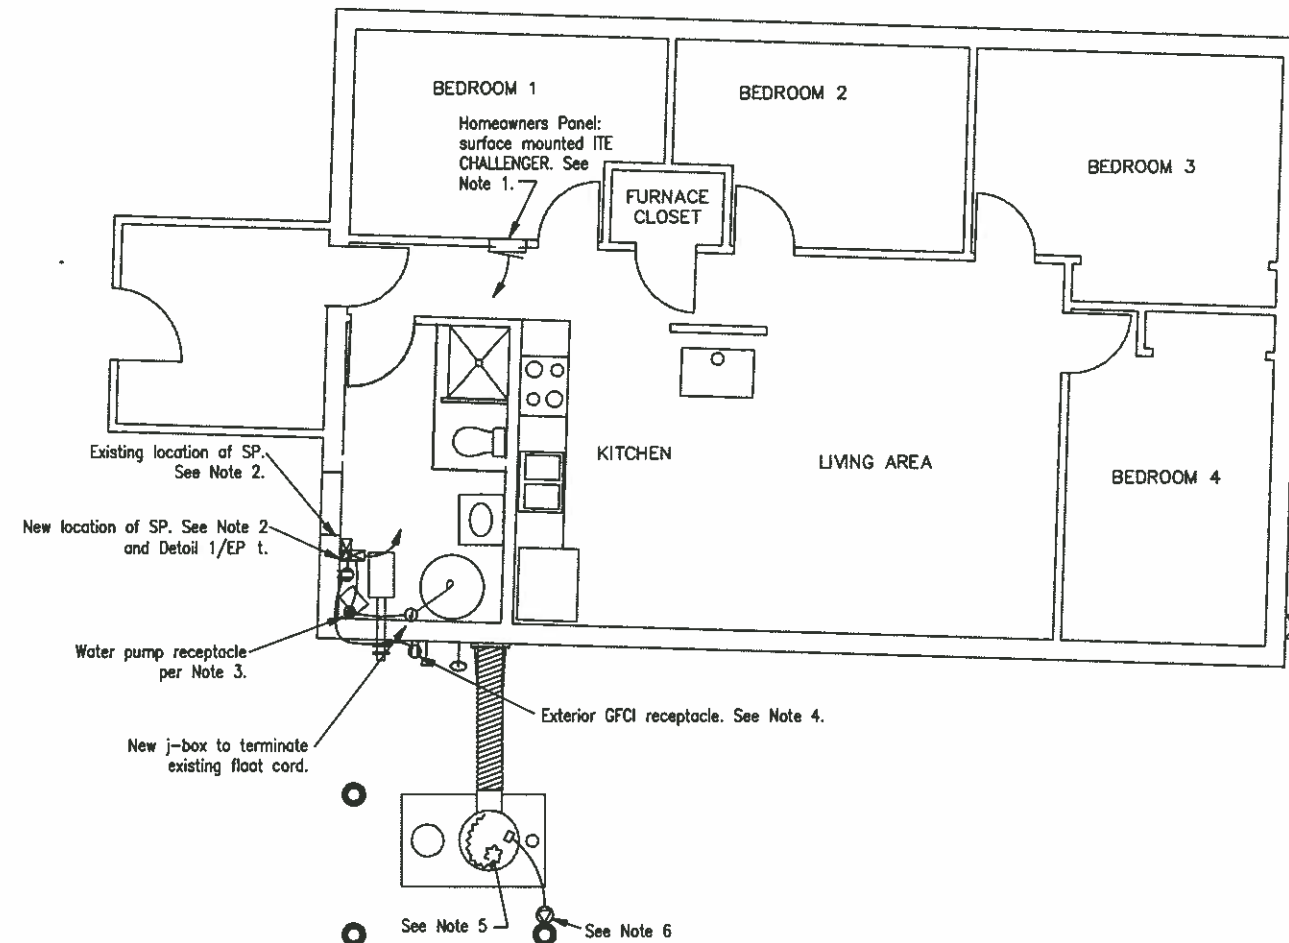


1
—
BUILDING 15 - SELENA PETRUSKA
AS SHOWN

RESIDENCE #17 NOTES

- Provide dedicated circuits in homeowner's panel for SP and sewer line heat tape.
 - Provide a 20/1 circuit breaker for SP.
 - Provide a GFCI 20/1 or 15/1 circuit breaker for the sewer line heat tape.
 - Update new circuits on the panel schedule with the following descriptions: "Water/Sewer Panel", "Sewer Line Heat Tape".
- Disconnect, remove Status Panel (SP) and re-install as shown.
 - Serve SP on a dedicated circuit from Homeowner's Panel (Note 1.a.).
 - Intercept, splice (in new J-box) and extend probe conductors to new location for SP.
 - SP to supply circuits for outside GFCI receptacle (Note 4), water heater receptacle and water pump simplex receptacle (NOTE 3). Water pump receptacle is controlled by SP.
 - Patch any holes that remain in SP enclosure after conduit installation is completed.
- Provide a simplex receptacle for the water pump. Locate near water pump. Provide label on cover plate: "WATER PUMP ONLY". Serve with 3#12(N, G, Switch leg) on controlled circuit from SP. Install a 3P plug (HUBBELL HBL5965VBK or equal) on the water pump pigtail.
- Exterior GFCI receptacle in weatherproof box with lockable cover. Locate near sewer line. Serve from SP circuit.
- Remove end kit from heat tape at septic manhole. Splice an additional 10 feet of heat tape and install new end kit. Wrap the new section of heat tape around the probe holder junction box, flange and riser. See Detail 1/EP1.
- Extend tank heater power source to inlet on riser. See Detail 2/EP 1.
- Provide Placard at Heat Tape pilot switch: "SEWER LINE HEAT TAPE".

New location of SP. See Note 2
and Detail 1/EP t.

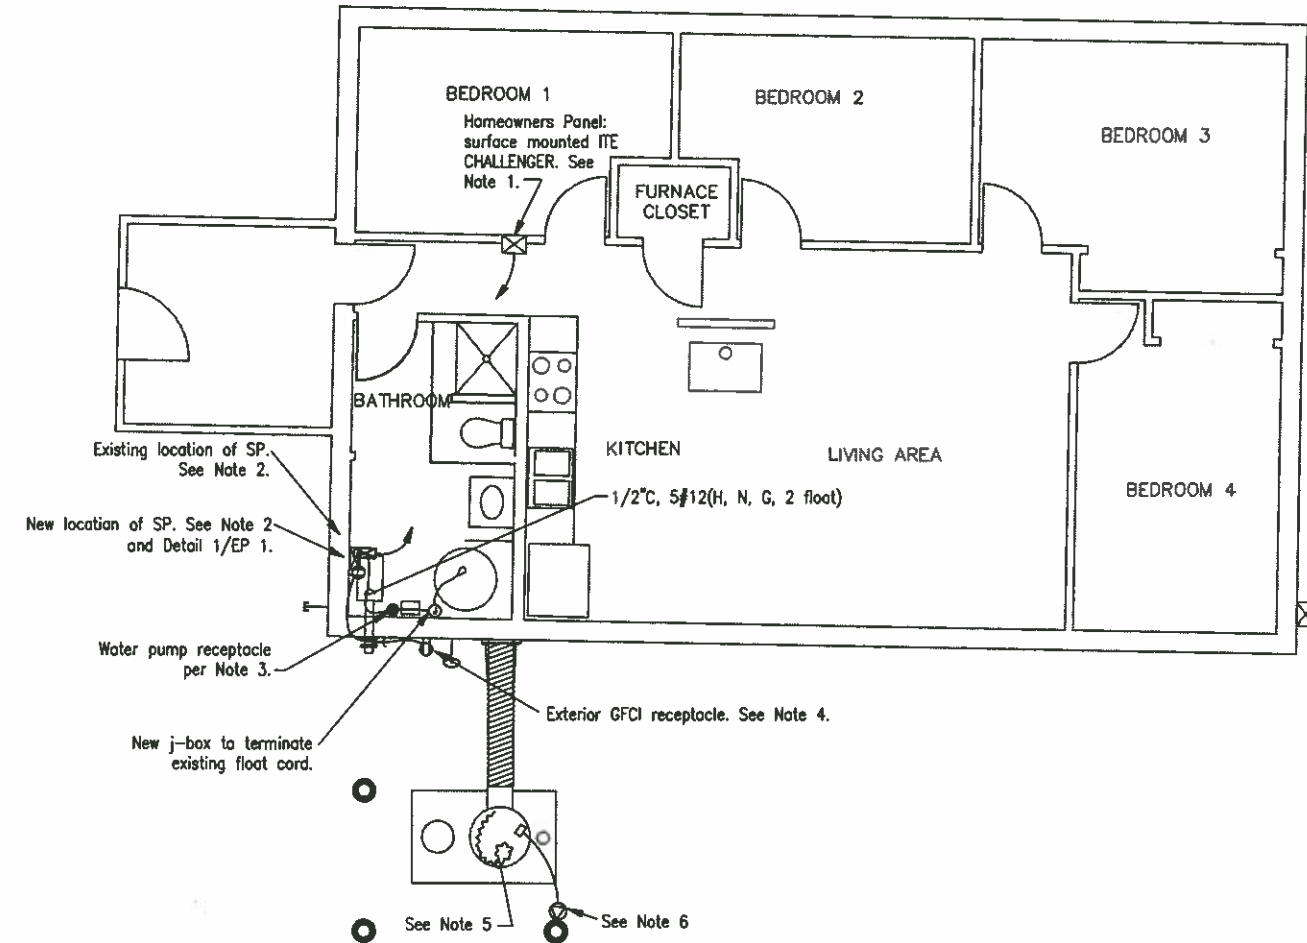

2
—
BUILDING 17 - VIVIAN JUMEABY
AS SHOWN

RECORD DRAWING CERTIFICATE
THESE DRAWINGS REFLECT
RECORDED INFORMATION OBTAINED
DURING CONSTRUCTION.
INFORMATION PROVIDED HEREIN
IS ACCURATE TO THE BEST OF
MY KNOWLEDGE.
DATE 11/11/08
NAME



VILLAGE OF BEAVER
SANITATION IMPROVEMENTS
BATHROOM UPGRADES
ELECTRICAL
SELENA PETRUSKA - BUILDING 15
VIVIAN JUMEABY - BUILDING 17


REVISION	BY	DATE
AS-BUILT	MM	11/08

Project No.	9966	Date	AUGUST 2008	Designed	MM	Drawn	MM	Approved	MM
-------------	------	------	-------------	----------	----	-------	----	----------	----

Sheet No. EP 6
SHEET 6 OF 15

RESIDENCE #20 NOTES


- Provide dedicated circuits in homeowner's panel for SP and sewer line heat tape.
 - Provide a 20/1 circuit breaker for SP.
 - Provide a GFCI 20/1 or 15/1 circuit breaker for the sewer line heat tape.
 - Update new circuits on the panel schedule with the following descriptions: "Water/Sewer Panel", "Sewer Line Heat Tape".
- Disconnect, remove Status Panel (SP) and re-install as shown.
 - Serve SP on a dedicated circuit from Homeowner's Panel (Note 1.a.).
 - Intercept, splice (in new J-box) and extend probe conductors to new location for SP.
 - SP to supply circuits for outside GFCI receptacle (Note 4), water heater receptacle and water pump simplex receptacle (NOTE 3). Water pump receptacle is controlled by SP.
 - Patch any holes that remain in SP enclosure after conduit installation is completed.
- Provide a simplex receptacle for the water pump. Locate near water pump. Provide label on cover plate: "WATER PUMP ONLY". Serve with 3#12(N, G, Switch leg) on controlled circuit from SP. Install a 3P plug (HUBBELL HBL5965VBK or equal) on the water pump pigtail.
- Exterior GFCI receptacle in weatherproof box with lockable cover. Locate near sewer line. Serve from SP circuit.
- Remove end kit from heat tape at septic manhole. Splice on additional 10 feet of heat tape and install new end kit. Wrap the new section of heat tape around the probe holder junction box, flange and riser. See Detail 1/EP1.
- Extend tank heater power source to inlet on riser. See Detail 2/EP 1.
- Provide Placard at Heat Tape pilot switch: "SEWER LINE HEAT TAPE".

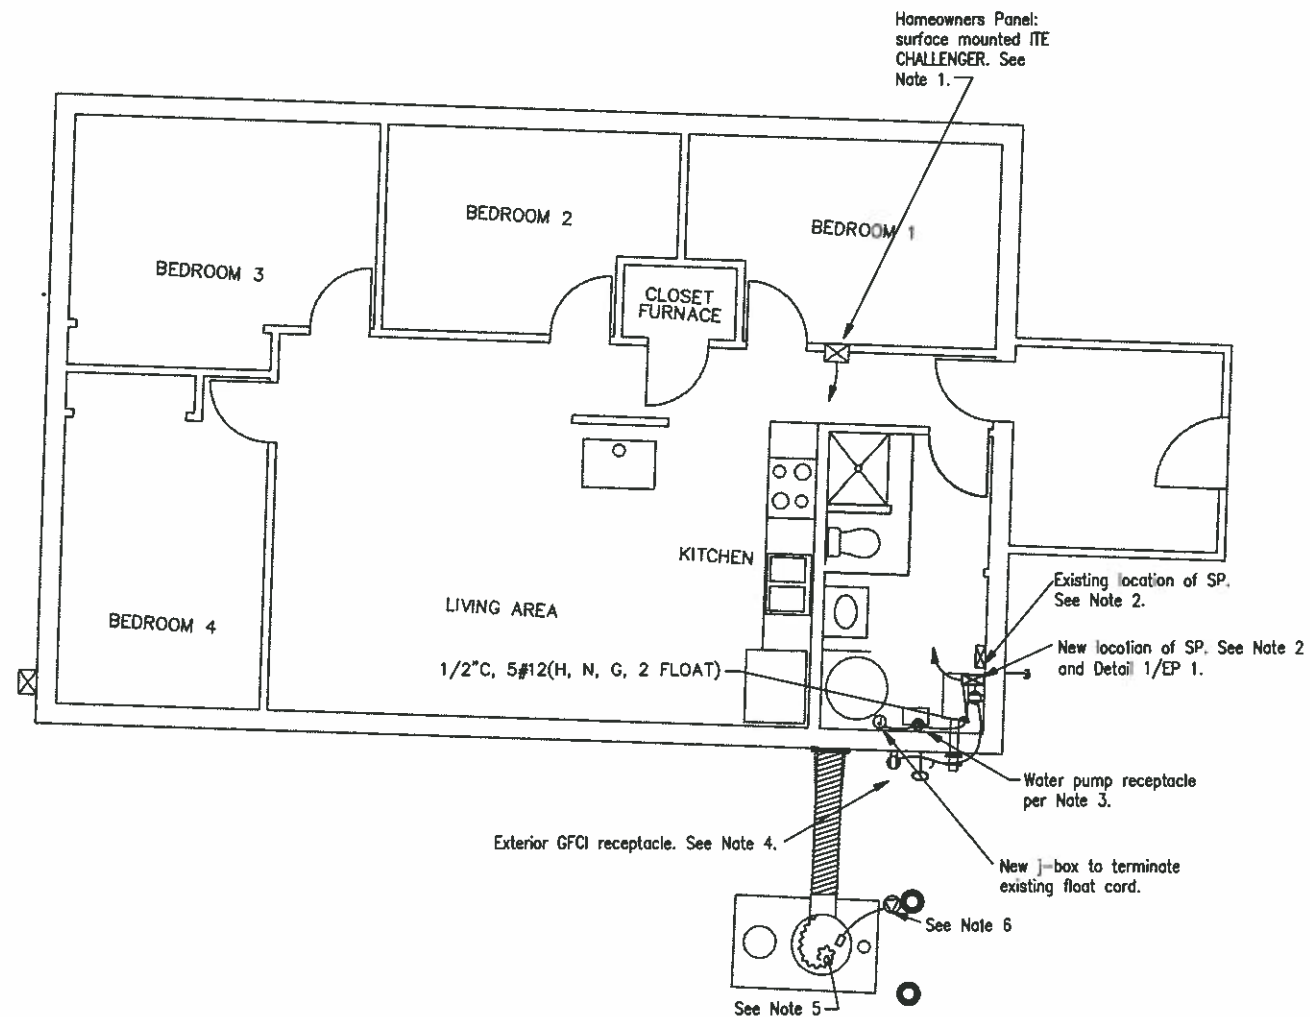

1 BUILDING 20 - ANNA JOSEPH
AS SHOWN

RESIDENCE #22 NOTES

- Provide dedicated circuits in homeowner's panel for Kitchen, SP and sewer line heat tape/water heater.
 - Provide a 20/1 circuit breaker for SP.
 - Verify existing Bathroom GFCI receptacle at sink is used for sewer line heat tape, and
 - Update new circuits on the panel schedule with the following description: "Water/Sewer Panel".
- Disconnect, remove Status Panel (SP) and re-install as shown.
 - Serve SP on a dedicated circuit from Homeowner's Panel (Note 1.a.).
 - Intercept, splice (in new J-box) and extend probe conductors to new location for SP.
 - SP to supply circuits for outside GFCI receptacle (Note 4), water heater receptacle and water pump simplex receptacle (NOTE 3). Water pump receptacle is controlled by SP.
 - Patch any holes that remain in SP enclosure after conduit installation is completed.
- Provide a simplex receptacle for the water pump. Locate near water pump. Provide label on cover plate: "WATER PUMP ONLY". Serve with 3#12(N, G, Switch leg) on controlled circuit from SP. Install a 3P plug (HUBBELL HBL5965VBK or equal) on the water pump pigtail.
- Exterior GFCI receptacle in weatherproof box with lockable cover. Locate near sewer line. Serve from SP circuit.
- Remove end kit from heat tape at septic manhole. Splice on additional 10 feet of heat tape and install new end kit. Wrap the new section of heat tape around the probe holder junction box, flange and riser.
- Extend septic tank heater power connection to inlet mounted on the vent riser. See Detail 2/EP 1.

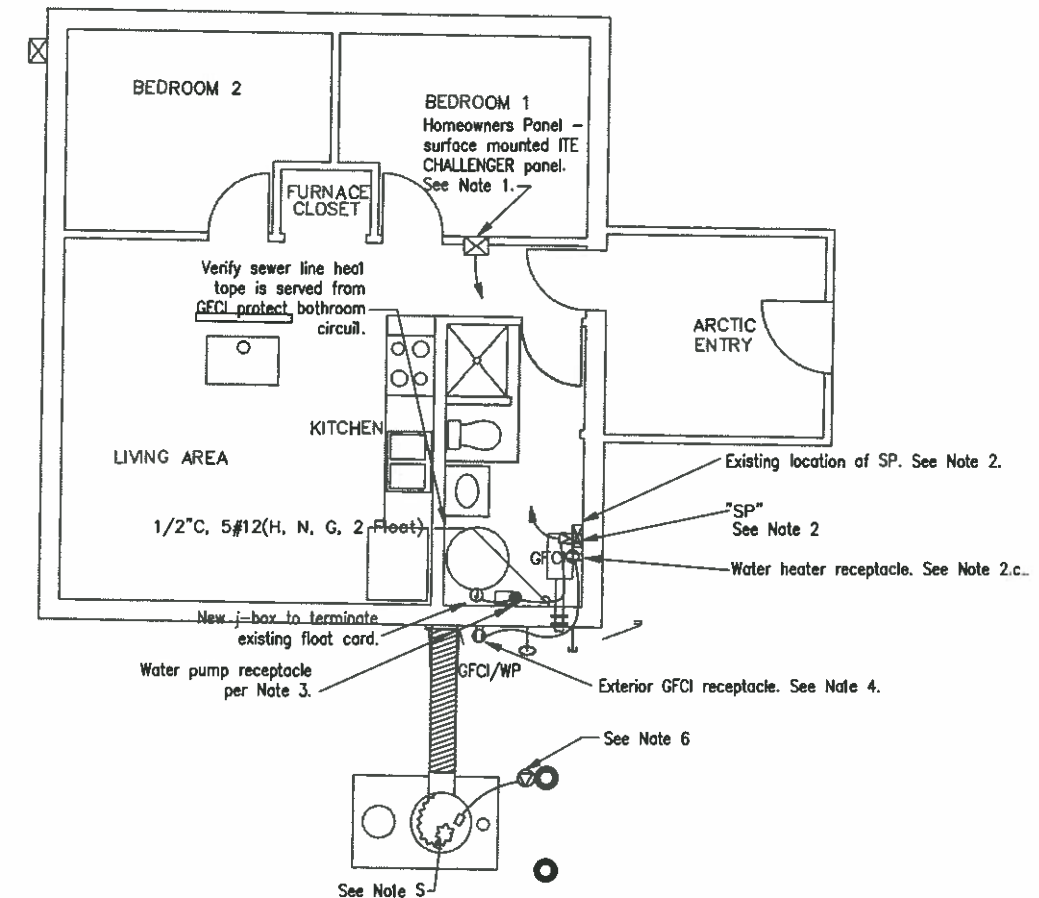


2 BUILDING 22 - HANNAH ADAMS (BABES)
AS SHOWN

RECORD DRAWING CERTIFICATE		THESE DRAWINGS REFLECT RECORDED INFORMATION OBTAINED DURING CONSTRUCTION. INFORMATION PROVIDED HEREIN IS ACCURATE TO THE BEST OF MY KNOWLEDGE.		DATE 11/11/08	
VILLAGE SAFE WATER		STATE OF ALASKA		REGISTERED PROFESSIONAL ENGINEER	
CRW ENGINEERING GROUP LLC		3800 ARCTIC BLVD., SUITE 203 ANCHORAGE, ALASKA 99503 PHONE: (907) 562-3252 FAX: (907) 561-2273			
VILLAGE OF BEAVER SANITATION IMPROVEMENTS		BATHROOM UPGRADES ELECTRICAL		ANNA JOSEPH - BUILDING 20 HANNAH ADAMS (BABES) - BUILDING 22	
REVISION	BY	DATE			
AS-BUILT	WM	11/08			
Project No.	9966	Date	AUGUST 2008	Designed	WM
				Drawn	WM
				Approved	WM
Sheet No.			EP 7		
SHEET			7 OF 15		

RESIDENCE #23 NOTES

- Provide dedicated circuits in homeowner's panel for SP and sewer line heat tape.
 - Provide a 20/1 circuit breaker for SP.
 - Provide a GFCI 20/t or t5/t circuit breaker for the Bathroom serving the sink receptacle, sewer line heat tape, and water heater.
 - Update new circuits on the panel schedule with the following descriptions: "Water/Sewer Panel", "Bathroom"
- Disconnect, remove Status Panel (SP), and re-install in location shown.
 - Serve SP on a dedicated circuit from Homeowner's Panel (Note 1.a.).
 - Complete partial installation of conduit for probe conductors between SP and the probe holder in the septic tank manhole, terminate per control drawing.
 - SP to supply circuits for outside GFCI receptacle (Note 4), water heater receptacle and water pump simplex receptacle (NOTE 3). Water pump receptacle is controlled by SP.
- Provide a simplex receptacle for the water pump. Locate near water pump. Provide label on cover plate: "WATER PUMP ONLY". Serve with 3#12(N, G, Switch leg) on controlled circuit from SP. Install a 3P plug (HUBBELL HBL5965VBK or equal) on the water pump pigtail.
- Exterior GFCI receptacle in weatherproof box with lockable cover. Locate near sewer line. Serve from SP circuit.
- Remove end kit from heat tape at septic manhole. Splice an additional 10 feet of heat tape and install new end kit. Wrap the new section of heat tape around the probe holder junction box, flange and riser.
- Provide Placard at Heat Tape pilot switch: "SEWER LINE HEAT TAPE".
- Provide GFCI receptacle adjacent to sink in bathroom.

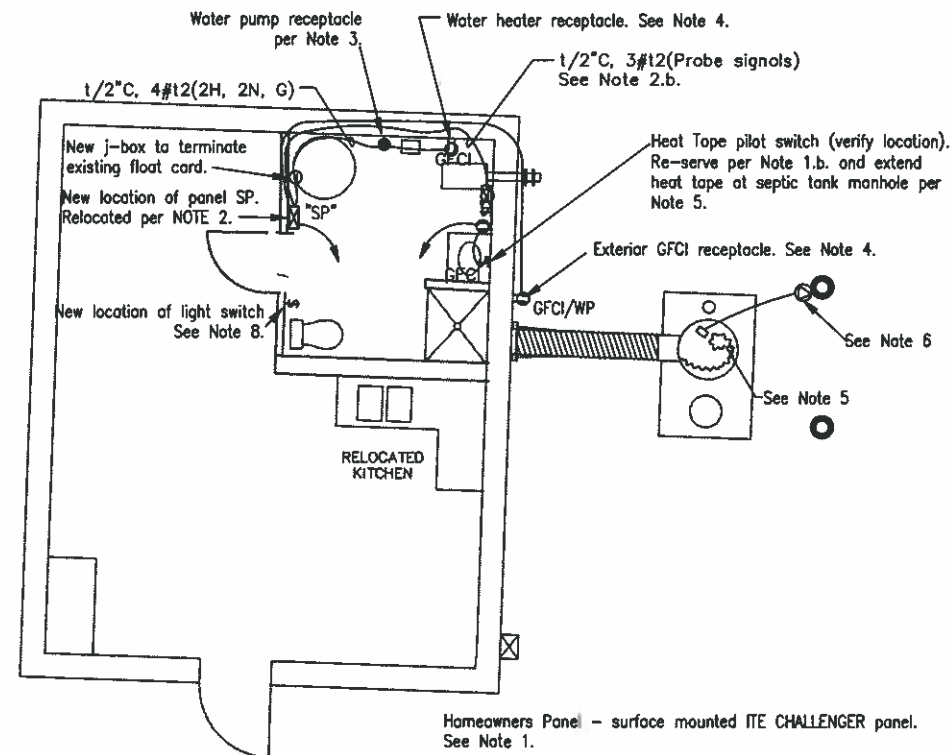


0 1 2
SCALE IN FEET



RESIDENCE #24 NOTES

- Provide dedicated circuits in homeowner's panel for SP.
 - Provide a 20/1 circuit breaker for SP.
 - Update new circuits on the panel schedule with the following description: "Water/Sewer Panel".
- Disconnect, remove Status Panel (SP) and re-install as shown.
 - Serve SP on a dedicated circuit from Homeowner's Panel (Note 1.a.).
 - Intercept, splice (in new J-box) and extend probe conductors to new location for SP (See also Note 8).
 - SP to supply circuits for outside GFCI receptacle (Note 4), water pump simplex receptacle (NOTE 3). Water pump receptacle is controlled by SP.
 - Patch any holes that remain in SP enclosure after conduit installation is completed.
- Provide a simplex receptacle for the water pump. Locate near water pump. Provide label on cover plate: "WATER PUMP ONLY". Serve with 3#12(N, G, Switch leg) on controlled circuit from SP. Install a 3P plug (HUBBELL HBL5965VBK or equal) on the water pump pigtail.
- Exterior GFCI receptacle in weatherproof box with lockable cover. Locate near sewer line. Serve from SP circuit.
- Remove end kit from heat tape at septic manhole. Splice an additional 10 feet of heat tape and install new end kit. Wrap the new section of heat tape around the probe holder junction box, flange and riser. See Detail 1/EP1.
- Provide tank heater power supply extension. See Detail 2/EP1.
- Provide Placard at Heat Tape pilot switch: "SEWER LINE HEAT TAPE". In Bathroom, provide PVC sleeve for heat tape between the floor and power point j-box.
- Disconnect receptacle located in the septic tank manhole, and disconnect the circuit serving it. The control conductors cannot share the same conduit with power due to their power class rating. Tie back unused conductors and label as spare.

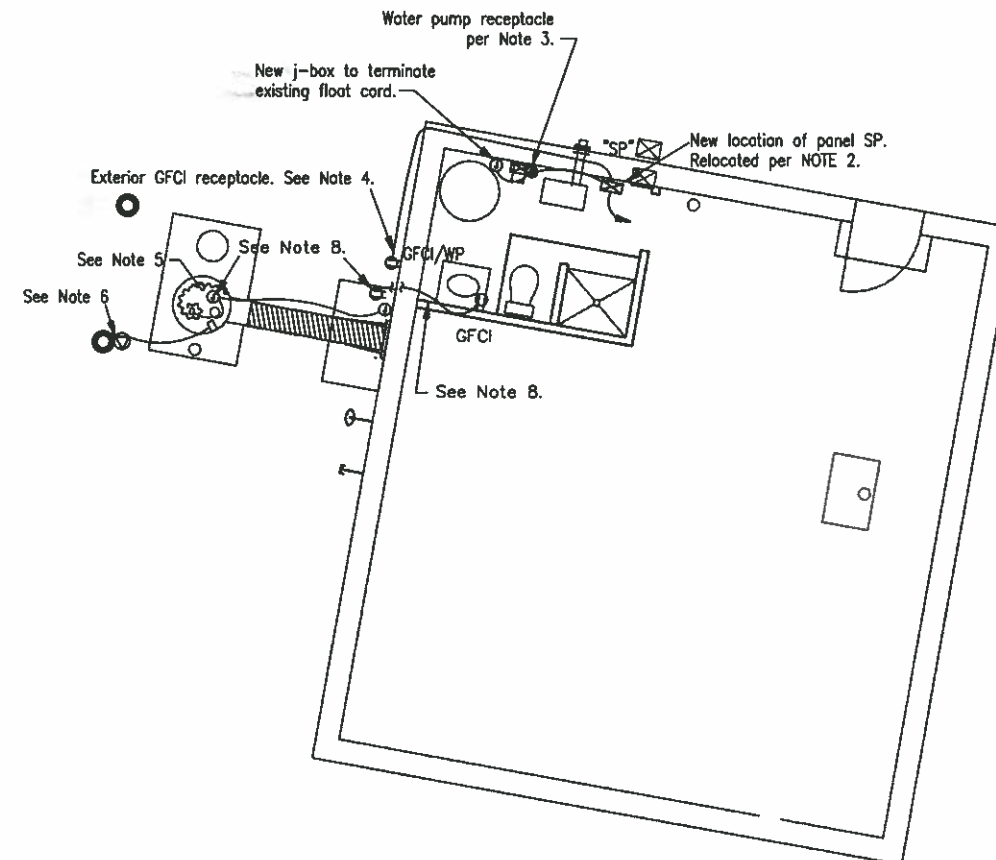

RECORD DRAWING CERTIFICATE
THESE DRAWINGS REFLECT
RECORDED INFORMATION OBTAINED
DURING CONSTRUCTION.
INFORMATION PROVIDED HEREIN
IS ACCURATE TO THE BEST OF
MY KNOWLEDGE.
NAME: [Signature]
DATE: 11/11/08




VILLAGE OF BEAVER
SANITATION IMPROVEMENTS
BATHROOM UPGRADES
ELECTRICAL
ALVIN WINER - BUILDING 23
WILLIAM HENRY - BUILDING 24

REVISION	BY	DATE
AS-BUILT	MM	11/08

Project No.	9966
Date	MAY - 2006
Designed	M.L.
Drawn	M.L.
Approved	M.L.

RESIDENCE #25 NOTES


- GFCI Provide dedicated circuits in homeowner's panel for Kitchen, SP and sewer line heat tape/water heater.
1.a. Provide a 20/1 circuit breaker for SP,
1.b. Provide a GFCI 20/1 or 15/1 circuit breaker for the sewer line heat tape and water heater GFCI receptacle,
1.c. Update new circuits on the panel schedule with the following descriptions: "Water/Sewer Panel", "Sewer Line Heat Tape".
- Disconnect water pump and float cords from Status Panel (SP) and re-install as shown.
2.a. Serve SP on a dedicated circuit from Homeowner's Panel (Note 1.a.).
2.b. Intercept, splice (in new J-box) and extend probe conductors to new location for SP.
2.c. SP to supply circuits for outside GFCI receptacle (Note 4), water pump simplex receptacle (NOTE 3). Water pump receptacle is controlled by SP.
2.d. Patch any holes that remain in SP enclosure after conduit installation is completed.
- Provide a simplex receptacle for the water pump. Locate near water pump. Provide label on cover plate: "WATER PUMP ONLY". Serve with 3#12(N, G, Switch leg) on controlled circuit from SP. Install a 3P plug (HUBBELL HBL5965VBK or equal) on the water pump pigtail.
- Exterior GFCI receptacle in weatherproof box with lockable cover. Locate near sewer line. Serve from SP circuit.
- Remove end kit from heat tape at septic manhole. Splice on additional 10 feet of heat tape and install new end kit. Wrap the new section of heat tape around the probe holder junction box, flange and riser. See Detail 3/EP 1.
- Extend septic tank heater power connection to inlet mounted on the vent riser. See Detail 2/EP 1.

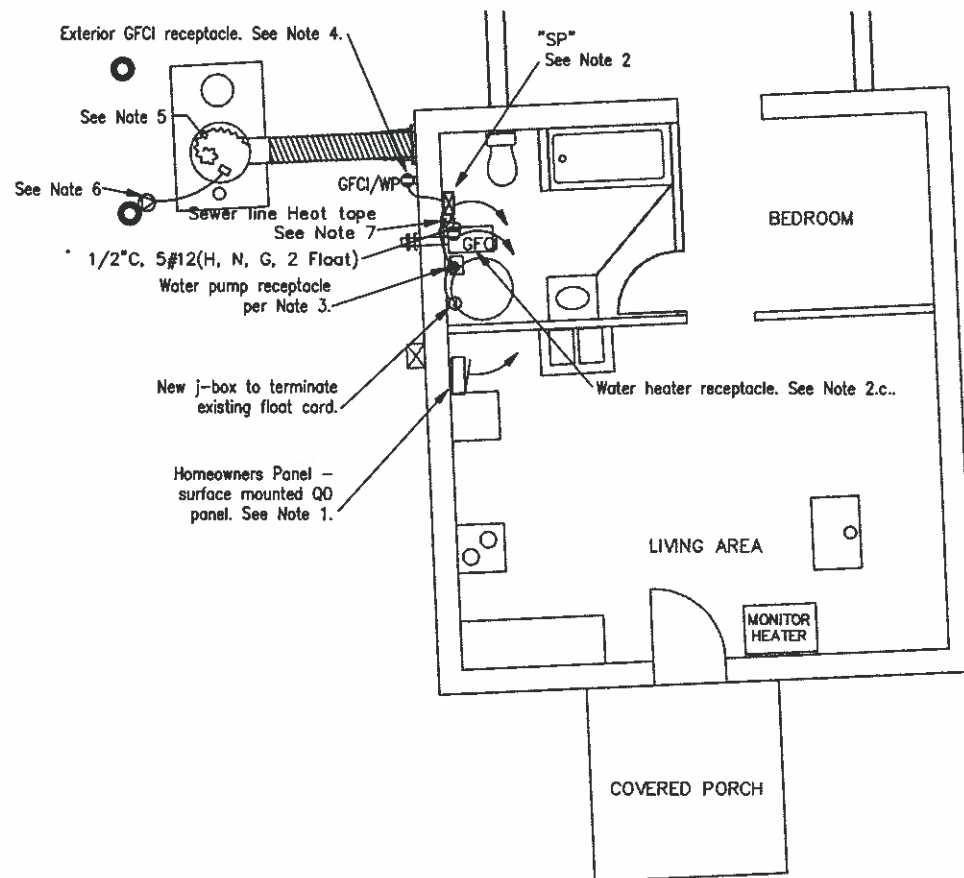

1 BUILDING 25 - NORA BILLY
AS SHOWN

RESIDENCE #26 NOTES

- Provide dedicated circuits in homeowner's panel for SP and sewer line heat tape.
1.a. Provide a 20/1 circuit breaker for SP,
1.b. Update new circuits on the panel schedule with the following description: "Water/Sewer Panel".
- Disconnect, remove Status Panel (SP) and re-install in location shown.
2.a. Serve SP on a dedicated circuit from Homeowner's Panel (Note 1.a.).
2.b. Extend conduit for probe conductors to new location for SP. Provide conductors per original plans and terminate per control drawing.
2.c. SP to supply circuits for outside GFCI receptacle (Note 4), water heater receptacle and water pump simplex receptacle (NOTE 3). Water pump receptacle is controlled by SP.
- Provide a simplex receptacle for the water pump. Locate near water pump. Provide label on cover plate: "WATER PUMP ONLY". Serve with 3#12(N, G, Switch leg) on controlled circuit from SP. Install a 3P plug (HUBBELL HBL5965VBK or equal) on the water pump pigtail.
- Exterior GFCI receptacle in weatherproof box with lockable cover. Locate near sewer line. Serve from SP circuit.
- Remove end kit from heat tape at septic manhole. Splice on additional 10 feet of heat tape and install new end kit. Wrap the new section of heat tape around the probe holder junction box, flange and riser.
- Provide Placard at Heat Tape pilot switch: "SEWER LINE HEAT TAPE" serve heat tape circuit from the protected side of the bathroom GFCI receptacle.
- Extend septic tank heater power connection to inlet mounted on the vent riser. See Detail 2/EP 1.

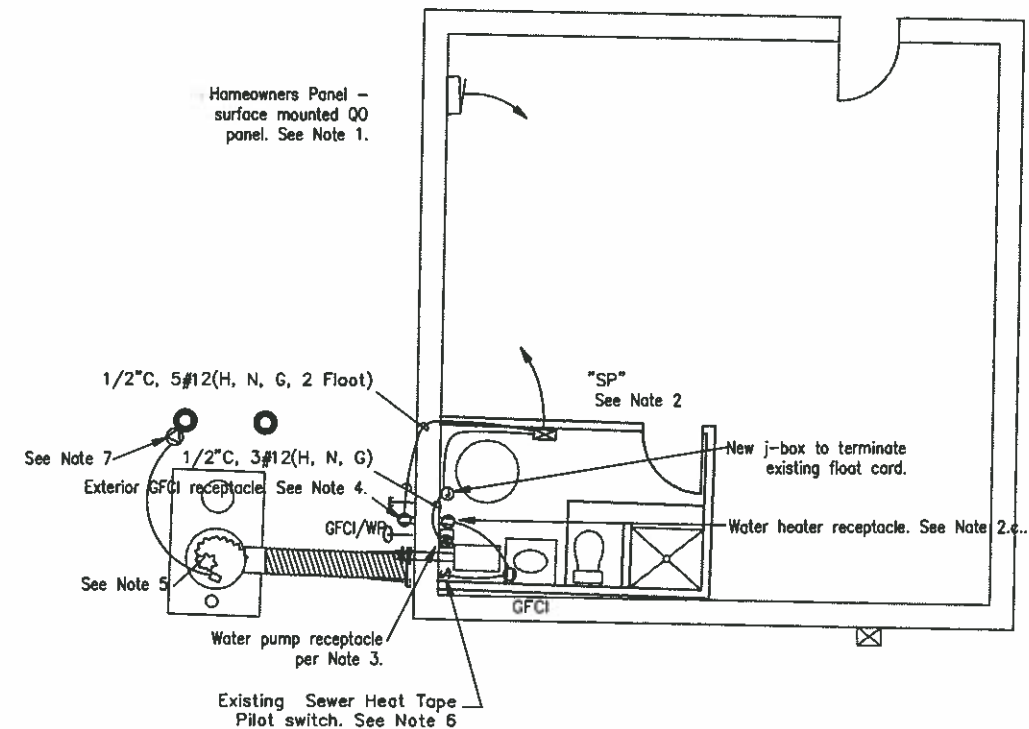

2 BUILDING 26 - ROY HENRY
AS SHOWN

RECORD DRAWING CERTIFICATE	DATE
THESE DRAWINGS REFLECT RECORDED INFORMATION OBTAINED DURING CONSTRUCTION INFORMATION PROVIDED HEREIN IS ACCURATE TO THE BEST OF MY KNOWLEDGE	11/11/08
NAME	




VILLAGE OF BEAVER
SANITATION IMPROVEMENTS
BATHROOM UPGRADES
ELECTRICAL
NORA BILLY - BUILDING 25
ROY HENRY - BUILDING 26

REVISION	BY	DATE
AS-BUILT	MM	11/08

Project No.	9966
Date	AUGUST 2008
Designed	MM
Drawn	MM
Approved	MM

RESIDENCE #27 NOTES


- 1. Provide dedicated circuits in homeowner's panel for SP and sewer line heat tape.
 - 1.a. Provide a 20/1 circuit breaker for SP.
 - 1.b. Update new circuits on the panel schedule with the following description: "Water/Sewer Panel".
- 2. Disconnect, remove Status Panel (SP) and re-install as shown.
 - 2.a. Serve SP on a dedicated circuit from Homeowner's Panel (Note 1.a.).
 - 2.b. Intercept, splice (in new J-box) and extend probe conductors to new location for SP.
 - 2.c. SP to supply circuits for outside GFCI receptacle (Note 4), water heater receptacle and water pump simplex receptacle (NOTE 3). Water pump receptacle is controlled by SP.
 - 2.d. Patch any holes that remain in SP enclosure after conduit installation is completed.
- 3.
- 4. Provide a simplex receptacle for the water pump. Locate near water pump. Provide label on cover plate: "WATER PUMP ONLY". Serve with 3#12(N, G, Switch leg) on controlled circuit from SP. Install a 3P plug (HUBBELL HBL5965VBK or equal) on the water pump pigtail.
- 5. Exterior GFCI receptacle in weatherproof box with lockable cover. Locate near sewer line. Serve from SP circuit.
- 6. Remove end kit from heat tape at septic manhole. Splice an additional 10 feet of heat tape and install new end kit. Wrap the new section of heat tape around the probe holder junction box, flange and riser. See Detail 1/EP1.
- 7.
- 8. Provide tank heater power supply extension. See Detail 2/EP1.
- 9. Provide Placard at Heat Tape pilot switch: "SEWER LINE HEAT TAPE". In Bathroom, provide PVC sleeve for heat tape between the floor and power point j-box.

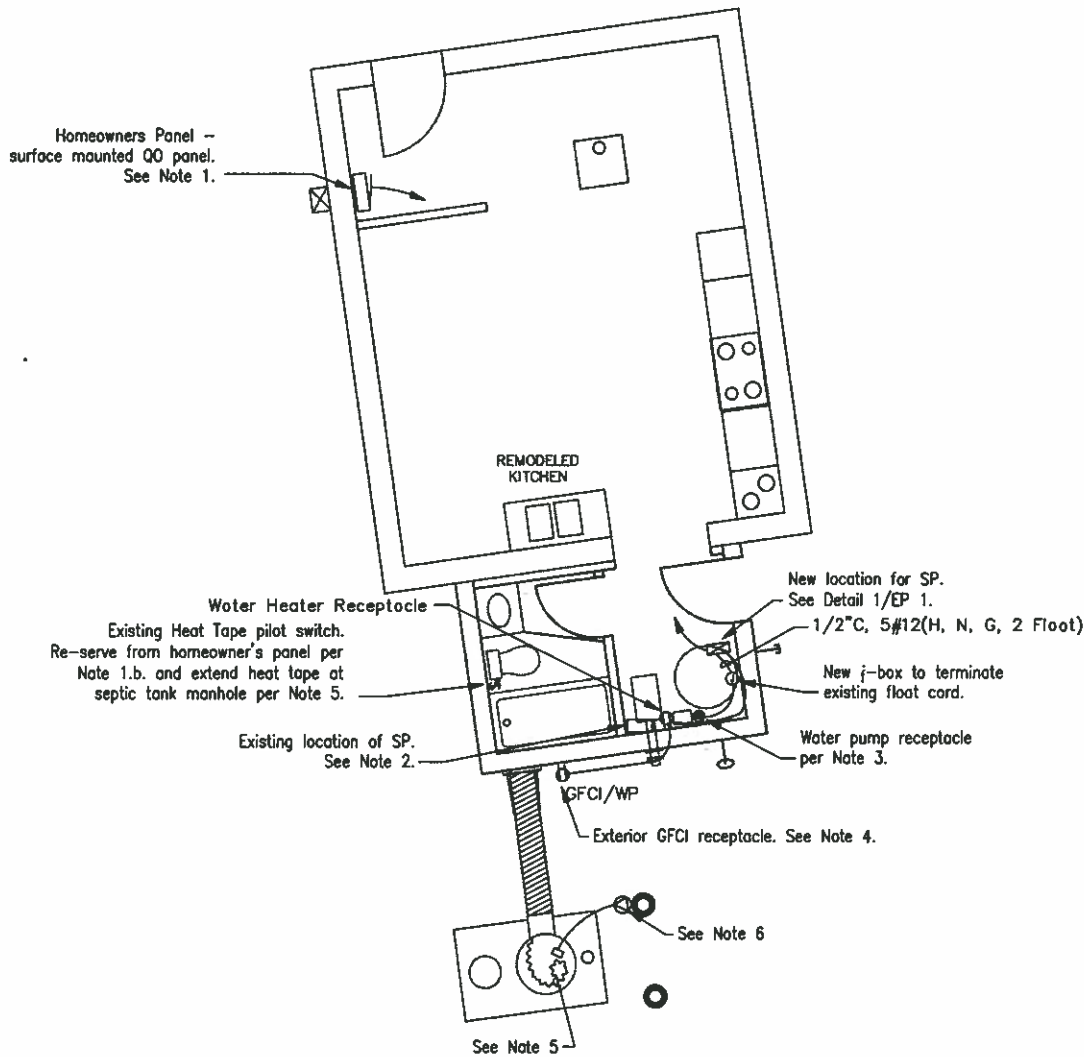

1 BUILDING 27 - HEATHER JOSEPH
AS SHOWN

RESIDENCE #28 NOTES

- 1. Provide dedicated circuits in homeowner's panel for SP and sewer line heat tape.
 - 1.a. Provide a 20/1 circuit breaker for SP.
 - 1.b. Update new circuits on the panel schedule with the following description: "Water/Sewer Panel".
- 2. Disconnect, remove Status Panel (SP) and re-install as shown.
 - 2.a. Serve SP on a dedicated circuit from Homeowner's Panel (Note 1.a.).
 - 2.b. Intercept, splice (in new J-box) and extend probe conductors to new location for SP.
 - 2.c. SP to supply circuits for outside GFCI receptacle (Note 4), water heater receptacle and water pump simplex receptacle (NOTE 3). Water pump receptacle is controlled by SP.
 - 2.d. Patch any holes that remain in SP enclosure after conduit installation is completed.
- 3. Provide a simplex receptacle for the water pump. Locate near water pump. Provide label on cover plate: "WATER PUMP ONLY". Serve with 3#12(N, G, Switch leg) on controlled circuit from SP. Install a 3P plug (HUBBELL HBL5965VBK or equal) on the water pump pigtail.
- 4. Exterior GFCI receptacle in weatherproof box with lockable cover. Locate near sewer line. Serve from SP circuit.
- 5. Remove end kit from heat tape at septic manhole. Splice on additional 10 feet of heat tape and install new end kit. Wrap the new section of heat tape around the probe holder junction box, flange and riser. See Detail 1/EP1.
- 6. Provide tank heater power supply extension. See Detail 2/EP1.
- 7. Provide Placard at Heat Tape pilot switch: "SEWER LINE HEAT TAPE". In Bathroom, provide PVC sleeve for heat tape between the floor and power point j-box.

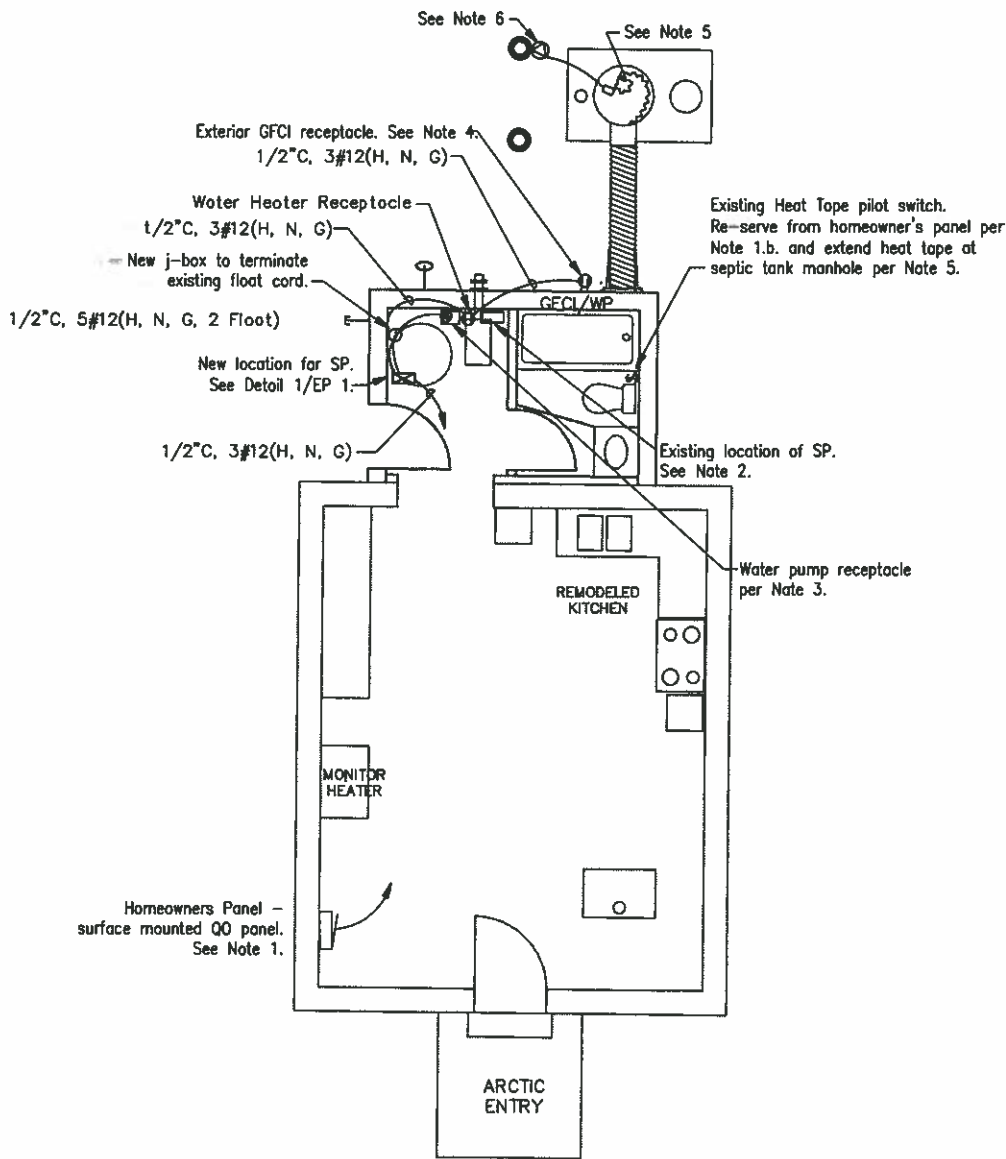


2 BUILDING 28 - SAM JOSEPH
AS SHOWN

0 1 2
SCALE IN FEET



RECORD DRAWING CERTIFICATE
THESE DRAWINGS REFLECT
RECORDED INFORMATION OBTAINED
DURING CONSTRUCTION
INFORMATION PROVIDED HEREIN
IS ACCURATE TO THE BEST OF
MY KNOWLEDGE
DATE 11/11/08
NAME [Signature]

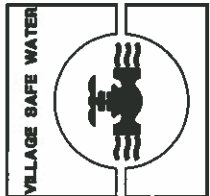

VILLAGE OF BEAVER
SANITATION IMPROVEMENTS
BATHROOM UPGRADES
ELECTRICAL
HEATHER JOSEPH - BUILDING 27
SAM JOSEPH - BUILDING 28


REVISION	BY	DATE
AS-BUILTS	WJM	11/08

Project No. 9966	Date SEP 2008	Designed WJM	Drawn WJM	Approved WJM
------------------	---------------	--------------	-----------	--------------

Sheet No. EP 10
SHEET 10 OF 15


This home was not inspected. Review completion checklist (EP 1) and correct as needed..

Improvements Installed as generally shown in Detail 2 & 3 of EP1

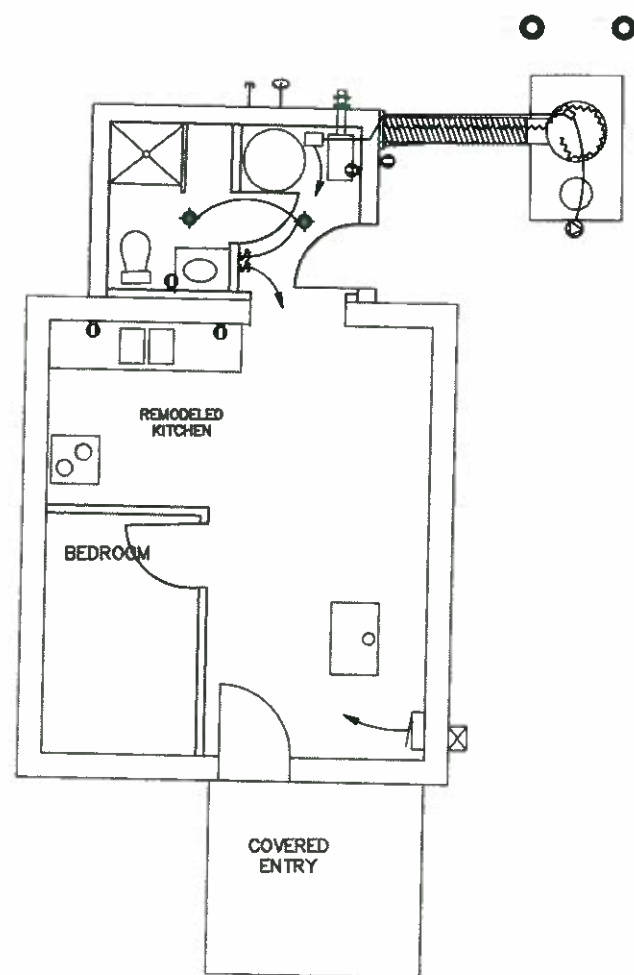


1 BUILDING 32 - JENNIE PITKA
AS SHOWN

0 1 2
SCALE IN FEET

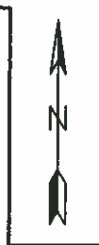


This home was not inspected. Review completion checklist (EP 1) and correct as needed..

Homeowner refused access and stated she did not want the improvements.

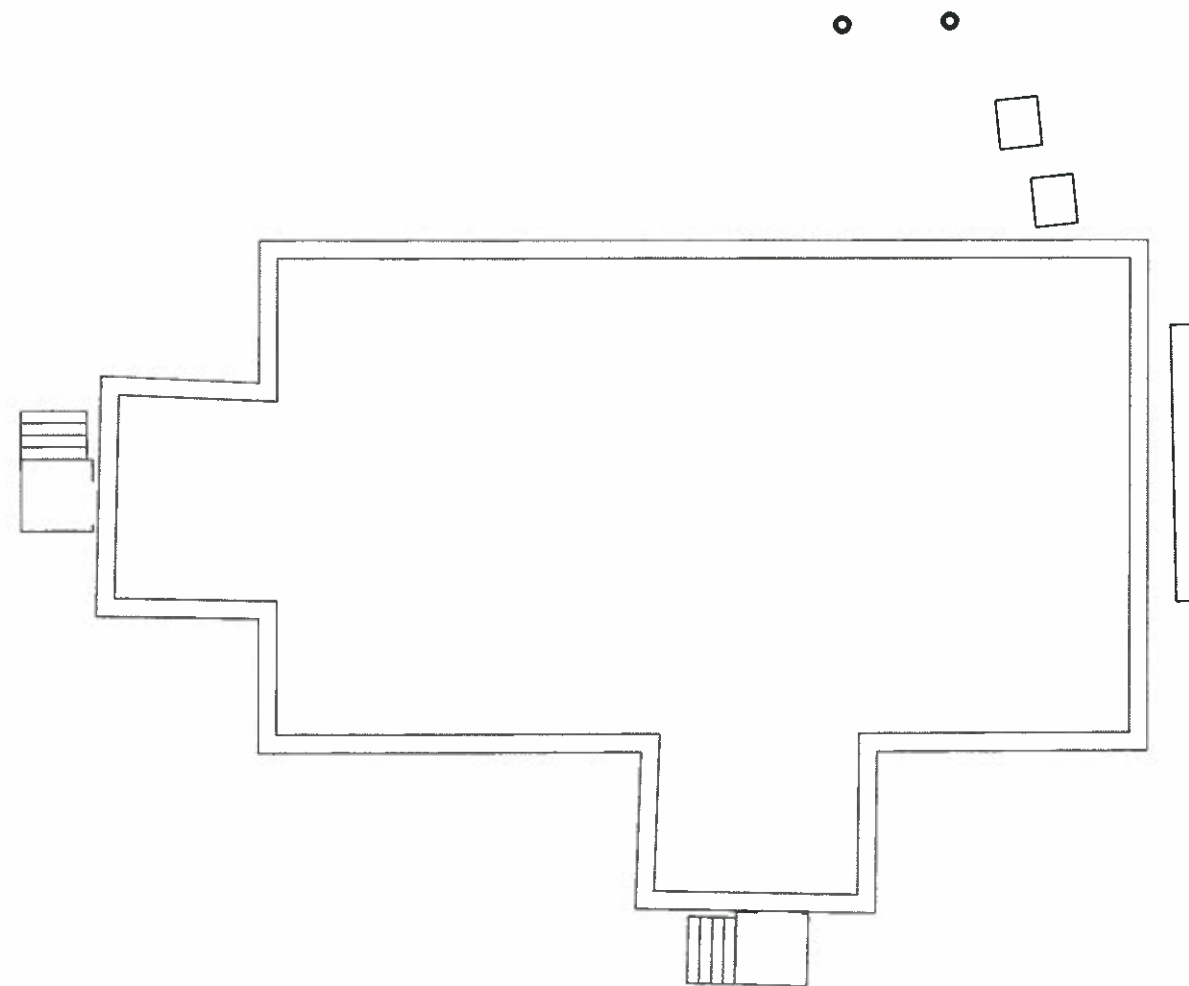

2 BUILDING 37 - CHARLEEN FISHER
AS SHOWN

RECORD DRAWING CERTIFICATE
THESE DRAWINGS REFLECT
RECORDED INFORMATION OBTAINED
DURING CONSTRUCTION.
INFORMATION PROVIDED HEREIN
IS ACCURATE TO THE BEST OF
MY KNOWLEDGE.
NAME: *William M. Macomber* DATE: 11/11/08

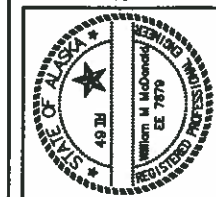

VILLAGE OF BEAVER
SANITATION IMPROVEMENTS
BATHROOM UPGRADES
ELECTRICAL
JENNIE PITKA - BUILDING 32
CHARLEEN FISHER - BUILDING 37


REVISION	BY	DATE
AS-BUILTS	WM	11/08

Project No.	9966
Date	SEP 2008
Designed	WM
Drawn	WM
Approved	WM

Sheet No. EP 11
SHEET 11 OF 15


RESIDENCE #51 NOTES

- Provide dedicated circuits in homeowner's panel for SP and sewer line heat tape.
 - Provide a 20/1 circuit breaker for SP.
 - Update new circuits on the panel schedule with the following description: "Water/Sewer Panel".
- Disconnect, remove Status Panel (SP) and re-install as shown.
 - Serve SP on a dedicated circuit from Homeowner's Panel (Note 1.a.).
 - Intercept, splice (in new J-box) and extend probe conductors to new location for SP.
 - SP to supply circuits for outside GFCI receptacle (Note 4), water heater receptacle and water pump simplex receptacle (NOTE 3). Water pump receptacle is controlled by SP.
 - Patch any holes that remain in SP enclosure after conduit installation is completed.
- Provide a simplex receptacle for the water pump. Locate near water pump. Provide label on cover plate: "WATER PUMP ONLY". Serve with 3#12(N, G, Switch leg) on controlled circuit from SP. Install a 3P plug (HUBBELL HBL5965VBK or equal) on the water pump pigtail.
- Exterior GFCI receptacle in weatherproof box with lockable cover. Locate near sewer line. Serve from SP circuit.
- Remove end kit from heat tape at septic manhole. Splice an additional 10 feet of heat tape and install new end kit. Wrap the new section of heat tape around the probe holder junction box, flange and riser. See Detail 1/EP1.
- Provide tank heater power supply extension. See Detail 2/EP1.
- Provide Placard at Heat Tape pilot switch: "SEWER LINE HEAT TAPE". In Bathroom, provide PVC sleeve for heat tape between the floor and power point j-box.

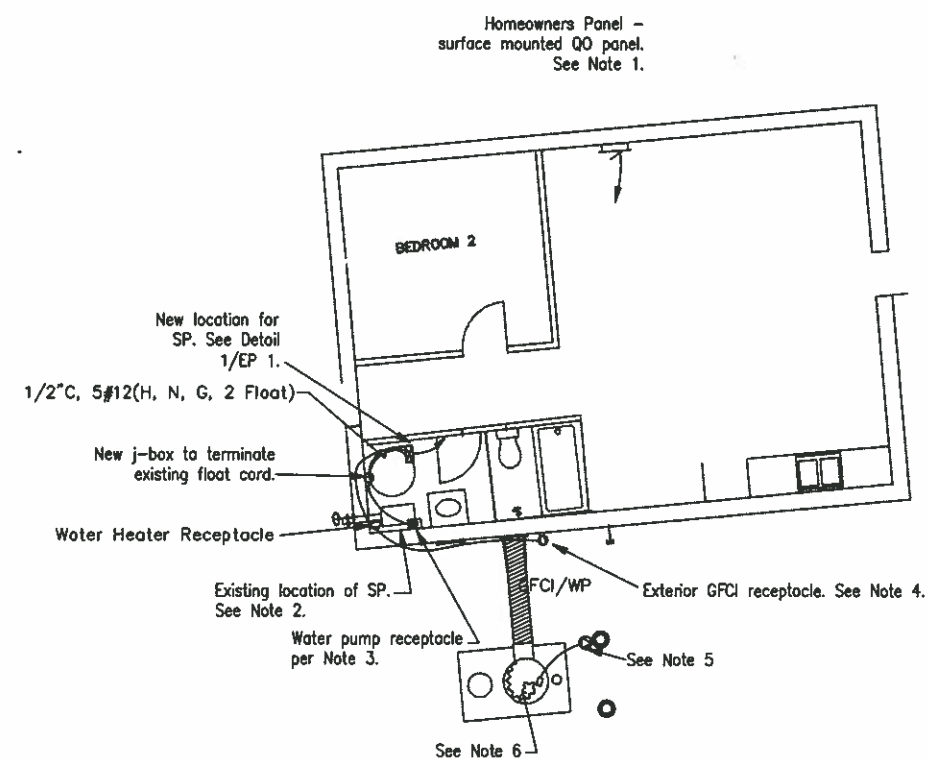


1
—
BUILDING 51 - YATLIN
AS SHOWN

0 1 2
SCALE IN FEET

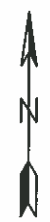


RESIDENCE #58 NOTES

- Provide dedicated circuits in homeowner's panel for SP and sewer line heat tape.
 - Provide a 20/1 circuit breaker for SP.
 - Provide a 20/3 GFCI circuit breaker for the bathroom circuit. Use this circuit for the sewer line heat tape.
 - Update new circuits on the panel schedule with the following description: "Water/Sewer Panel".
- Disconnect, remove Status Panel (SP) and re-install as shown.
 - Serve SP on a dedicated circuit from Homeowner's Panel (Note 1.a.).
 - Run probe conductors from the septic tank manhole to new location for SP.
 - SP to supply circuits for outside GFCI receptacle (Note 4), water heater receptacle and water pump simplex receptacle (NOTE 3). Water pump receptacle is controlled by SP.
 - Patch any holes that remain in SP enclosure after conduit installation is completed.
- Provide a simplex receptacle for the water pump. Locate near water pump. Provide label on cover plate: "WATER PUMP ONLY". Serve with 3#12(N, G, Switch leg) on controlled circuit from SP. Install a 3P plug (HUBBELL HBL5965VBK or equal) on the water pump pigtail.
- Exterior GFCI receptacle in weatherproof box with lockable cover. Locate near sewer line. Serve from SP circuit.
- Remove end kit from heat tape at septic manhole. Splice on additional 10 feet of heat tape and install new end kit. Wrap the new section of heat tape around the probe holder junction box, flange and riser. See Detail 1/EP1.
- Serve sewer line heat tape from bathroom GFCI receptacle. Install protective sleeve on any portion of the exposed heat tape. Provide label "SEWER LINE HEAT TAPE" on the existing pilot switch.
- Provide tank heater power supply extension. See Detail 2/EP1.

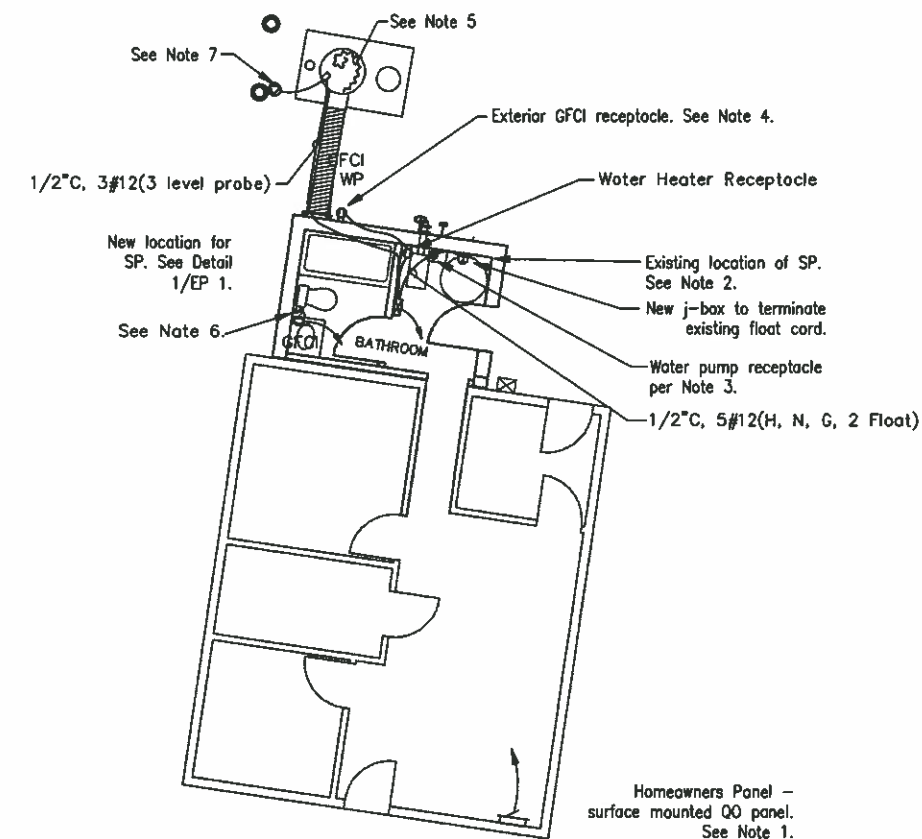

2
—
BUILDING 58 - THOMAS ADAMS
AS SHOWN

RECORD DRAWING CERTIFICATE	THESE DRAWINGS REFLECT RECORDED INFORMATION OBTAINED DURING CONSTRUCTION. INFORMATION PROVIDED HEREIN IS ACCURATE TO THE BEST OF MY KNOWLEDGE.	DATE 11/11/08
----------------------------	--	------------------

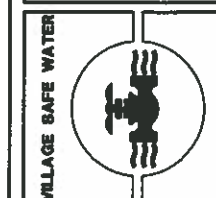

VILLAGE OF BEAVER
SANITATION IMPROVEMENTS
BATHROOM UPGRADES
ELECTRICAL
YATLIN - BUILDING 51
THOMAS ADAMS - BUILDING 58

REVISION	BY	DATE
AS-BUILTS	MM	11/08


Project No.	9956
Date	SEP 2008
Designed	MM
Drawn	MM
Approved	MM

Sheet No. EP 12
SHEET 12 OF 15

RESIDENCE #66 NOTES

- 1. Provide Bathroom installation per Detail 2 Sheet E2 of the original design in accordance with the Specifications on P1 and with the modifications listed below.
- 2. Locate the Status Panel and Panel A as shown on this sheet.
- 3. HEAT TAPE Item 4 Detail 2, E2. Do not provide dual heat tape runs shown but terminate the single run of heat tape at the septic tank manhole. Include a 10 foot length of heat tape in the septic manhole and wrap the probe holder junction box, flange and riser.
- 4. Provide Septic Tank Heat power supply point as shown on Detail 2, EP 1.

As of November 2008, The only improvement installed was the sewage holding tank.

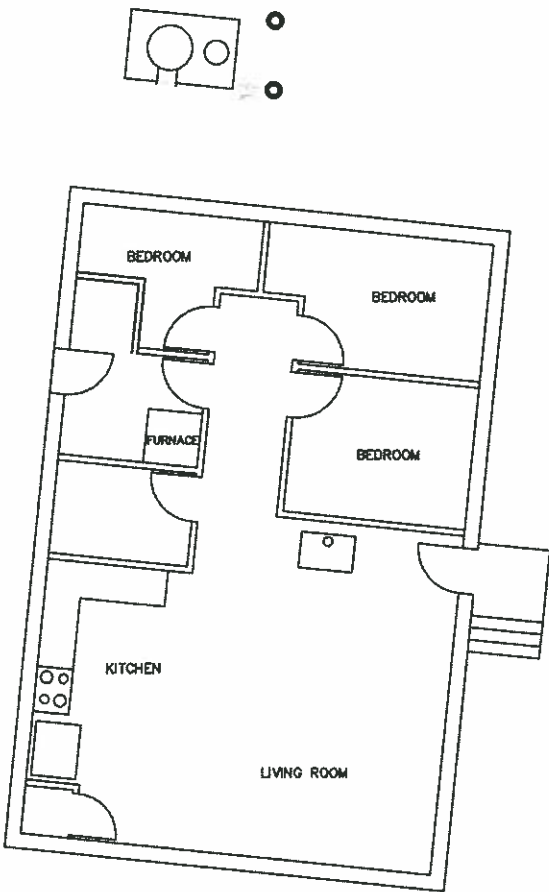


1 BUILDING 66 - MICHAEL WILLIAMS
AS SHOWN



RESIDENCE #67 NOTES

This installation was performed by the owner. The current water tank does not have any floats and the owner's pressure pump is 1/2Hp - it cannot be run on SP's water pump receptacle. At this time the owner is requesting a new (vertical) water tank. If the septic and water override is desired by the owner using his own pump, he must provide a motorstarter, controlled by SP's water pump receptacle circuit.

In any event the Status Panel must be relocated, probes connected and external receptacle installed. SP should be run on a dedicated circuit.

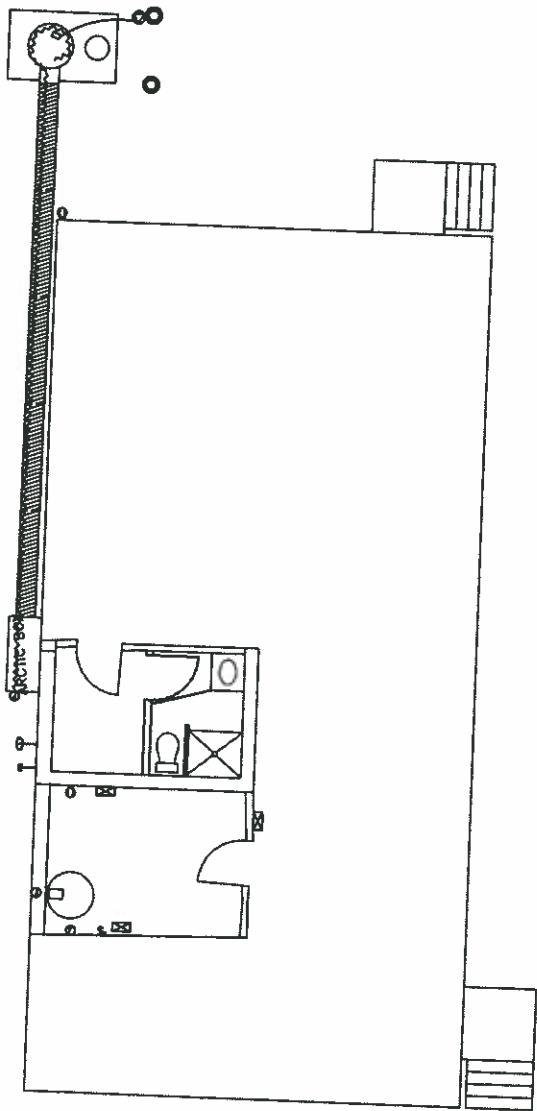


2 BUILDING 67 - BIRDIE BILLY
AS SHOWN

RECORD DRAWING CERTIFICATE

THESE DRAWINGS REFLECT RECORDED INFORMATION OBTAINED DURING CONSTRUCTION. INFORMATION PROVIDED HEREIN IS ACCURATE TO THE BEST OF MY KNOWLEDGE.

NAME: *Billy Williams* DATE: 11/11/08

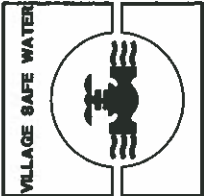

CRW
ENGINEERING GROUP, LLC

3000 ARCTIC BLVD. SUITE 203
ANCHORAGE, ALASKA 99503
PHONE: (907) 942-3333
FAX: (907) 941-2273

VILLAGE OF BEAVER
SANITATION IMPROVEMENTS

**BATHROOM UPGRADES
ELECTRICAL**

MICHAEL WILLIAMS - BUILDING 66
BIRDIE BILLY - BUILDING 67


REVISION	BY	DATE
AS-BUILTS	MM	11/08

Project No. 9966	Date SEP 2008	Designed WMM	Drawn WMM	Approved WMM
------------------	---------------	--------------	-----------	--------------

NOTE: Homeowner has expressed a reluctance to allow any more work being done. She has had the housing electrician move some things for her and likes everything right where it is.


RESIDENCE #69 NOTES

1. Verify dedicated circuit in homeowner's panel for SP.
t.a. Provide a 20/1 circuit breaker for SP.
t.b. Update new circuit on the panel schedule with the following description: "Water/Sewer Panel".
2. Disconnect, remove Status Panel (SP) and re-install as shown.
2.a. Serve SP on a dedicated circuit from Homeowner's Panel (Note t.a.).
2.b. Intercept, splice (in new J-box) and extend probe conductors to new location for SP.
2.c. SP to supply circuits for outside GFCI receptacle (Note 4), water pump simplex receptacle (NOTE 3). Water pump receptacle is controlled by SP.
2.d. Patch any holes that remain in SP enclosure after conduit installation is completed.
3. Provide a simplex receptacle for the water pump. Locate near water pump. Provide label on cover plate: "WATER PUMP ONLY". Serve with 3#12(N, G, Switch leg) on controlled circuit from SP. Install a 3P plug (HUBBELL HBL5965VBK or equal) on the water pump pigtail.
4. Exterior GFCI receptacle in weatherproof box with lockable cover. Locate near sewer line. Serve from SP circuit.
5. Remove end kit from heat tape at septic manhole. Splice on additional 10 feet of heat tape and install new end kit. Wrap the new section of heat tape around the probe holder junction box, flange and riser. See Detail 1/EP1.
6. Provide tank heater power supply extension. See Detail 2/EP1.
7. Provide Placard at Heat Tape pilot switch: "SEWER LINE HEAT TAPE". In Bathroom, provide PVC sleeve for heat tape between the floor and power point j-box.

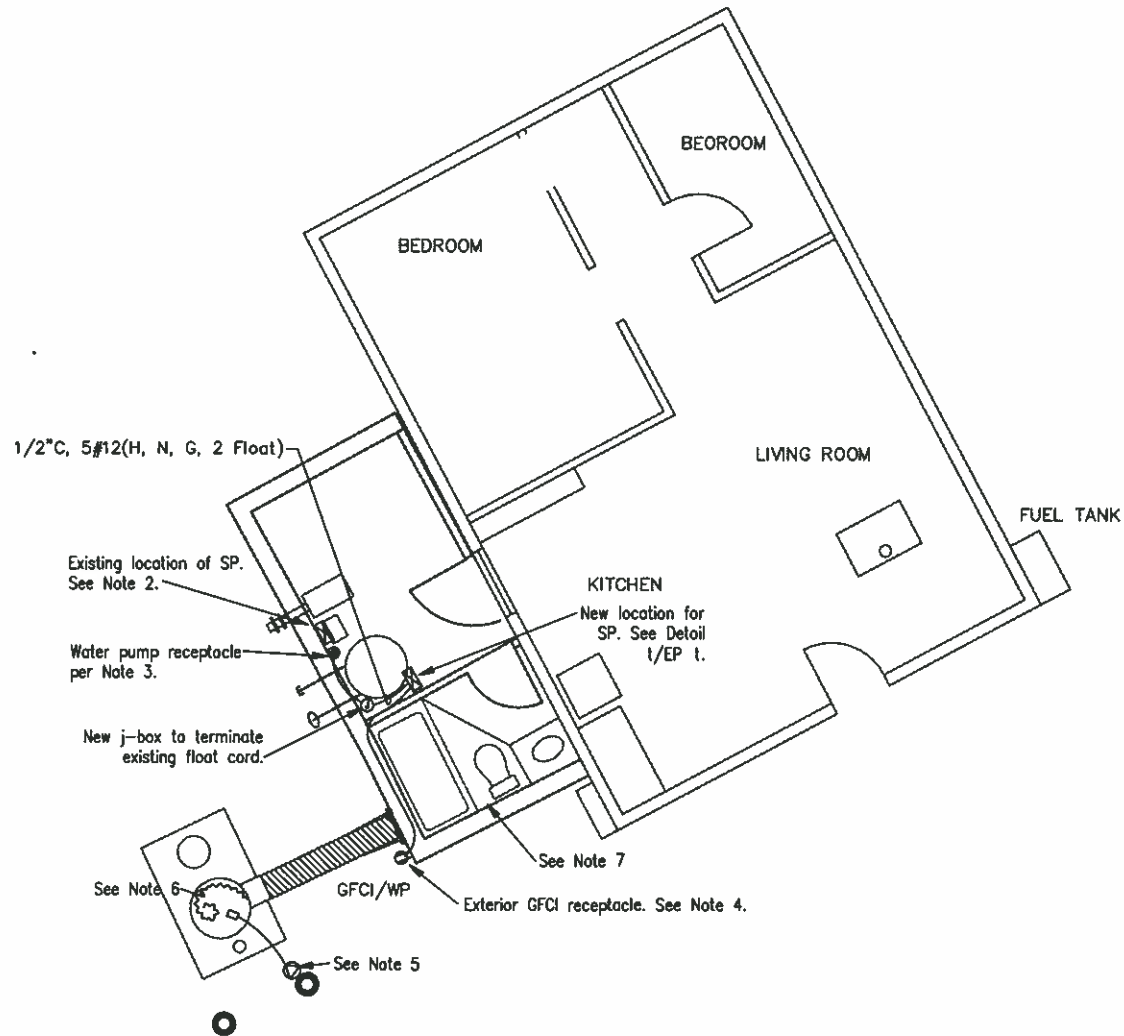


1 BUILDING 69 - DORTHEA ADAMS
AS SHOWN

0 1 2
SCALE IN FEET

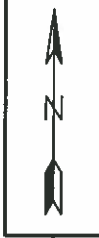


RESIDENCE #70 NOTES

1. Provide dedicated circuits in homeowner's panel for SP and sewer line heat tape.
1.a. Provide a 20/1 circuit breaker for SP.
1.b. Provide a GFCI 20/1 or 15/1 circuit breaker for the sewer line heat tape.
1.c. Provide 2 20/1 circuits for the relocated kitchen (use existing and add as needed).
1.d. Identify the circuit used for the water heater (if installed) and
1.e. Update new circuits on the panel schedule with the following descriptions: "Water/Sewer Panel", "Sewer Line Heat Tape".
2. Disconnect, remove Status Panel (SP) and re-install in location shown.
2.a. Serve SP on a dedicated circuit from Homeowner's Panel (Note t.a.).
2.b. Intercept, splice (in new J-box) and extend probe conductors to new location for SP.
2.c. SP to supply circuits for outside GFCI receptacle (Note 4) and water pump simplex receptacle (NOTE 3). Water pump receptacle is controlled by SP.
3. Provide a simplex receptacle for the water pump. Locate near water pump. Provide label on cover plate: "WATER PUMP ONLY". Serve with 3#12(N, G, Switch leg) on controlled circuit from SP. Install a 3P plug (HUBBELL HBL5965VBK or equal) on the water pump pigtail.
4. Exterior GFCI receptacle in weatherproof box with lockable cover. Locate near sewer line. Serve from SP circuit.
5. Remove end kit from heat tape at septic manhole. Splice on additional 10 feet of heat tape and install new end kit. Wrap the new section of heat tape around the probe holder junction box, flange and riser.
6. Provide 2 GFCI receptacles. One on either side of the sink, 6" above the counter top.
7. Provide GFCI receptacle adjacent to sink in bathroom. Serve on existing bathroom circuit.
8. Move light switch to location by door.
9. Provide Placard at Heat Tape pilot switch: "SEWER LINE HEAT TAPE".

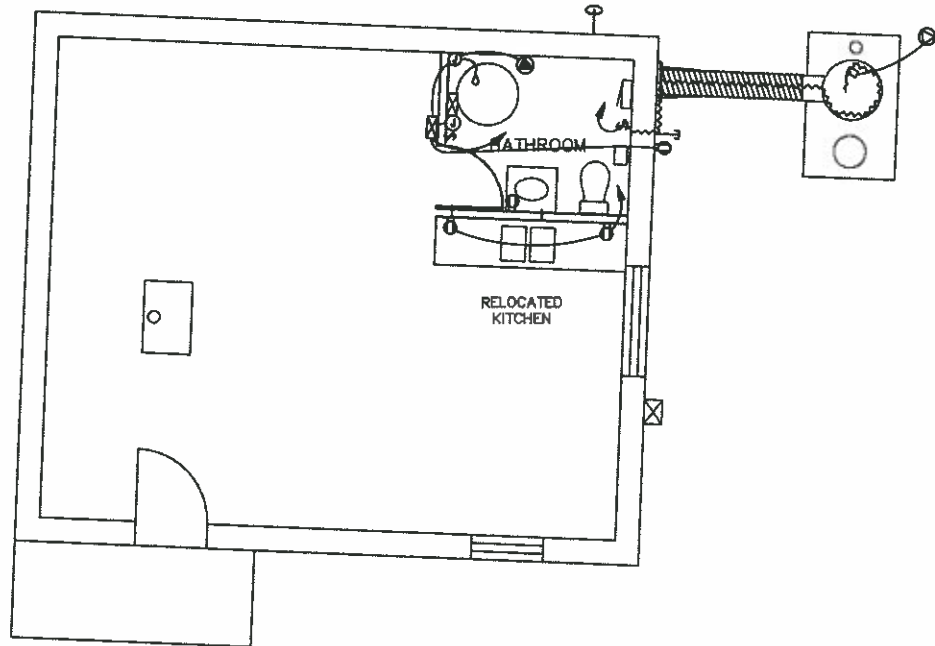

2 BUILDING 70 - ARTHUR HENRY
AS SHOWN

RECORD DRAWING CERTIFICATE
THESE DRAWINGS REFLECT
RECORDED INFORMATION OBTAINED
DURING CONSTRUCTION. HEREIN
INFORMATION PROVIDED HEREIN
IS ACCURATE TO THE BEST OF
MY KNOWLEDGE.
DATE 11/11/08
NAME [Signature]

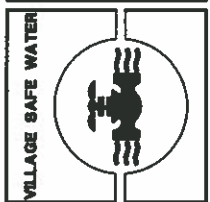

VILLAGE OF BEAVER
SANITATION IMPROVEMENTS
BATHROOM UPGRADES
ELECTRICAL
DORTHEA ADAMS - BUILDING 69
ARTHUR HENRY - BUILDING 70

REVISION	BY	DATE
AS-BUILTS	WM	11/08

Project No.	9966
Date	SEP 2008
Designed	WM
Drawn	WM
Approved	WM

RESIDENCE #71 NOTES

1. Provide Bathroom installation per Detail 2 Sheet E2 of the original design in accordance with the Specifications on P1 and with the modifications listed below.
2. Locate the Status Panel and Panel A as shown on this sheet.
3. HEAT TAPE item 4 Detail 2, E2. Do not provide dual heat tape runs shown but terminate the single run of heat tape at the septic tank manhole. Include a 10 foot length of heat tape in the septic manhole and wrap the probe holder junction box, flange and riser.
4. Provide Septic Tank Heat power supply point as shown on Detail 2, EP 1.

⚠ Homeowner refused access and stated she did not want the improvements.

0 1 2
SCALE IN FEET



1

BUILDING 71 - ANN FISHER
AS SHOWN

RECORD DRAWING CERTIFICATE
THESE DRAWINGS REFLECT
RECORDED INFORMATION OBTAINED
DURING CONSTRUCTION.
INFORMATION PROVIDED HEREIN
IS ACCURATE TO THE BEST OF
MY KNOWLEDGE.
NAME Ann Fisher DATE 11/11/08





VILLAGE OF BEAVER
SANITATION IMPROVEMENTS
**BATHROOM UPGRADES
ELECTRICAL**
ANN FISHER - BUILDING 71

REVISION	BY	DATE

Project No. 9966
Date SEP 2008
Designed WMM
Drawn WMM
Approved WMM

Sheet No. EP 15
SHEET 15 OF 15

JOE M, CCI 12/28/2007 11:02 PM LEVEL_CONTROLS.dwg

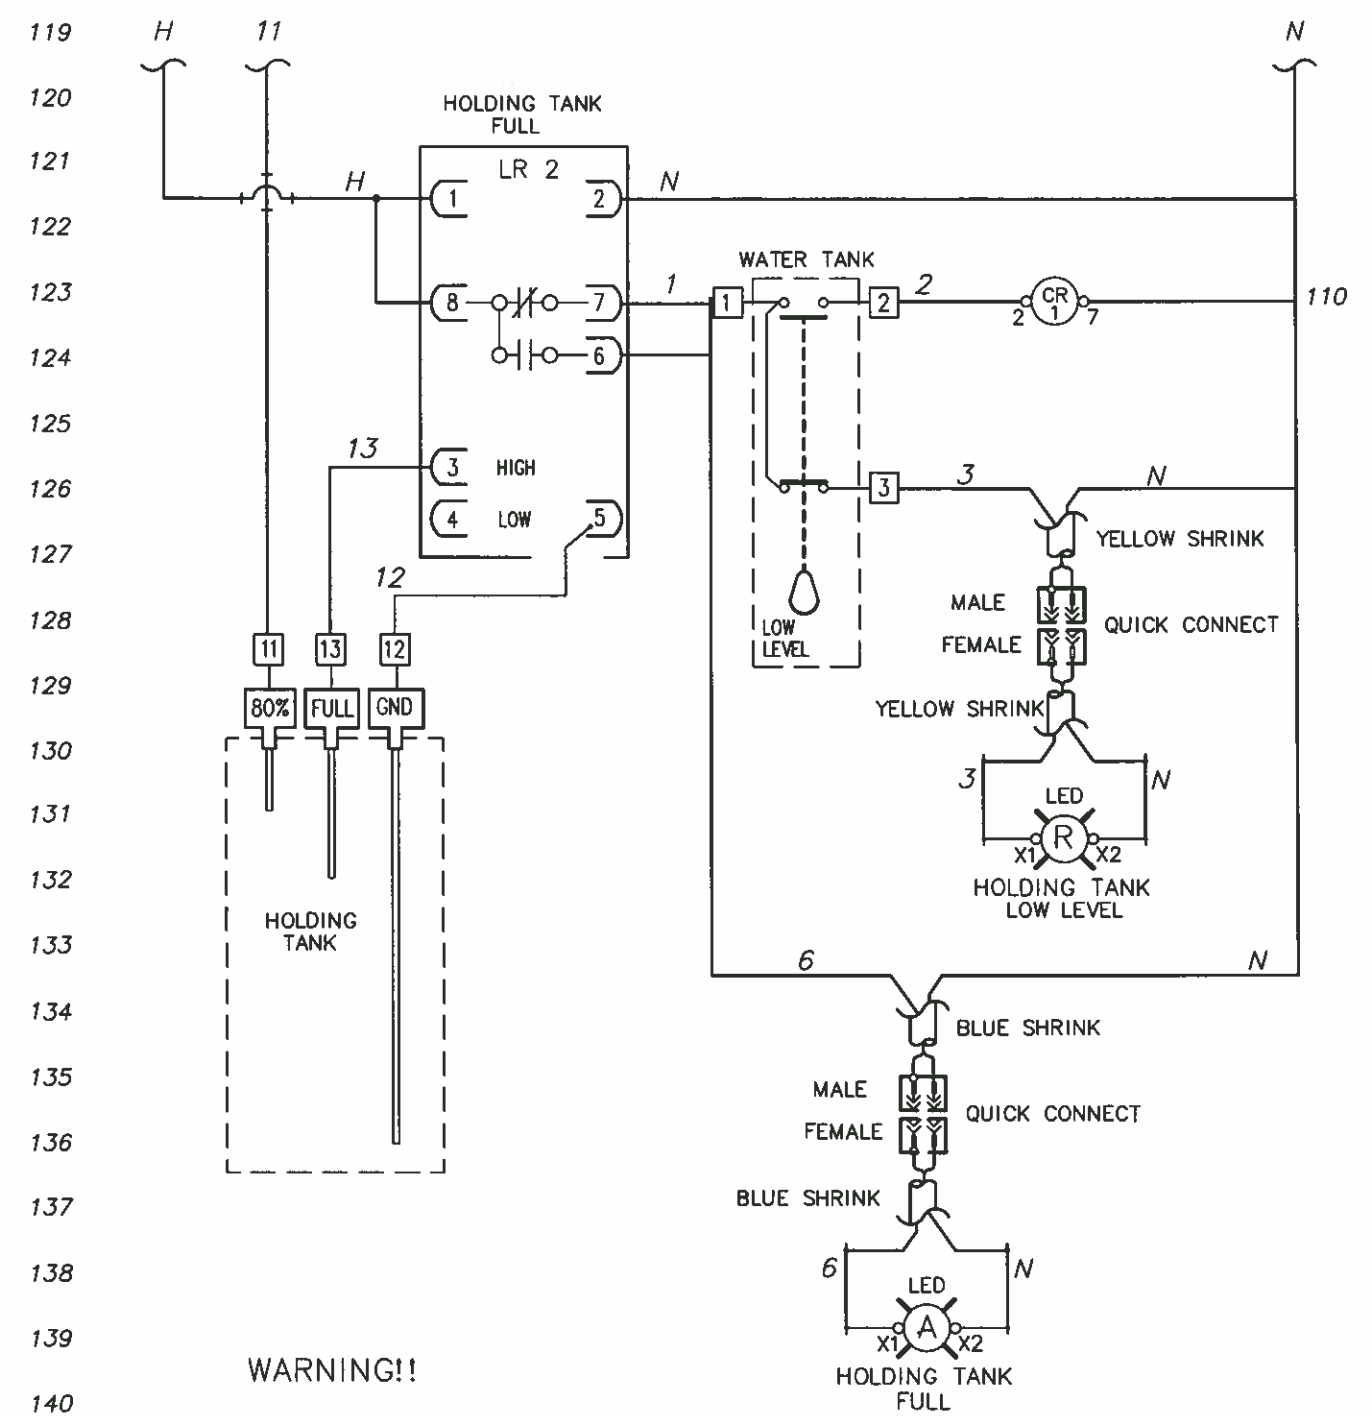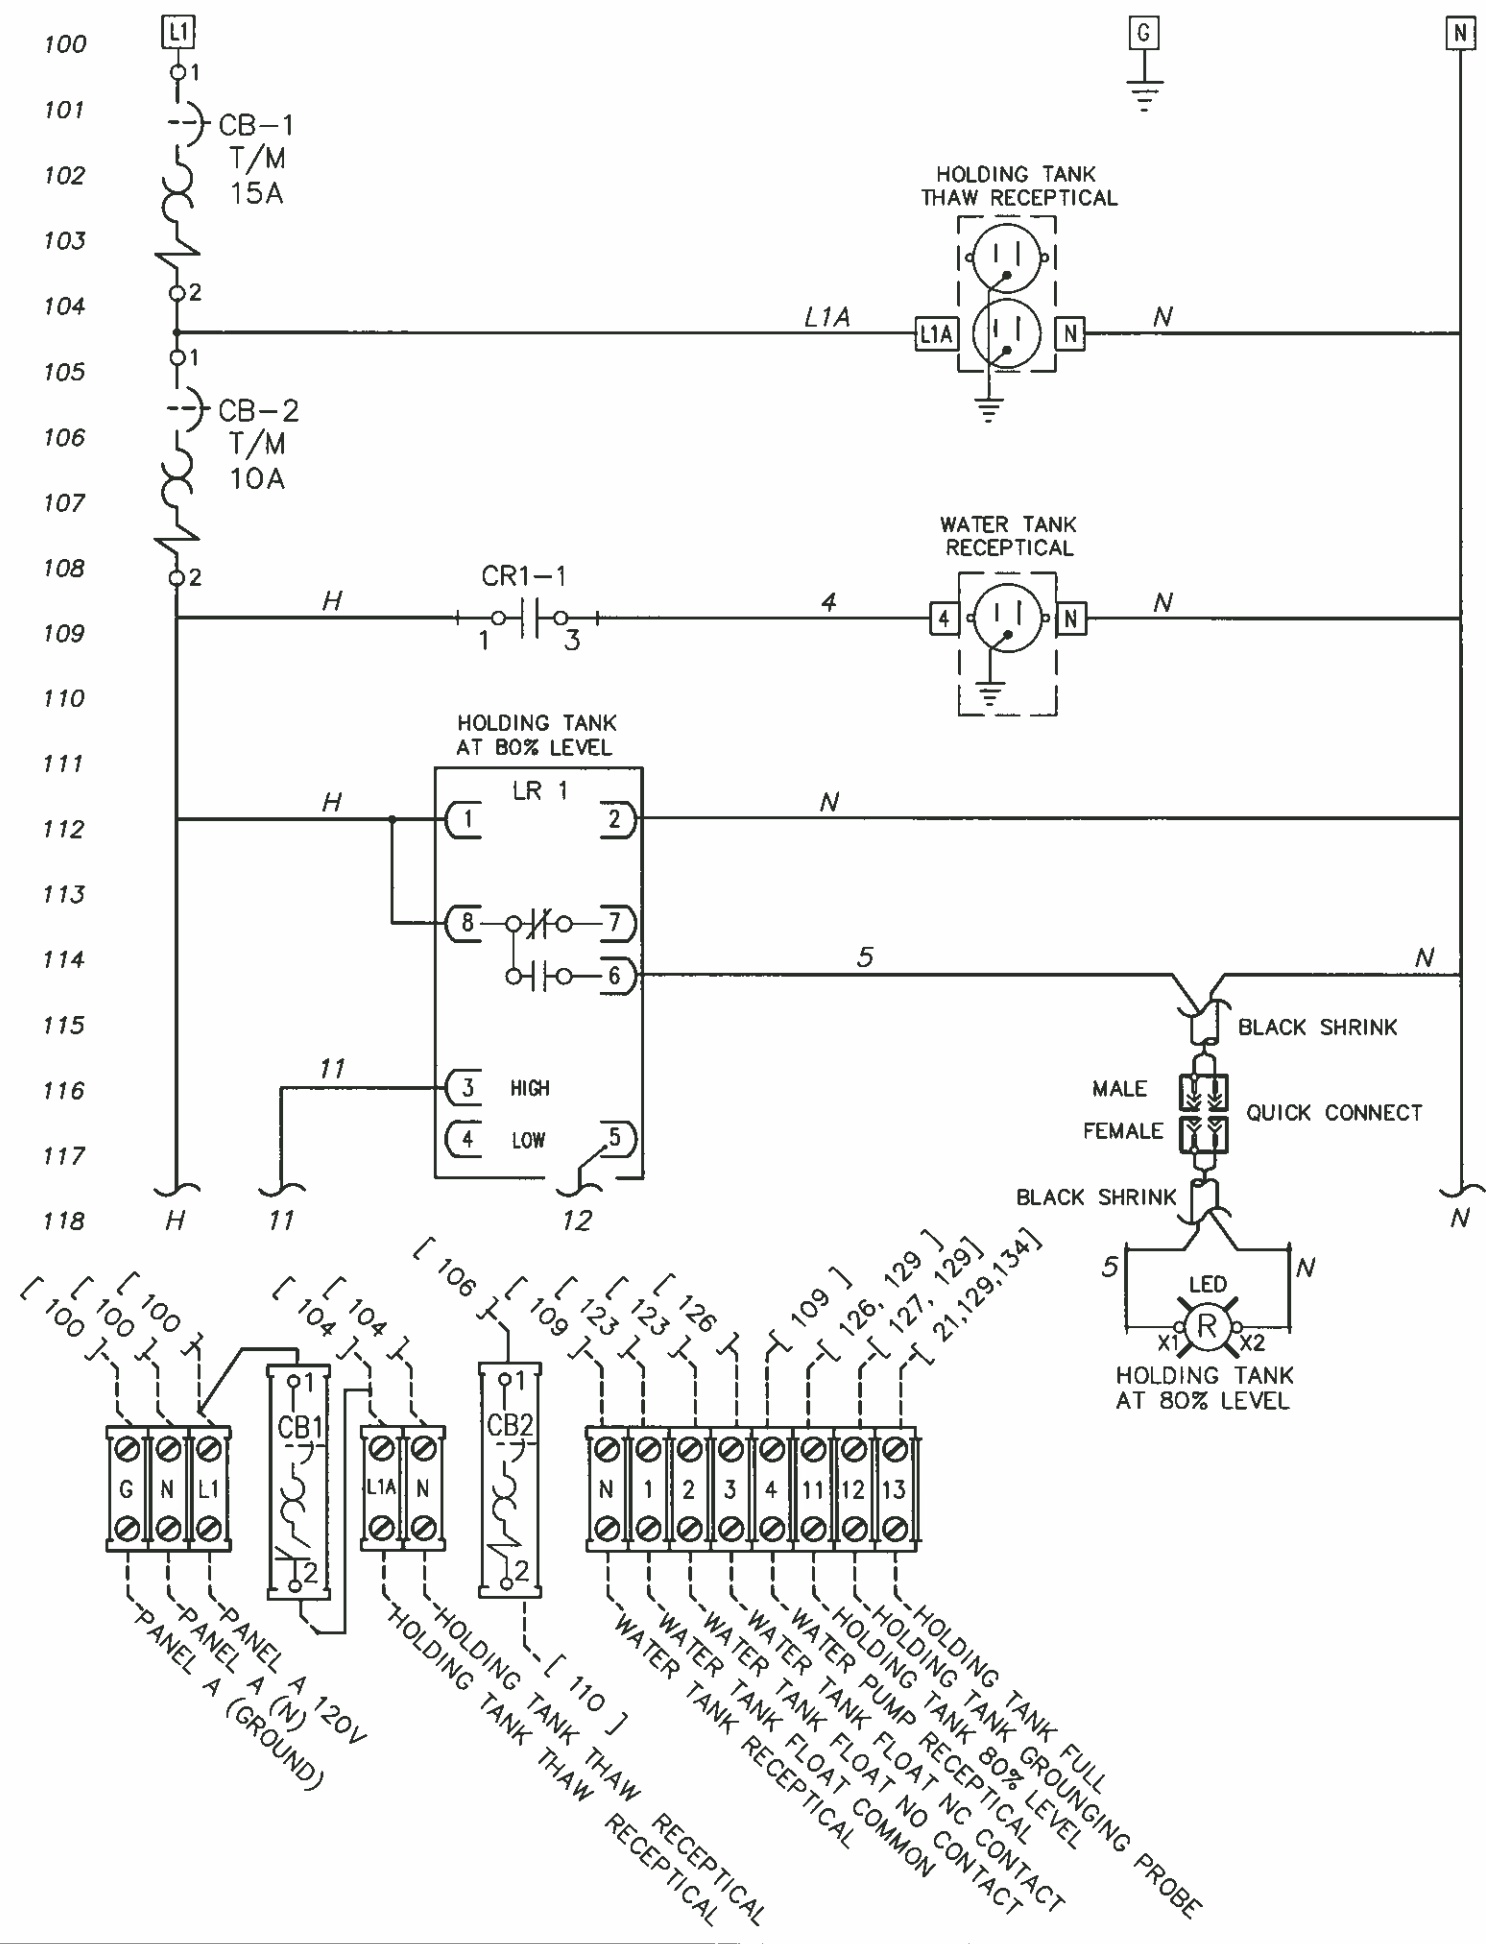

CONTROL CRAFT, INC. Industrial Control Panel Fabricator		VILLAGE BEAVER LEVEL CONTROLS	
P.O. BOX 241186 ANCHORAGE, AK 99524		907/561-7065 (TEL) 907/561-7592 (FAX)	
ETL LISTED C 53950		Sheet/Rev	SHEET 1 OF 1
		Drawn By	KD
		Checked By	J. MOSSAKOWSKI
		File No.	122B07_1 THRU 25