
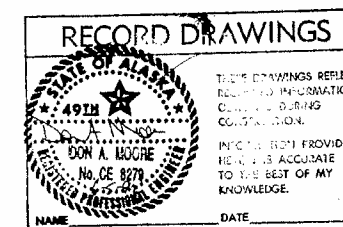


CONSTRUCTION PLANS

SANITATION FACILITIES

BEAVER, ALASKA

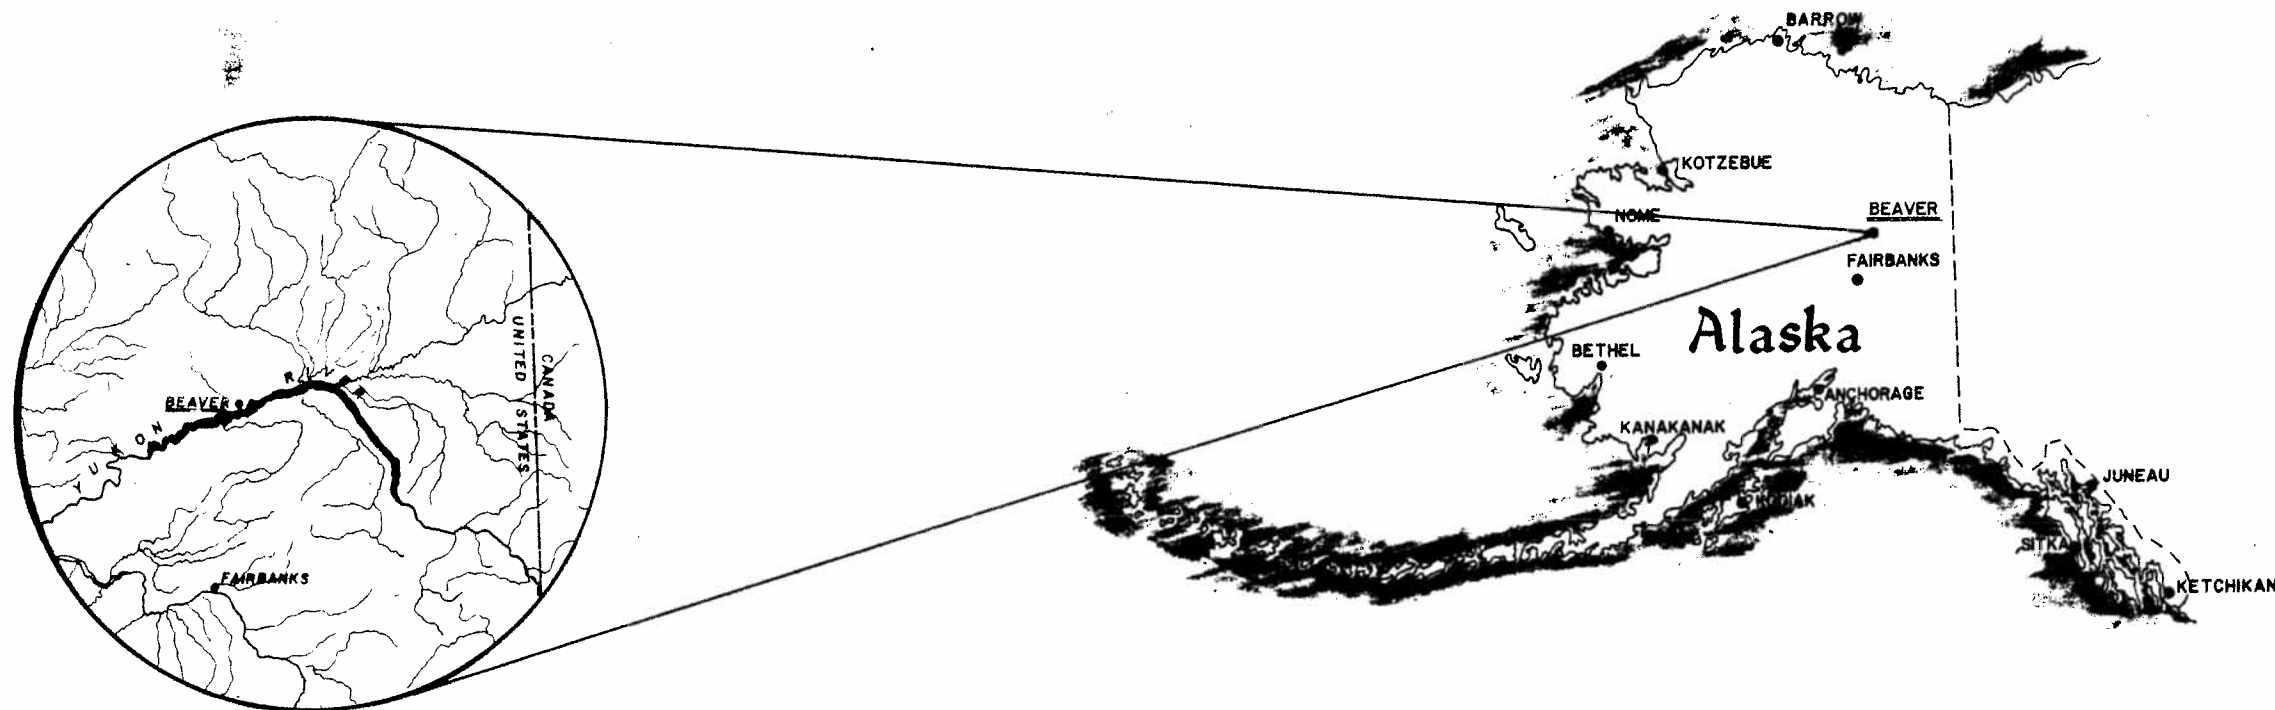

ALASKA AREA NATIVE HEALTH SERVICE
ENVIRONMENTAL HEALTH BRANCH
701 C STREET BOX 65
ANCHORAGE, ALASKA 99510

PUBLIC LAW 86-121 PROJECT
PROJECT NO. AN-89-996

U. S. DEPT. OF HEALTH & HUMAN SERVICES
PUBLIC HEALTH SERVICE
INDIAN HEALTH SERVICE




SHEET NO.	TABLE OF CONTENTS ITEM
1	COVER SHEET
L-1	LEGEND & NOTES
D-1	AERIAL PHOTO & SCOPE OF WORK
D-2	SCHEMATIC LAYOUT
	CIVIL
C-1	SITE PLAN
	ARCHITECTURAL
A-1	WTP / FLOOR PLAN AND ELEVATIONS
A-2	UTILITY BUILDING FLOOR PLAN
A-3	INTERIOR SCHEDULES
A-4	STAIR DETAILS
A-5	DOOR AND WINDOW DETAILS
A-6	FLOOR AND WALL SECTIONAL DETAILS
	MECHANICAL
M-1	DOMESTIC PLUMBING SCHEMATIC
M-2	HYDRONICS SCHEMATIC
M-3	MISC. HYDRONIC DETAILS
M-4	DMV PLUMBING SCHEMATIC & DETAILS
M-5	MISC. PLUMBING DETAILS
M-6	DRYER, BOILER, AND VENT DUCTS
M-7	HYDRONICS UTILIDOR
M-8	FUEL OIL SYSTEM STD. DETAILS
M-9	BOILER PIPING STD. DETAILS
M-10	BOILER STACK STD. DETAILS
M-11	WATERING POINT STD. DETAILS
M-12	GREEN SAND PRESSURE FILTER
M-13	FLUORINATION AND CHLORINATION
M-14	PUMP CURVES AND SOIL LOGS
M-15	WATER STORAGE TANK DETAILS
M-16	BOLTED STEEL TANK DETAILS
M-17	LIFT STATION
	ELECTRICAL
E-1	LIGHTING
E-2	MECHANICAL - 120/208V AC
E-3	WTP - FIRE ALARM
E-4	CIRCUIT BREAKER PANELS
E-5	DUPLEX LIFT STATION PANEL
E-6	DUPLEX PRESSURE PUMPS PANEL
E-7	12 CIRCUIT ALARM PANEL
E-8	DUPLEX WELL PUMP CONTROL PANEL
E-9	PANEL RACKS
E-10	DISTRIBUTION
SP-1	SPECIFICATION SHEET


LEGEND AND GENERAL NOTES

SITE PLAN


EXISTING

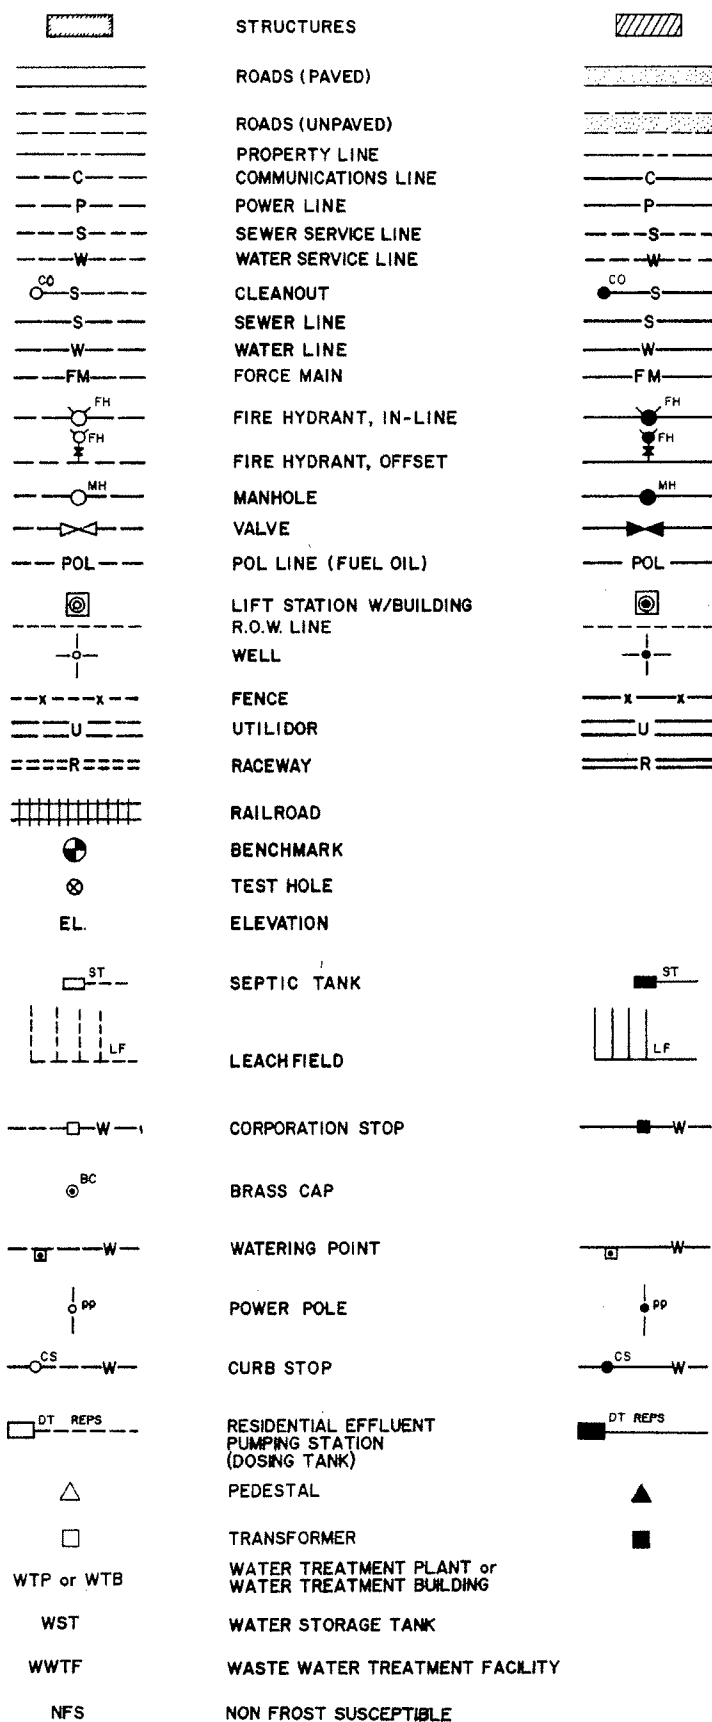


PROPOSED
THIS PROJECT

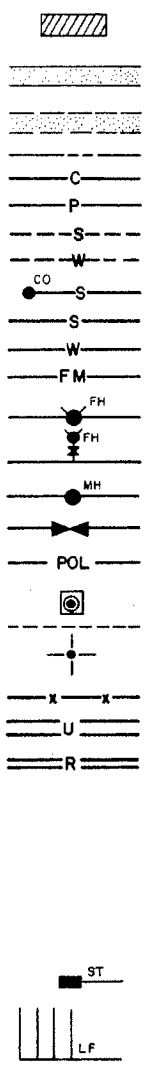


MECHANICAL

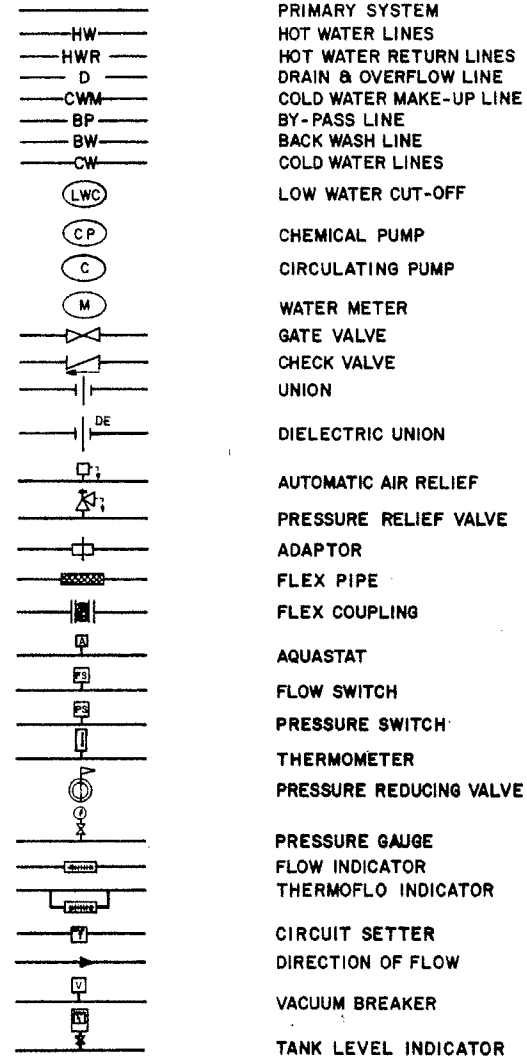

PIPE FITTING & VALVE SYMBOLS

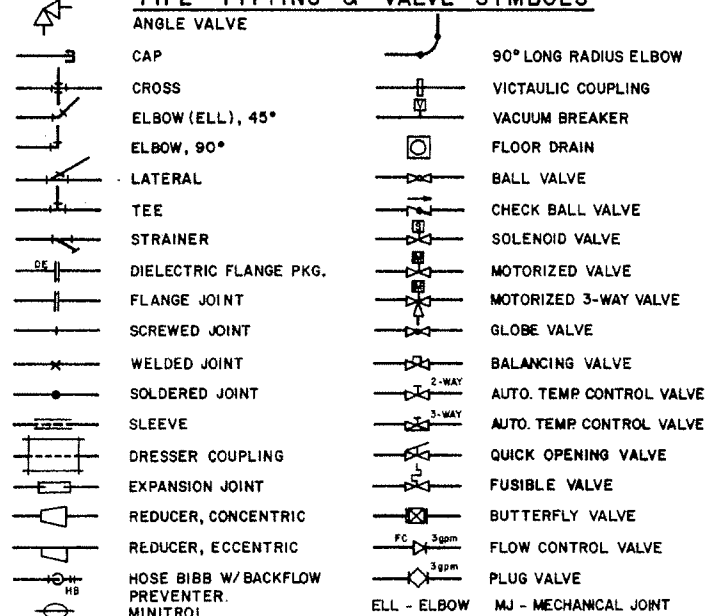

ELECTRICAL

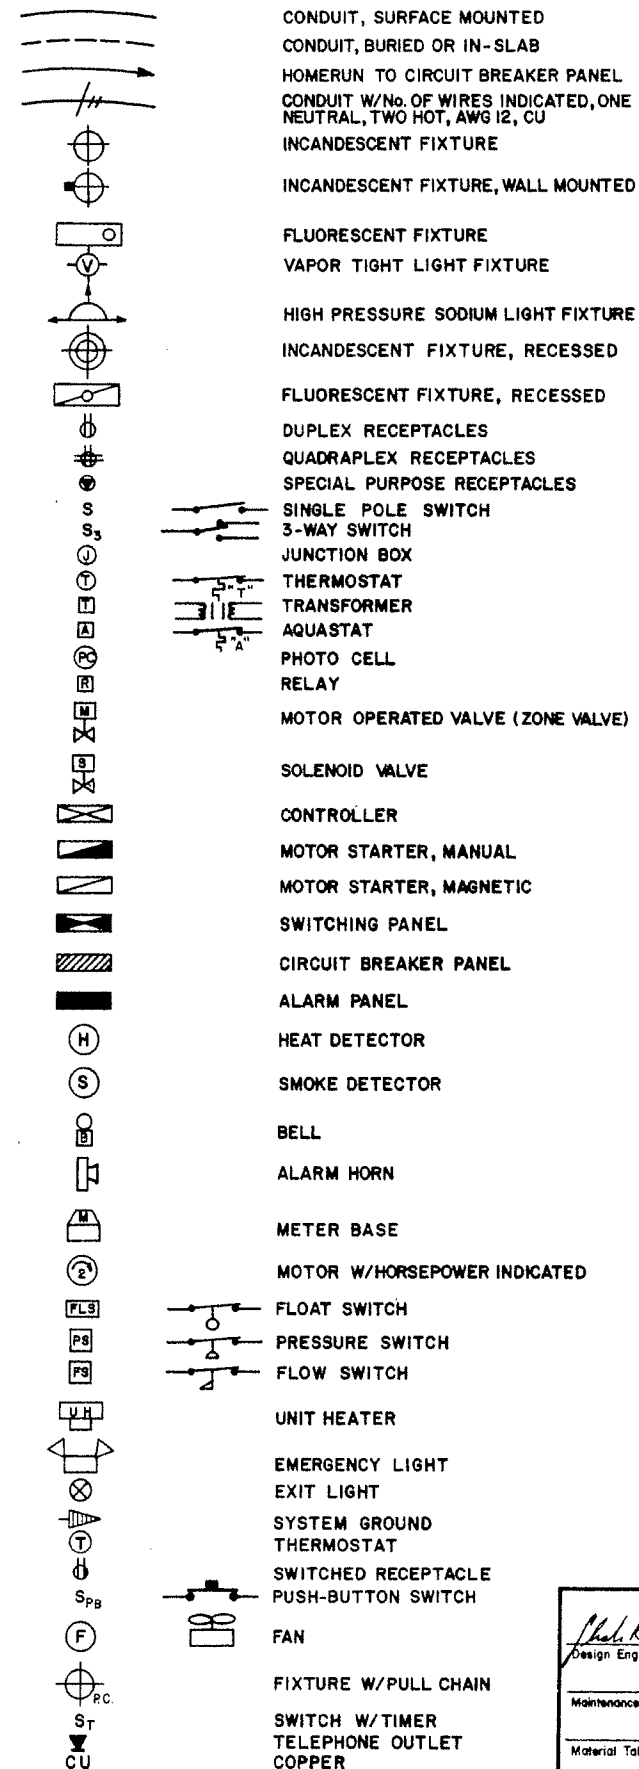

NOTES

CIVIL

1. MINIMUM VERTICAL SEPARATION BETWEEN WATER LINE & SEWER LINE AT THE CROSSING POINT SHALL BE 10'-0".
2. MINIMUM HORIZONTAL SEPARATION BETWEEN WATER LINE & SEWER LINE SHALL BE 10'-0".
3. MINIMUM BURY ON WATER LINE SHALL BE:
4. LOCATION OF ALL WELLS, SEPTIC TANKS, MANHOLES, CLEANOUTS, VALVES, ETC. SHALL BE REFERENCED TO THREE PERMANENT ABOVE GROUND STRUCTURES.
5. CLEANOUTS, LEACHFIELDS AND SEPTIC TANKS ARE NUMBERED ACCORDING TO CORRESPONDING MANHOLE, I.E., MH-1, ST-1A, LF-1A AND CO-1A.

MECHANICAL

1. ALL EXPOSED PIPING SHALL BE PAINTED USING THE FOLLOWING COLOR CODE:

GREEN - RAW WATER	YELLOW - WASTE HEAT RECOVERY
BLUE - POTABLE WATER	
BLACK - HEATING	
RED - FIRE	
BROWN - SEWAGE	
GRAY - COMPRESSED AIR	
ORANGE - FUEL	
2. TYPE OF PAINT TO BE USED SHALL BE GARLOCK OR APPROVED EQUAL.
3. DIRECTION OF FLOW SHALL BE INDICATED BY ARROWS AND A NAME PLATE SHALL BE ATTACHED DESCRIBING MATERIAL BEING CARRIED.
4. ALL PIPING SHALL BE COPPER UNLESS OTHERWISE INDICATED.
5. ALL SOLDER CONNECTIONS SHALL BE MADE W/TIN-ANTIMONY 95-5 SOLDER.
6. ALL HOT WATER LINES SHALL BE INSULATED.
7. ALL PIPE SUPPORTS AND HANGERS SHALL HAVE 1/2" INSULATION BETWEEN COPPER PIPE AND SUPPORTS OR HANGERS.
8. PRESSURE TESTING REQUIREMENTS WATER MAINS AND SERVICES, SEWER MAINS AND SERVICES IN ACCORDANCE WITH SFS GUIDE-LINE C-39 .
9. DRAIN WATER AND VENT PLUMBING, WATER SUPPLY PIPING AND HYDRONICS PIPING IN ACCORDANCE WITH SECTION 318 OF UPC .

ELECTRICAL

1. CLEAR AREA REQUIRED FOR ELECTRICAL PANELS :
36" FROM FACE OF PANEL
75" FROM FLOOR UP TO FIRST OBSTRUCTION
15" CLEAR EACH SIDE FROM CENTER LINE OF PANEL
2. GROUND SYSTEM NEUTRAL AND ALL METALLIC SURFACES PER 1990 NATIONAL ELECTRICAL CODE (N. E. C.).
3. ALL WIRING SHALL BE IN CONDUIT, UNLESS OTHERWISE SPECIFIED

12-9-91	RECORD DRAWING	J.E
DATE	REVISIONS	INITIALS

U. S. Department of Health, & Human Services
Public Health Service
Indian Health Service

BEAVER, ALASKA
LEGEND & NOTES
PUBLIC LAW 86-121 PROJECT
PROJECT NO. AN-89-986

SHEET NO.
L-1
OF
1
TOTAL SHEETS


OWN BY: **LOWDERMILK D.C.G.** CHECKED BY: _____
 DATE: **9/82** **11-12-90** DATE: _____

**SANITATION FACILITIES CONSTRUCTION BRANCH
 ENVIRONMENTAL HEALTH BRANCH
 ALASKA AREA NATIVE HEALTH SERVICE
 ANCHORAGE, ALASKA**

Charles R. McHenry
Design Engineer

Maintenance Review

Material Take-off

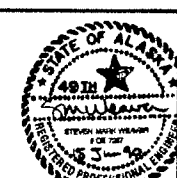

SCOPE OF WORK

WASHETERIA REHABILITATION:

1. STRIP BUILDING OF EXISTING FACILITIES AND PARTITION WALLS.
2. COMPLETE NEW FLOOR PLAN TO INCLUDE:
 - a. INSULATE FLOOR WITH EQUIVALENT R-36, POLYURETHANE SPRAY FOAM PERFORMED.
 - b. INSULATE EXTERIOR WALLS WITH 2-INCH INTERIOR PLACED POLYSTYRENE AND SEAL WITH 6 MIL VAPOR BARRIER.
 - c. CONSTRUCT INTERIOR PARTITION WALLS.
 - d. REMOVE AND PLUG DESIGNATED WINDOWS AND INSTALL NEW WINDOWS.
 - e. REPLACE OLD DOORS & FRAMES WITH NEW.
 - f. PROVIDE NEW INTERIOR FINISH AND TRIM.
 - g. REPLACE ELECTRICAL WIRING AND CONTROLS.
 - h. INSTALL NEW HOT WATER GENERATOR.
3. WASHERS - 4 EACH.
4. DRYERS - 3 EACH.
5. REMOVE OLD LIFT STATION. PROVIDE AND INSTALL NEW PACKAGE LIFT STATION.
6. INSTALL NEW SHOWERS, TOILETS, AND SINKS.
7. INSTALL NEW PLUMBING.
8. PROVIDE FOR WATER TREATMENT: CHLORINATION, FLUORIDATION, POTASSIUM PERMANGANATE INJECTION, AND GREENSAND FILTER. PRECHLORINATE AT THE WELL.
9. PROVIDE TWO BOILERS COMPLETE WITH WATER MAKEUP AND CIRCULATION PUMPS.
10. PLACE 3-INCH CONCRETE FLOOR WITH 6 MIL VAPOR BARRIER THROUGHOUT.
11. ADD FLOOR TILES IN PUBLIC AREAS AND OFFICE.
12. BUILDING EXTERIOR REPAIRS AND PAINT, AND REPLACE STAIRWAYS.
13. FUEL SYSTEM MODIFICATIONS.
14. CONSTRUCT NEW UTILIDOR BETWEEN THE WASHETERIA AND THE UTILITY BUILDING.
15. PROVIDE FOR INTERIM WASHER AND DRYER SERVICES DURING THE REHABILITATION OF THE WASHETERIA FACILITIES.
16. SUPERCHLORINATE AND FLUSH WATER TRANSMISSION LINES.
17. PROVIDE WELL HEAD MODIFICATIONS TO INCLUDE NEW INSULATED WELL BOX, AND WELL SEAL.

UTILITY BUILDING REHABILITATION:

1. INTERIOR REHAB OF WALLS, CEILING, AND FLOOR TO INCLUDE:
 - a. REPLACE OLD DOORS & FRAMES WITH NEW.
 - b. REPLACE STAIRWAY AND PLATFORM.
 - c. PLACE 3-INCH CONCRETE FLOOR WITH 6 MIL VAPOR BARRIER THROUGHOUT.
 - d. REPAIR BROKEN WINDOWS BY UTILIZING OLD WINDOWS FROM WASHETERIA.
2. UTILIDOR PLUMBING MODIFICATIONS.
3. BUILDING EXTERIOR REPAIRS AND FINISH.
4. HEATING AND MECHANICAL SYSTEMS.
5. INSTALL NEW 4,000 GALLON WATER STORAGE TANK.
6. INSTALL PRESSURE TANK SYSTEM AND PUMPS.
7. INSTALL WATERING POINT.

RECORD DRAWINGS



THESE DRAWINGS REFLECT RECORDED INFORMATION OBTAINED DURING CONSTRUCTION.

INFORMATION PROVIDED HEREIN IS ACCURATE TO THE BEST OF MY KNOWLEDGE.

NAME _____ DATE _____

12-3-91	RECORD DRAWING	JTC
DATE	REVISIONS	INITIALS

U. S. Department of Health & Human Services
Public Health Service
Indian Health Service

BEAVER, ALASKA


AERIAL PHOTO
PUBLIC LAW 86-121 PROJECT
PROJECT NO. AN-89-996

SHEET NO.
D-1
OF
2
TOTAL SHEETS

Mark R. McKinley
Design Engineer


Maintenance Review

Material Take-off

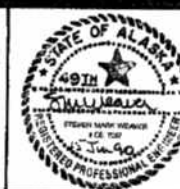


DRAWN BY: TJM
DATE: 1-90
CHECKED BY: _____
DATE: _____

SANITATION FACILITIES CONSTRUCTION BRANCH
ENVIRONMENTAL HEALTH BRANCH
ALASKA AREA NATIVE HEALTH SERVICE
ANCHORAGE, ALASKA

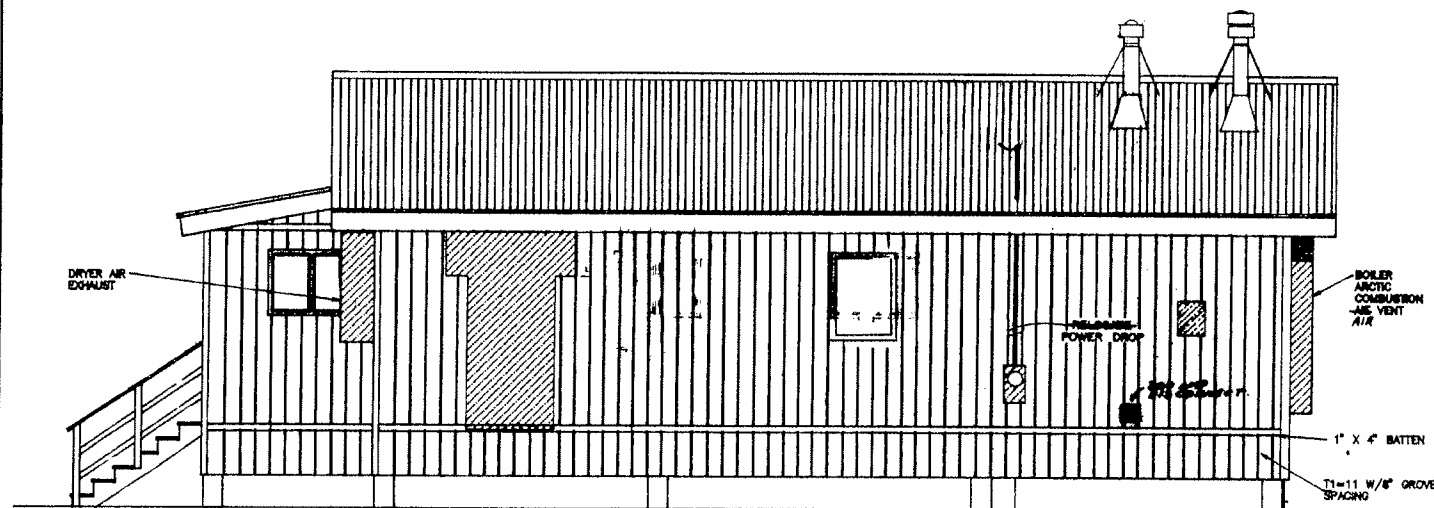


RIGHT SIDE ELEVATION
SCALE 1/4" = 1'-0"

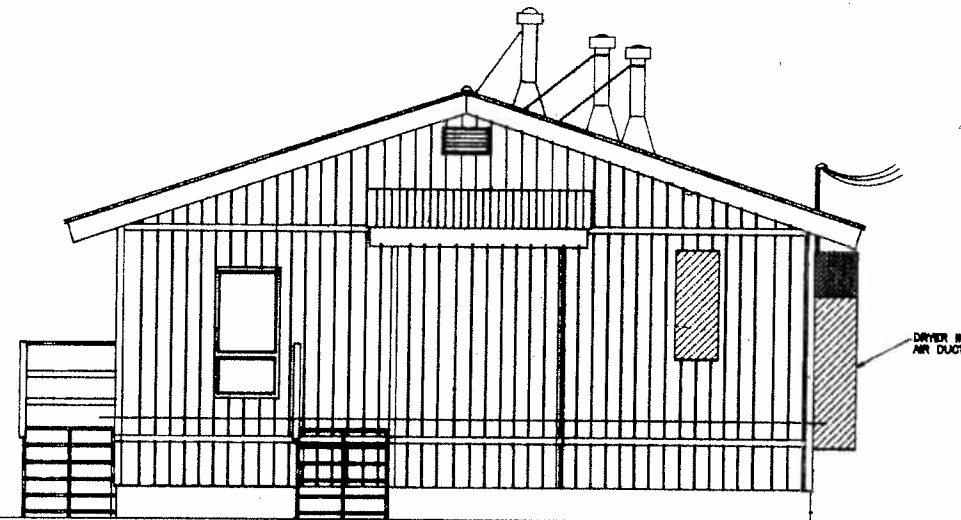


FRONT ELEVATION
SCALE 1/4" = 1'-0"

- SCOPE OF WORK (✓ INDICATES WORK COMPLETED)
1. SPRAY BUILDING OF EXISTING FACILITIES AND PARTITION WALLS.
 2. COMPLETE NEW FLOOR PLAN TO INCLUDE:
 - ✓ A. INSULATE FLOOR TO EQUIVALENT R-36; POLYURETHANE SPRAY FOAM PREFERRED.
 - ✓ B. INSULATE INTERIOR WALLS WITH 2-INCH POLYSTYRENE AND SEAL WITH 8 MIL VAPOR BARRIER.
 - ✓ C. CONSTRUCT INTERIOR PARTITION WALLS.
 - ✓ D. REMOVE AND PLUG DESIGNATED WINDOWS AND INSTALL NEW WINDOWS.
 - ✓ E. REMOVE OLD DOORS AND INSTALL NEW DOORS.
 - ✓ F. INTERIOR FINISH AND TRIM.
 - ✓ G. ELECTRICAL WIRING AND CONTROLS.
 - ✓ H. HOT WATER GENERATOR.
 - ✓ I. WASHERS - 4 EACH
 - ✓ J. DRYERS - 3 EACH
 - ✓ K. LIFT STATION
 - ✓ L. SHOWERS, TOILETS, AND SINKS.
 - ✓ M. PLUMBING.
 - ✓ N. WATER TREATMENT: CHLORINATOR, FLUORIDATOR, POTASSIUM PERMANGANATE INJECTOR, AND FILTER, ALSO PRECHLORINATE WELL.
 - ✓ O. TWO BOILERS COMPLETE WITH WATER MAKEUP AND CIRCULATION PUMPS.
 - ✓ P. SEARCH CONCRETE FLOOR WITH 8 MIL VAPOR BARRIER.
 - ✓ Q. ADD FLOOR TILES IN PUBLIC AREAS AND OFFICE.
 - ✓ R. BUILDING EXTERIOR REPAIR AND PAINT, AND REPLACE STAIRWAYS.
 - ✓ S. FUEL SYSTEM MODIFICATIONS.
 - ✓ T. CONSTRUCT NEW UTILITY BETWEEN THE WASHETERIA AND UTILITY BUILDING.
 - ✓ U. PROVIDE FOR INTERIM WASHER AND DRYER SERVICES DURING THE REHABILITATION OF THE WASHETERIA FACILITIES.
 3. RELOCATE POWER DROP & WEATHER HEAD.
 4. ABANDON EXISTING WATERING POINT & SEAL ACCESS DOOR.
 5. LOCATE SEWER PUMP & LIFT STATION DURING CONSTRUCTION. CONTACT FIELD ENGINEER TO REVIEW FINAL PLACEMENT.
10. NOTES:
 F.D. = FLOOR DRAIN
 F.E. = FINE EXTINGUISHER
 F.T.R. = FIN TUBE RADIATOR


NOTE: REFER TO R&M CONSTRUCTION DRAWINGS FOR THE ORIGINAL BUILDING LAYOUT AND CONSTRUCTION DETAILS.

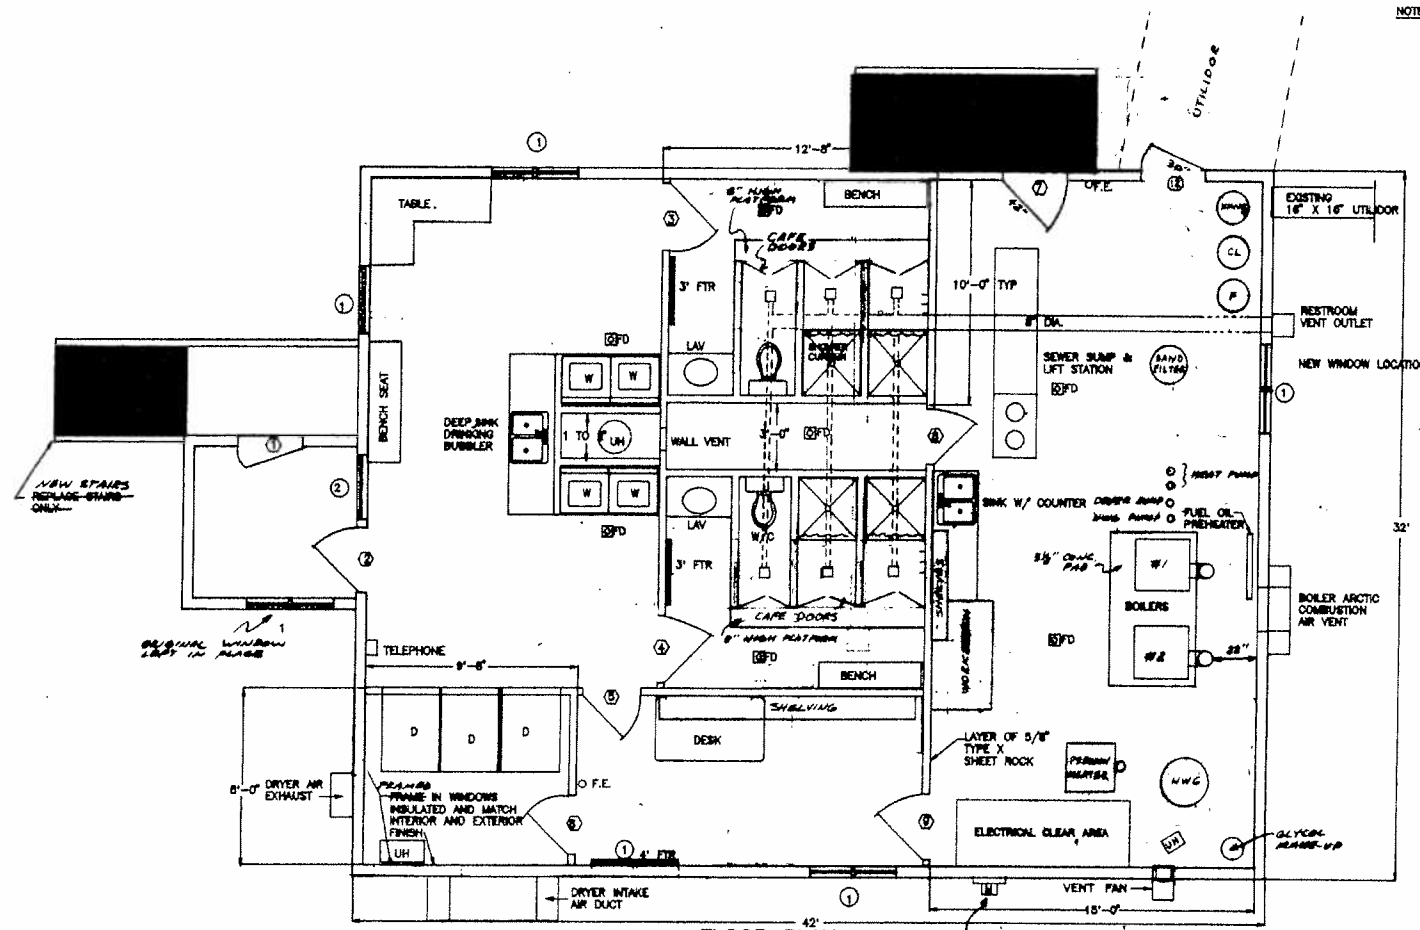


FLOOR PLAN
SCALE 1/4" = 1'-0"

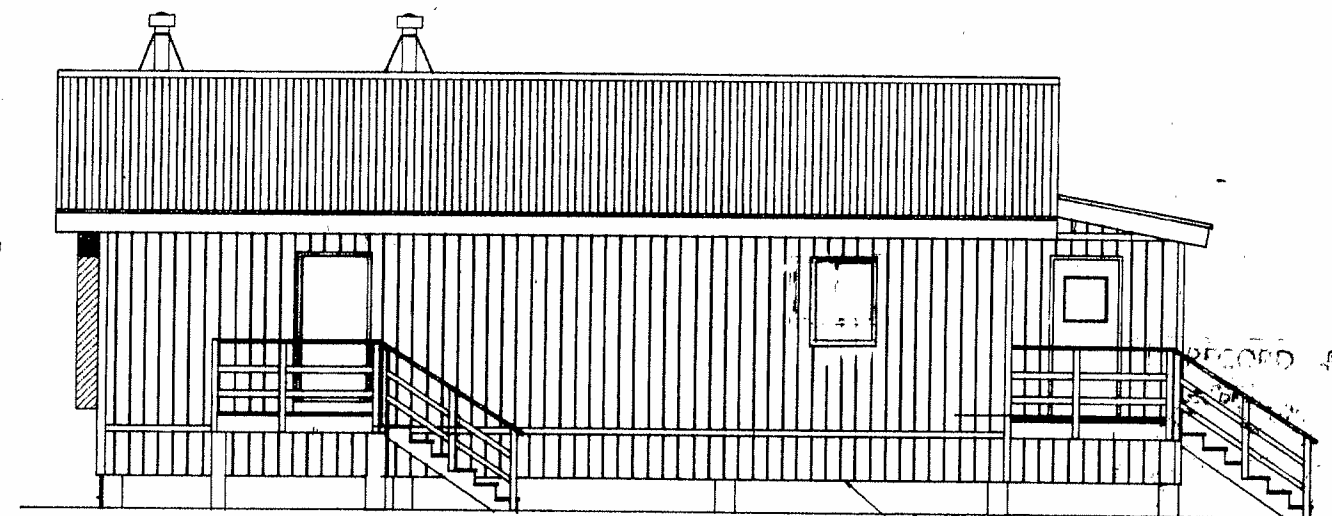


LEFT SIDE ELEVATION
SCALE 1/4" = 1'-0"

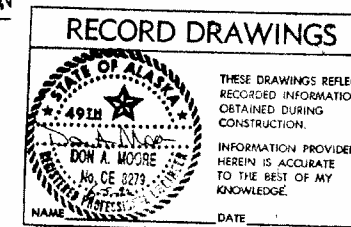

NAME: Don A. Moore
 Design Engineer
 Maintenance Review
 Material Take-off

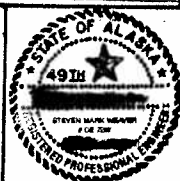


12-23-81		212385 DRAWING		J.C.
1-13-82		MODIFIED		J.C.
DATE	REVISIONS			INITIALS
U.S. Department of Health & Human Services Public Health Service Indian Health Service				
BEAVER, ALASKA				SHEET NO. A-1
WTP / FLOOR PLAN AND ELEVATIONS				OF 6
PUBLIC LAW 86-121 PROJECT				TOTAL SHEETS
PROJECT NO. AN-89-996				
DRAWN BY: JAO	CHECKED BY:			
DATE: 3-90	DATE:			
SANITATION FACILITIES CONSTRUCTION BRANCH ENVIRONMENTAL HEALTH BRANCH ALASKA INDIAN HEALTH SERVICE ANCHORAGE, ALASKA				

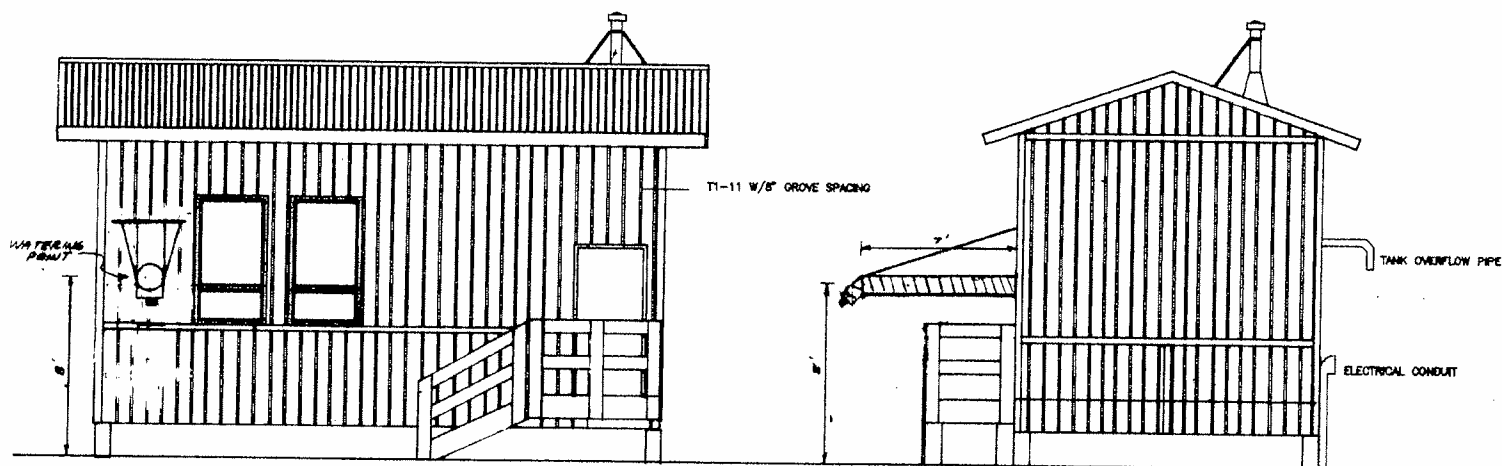

FRONT ELEVATION
SCALE 1/4" = 1'-0"

END ELEVATION
SCALE 1/4" = 1'-0"

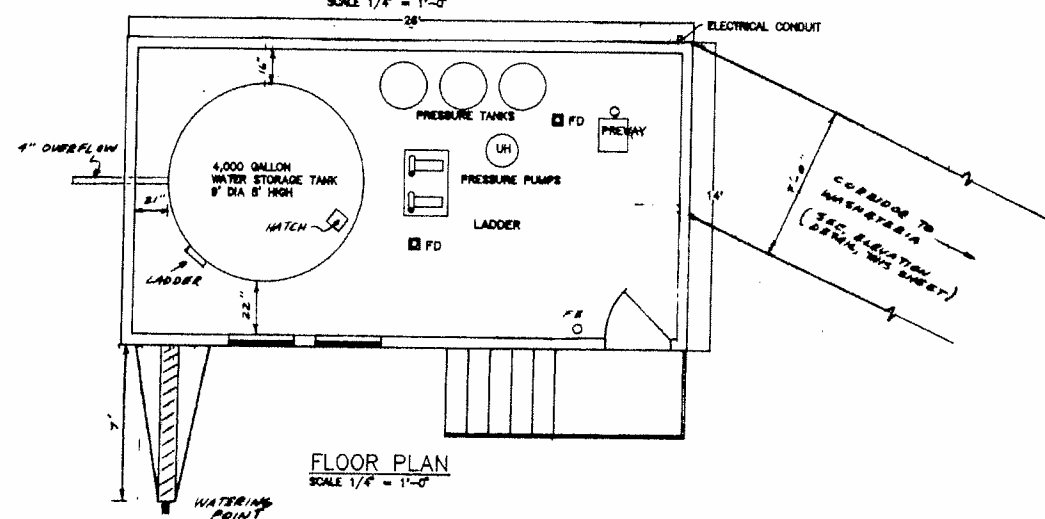

FLOOR PLAN
SCALE 1/4" = 1'-0"

SCOPE OF WORK (V INDICATES WORK COMPLETED)


1. REMOVE AND REPLACE ROTTEN GYPSUM BOARD ON INTERIOR OF UTILITY BUILDING. THIS IS GENERALLY LIMITED TO THE LOWER 4 FOOT PERIMETER OF THE BUILDING.
2. INSULATE MISCELLANEOUS HOLES IN THE STRUCTURE AND SEAL WITH 8 MIL VAPOR BARRIER. USE PLASTIC TAPE TO SEAL ALL VAPOR BARRIER JOINTS.
3. REPAIR ALL HOLES WITH GYPSUM AND GROUT AFTER ITEM 2 IS COMPLETED.
4. REFRESH FLOOR WITH 8 MIL VAPOR BARRIER AND SMOOTH CONCRETE SLAB WITH 615/10-10 MMA W/N 2 REBAR 24-INCHES O.C. EACH DIRECTION.
5. INSTALL NEW WATER STORAGE TANK WITH PE OVERFLOW PIPE.
6. INSTALL PRESSURE PUMPS, PLUMBING, PRESSURE TANKS AND HYDROLOGIC LOOP.
7. INSTALL PREPARED HEATER, FUE STACK, AND FUEL OIL PIPING.
8. REPAIR THE ELECTRICAL SYSTEM FOR NEW FLOOR PLAN.
9. REPAIR INTERIOR AND EXTERIOR OF THE BUILDING.
10. REPLACE ENTRANCE STAIRWAY AND DECK WITH THE IHS STANDARD STAIRWAY.
11. REPAIR BROKEN WINDOW PANELS.
12. REPLACE DOORS AND FRAMES.
13. ADD SHELVING STORAGE CABINETS IN CLEAR AREAS.
14. ADD LADDER TO ACCESS STORAGE SPACE ABOVE STAIRS ENTRY. ACCESS ABANDONED & HOLE INSULATED.
15. ADD FLOOR DRAINS.

AS-BUILT NOTES


1. 3/8" CONCRETE SLAB POURED ON 40 PSI EXTRUDED SYSTEMS.
2. EXTERIOR WALLS AND CEILING RECEIVED VISIBLY 2" DIRECTIONED INSULATION, 3/4" PLYWOOD AND 1/2" WATER-RESISTANT SHEATHING.

BEAVER, ALASKA MECHANICAL ACCESS MELANET 4/16/91

1. REMAIN EXISTING TO NEW UTILITY BLDG & MECHANICAL ACCESS OF APPROXIMATELY:
 MAXIMUM LENGTH = 17'-0"
 OVERALL WIDTH = 7'-0"
 EXTERIOR HEIGHT = 5'-5"
 INTERIOR HEIGHT = 8'-0"

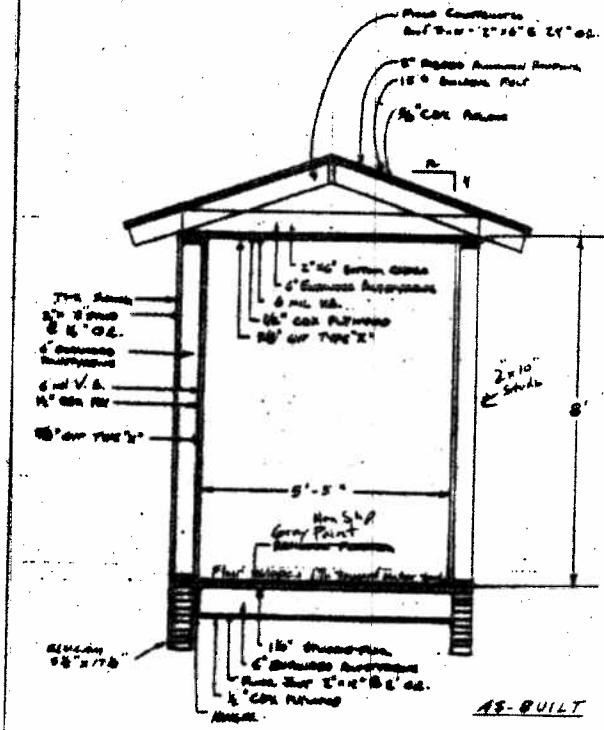

AS-BUILT

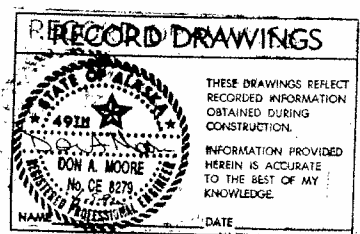


10-15-A	RECORD DRAWING	J.E.
1-13-28	MODIFIED	J.E.
DATE	REVISIONS	INITIALS

U. S. Department of Health & Human Services
 Public Health Service
 Indian Health Service

BEAVER, ALASKA
 UTILITY BUILDING FLOOR PLAN
 PUBLIC LAW 86-121 PROJECT
 PROJECT NO.




SHEET NO.
 A-2
 OF
 6
 TOTAL SHEETS

Design Engineer

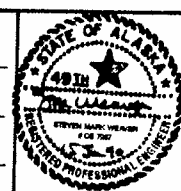

Maintenance Review
 Material Take-off

DRAWN BY: JAG
 DATE: 5-80
 CHECKED BY:
 DATE:
 SANITATION FACILITIES CONSTRUCTION BRANCH
 ENVIRONMENTAL HEALTH BRANCH
 ALASKA AREA NATIVE HEALTH SERVICE
 ANCHORAGE, ALASKA

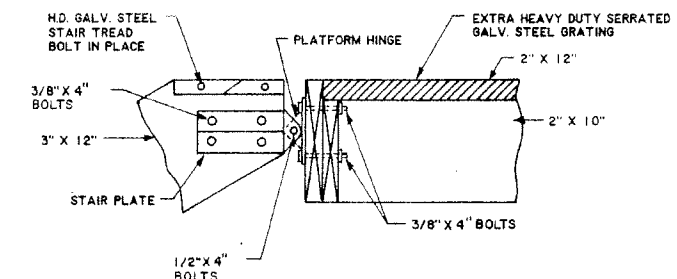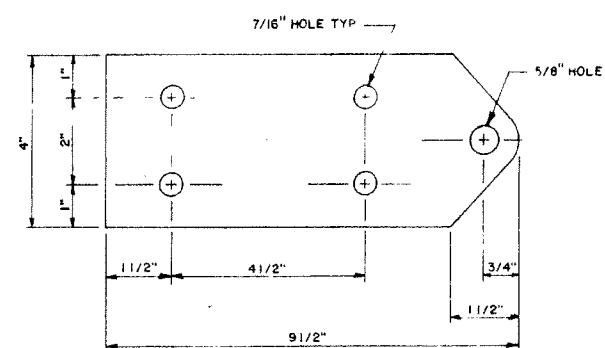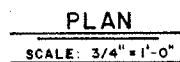


SCALE: 1/2" = 1'-0"

SCOPE OF WORK

NOTES :

1. SEE FLOOR PLAN SHEETS A-1 AND A-2 FOR ORIENTATION OF STAIRS.
2. WASHETERIA: ~~REPLACE~~ ^{REPLACE} BOTH FRONT AND REAR STAIRWAYS, REPAIR PORCHES WHERE NEEDED.
3. UTILITY BUILDING: ~~REPLACE~~ ^{REPLACE} THE PORCH AND THE STAIRWAY ASSEMBLY.
4. U.B.C. SECTION 3306 - "THE RISE ON EVERY STEP IN STAIRWAY SHALL BE ~~NOT~~ ^{NOT} LESS THAN 4" OR GREATER THAN 7".

RECORD DRAWINGS

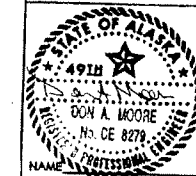

THESE DRAWINGS REFLECT
RECORDED INFORMATION
OBTAINED DURING
CONSTRUCTION.

INFORMATION PROVIDED
HEREIN IS ACCURATE
TO THE BEST OF MY
KNOWLEDGE.

DATE 6-5-92

12-9-81	RECORD DRAWING	J.C.
1-18-82	MODIFIED	J.C.
DATE	REVISIONS	INITIALS

U. S. Department of Health & Human Services
Public Health Service
Indian Health Service

BEAVER, ALASKA

BUILDING STAIRS DETAIL
PUBLIC LAW 86-121 PROJECT
PROJECT NO. AN-89-026

SHEET NO.
A-4
OF
6
TOTAL SHEET


DRAWN BY: WKT TMM **CHECKED BY:**
DATE: NOV. 84 2-90 **DATE:**


SANITATION FACILITIES CONSTRUCTION BRANCH
ENVIRONMENTAL HEALTH BRANCH
ALASKA AREA NATIVE HEALTH SERVICE
ANCHORAGE, ALASKA

Charles E. Meloy
Design Engineer

Maintenance Review

Material Take-off

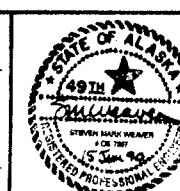

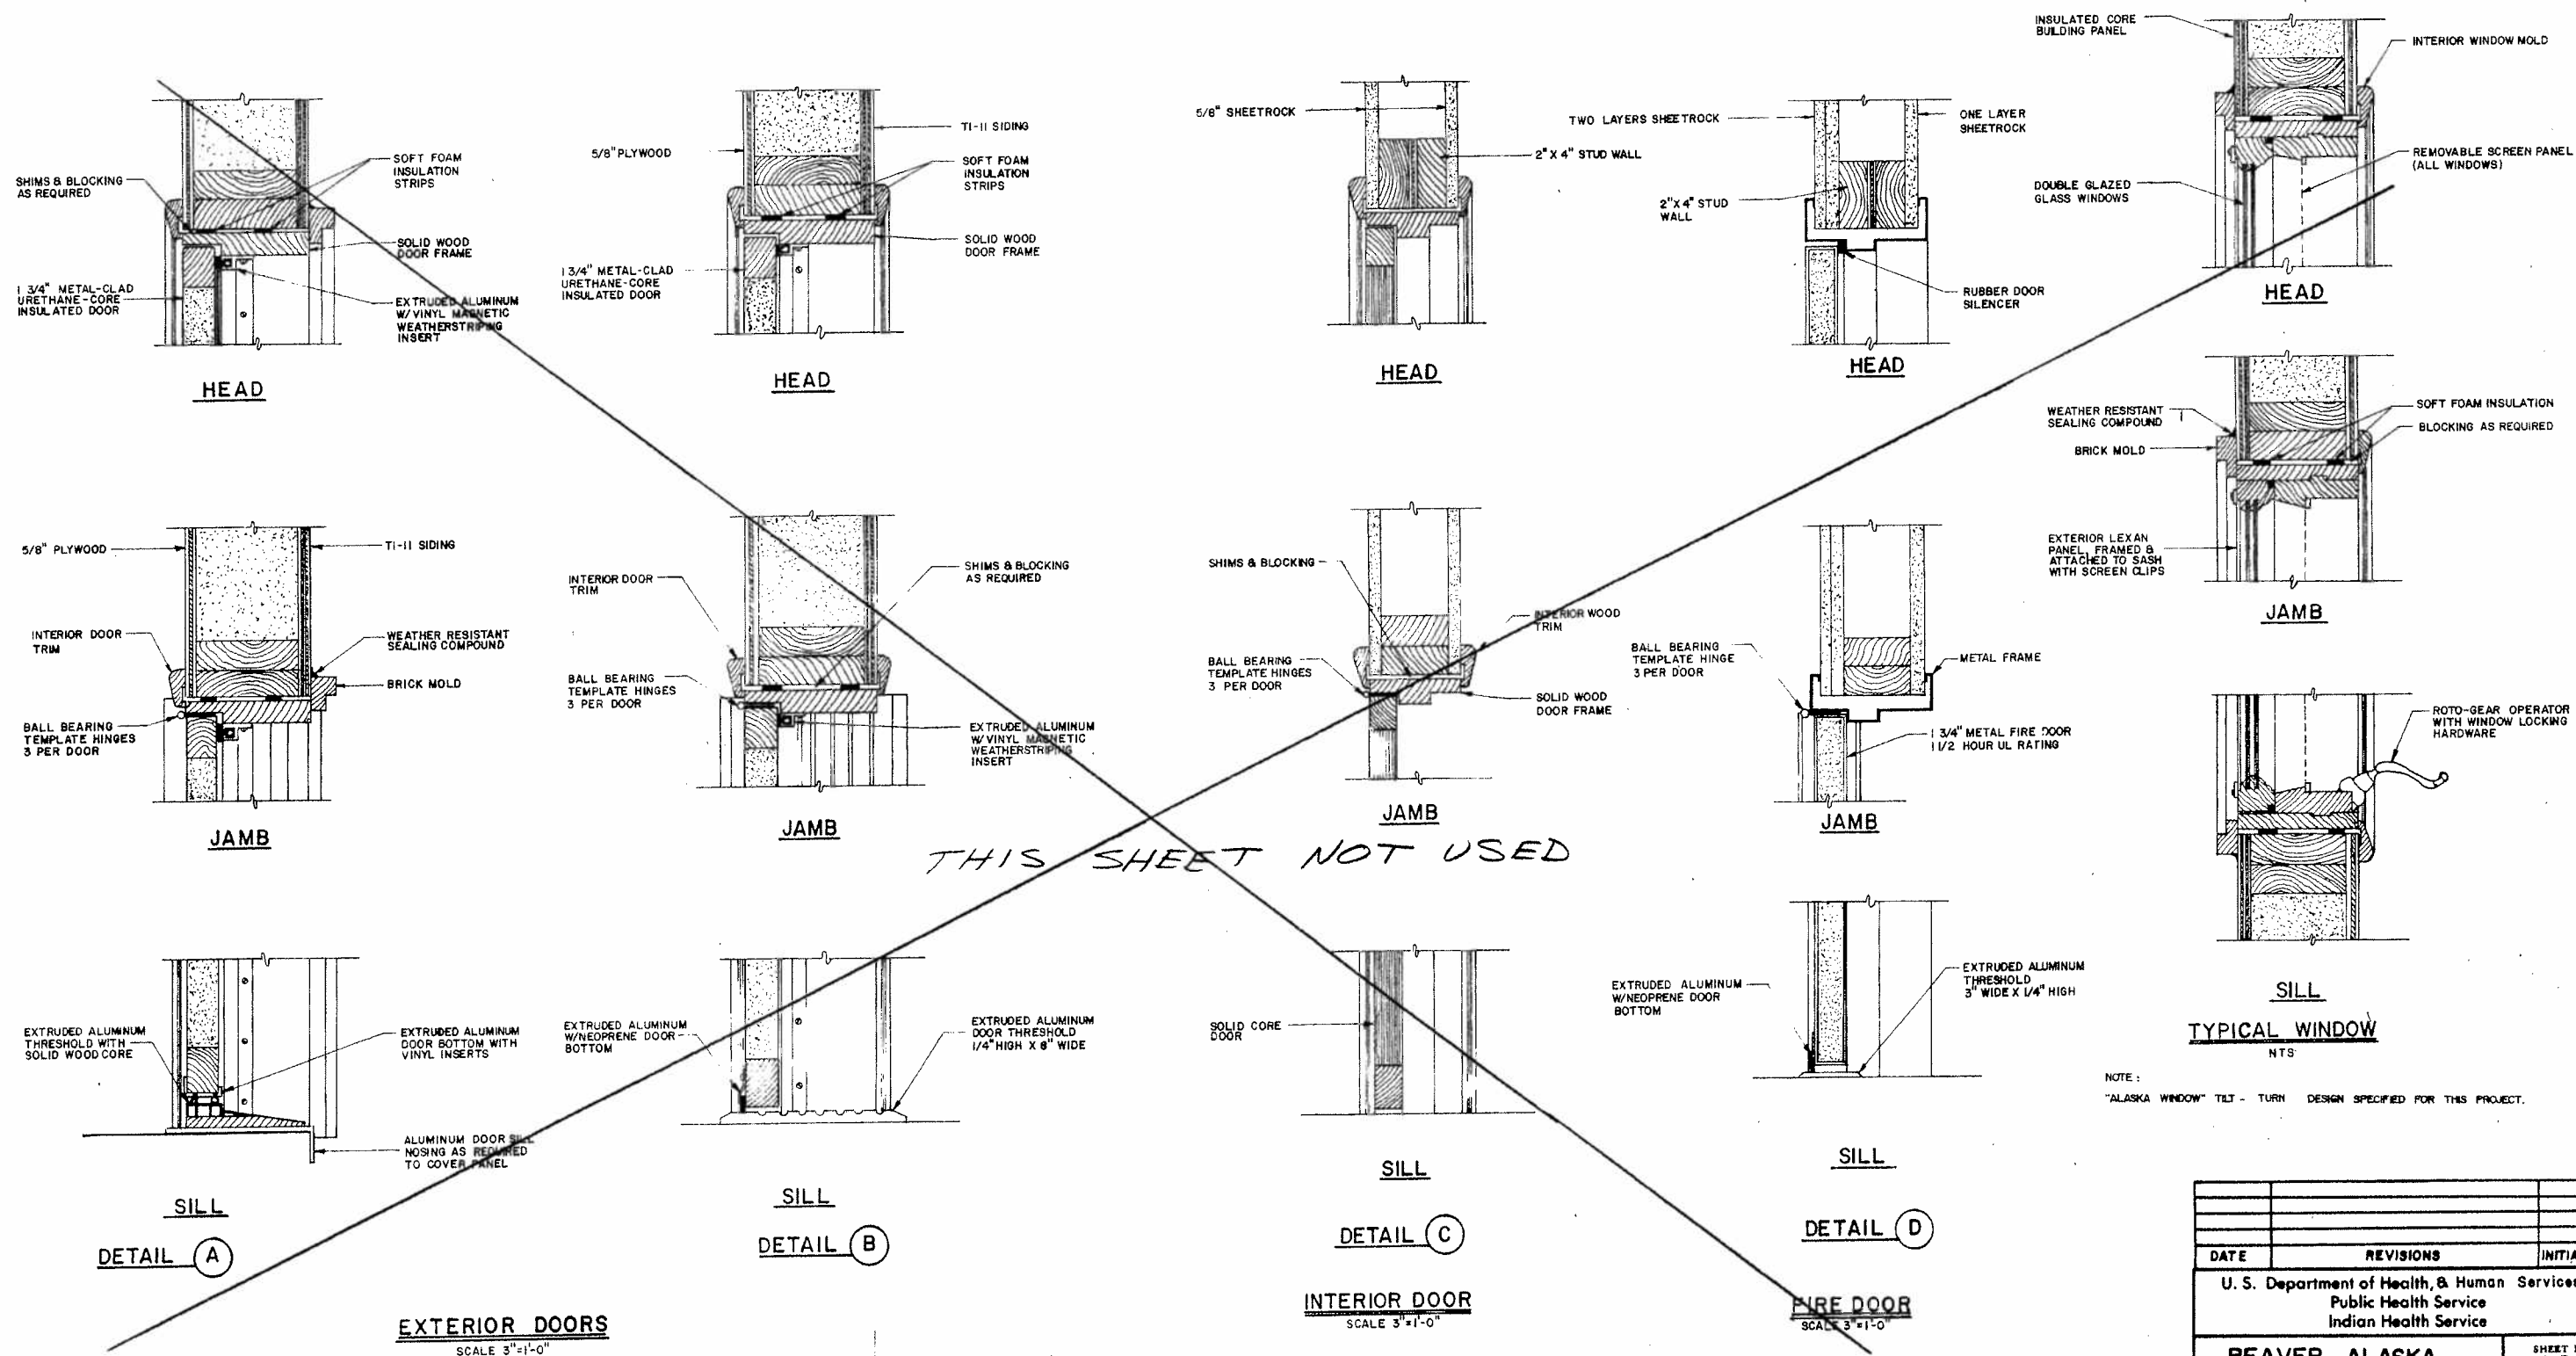








DATE	REVISIONS	INITIALS
U. S. Department of Health, & Human Services Public Health Service Indian Health Service		
BEAVER, ALASKA		SHEET NO. A-5
DOORS AND WINDOW DETAILS		OF 6
PUBLIC LAW 86-121 PROJECT		TOTAL SHEETS
PROJECT NO. AN-89-996		
DRAWN BY: TJM	CHECKED BY:	
DATE: 2-90	DATE:	
SANITATION FACILITIES CONSTRUCTION BRANCH ENVIRONMENTAL HEALTH BRANCH ALASKA AREA NATIVE HEALTH SERVICE ANCHORAGE, ALASKA		

Paul R. Miley
Design Engineer

Maintenance Review

Material Take-off

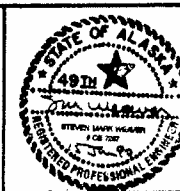

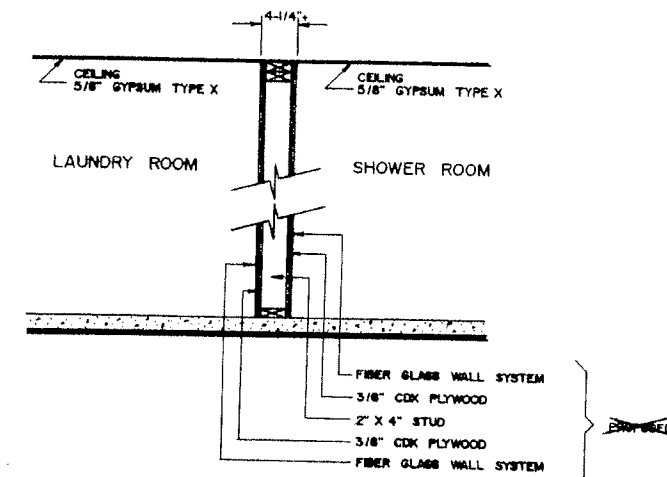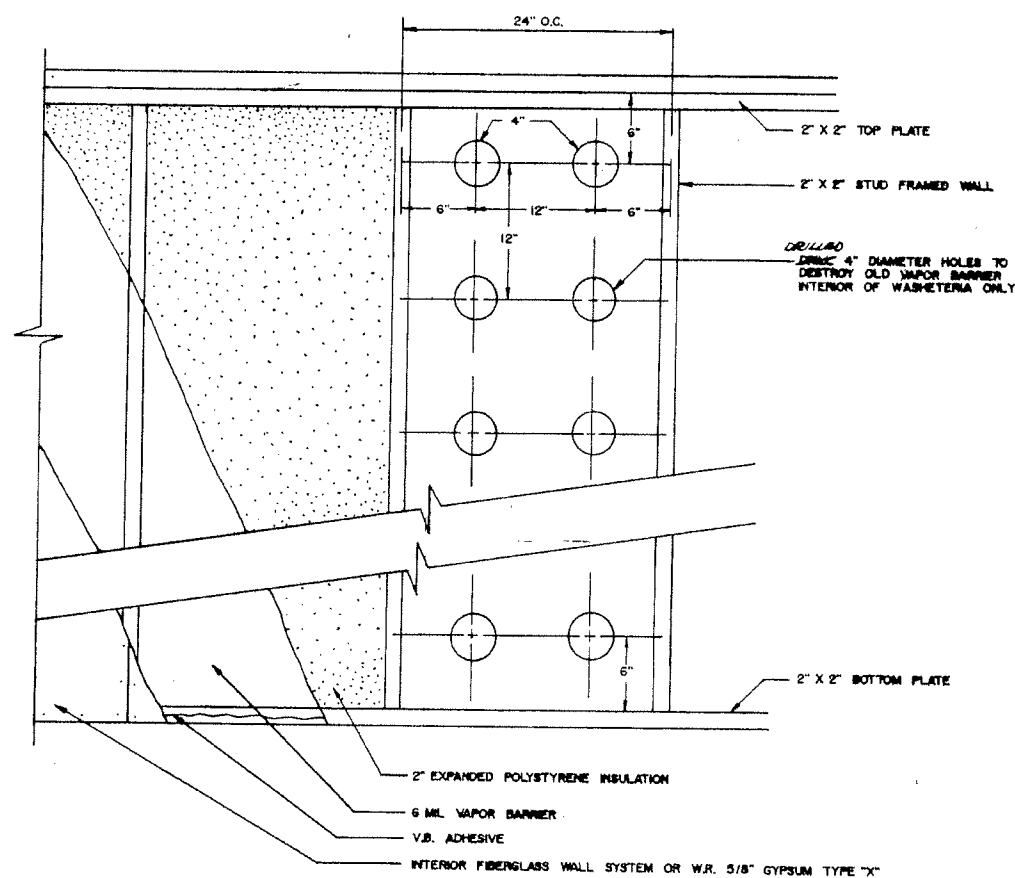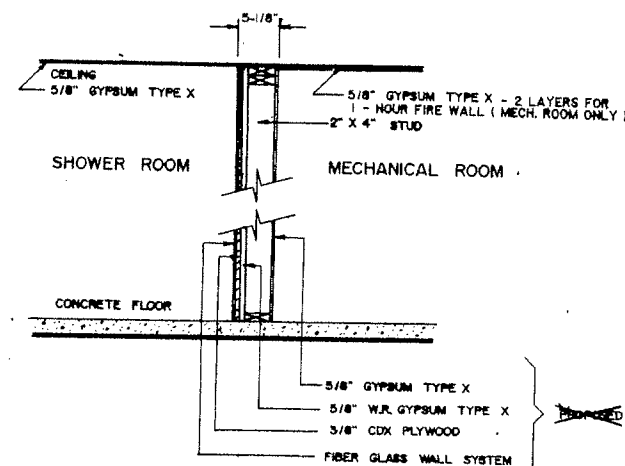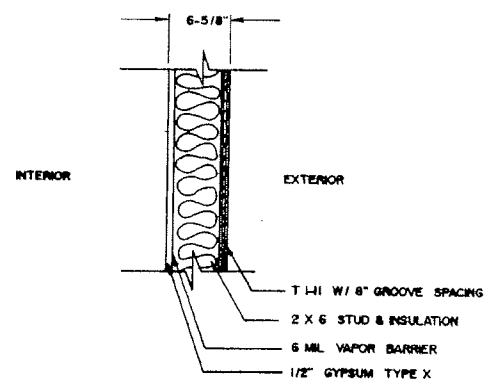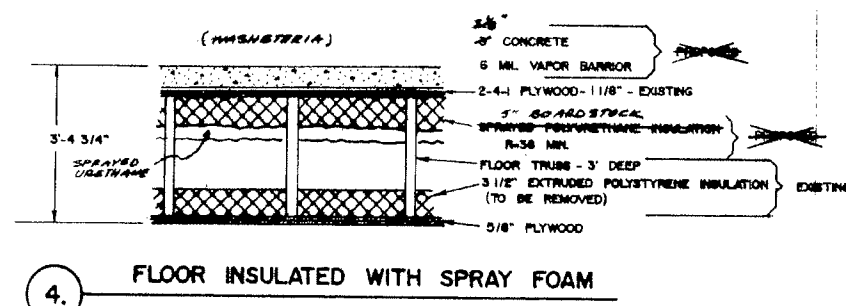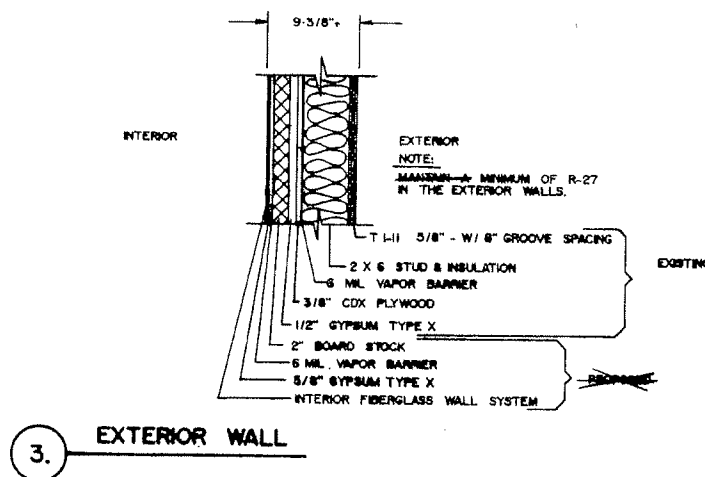

- RETROFIT NOTES: (V INDICATES ITEMS COMPLETED)**
1. Remove old vapor barrier (VB) by drilling 4" diameter holes 12" OC through the interior of the existing walls.
 2. Construct the new 2" X 2" stud walls.
 3. COMPLETE THE ELECTRICAL INSTALLATION.
 4. Install new 2" expanded polystyrene insulation.
 5. Install vapor barrier with "TRENCO" acoustical sealant, or approved equal. Staple through the sealant into blocking. Overlap all VB seams by one stud. Tape all VB seams with 3M "CONTRACTOR SHEATHING TAPE", No. 8084, or approved equal. Cut an "X" from corner to corner at window and door openings. Pull the VB over opening and fasten. Trim excess material. Cut a strip the width of the openings and install it around opening. Seal the seams with acoustical sealant and staple through it. Tape the perimeter's edges with sheathing tape.
 6. Seal all electrical outlets with separate VB sheets, sealant, and sheathing tape.
 7. The VB must be inspected by the project engineer or his representative before it is covered with the interior wall system.

WATER TANK ROOM FLOOR PROFILE



RECORD DRAWINGS

THESE DRAWINGS REFLECT RECORDED INFORMATION OBTAINED DURING CONSTRUCTION.

INFORMATION PROVIDED HEREIN IS ACCURATE TO THE BEST OF MY KNOWLEDGE.

NAME: DON A. MOORE No. CE 827

DATE: 6-5-92

12-8-91	RECORD DRAWING	J.C.
1-13-92	MODIFIED	J.C.
DATE	REVISIONS	INITIALS

U. S. Department of Health & Human Services
Public Health Service
Indian Health Service

BEAVER, ALASKA

FLOOR & WALL SECTION DETAILS

PUBLIC LAW 86-121 PROJECT

PROJECT NO. AN-88-996

SHEET NO. A-6

OF 6

TOTAL SHEETS




DRAWN BY: TJM

DATE: 2-90


CHECKED BY:

DATE:


SANITATION FACILITY CONSTRUCTION

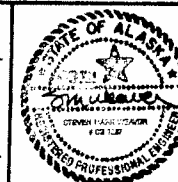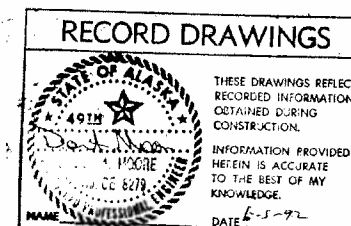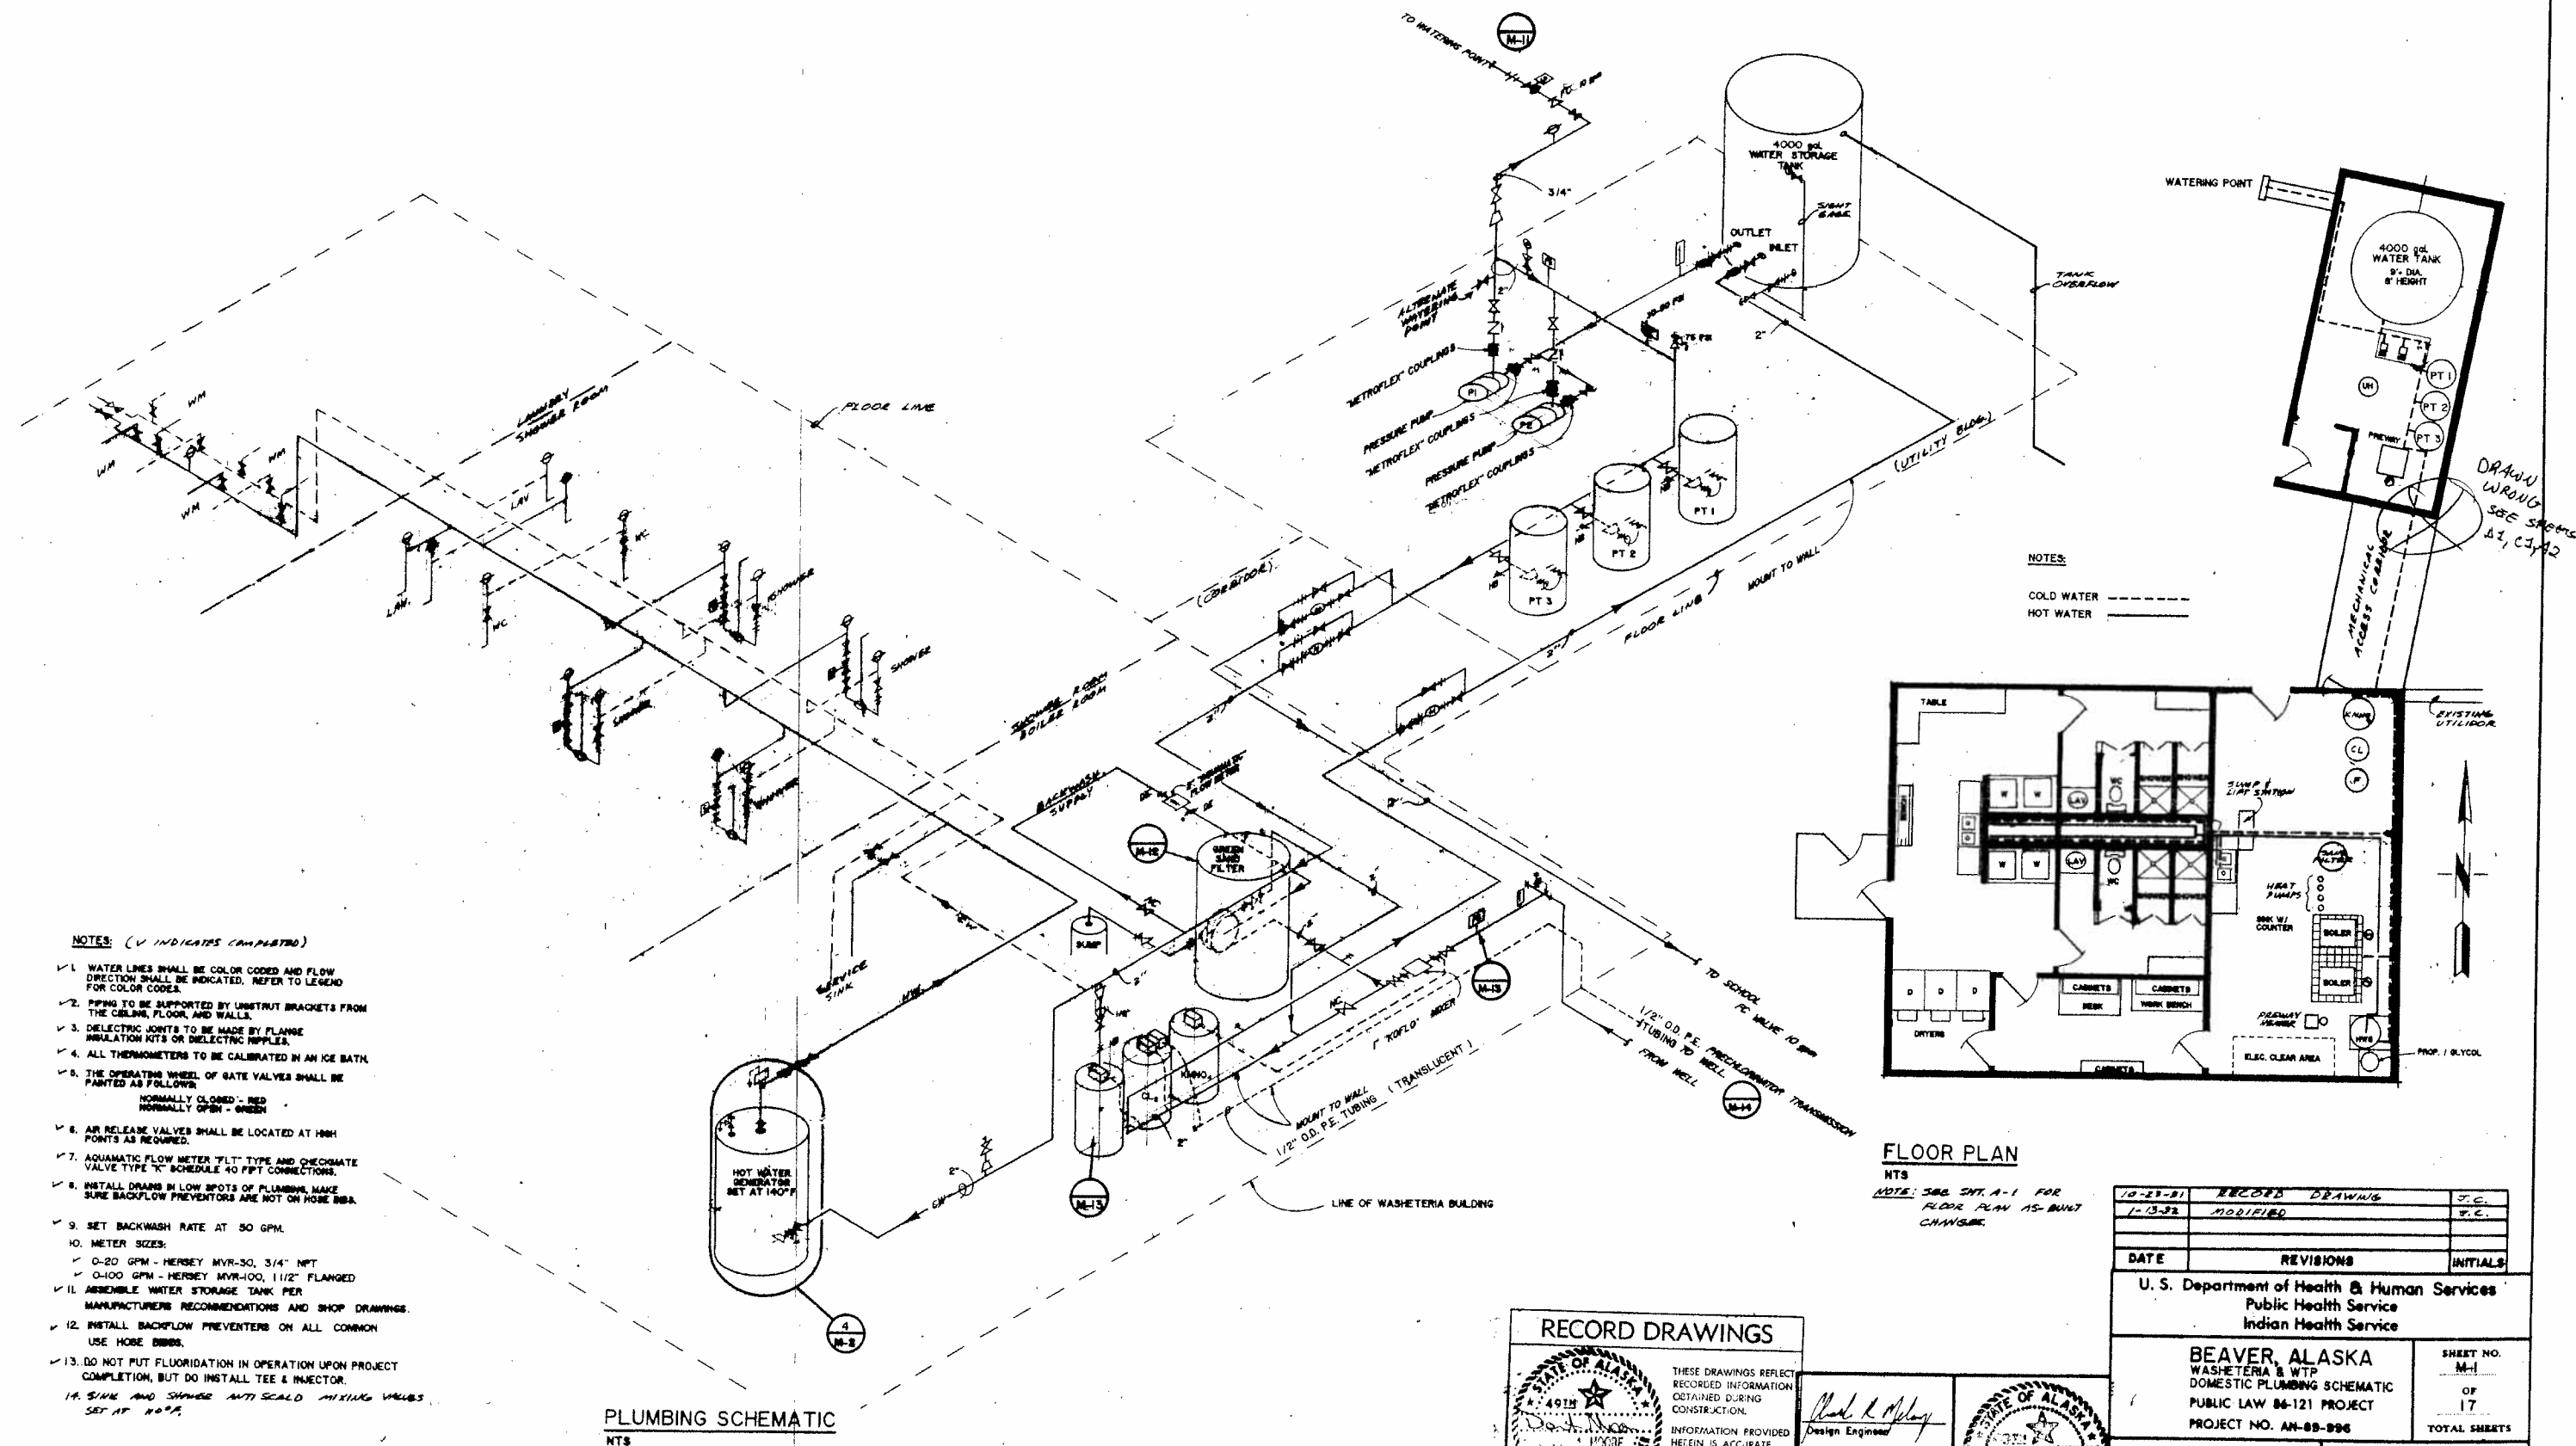

10-23-81	RECORD DRAWING	J.C.
1-13-92	MODIFIED	J.C.
DATE	REVISIONS	INITIALS
U. S. Department of Health & Human Services Public Health Service Indian Health Service		
BEAVER, ALASKA WASHETERIA & WTP DOMESTIC PLUMBING SCHEMATIC PUBLIC LAW 86-121 PROJECT PROJECT NO. AN-88-896		SHEET NO. M-1 OF 17 TOTAL SHEETS
DRAWN BY: DCS, J.M.	CHECKED BY:	
DATE: 1-2-90	DATE:	
SANITATION FACILITIES CONSTRUCTION BRANCH ENVIRONMENTAL HEALTH BRANCH ALASKA AREA NATIVE HEALTH SERVICE ANCHORAGE, ALASKA		

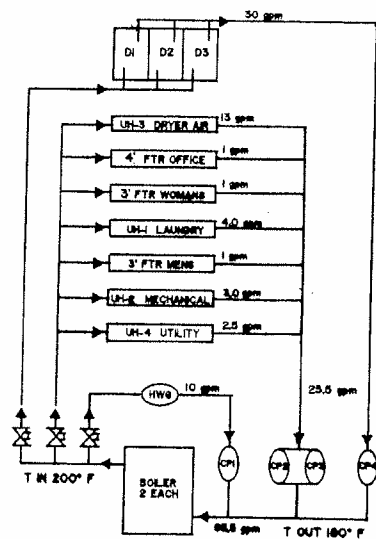

HYDRONIC SYSTEM LOOP SCHEMATIC
NTS

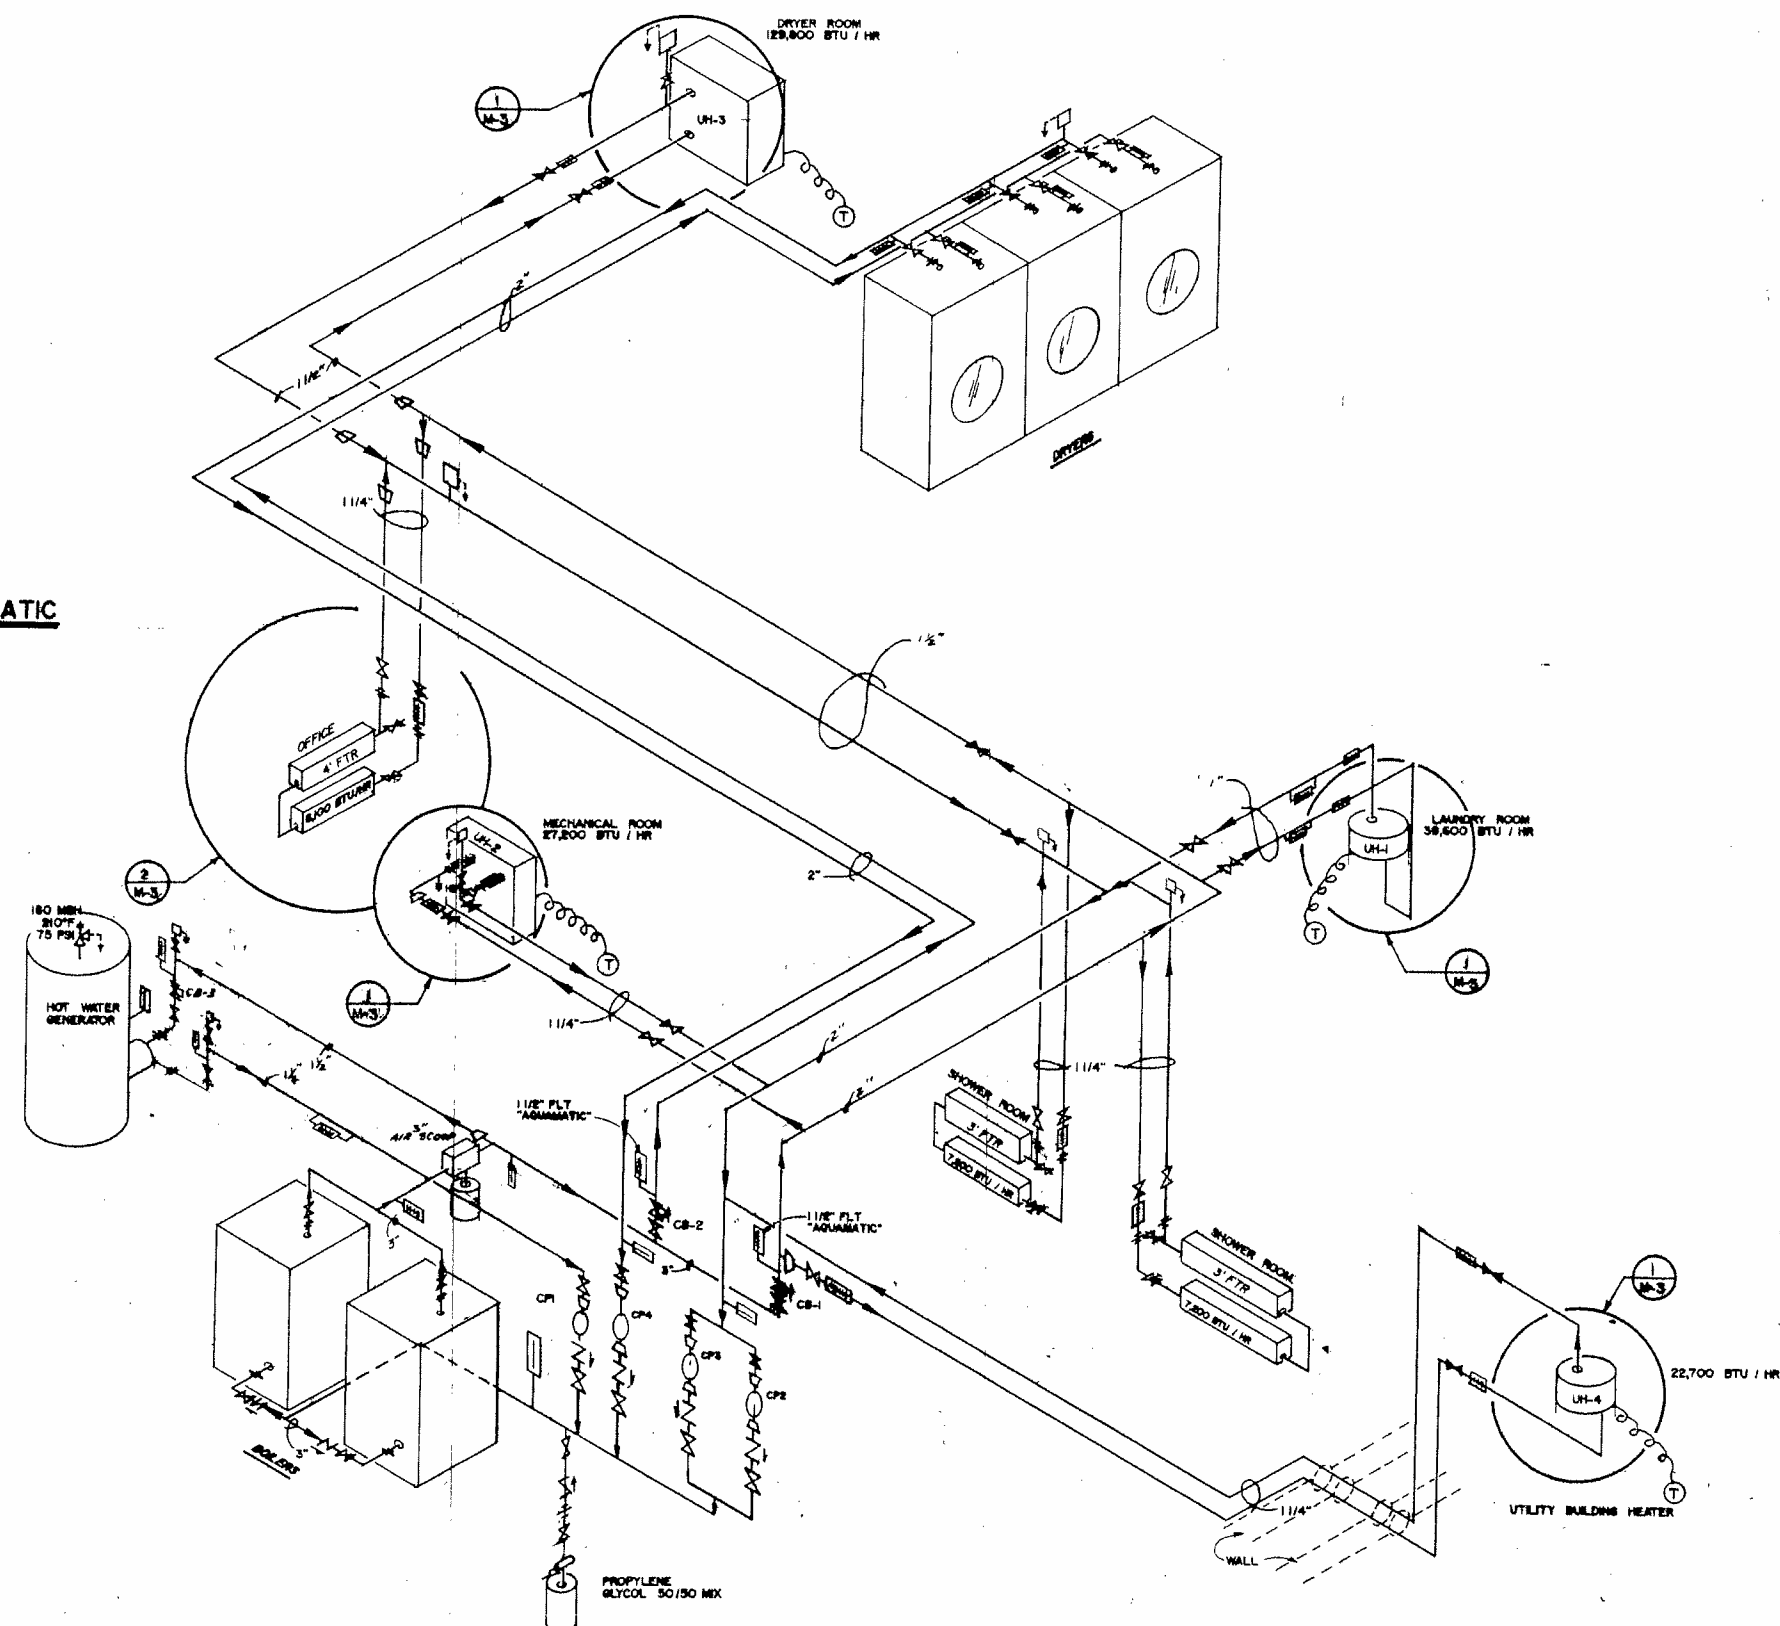

HYDRONIC SYSTEM SCHEMATIC
NTS

- OPERATING INSTRUCTIONS:**
1. SPACE HEAT. ONE OF THE TWO CIRCULATING PUMPS (CP) SHALL CONTINUOUSLY CIRCULATE BOILER WATER. (CP-2 OR CP-3)
 - UNIT HEATER ZONE. WATER WILL ALWAYS FLOW THROUGH THE UNIT HEATERS - UPON DEMAND FROM THEIR RESPECTIVE THERMOSTATS, UNIT HEATER PUMP WILL ACTIVATE FOR ZONE HEAT.
 - FIN RADIATOR ZONE. WATER ONLY FLOWS THROUGH THESE LOOPS WHEN THE APPROPRIATE THERMOSTAT CALLS FOR HEAT AND SPENDS THE THERMOSTATIC RADIATOR VALVE ON THAT PARTICULAR LOOP.
 2. BALANCE THE HYDRONIC PLUMBING.
 - A. FIRST ADJUST THE CIRCUIT BALANCING (CB-1) VALVE TO DESIRED FLOW RATE.
 - B. REPEAT STEP ON FOR CB-2 AND CB-3.
 - C. ADJUST THE THERMOSTATIC BALANCERS FOR THE PROPER FLOW RATES THROUGH THE INDIVIDUAL LOOPS.
 3. BEFORE THE DRYER HOT WATER CIRCULATING PUMP IS ACTIVATED WHEN ANY ONE DRYER IS ACTIVATED. WHEN ONE DRYER IS ON, ALL COILS ARE SUPPLIED WITH HOT WATER.
 4. UNIT HEATER ZONE. THE UNIT HEATER CIRCULATING PUMP IS ACTIVATED UPON CALL FROM THE UNIT HEATER THERMOSTAT.

PLUMBING:

UNIT HEATER UH-1: TRANE UH0604P400AC, 1500 RPH, LAUNDRY ROOM
 UNIT HEATER UH-2: TRANE UH0604P400AC, 1500 RPH, MECHANICAL ROOM
 UNIT HEATER UH-3: TRANE UH0604P400AC, 1500 RPH, DRYER AIR PREHEAT
 UNIT HEATER UH-4: TRANE UH0604P400AC, 1500 RPH, UTILITY BUILDING
 FIN RADIATOR: TRANE SERIES 80, 2 TIER, 200 ENCLOSURE, 6-INCH DEEP

CIRCULATING PUMPS:

CP-1, HOT WATER GENERATOR LOOP, BRUNNEN PUMPS 15-42P
 CP-2 AND CP-3, SPACE HEATING LOOP, BRUNNEN PUMPS 50-60
 CP-4, DRYER LOOP, BRUNNEN PUMPS 50-60

MANUAL FLAP VALVES:

TYPE 2 1/2" WITH ZONES AND METAL STRAINER COP AND TIEPLIN O-RINGS, AND TYPE 1" CHAMBERS WITH 30-40S AND TIEPLIN O-RINGS. ENTIRE ASSEMBLY TO BE RATED TO 300° F.

2 EACH 1-1/2 INCH
 1 EACH 2 INCH

- NOTES**
- (V 1/2 INCHES WITH 1/2 INCH CLAMPING)
1. INSULATE HYDRONIC LINES WITH 1/2" ARMAFLEX OR EQUAL. INDICATE DIRECTION OF FLOW SUPPLY AND RETURN PLUMBING.
 2. PROVIDE THERMAL BREAK BETWEEN PIPE AND PIPE SUPPORTS. IF PIPE SUPPORTS ARE UNISOLATED FITTINGS, THEN USE EXTRA LARGE PIPE CLAMPS TO HANG AROUND THE INSULATED PIPE.
 3. NO USED FRAMING MEMBER SHALL BE IN CONTACT WITH UNINSULATED HEATING PIPE.
 4. HYDRONIC BRASS VALVES SHALL HAVE A SQUARE HNT, OR SIMILAR OPERATING DRIVE. WHEEL VALVES SHALL NOT BE USED.
 5. AUTOMATIC FLAP VALVE (FLV) TYPE AND CHECK VALVE (K) TYPE WITH HIGH TEMPERATURE CONSTRUCTION FOR PERFORMANCE RATING TO 300° F. SCHEDULE 40 FIFTY CONNECTIONS. THE FLV METER SHALL BE INSTALLED ON A LENGTH OF PIPE THAT IS THE SAME DIAMETER AS THE METER. VALVES AND FITTINGS SHALL BE AT LEAST 3 PIPE DIAMETERS UPSTREAM FROM THE METER AND AT LEAST 3 PIPE DIAMETERS DOWNSTREAM OF THE METER.
 6. LOCATE THE S & S THERMOSTATIC BALANCER, THE ISOLATION VALVES, AND THE AIR-1 AT THE CEILING LEVEL.
 7. HOSE BONDS SHALL BE INSTALLED IN LOW AREAS IN THE PIPING FOR DRAINAGE PURPOSES.
 8. PUMPS SHALL BE INSTALLED AT OR BELOW THE LEVEL OF THE BOILER LOW WATER BUTTEFFS.
 9. BOILERS SHALL BE OPERATED IN A LEAD/LAG FASHION. CIRCULATING PUMPS SHALL PUSH WATER THROUGH BOTH BOILERS IN PARALLEL FLOW ARRANGEMENT. THE LEAD BOILER SHALL OPERATE BETWEEN 180° AND 200° F. THE LAG BOILER SHALL OPERATE BETWEEN 160° AND 180° F. LEAD AND LAG STATUS MAY BE CHANGED BY ADJUSTING THE THERMOSTATS OF THE RESPECTIVE BOILERS.

RECORD DRAWINGS

THESE DRAWINGS REFLECT RECORDED INFORMATION OBTAINED DURING CONSTRUCTION. INFORMATION PROVIDED HEREIN IS ACCURATE TO THE BEST OF MY KNOWLEDGE.

NAME: *BOB A. MOORE* DATE: *6-5-92*

Professional Engineer
 No. CE 8279
 State of Alaska

Paul R. Ashby
 Design Engineer







Maintenance Review



Material Take-off


STATE OF ALASKA

Professional Engineer
 No. CE 8279
 State of Alaska


11-12-91	RECORD DRAWING	J.C.
DATE	REVISIONS	INITIALS
U. S. Department of Health & Human Services Public Health Service Indian Health Service		
BEAVER, ALASKA HYDRONIC SYSTEM PUBLIC LAW 94-121 PROJECT PROJECT NO. AN-89-996		SHEET NO. M-2 OF 17 TOTAL SHEETS
DRAWN BY: DGB, TMA	CHECKED BY:	
DATE: 12-22-89, 2-90	DATE:	
SANITATION FACILITIES CONSTRUCTION BRANCH ENVIRONMENTAL HEALTH BRANCH ALASKA NATIVE HEALTH SERVICE ANCHORAGE, ALASKA		

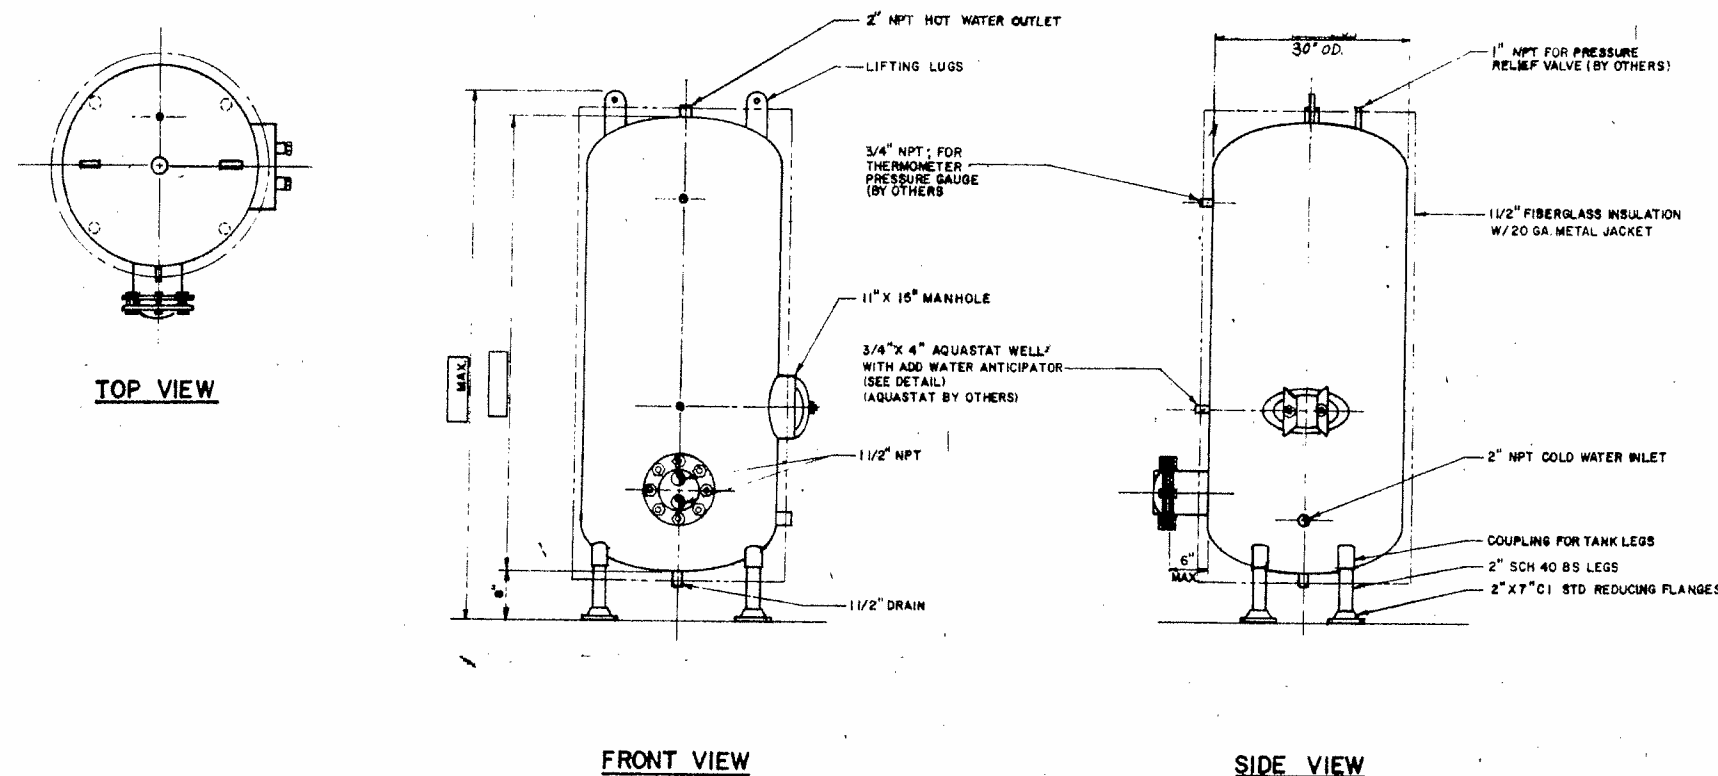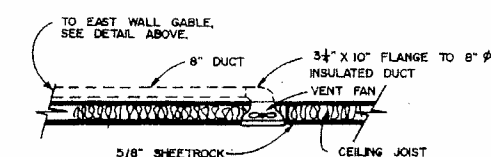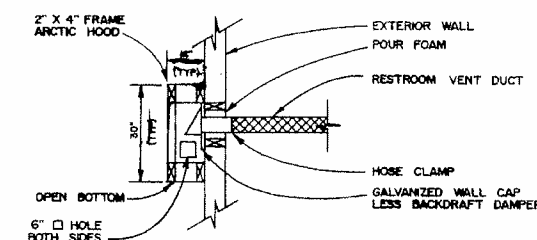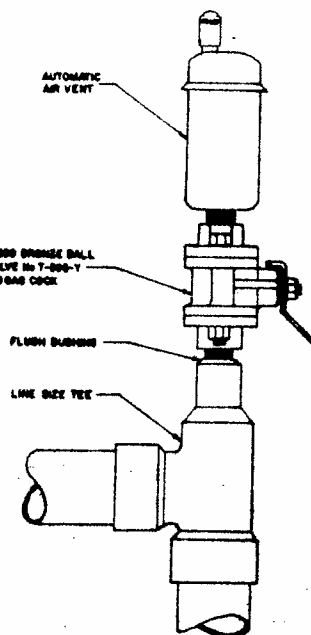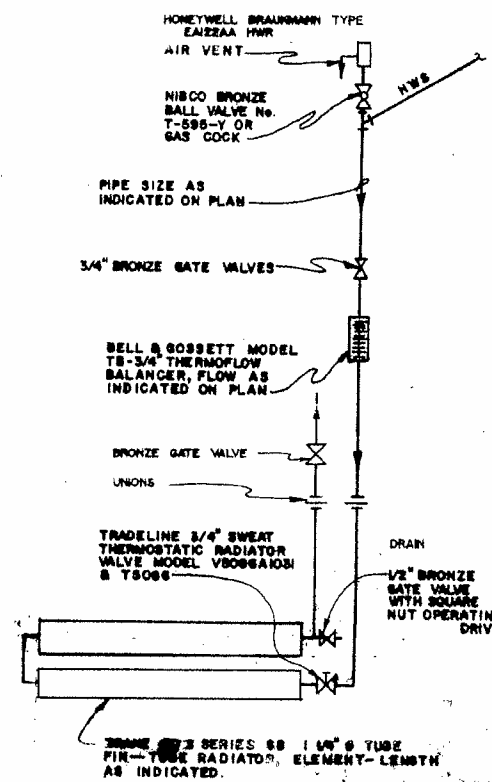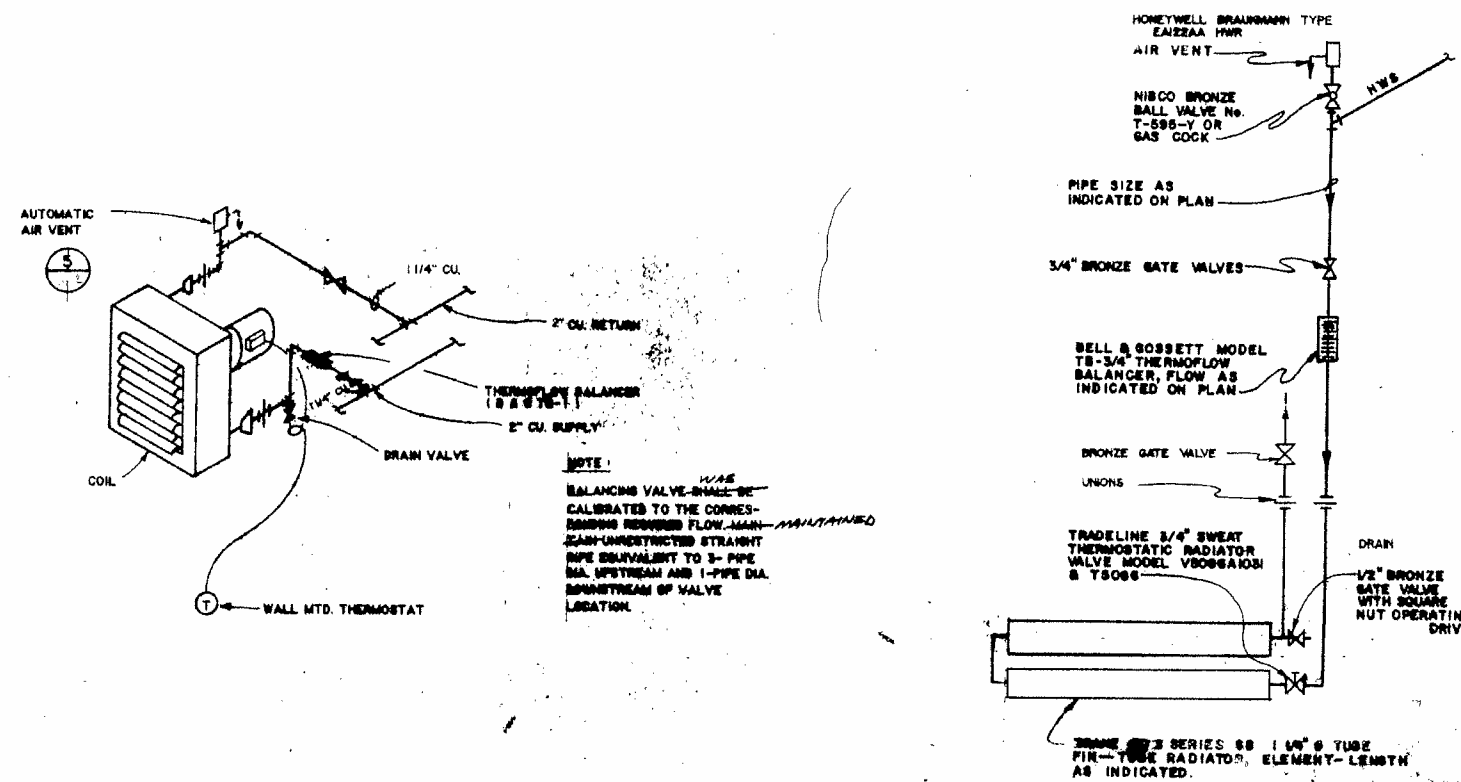

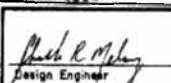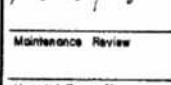RECORD DRAWINGS		12-8-91 RECORD DRAWING J.C.					
 THESE DRAWINGS PERFECT RECORDED INFORMATION OBTAINED DURING CONSTRUCTION. INFORMATION PROVIDED HEREIN IS ACCURATE TO THE BEST OF MY KNOWLEDGE. DATE <u>6-5-92</u>		<table border="1" style="width: 100%; border-collapse: collapse;"> <tr> <td style="width: 50%; padding: 5px;">DATE</td> <td style="width: 50%; padding: 5px;">REVISIONS</td> </tr> <tr> <td style="width: 50%; padding: 5px;"> </td> <td style="width: 50%; padding: 5px;">INITIALS</td> </tr> </table>		DATE	REVISIONS		INITIALS
		DATE	REVISIONS				
	INITIALS						
U. S. Department of Health & Human Services Public Health Service Indian Health Service							
 Design Engineer Maintenance Review Material Take-off		BEAVER, ALASKA MISC. DETAILS PUBLIC LAW 86-121 PROJECT PROJECT NO. AN-89-996 DRAWN BY: <u>DCG TM</u> DATE: <u>12-22-90</u> CHECKED BY: _____ DATE: _____ SANITATION FACILITIES CONSTRUCTION BRANCH ENVIRONMENTAL HEALTH BRANCH ALASKA AREA HEALTH SERVICE ANCHORAGE, ALASKA					
 STEVEN MANN REGISTERED PROFESSIONAL ENGINEER STATE OF ALASKA LICENSE NO. CE 8279 MECHANICAL ENGINEERING		SHEET NO. <u>M-3</u> OF <u>17</u> TOTAL SHEETS					

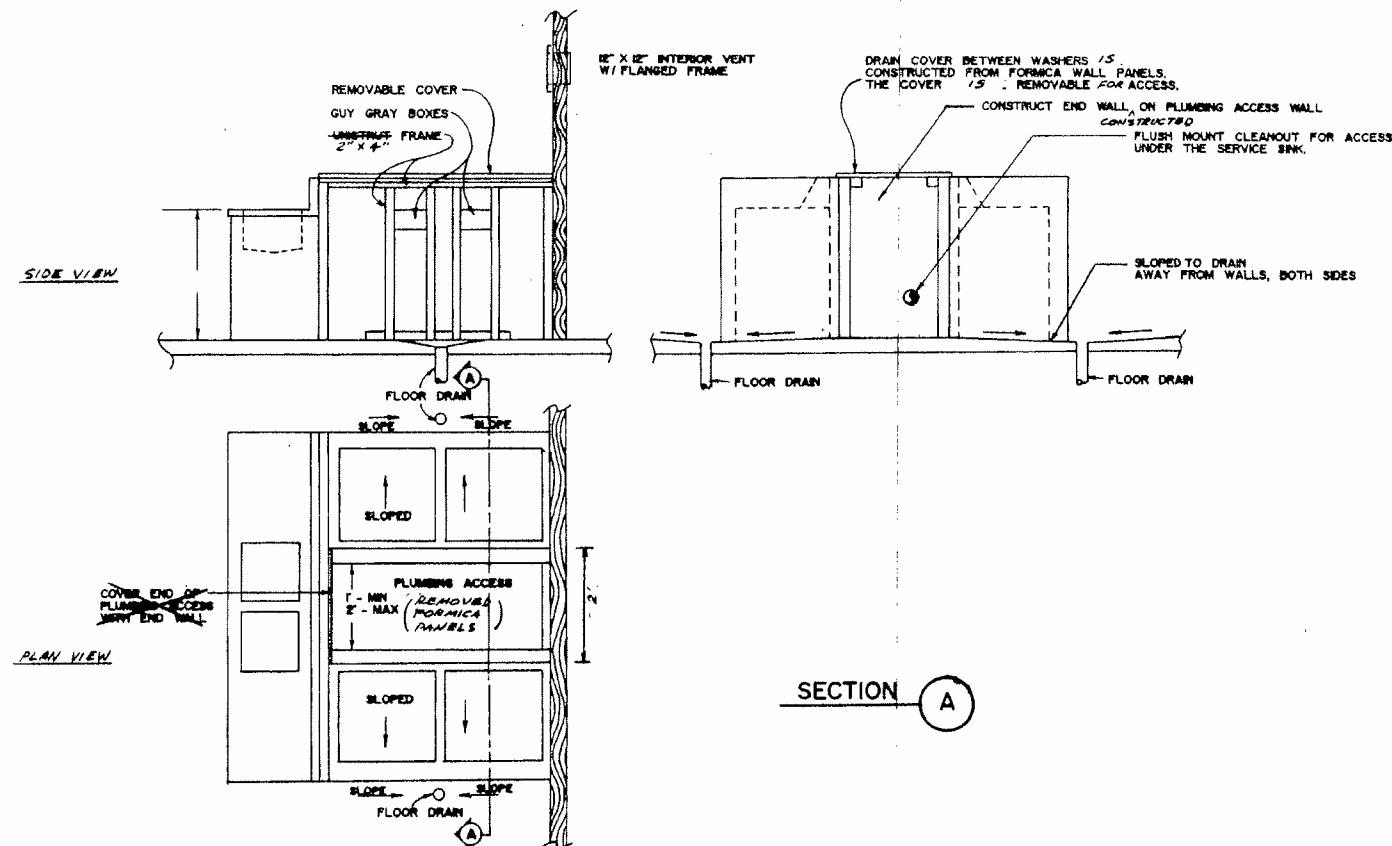


1 WASHER PLUMBING WALL WITH SINK
NOT TO SCALE

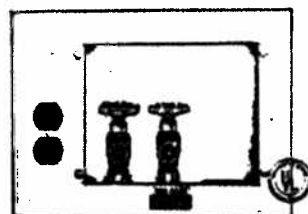

Model No. 100-000 for 2\"/>

3 GUY GRAY BOX 4 EA.

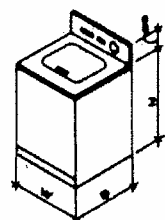

FRONT VIEW - TOP ON
FRONT VIEW - BOTTOM


ITEM	DESCRIPTION
1	1 - 12\"/>

4 WASHER DIMENSIONS


SECTION A

NOTES: (U INDICATES WORK COMPLETED)

1. DWV PLUMBING SINK SLOPES 1/4\"/>

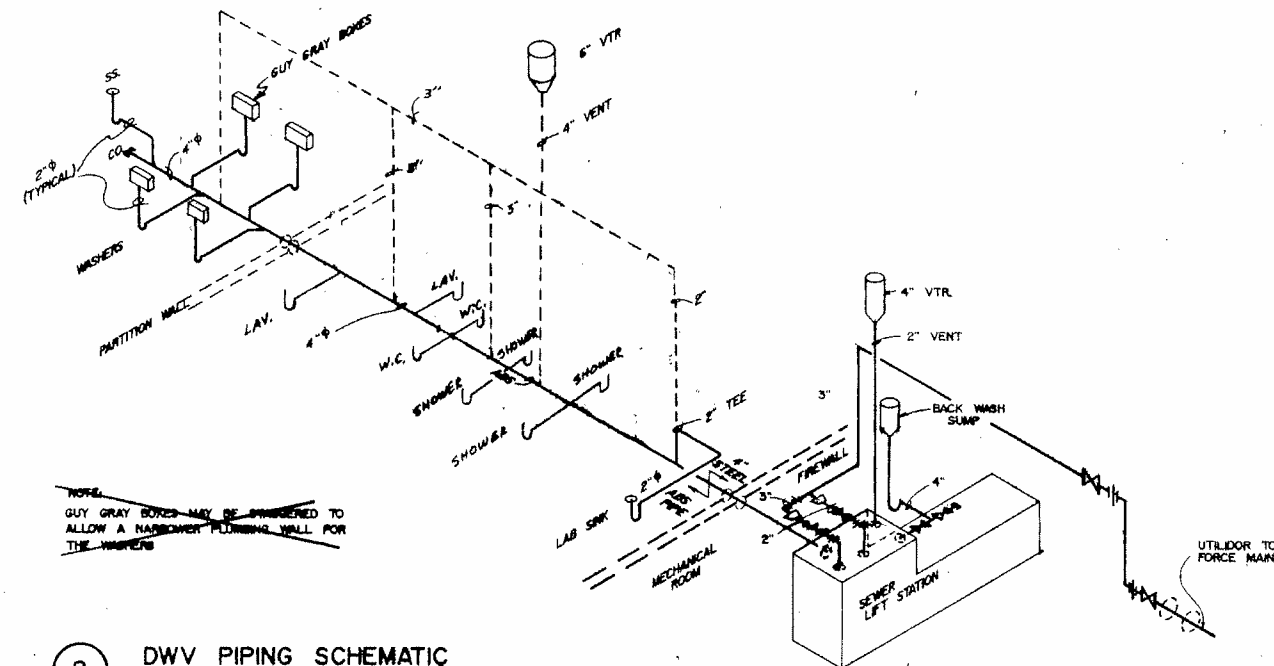

2 DWV PIPING SCHEMATIC
NOT TO SCALE

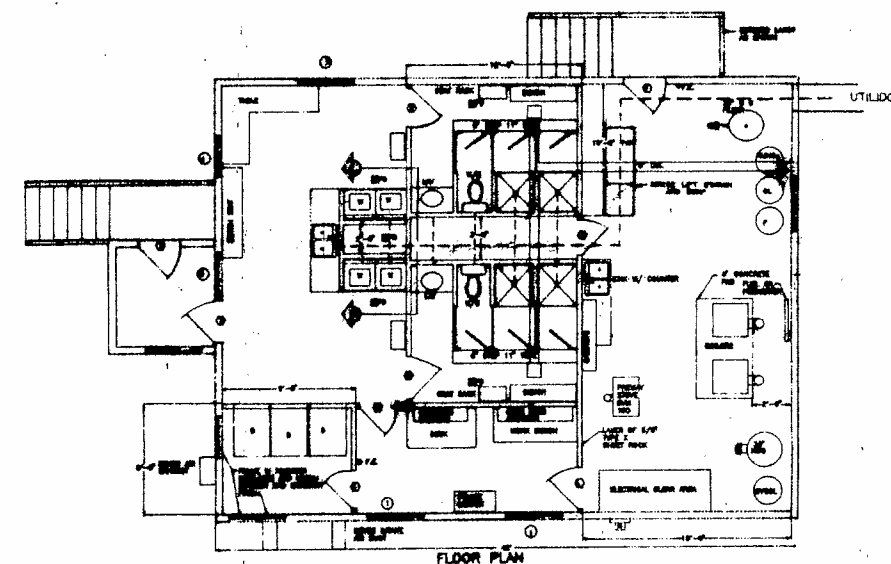

5 DWV PIPING LAYOUT
NOT TO SCALE

NOTE: SEE SHEETS 1-1 & 1-2 FOR AS-BUILT CHANGES TO FLOOR PLAN

RECORD DRAWINGS		
	THESE DRAWINGS REFLECT RECORDED INFORMATION OBTAINED DURING CONSTRUCTION.	DATE
	INFORMATION PROVIDED HEREIN IS ACCURATE TO THE BEST OF MY KNOWLEDGE.	DATE

Design Engineer	
Maintenance Review	
Material Take-off	

10-24-91	RECORD DRAWING	J.C.
DATE	REVISIONS	INITIALS


U. S. Department of Health & Human Services
Public Health Service
Indian Health Service

BEAVER, ALASKA
DWV PLUMBING SCHEMATIC AND
WASHER PAD DETAILS
PUBLIC LAW 96-121 PROJECT
PROJECT NO. AN-89-996


SHEET NO.
M-4
OF
17
TOTAL SHEETS

DRAWN BY: J.M.
DATE: 2-90
CHECKED BY: DATE:


SANITATION FACILITIES CONSTRUCTION BRANCH
ENVIRONMENTAL HEALTH BRANCH
ALASKA AREA NATIVE HEALTH SERVICE
ANCHORAGE, ALASKA

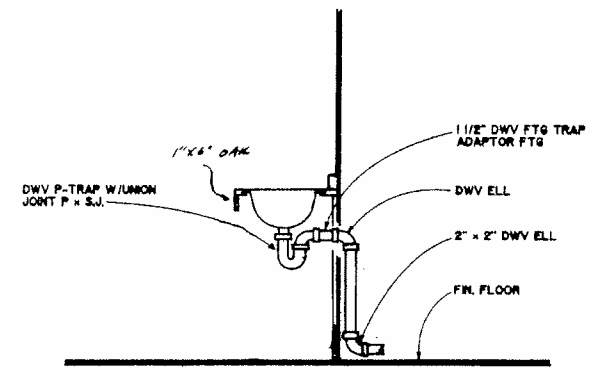


1 TYPICAL LAVATORIES
DWV PIPING
NTS

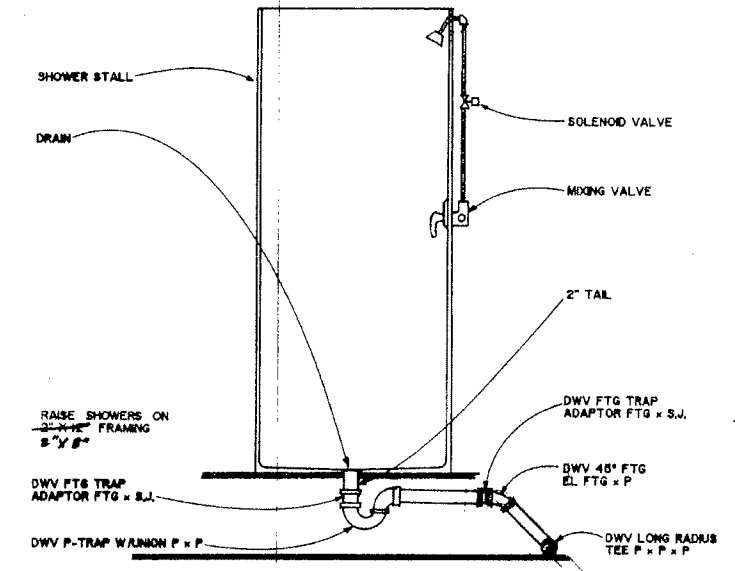


2 TYPICAL SHOWER CONNECTION
NTS

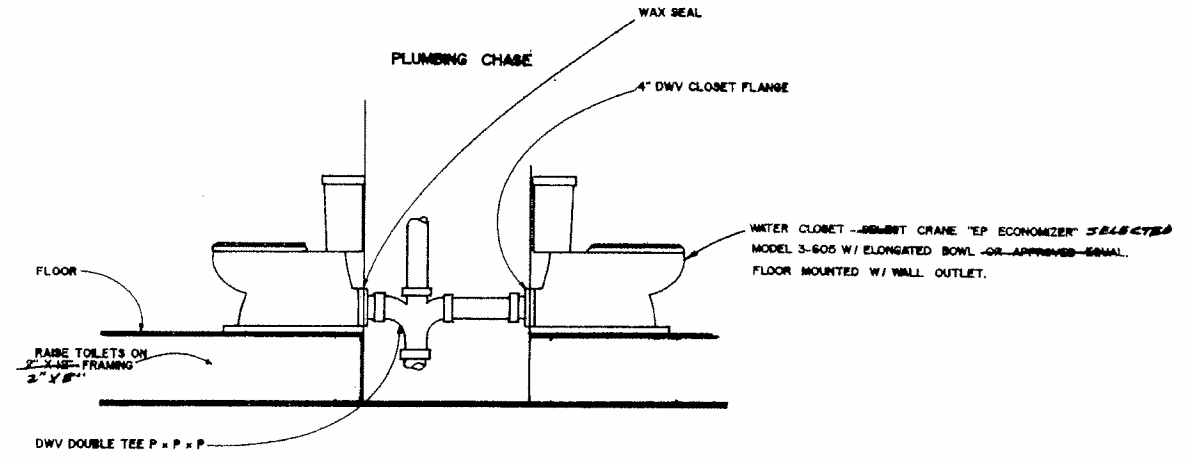


3 TYPICAL WATER CLOSET
NTS

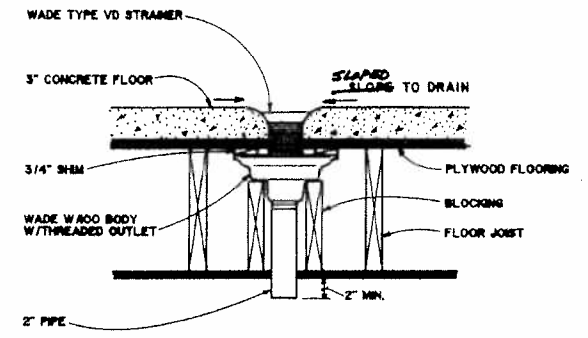


4 TYPICAL FLOOR DRAIN
NTS

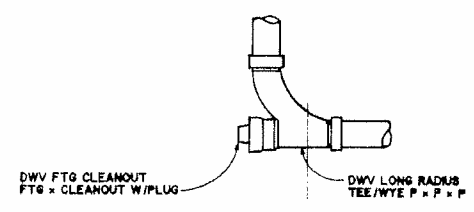


5 TYPICAL CLEANOUT
NTS

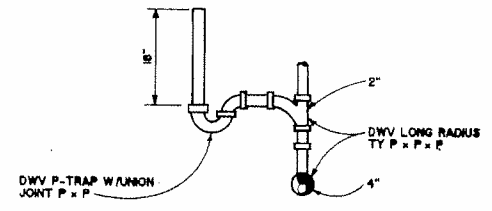

6 TYPICAL WASHER DRAIN
NTS

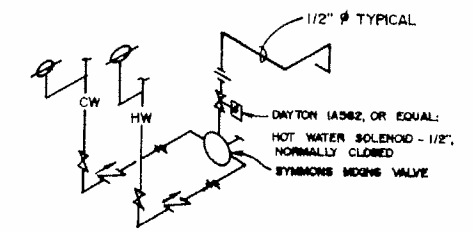

7 SHOWER PLUMBING DETAIL
NOT TO SCALE

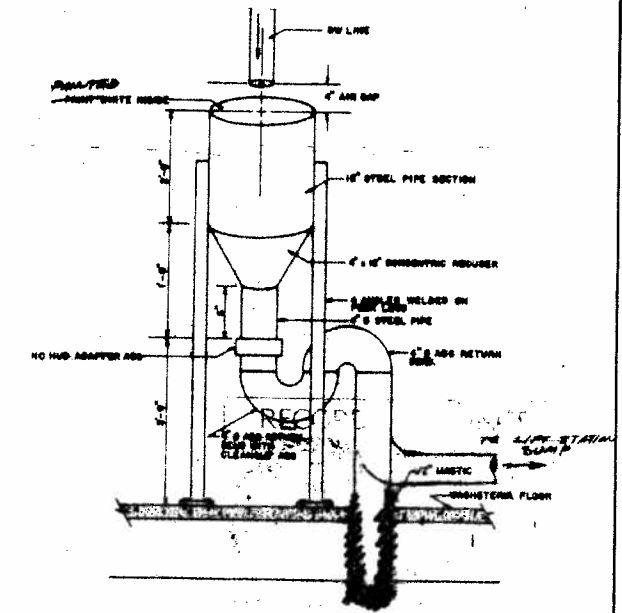

8 BACKWASH PUMP DETAIL
NOT TO SCALE

RECORD DRAWINGS

THESE DRAWINGS REFLECT RECORDED INFORMATION OBTAINED DURING CONSTRUCTION.

INFORMATION PROVIDED HEREIN IS ACCURATE TO THE BEST OF MY KNOWLEDGE.


NAME: *Don A. Moore* DATE: *12-3-91*

DESIGN ENGINEER: *Don A. Moore*

MAINTENANCE REVIEW: *Don A. Moore*


MATERIAL TAKE-OFF: *Don A. Moore*

12-3-91	RECORD DRAWING	J.C.
DATE	REVISIONS	INITIALS
U. S. Department of Health & Human Services Public Health Service Indian Health Service		
BEAVER, ALASKA MISC. PLUMBING DETAILS PUBLIC LAW 94-121 PROJECT PROJECT NO. AM-89-996		SHEET NO. M-5 OF 17 TOTAL SHEETS
DRAWN BY: DCG DATE: 1-3-90	CHECKED BY: <i>Don A. Moore</i> DATE: <i>12-3-91</i>	
SANITATION FACILITIES CONSTRUCTION BRANCH ENVIRONMENTAL HEALTH BRANCH ALASKA AREA NATIVE HEALTH SERVICE ANCHORAGE, ALASKA		


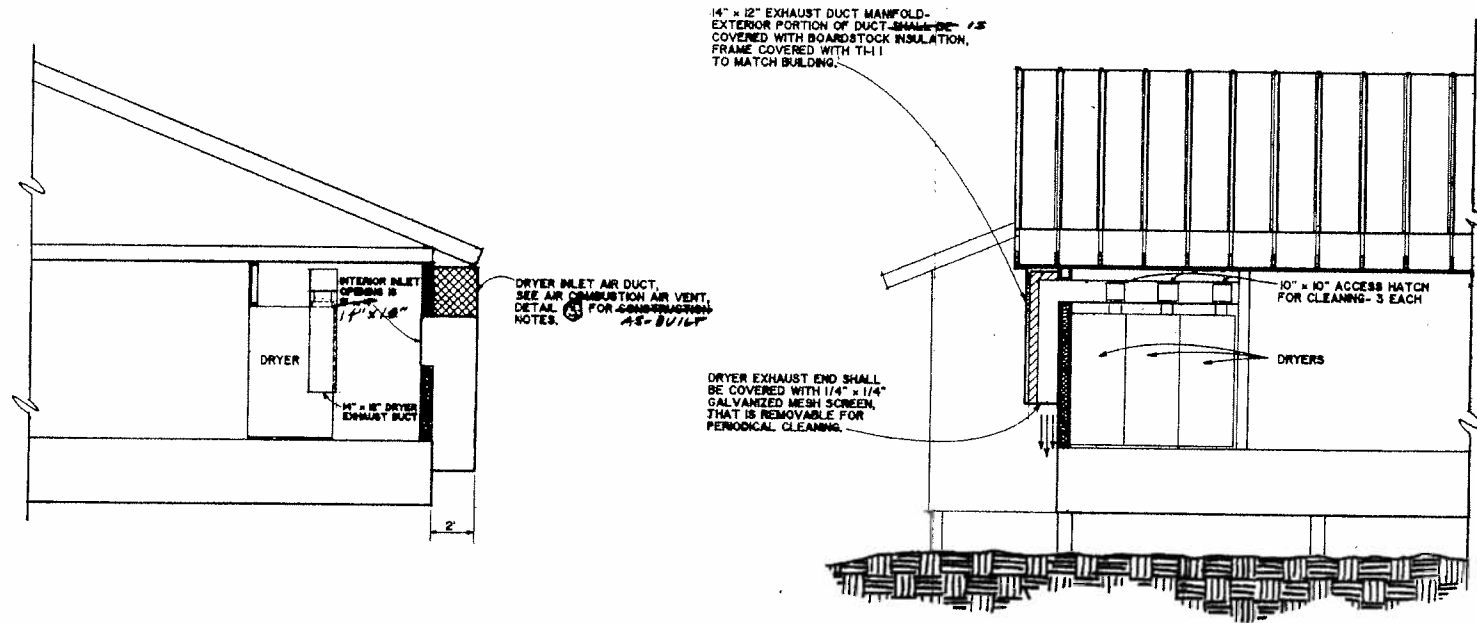


SECTION B-B
SCALE: 1/4" = 1'-0"

SECTION A-A
SCALE: 1/4" = 1'-0"

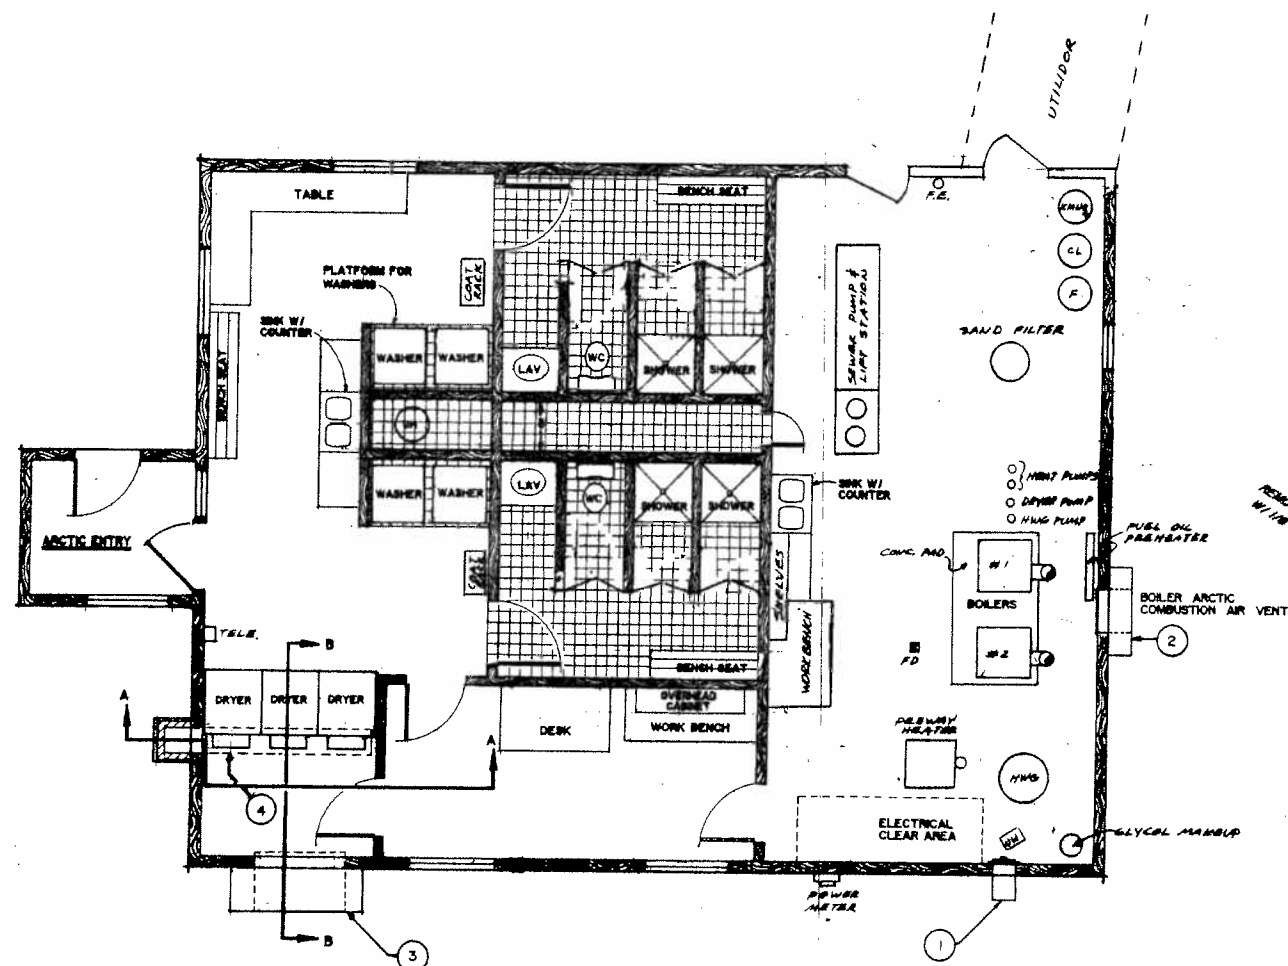

FLOOR PLAN
SCALE: 1/4" = 1'-0"

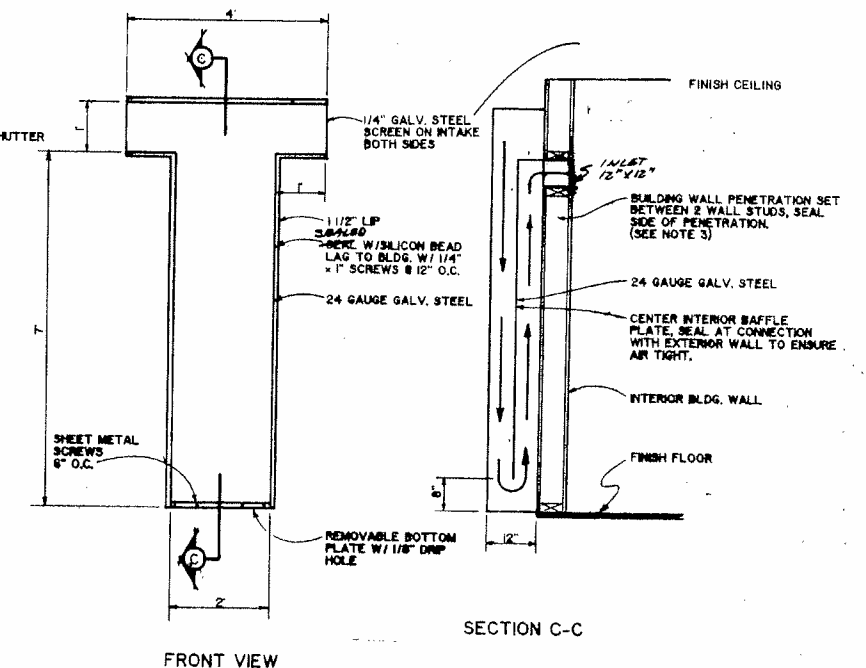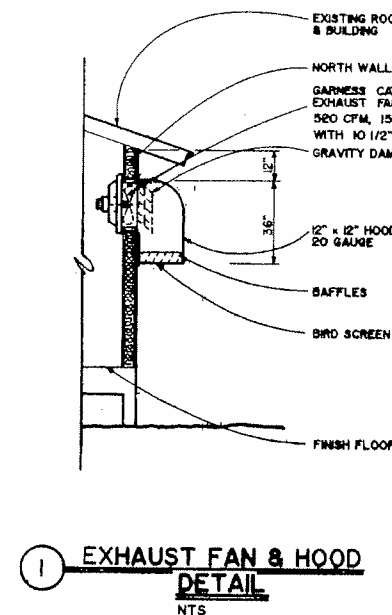


NOTES:

1. VENT RATED FOR 720,000 BTU/hr MAX.
2. APPLICABLE FOR APPLIANCES IN CONFINED SPACES (LESS THAN 80 CU. FT. PER 1000 BTU/hr AGGREGATE INPUT RATING OF ALL FUEL BURNING APPLIANCE) COMBUSTION AIR VENT COVER SHALL BE SIZED FOR A FREE AREA OF AT LEAST 1 SQUARE INCH PER 5000 BTU/hr OF TOTAL INPUT

OF ALL APPLIANCE IN THE ENCLOSURE UNLESS THE COMBUSTION VENT IS ENGINEERED AND A LESSER VALUE JUSTIFIED.


3. SIZE BUILDING PENETRATION FOR SPECIFIC REQUIREMENT. MAXIMUM ALLOWABLE SIZE 144 SQUARE INCHES.

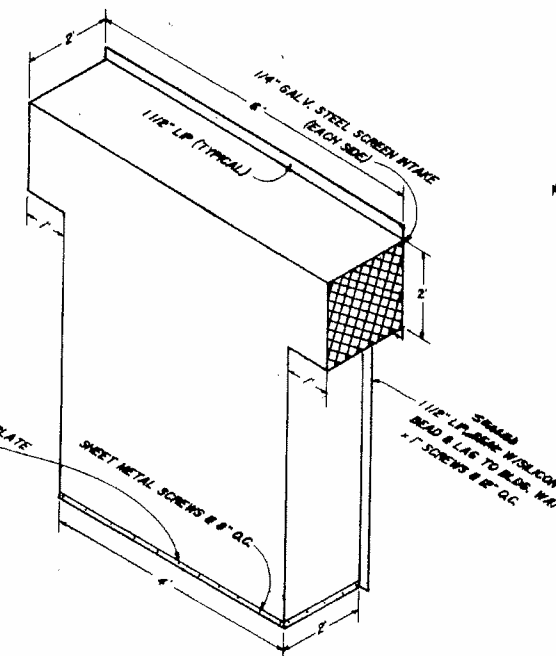


3 DRYER INLET AIR VENT
NTS

NOTES:

1. THE DRYER INLET AIR VENT IS CONSTRUCTED LIKE THE COMBUSTION AIR VENT.
2. INTERIOR OPENING TO HAVE 23 SQUARE FEET OF FREE UNRESTRICTED AREA. SELECT BACKDRAFT DAMPER WITH DIMENSIONS OF WIDTH 14\"/>

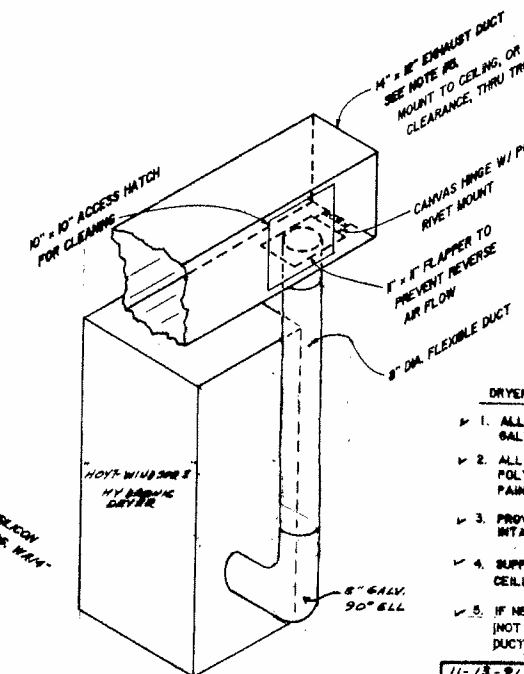

4 DRYER EXHAUST DUCT
NTS

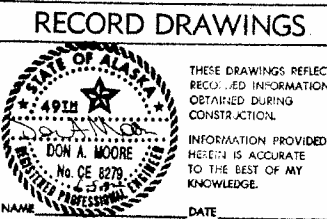

- DRYER EXHAUST DUCTS NOTES: (V = VENT, F = FAN, R = RETARDER)
1. ALL DUCTING SHALL BE FABRICATED USING 26 GAUGE GALVANIZED SHEET STEEL UNLESS NOTED OTHERWISE.
 2. ALL OUTSIDE DUCTING SHALL BE INSULATED WITH 2\"/>

DATE	REVISIONS	INITIALS
11-13-91	RECORDED DRAWING	J.C.





U. S. Department of Health & Human Services
Public Health Service
Indian Health Service

BEAVER, ALASKA
DRYER INTAKE/EXHAUST DUCT,
COMBUSTIBLE AIR DUCT AND
MECH. ROOM EXHAUST FAN DETAILS
PUBLIC LAW 96-121 PROJECT
PROJECT NO. AN-89-934


SHEET NO.
M-6
OF
17
TOTAL SHEETS

DRAWN BY: DGB
DATE: 1-10-90
CHECKED BY: [Signature]
DATE: [Blank]

SANITATION FACILITIES CONSTRUCTION BRANCH
ENVIRONMENTAL HEALTH BRANCH
ALASKA AREA NATIVE HEALTH SERVICE
ANCHORAGE, ALASKA

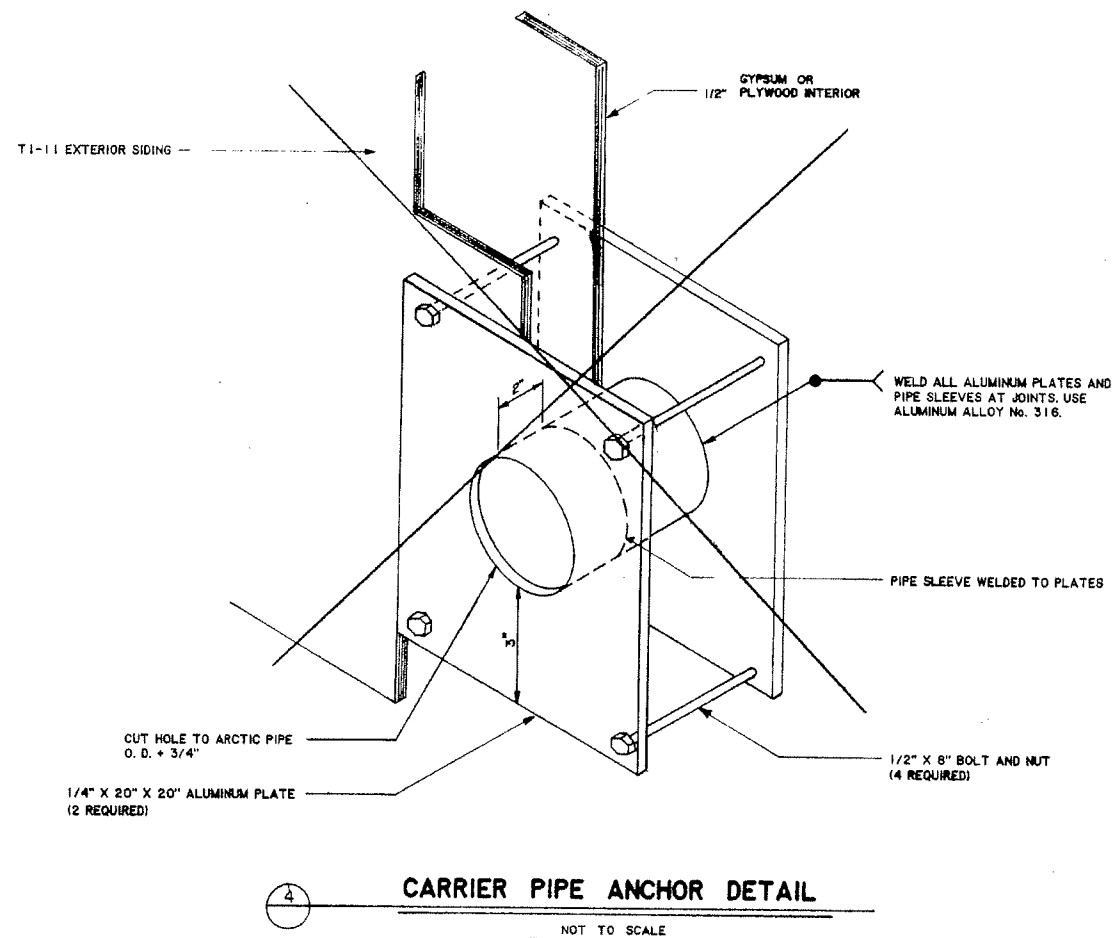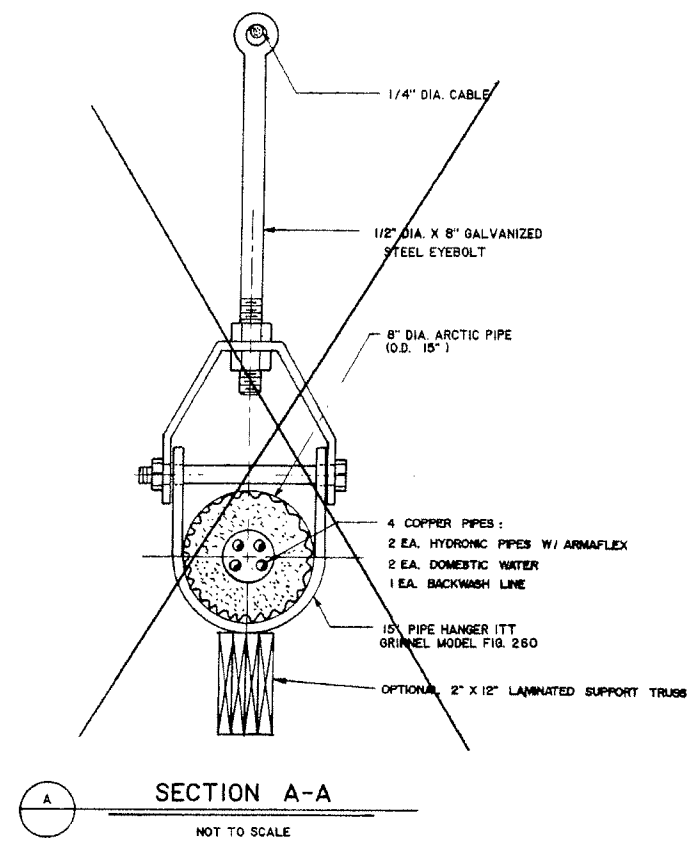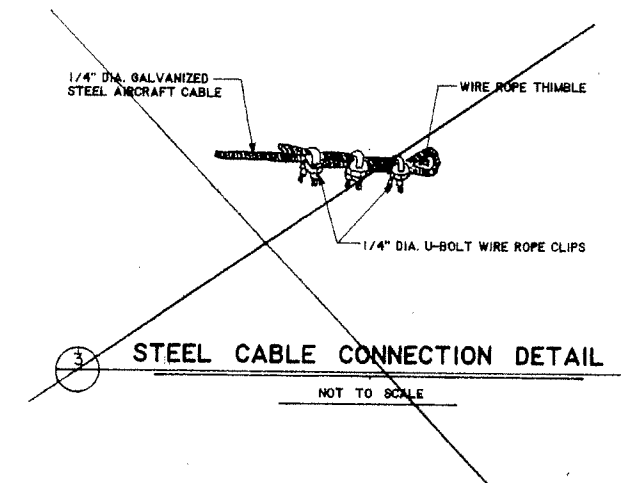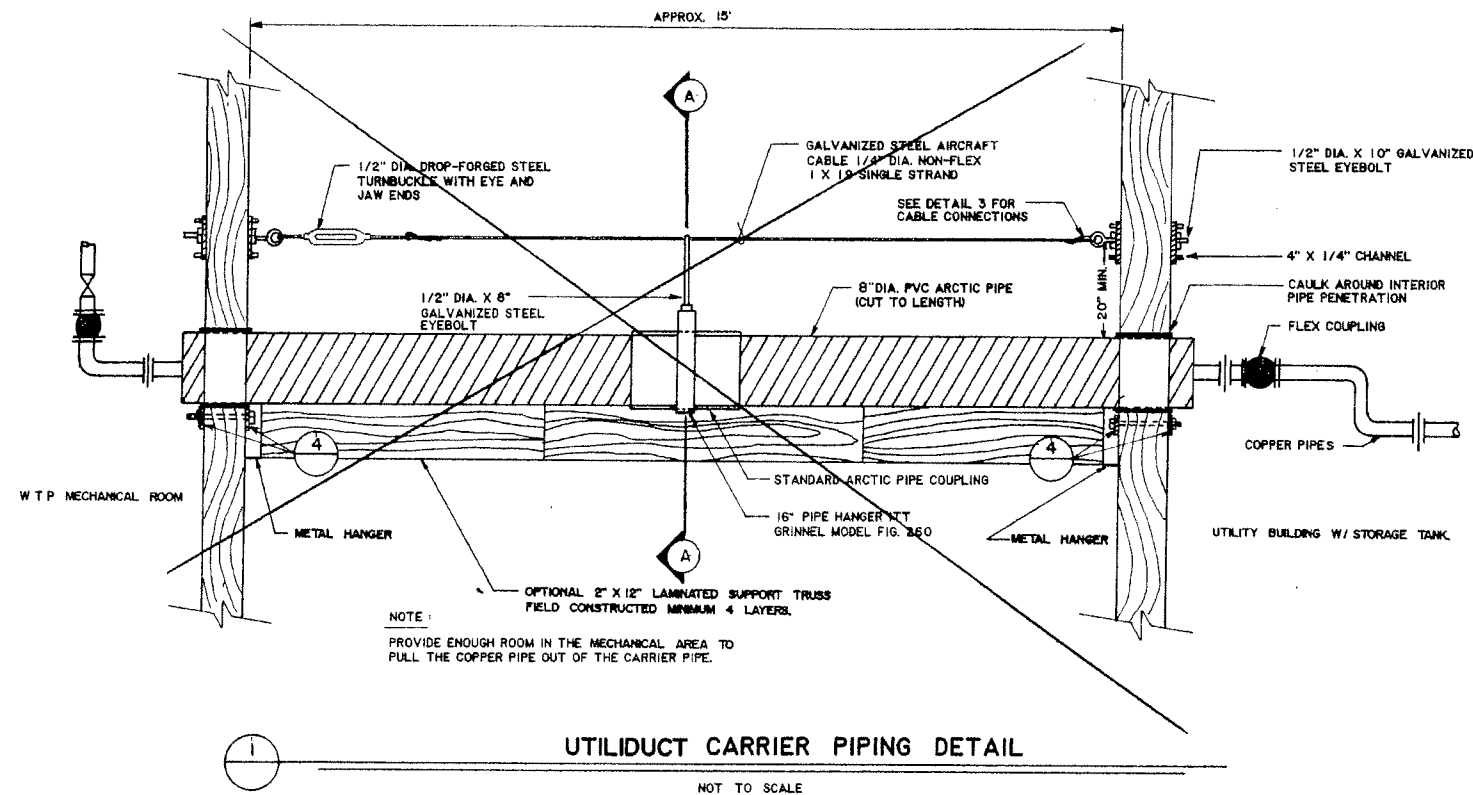

NOTE: DUE TO DESIGN CHANGES, THESE DETAILS WERE NOT USED.

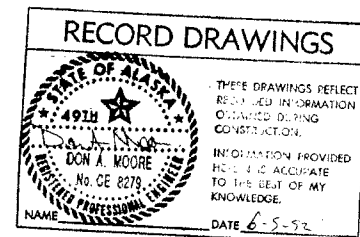



12-9-91	RECORD DRAWING	J.C.
DATE	REVISIONS	INITIALS
U. S. Department of Health & Human Services Public Health Service Indian Health Service		
BEAVER, ALASKA		SHEET NO. M-7
HYDRONICS UTILIDUCT DETAILS		OF 17
PUBLIC LAW 86-121 PROJECT		TOTAL SHEETS
PROJECT NO. AN-89-996		
DRAWN BY: TM	CHECKED BY:	
DATE: 2-90	DATE:	
SANITATION FACILITIES CONSTRUCTION BRANCH ENVIRONMENTAL HEALTH BRANCH ALASKA AREA NATIVE HEALTH SERVICE ANCHORAGE, ALASKA		

Design Engineer

Maintenance Review

Material Take-off

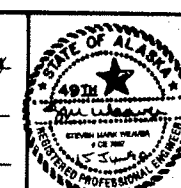


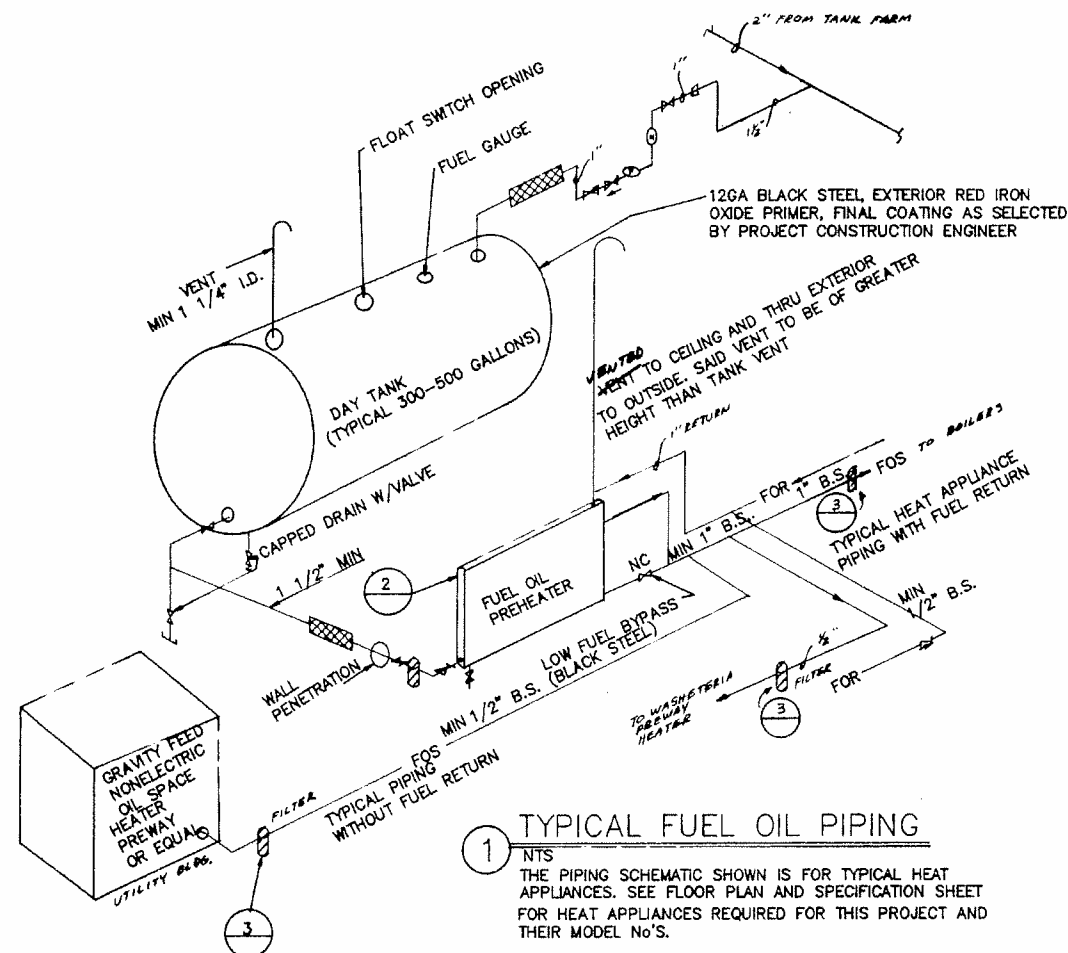

1 TYPICAL FUEL OIL PIPING
NTS
THE PIPING SCHEMATIC SHOWN IS FOR TYPICAL HEAT APPLIANCES. SEE FLOOR PLAN AND SPECIFICATION SHEET FOR HEAT APPLIANCES REQUIRED FOR THIS PROJECT AND THEIR MODEL NO'S.

FUEL STORAGE TANK NOTES: (U INDICATES WORK DONE)



1. IDENTIFY TANK WITH 3" HIGH x 1/2" STROKE LETTERS "DIESEL" AFTER APPLYING FINAL TANK COATING.
2. LOCATE DAY TANK A MINIMUM OF 5 FT FROM THE CLOSEST EXTERIOR BUILDING WALL (TO INCLUDE EAVES) AND 20 FT FROM ANY PROPERTY LINE ON WHICH STRUCTURES MAY BE BUILT.
3. A STORAGE TANK IN EXCESS OF 660 GALLONS OR MULTIPLE TANKS IN EXCESS OF 1320 GALLONS REQUIRE SECONDARY CONTAINMENT AND SPILL PREVENTION CONTROL AND COUNTER MEASURE PLAN CERTIFIED BY A REGISTERED PROFESSIONAL ENGINEER.
4. SLOPE FOUNDATION UNDER TANK TO ENSURE ANY SPILLED FUEL DOES NOT POND UNDER BUILDING.
5. IF BULK STORAGE CONNECTION NOT ALREADY METERED INSTALL TUTHILL FILL RITE DN. M/N 807A 1" OR EQUAL WITH TALLY AND TOTALIZER RESET (GRAVITY FLOW) PROVIDE ISOLATION VALVES AND UNIONS WITH INSTALLATION.
6. INVERT OUTLET ELEVATION OF DAY TANK SHOULD BE NOT LESS THAN THE ELEVATION OF THE PREHEATER FUEL RETURN LINE.
7. BULK FUEL STORAGE SUPPLY AND RETURN LINES MINIMUM 1-INCH DIA. USE SCH 80 PIPE WITH VICTAULIC COUPLINGS FOR BURIED LINES AND SCH 40 PIPE WITH THREADED COUPLINGS FOR ABOVE GRADE APPLICATIONS.

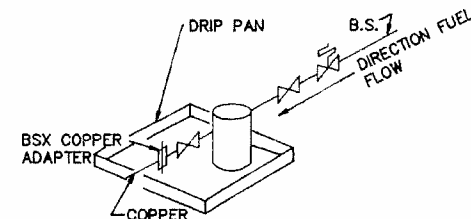

3 TYPICAL FUEL FILTER INSTALLATION
NTS

FUEL FILTER NOTES

1. WHEN AN EXTERIOR WALL PENETRATION IS MADE SET ISOLATION VALVE AS CLOSE TO INTERIOR WALL SURFACE AS POSSIBLE.
2. APPLIANCE FUEL FILTER INSTALLATION: USE GENERAL 1A25A OR EQUAL (TYP) AT EACH FUEL USING APPLIANCE.
3. DAY TANK FUEL FILTER INSTALLATION: USE GOLDENROD #496 FUEL FILTER W/496-5 ELEMENT OR EQUAL.
4. PROVIDE DRIP PANS UNDER ALL FUEL FILTER INSTALLATIONS.

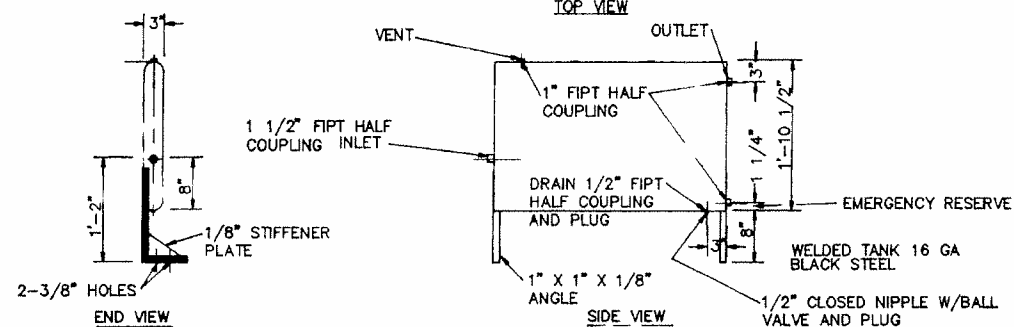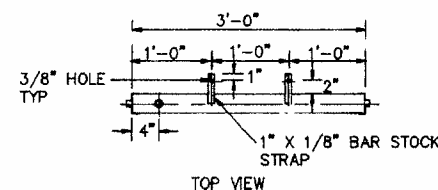

2 FUEL OIL PRE-HEATER
NTS

NOTE: THIS DRAWING WAS DEVELOPED AS A STANDARD DETAIL FOR AANHS SANITATION FACILITIES CONSTRUCTION PROGRAM PROJECT SPECIFIC MODIFICATIONS SHALL BE HIGHLIGHTED AND ARE THE RESPONSIBILITY OF THE PROJECT DESIGN ENGINEER.


NOTES ON FUEL PIPING (U INDICATES WORK DONE)

1. FUEL FILTERS SHALL BE LOCATED PRIOR TO EACH FUEL USING UNIT AND SHALL ALL BE THE SAME TYPE AND SIZE.
2. ISOLATION VALVES ARE REQUIRED ON EACH SIDE OF FILTER.
3. B.S. PIPE SHALL BE RUN TO EACH FUEL FILTER.
4. FIRE ISOLATION VALVES ARE REQUIRED PRIOR TO EACH FUEL FILTER.
5. FIRE ISOLATION VALVES ARE NOT TO BE USED AS GATE VALVES.
6. FIRE ISOLATION VALVES ARE NOT REQUIRED ON FUEL RETURN LINES WHEN THEY RETURN TO THE PRE-HEATER.
7. SOFT COPPER TUBING SHALL BE USED TO BRING THE FUEL OIL INTO AND OUT OF THE HEAT APPLIANCE.
8. VIBRATION LOOPS IN COPPER ARE NOT REQUIRED. IF INSTALLED THEY SHALL BE A SINGLE LOOP IN A HORIZONTAL ORIENTATION TO PREVENT AIR TRAPS.
9. ONLY THE STANDARD FUEL OIL PRE-HEATER SHOWN SHALL BE USED.
10. IF A SUCTION LIFT EXISTS IN THE FUEL SYSTEM, A FUEL SUCTION GAUGE WITH SHUT OFF SHALL BE INSTALLED ON THE FUEL OIL SUPPLY PORT OF THE FUEL PUMP.
11. THE DAY TANK INSTALLATION IS MADE WITH B.S. PIPE ONLY. NO COPPER FITTINGS OR PIPING IS REQUIRED.

SCOPE OF WORK THIS PROJECT

1. ABANDON EXISTING FUEL SUPPLY & RETURN LINES, AND WOODEN ENCLOSURES.
2. ELEVATE FUEL TANK ON METAL STAND.
3. REINSTALL FUEL TRANSFER PUMP IN MECHANICAL ROOM.
4. INSTALL FUEL LEVEL FLOAT SWITCHES TO CONTROL FUEL TRANSFER PUMP.
5. ROUTE FUEL SUPPLY LINES TO BOTH THE MECHANICAL ROOM & THE UTILITY BUILDING.

RECORD DRAWINGS

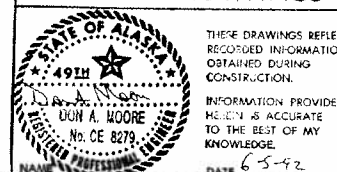

11-12-91	RECORD DRAWING	J-C
DATE	REVISIONS	INITIALS

U. S. Department of Health & Human Services
Public Health Service
Indian Health Service

BEAVER, ALASKA

TYPICAL FUEL OIL PIPING.
PUBLIC LAW 86-121 PROJECT
PROJECT NO.

SHEET NO.
M-8
OF
17
TOTAL SHEETS

DRAWN BY: JAO
DATE: 2-90


CHECKED BY:
DATE:


SANITATION FACILITIES CONSTRUCTION BRANCH
ENVIRONMENTAL HEALTH BRANCH
ALASKA AREA NATIVE HEALTH SERVICE
ANCHORAGE, ALASKA

Design Engineer

Maintenance Review


Material Take-off

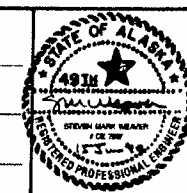

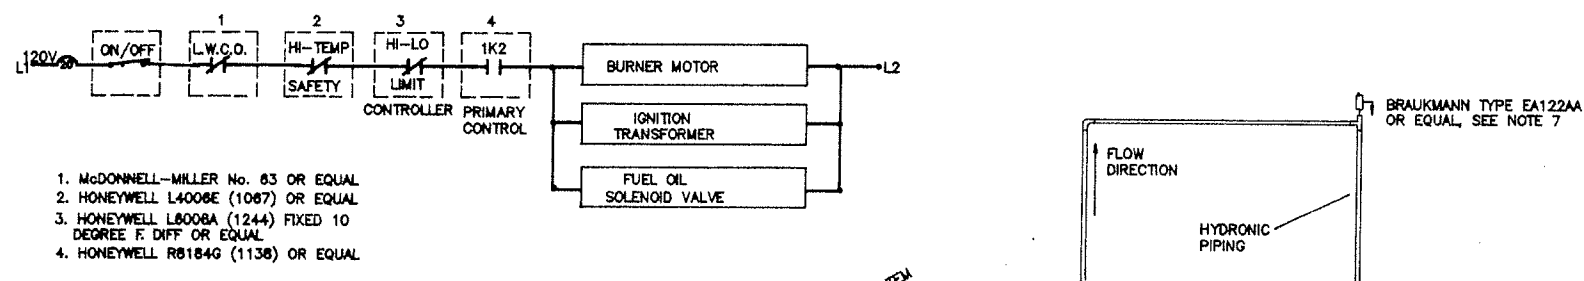

- McDONNELL-MILLER No. 83 OR EQUAL
- HONEYWELL L4008E (1087) OR EQUAL
- HONEYWELL L8008A (1244) FIXED 10 DEGREE F. DIFF OR EQUAL
- HONEYWELL R8184G (1138) OR EQUAL

5 TYPICAL BOILER CONTROL COMPONENTS SCHEMATIC LAYOUT
NTS

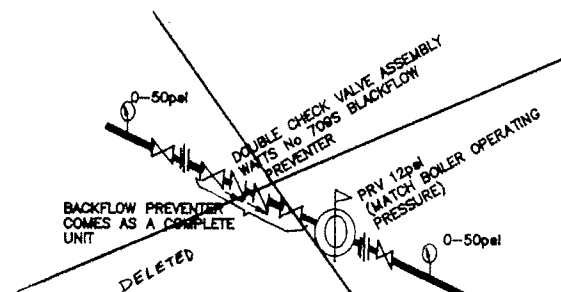

2 TYPICAL WATER SYSTEM/HYDRONICS SYSTEM INTERFACE
NTS

- NOTES:
- PROVIDE GLYCOL HYDROMETER FOR OPERATOR.
 - THE OPERATING PRESSURE FOR THE POTABLE WATER SUPPLY SHOULD BE GREATER THAN THAT OF THE HYDRONICS SYSTEM


BOILER OPERATING CHARACTERISTICS

- STACK TEMP 400 TO 550 DEGREE F
- OIL PRESSURE 100 psi UNLESS OTHERWISE SPECIFIED BY BURNER MANUFACTURER
- SMOKE DOT: 0-1
- STACK DRAFT: .02-.04" WATER COLUMN
- H₂O OVERFIRE DRAFT: 0.01-0.02" WATER COLUMN UNLESS OTHERWISE SPECIFIED BY BOILER MANUFACTURER
- 12-20 psi BOILER OPERATING PRESSURE
- 160 TO 190 DEGREE OPERATING TEMP

TEST KITS REQUIRED PROVIDED
BACHARACH KIT #10-5022 OR EQUAL

SPARE PARTS TO BE PROVIDED FOR EACH TYPE BOILER/BURNER INSTALLATION

- ONE EACH COMPLETE BURNER UNIT
- ELECTRODE ASSEMBLY 1 EACH
- IGNITION TRANSFORMER, 1 EACH
- CAD CELL FLAME DETECTION WITH HONEYWELL R8184G PRIMARY CONTROL OR EQUAL
- FUEL PUMP, 1 EACH
- HI-TEMPERATURE SAFETY CONTROL WITH MANUAL RESET HONEYWELL L4008E OR EQUAL
- HI-LO OPERATING CONTROLLER, HONEYWELL L8008A (1244) WITH 10 DEGREE FIXED OPERATING DIFFERENTIAL OR EQUAL

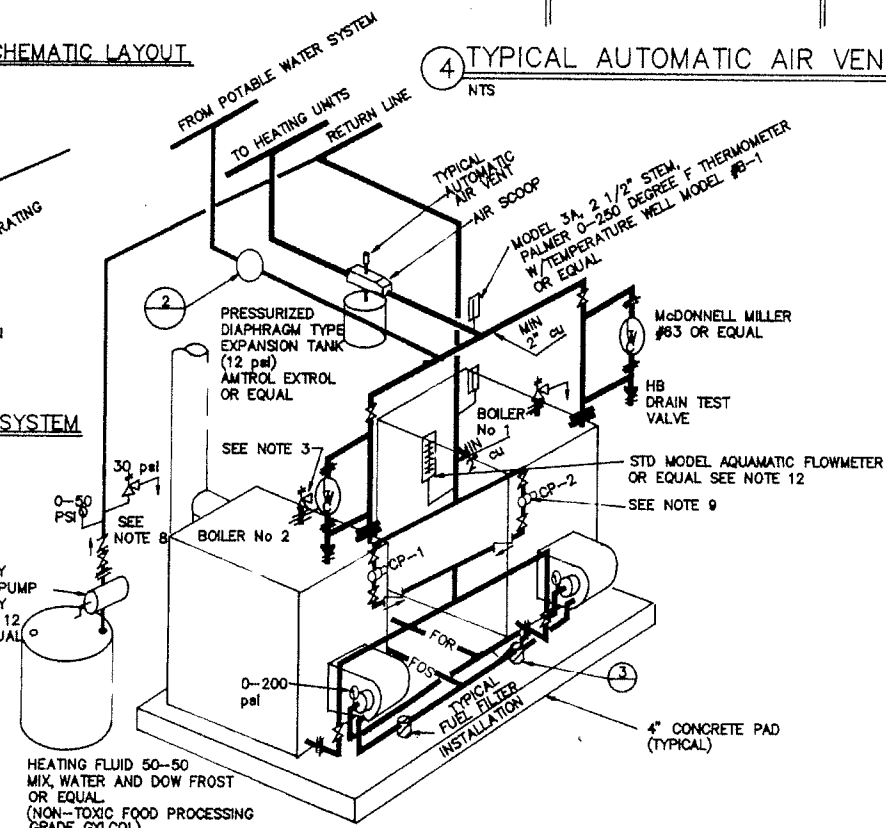

1 TYPICAL BOILER PIPING
NTS


FIRE EXTINGUISHER REQUIREMENTS (V INDICATES ITEM COMPLETED)

- SET PORTABLE FIRE EXTINGUISHERS PER REQUIREMENTS OF CHAPTER 10, 1988 NATIONAL FIRE CODE. WASHETERIA PUBLIC ROOMS ARE CONSIDERED A "LIGHT HAZARD" WITH CLASS A COMBUSTIBLES. WATER TREATMENT PLANTS OR MECHANICAL ROOMS ARE AN "ORDINARY HAZARD" WITH CLASS A COMBUSTIBLES AND CLASS B FLAMMABLES.
- USE 5-6 POUNDS PORTABLE FIRE EXTINGUISHERS IN LIGHT HAZARD AND ORDINARY HAZARD LOCATIONS. AMEREX MODEL No. 443, UL RATING 3-A40BC OR APPROVED EQUAL WITH MULTIPURPOSE ABC DRY CHEMICAL (NONAMONIUM PHOSPHATE) POWDER. INSTALL THE UNIT(S) IN ACCESSIBLE AREAS (MAX STRAIGHT WALKING DIST. = 70') OR AS REQUIRED BY FIRE MARSHAL. IN ANY CASE, PROVIDE A MINIMUM OF 2 UNITS IN EACH TREATMENT PLANT OR WASHETERIA.
- IN ADDITION, USE AUTOMATIC FIRE EXTINGUISHERS IN ORDINARY HAZARD LOCATIONS. AD-X FIRE SYSTEMS, INC. MODEL No. 103-20 SQ FOOT COVERAGE OR APPROVED EQUAL WITH MULTIPURPOSE ABC DRY CHEMICAL POWDER. INSTALL ONE UNIT OVER EACH HEAT APPLIANCE BURNER. SET BETWEEN 3 FEET AND 7.5 FEET ABOVE THE BURNER.

4 TYPICAL AUTOMATIC AIR VENT
NTS

NOTES ON BOILER PIPING (V INDICATES ITEM COMPLETED)

- HYDRONIC PIPING SHOWN IS FOR REPRESENTATION OF REQUIRED FITTINGS ONLY. ACTUAL LOCATION OF TAPS WILL VARY BY BOILER MANUFACTURER.
- BOILERS SHALL BE PLUMBED IN PARALLEL.
- BOILER HOT WATER SAFETY RELIEF VALVES SHALL BE RATED FOR 30 psi. A RIGID PIPE WITH THREADED CONNECTIONS SHALL BE ATTACHED TO BRING THE BLOW-OFF DISCHARGE WITHIN 6 INCHES OF THE FLOOR.
- THE EXPANSION TANK SHALL BE INDIVIDUALLY SIZED FOR EACH HYDRONIC SYSTEM, BASED ON OPERATING TEMPERATURES, VOLUME OF SYSTEM, AND TANK MANUFACTURER'S RECOMMENDATIONS.
- DIELECTRIC JOINTS SHALL BE MADE BY ISOLATION KITS (NIPPLES AND NOT UNIONS) AT ALL CONNECTIONS OF DISSIMILAR METALS.
- MINIMUM CLEARANCE REQUIRED BY UNIFORM CODE IS 18 INCHES ON ALL SIDES. FOR REAR EXIT BOILERS A REAR CLEARANCE OF 36 INCHES IS REQUIRED TO MAINTAIN ADEQUATE SEPARATION BETWEEN STACK AND WALL. FOR EASY O&M ACCESS 24-INCHES BETWEEN BOILERS, 36-INCHES SIDE CLEARANCE AND 48-INCHES FRONT CLEARANCE IS RECOMMENDED. THESE DISTANCES ARE AS MEASURED FROM THE BOILER BOX. ALLOWANCE FOR PROTRUDING PIPING AND APPURTENANCES ARE INCORPORATED INTO THE RECOMMENDED VALUES.
- INSTALL AUTOMATIC AIR VENT AT DOWNSTREAM END OF ANY HYDRONICS PIPING HIGH POINT. INSTALL AN ISOLATION BALL VALVE WITH EACH VENT IF NOT PART AN INTEGRAL PART OF THE VENT ASSEMBLY (HONEYWELL BRAUKMANN TYPE EA122AA)
- A HEATING FLUID ADD LINE 30 psi RELIEF VALVE IS ONLY REQUIRED WHEN MIX VAT IS LOCATED OUT OF SIGHT OF BOILER RELIEF VALVES. WHEN UTILIZED, POSITION HEATING FLUID ADD LINE 30 psi RELIEF VALVE AND ATTACH HOSE SUCH THAT ANY DISCHARGE DRAINS INTO GLYCOL MIXING VAT
- CIRCULATION PUMPS ARE TYPICALLY PLUMBED IN PARALLEL ON THE RETURN LINE AT AN ELEVATION BELOW THE LOW WATER CUTOFF. PUMPS ARE SHOWN IN A TYPICAL CONFIGURATION. SEE HYDRONICS SCHEMATIC FOR LOCATION.
- PROVIDE 2 EACH 10' WASHER HOSES FOR DRAINING SYSTEMS AND GENERAL HOUSEKEEPING.
- PROVIDE PETCOCK TYPE ISOLATION VALVE ON ALL PRESSURE GAUGES.
- PROVIDE THE STANDARD MODEL FLOW CELL FLOWMETER WITH NEOPRENE "O" RINGS AND METAL STRAINER CAP RATED FOR OPERATION TO A MAXIMUM 194 DEGREE F. PROVIDE THE "K" TYPE NICKEL PLATED BRASS "CHECKMATE" ISOLATION VALVE RATED FOR OPERATION TO A MAXIMUM 194 DEGREE F. SIZE THE METER PER MANUFACTURER'S RECOMMENDATION. IF BOILER OPERATION IN EXCESS OF 190 DEGREE F IS DESIRED PROVIDE TEFLON "O" RINGS TO BRING MAXIMUM TEMPERATURE RATING TO 302 DEGREES F.
- CALIBRATE ALL THERMOMETERS IN BOILING WATER PRIOR TO INSTALLATION.

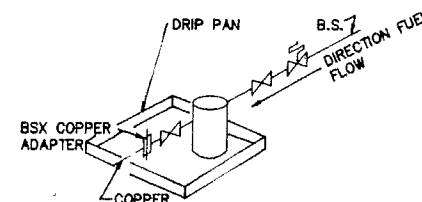

3 TYPICAL FUEL FILTER INSTALLATION
NTS

FUEL FILTER NOTES

- APPLIANCE FUEL FILTER INSTALLATION: USE GENERAL 1A25A OR EQUAL (TYP) AT EACH FUEL USING APPLIANCE.
- PROVIDE DRAIN PANS UNDER ALL FUEL FILTER INSTALLATIONS.

NOTE: THIS DRAWING WAS DEVELOPED AS A STANDARD DETAIL FOR AANHS SANITATION FACILITIES CONSTRUCTION PROGRAM PROJECT SPECIFIC MODIFICATIONS SHALL BE HIGHLIGHTED AND ARE THE RESPONSIBILITY OF THE PROJECT DESIGN ENGINEER.

12-9-91	RECORD DRAWING	J.C.
DATE	REVISIONS	INITIALS


U. S. Department of Health & Human Services
Public Health Service
Indian Health Service

BEAVER, ALASKA
TYPICAL BOILER PIPING
PUBLIC LAW 86-121 PROJECT
PROJECT NO.

SHEET NO.
M-9
OF
17
TOTAL SHEETS


DRAWN BY: JAQ
DATE: 2-90
CHECKED BY:
DATE:

SANITATION FACILITIES CONSTRUCTION BRANCH
ENVIRONMENTAL HEALTH BRANCH
ALASKA AREA NATIVE HEALTH SERVICE
ANCHORAGE, ALASKA

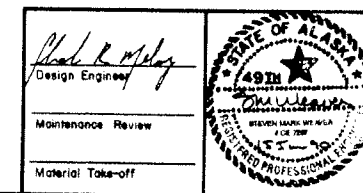

GENERAL METAL CHIMNEY NOTES: (V=ITEMS COMPLETED)


- ✓ 1. ALL CHIMNEYS SHALL BE SINGLE WALL STAINLESS STEEL TO A POINT NOT HIGHER THAN 4 FEET ABOVE THE APPLIANCE ABOVE THAT POINT. ALL CHIMNEYS SHALL BE STAINLESS STEEL, DOUBLE WALL INSULATED PIPE. IN ANY CASE, DOUBLE WALL PIPE IS REQUIRED FOR ANY WALL/CEILING PENETRATION.
- ✓ 2. INDIVIDUAL CHIMNEYS SHALL BE PROVIDED FOR APPLIANCES PROVIDING BUILDING/SYSTEM HEAT.
- ✓ 3. MANIFOLDED CHIMNEYS ARE ALLOWABLE FOR HEAT APPLIANCES UTILIZED FOR OTHER THAN BUILDING HEAT (e.g. DRYERS, HOT WATER GENERATOR, ETC) NOT MORE THAN THREE APPLIANCES OF SIMILAR TYPE AND CAPACITY MAY BE CONNECTED TO ONE CHIMNEY.
- ✓ 4. EACH CHIMNEY SHALL BE PROPERLY SIZED FOR NATURAL DRAFT BASED ON THE AVERAGE YEARLY TEMPERATURE (SEE WEIL-MOLAN ENGINEER'S REFERENCE OR EQUIVALENT DOCUMENT FOR SIZING PROCEDURE.)
- ✓ 5. EACH STACK OR VENT SHALL HAVE A STACK THERMOMETER MOUNTED 12-INCHES ABOVE THE BREECH AND 6-INCHES BELOW THE BAROMETRIC DAMPER IN PLAN VIEW, THE RANGE ON THE THERMOMETER SHALL BE 200 DEGREES F TO 1200 DEGREES F.
- ✓ 6. EACH STACK SHALL HAVE A BAROMETRIC DRAFT CORRECTOR FOR NATURAL DRAFT.
- ✓ 7. FOR NEW INSTALLATIONS REAR BREECH BOILER UNITS SHALL BE UTILIZED WHEN EVER POSSIBLE. FOR SAID INSTALLATION EACH STACK SHALL HAVE A "TEE" INSTALLED AT THE BREECH TO PREVENT RAIN WATER FROM ENTERING THE COMBUSTION CHAMBER AND FOR EASE OF STACK CLEANING.
- ✓ 8. IN BUILDING INTERIORS, METAL CHIMNEYS 18-INCHES IN DIAMETER OR LESS SHALL HAVE A MINIMUM CLEARANCE OF 18-INCHES FROM COMBUSTIBLE MATERIAL AND 2 INCHES FROM NONCOMBUSTIBLE MATERIAL.
- ✓ 9. THIS STANDARD DETAIL BASED ON CHAPTERS 5 AND 9 OF 1985 UNIFORM MECHANICAL CODE (UMC) FOR SINGLE STORY BUILDING WITH LOW HEAT APPLIANCES.

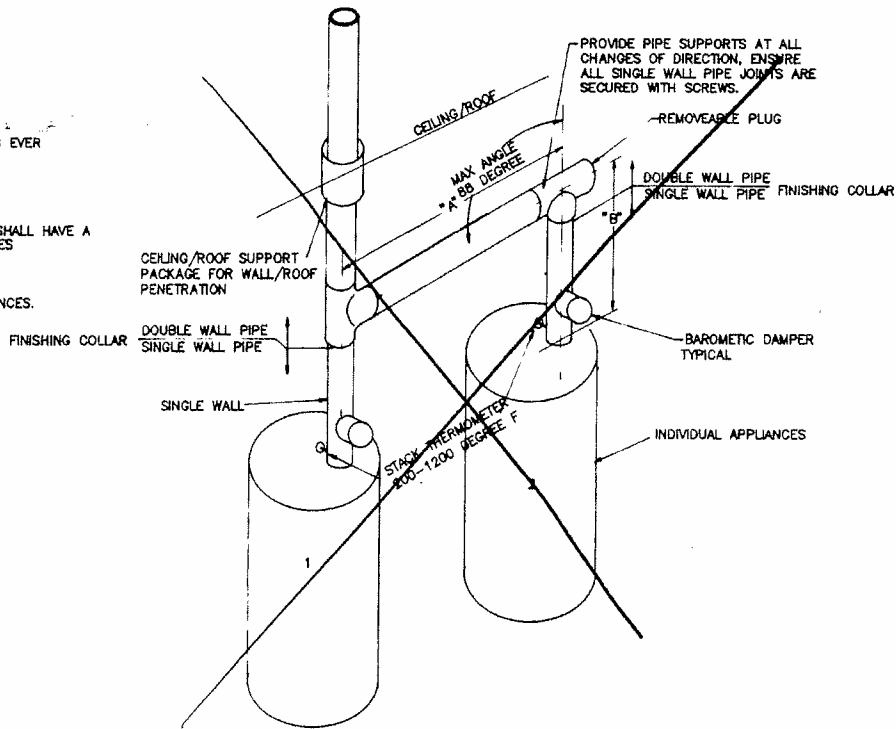

MULTIPLE HEATING UNIT (V=ITEMS COMPLETED)

- NTS
- ✓ 1. WHEN 2 OR MORE APPLIANCES UTILIZE A COMMON EXHAUST STACK, EACH APPLIANCE INLET SHALL BE OFFSET IN SUCH A MANNER THAT NO PORTION OF ANY OUTLET IS OPPOSITE OTHER INLET.
 - ✓ 2. WHERE 2 OR MORE APPLIANCES ARE CONNECTED INTO A COMMON EXHAUST STACK, THE STACK CROSS SECTIONAL AREA SHALL BE NOT LESS THAN THE AREA OF THE LARGEST INDIVIDUAL APPLIANCE STACK CONNECTOR PLUS 50 PERCENT OF THE AREA OF ADDITIONAL APPLIANCE STACK CONNECTORS.
 - ✓ 3. EACH INDIVIDUAL APPLIANCE STACK SHALL HAVE THE GREATEST POSSIBLE RISE CONSISTENT WITH THE HEAD ROOM AVAILABLE BETWEEN THE BAROMETRIC DAMPER AND THE POINT OF CONNECTION TO A MANIFOLD OR COMMON CHIMNEY.
 - ✓ 4. ALL VENT STACKS SHALL HAVE A CONTINUOUS RISE, MINIMUM ALLOWABLE RISE 1/4 INCH PER FOOT.
 - ✓ 5. HORIZONTAL DISTANCE ("A") SHALL BE LESS THAN 75 PERCENT OF THE TOTAL VERTICAL HEIGHT OF THE CONNECTOR VENT ("B"). ANY ANGLE FROM VERTICAL GREATER THAN 45 DEGREES IS CONSIDERED HORIZONTAL. THE MINIMUM RECOMMENDED VALUE FOR "B" IS 5 FEET.
 - ✓ 6. "TYPICAL HEATING UNIT STACK INSTALLATION" DETAIL NOTES ALSO APPLY TO THIS DETAIL.

NOTE: THIS DRAWING WAS DEVELOPED AS A STANDARD DETAIL FOR AANHS SANITATION FACILITIES CONSTRUCTION PROGRAM PROJECT SPECIFIC MODIFICATIONS SHALL BE HIGHLIGHTED AND ARE THE RESPONSIBILITY OF THE PROJECT DESIGN ENGINEER.

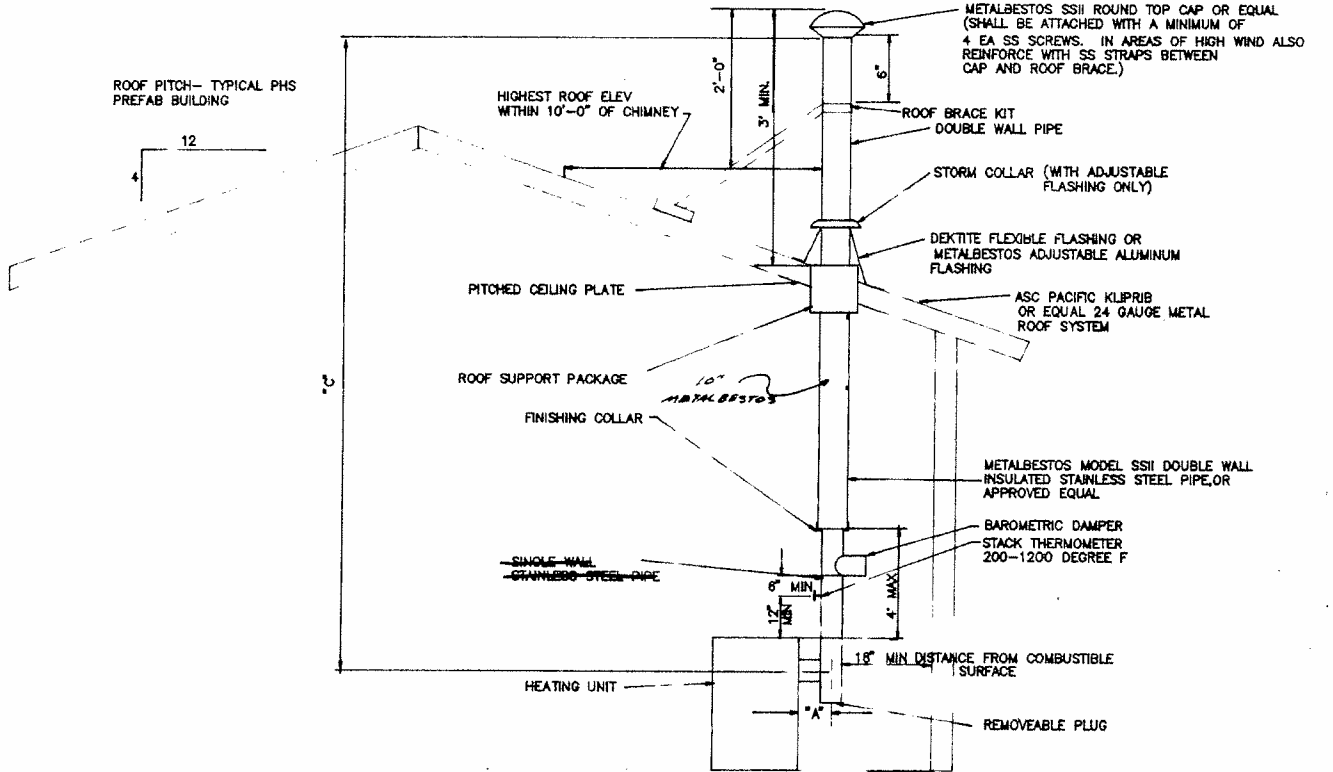


TYPICAL HEATING UNIT STACK INSTALLATION

NTS (V=ITEMS COMPLETED)

NOTES:


- ✓ 1. OVERALL CHIMNEY HEIGHT IS BASED ON APPLIANCE DRAFT REQUIREMENTS. HOWEVER THE CHIMNEY SHOULD EXTEND AT LEAST 3 FEET ABOVE THE POINT WHERE IT PASSES THROUGH THE ROOF OF THE BUILDING AND AT LEAST 2' HIGHER THAN ANY PORTION OF THE BUILDING WITHIN 10'.
- ✓ 2. SWITCH FROM SINGLE TO DOUBLE WALL PIPE PRIOR TO ANY WALL/CEILING PENETRATION.
- ✓ 3. FOR COLD ROOF PENETRATION INSTALL INSULATION SHIELD AND OFFSET CEILING SUPPORT PACKAGE IN LIEU OF ROOF SUPPORT PACKAGE.
- ✓ 4. WHERE A METAL CHIMNEY PASSES THROUGH A ROOF CONSTRUCTED OF COMBUSTIBLE MATERIAL, IT SHALL BE GUARDED BY A VENTILATING THIMBLE OF GALVANIZED STEEL OR APPROVED CORROSION-RESISTANT METAL EXTENDING NOT LESS THAN 9 INCHES ABOVE THE ROOF CONSTRUCTION, AND OF A SIZE TO PROVIDE NOT LESS THAN 6 INCHES CLEARANCE ON ALL SIDES OF THE CHIMNEY.
- ✓ 5. WHERE POSSIBLE SET APPLIANCE NEAR/AT BUILDING RIDGELINE TO MAXIMIZE LENGTH OF CHIMNEY HEATED SPACE.
- ✓ 6. THE RATIO OF "A"/"C" SHOULD ALWAYS BE LESS THAN 0.4 WHERE "A" IS THE LENGTH OF UNINSULATED HORIZONTAL CONNECTOR, ANY ANGLE FROM VERTICAL GREATER THAN 45 DEGREES IS CONSIDERED HORIZONTAL.
- ✓ 7. WHEN AN 18 INCH SEPARATION BETWEEN AND A COMBUSTIBLE SURFACE CANNOT BE MET, PIPING CAN BE SET AS CLOSE AS 9-INCHES FROM A COMBUSTIBLE SURFACE WHEN SAID SURFACES ARE COVERED WITH A 22 GAUGE (0.027) STEEL SHEET SPACED OUT 1-INCH FROM COMBUSTIBLE SURFACE WITH SAID SPACERS MADE OF NON COMBUSTIBLE MATERIAL. STEEL SHEET TO BE PLACED TO ALLOW NATURAL FLOW OF CIRCULATING AIR BETWEEN THE WALL AND THE SHEET WITH SAID AIR ENTERING AT THE BOTTOM AND EXITING AT THE TOP OF THE SHEET. COMBUSTIBLE SURFACES TO BE COVERED, AS A MINIMUM IN ALL AREAS WITHIN 18-INCHES OF THE SINGLE WALL PIPE. SEE TABLE 5-B, UMC FOR OTHER INSTALLATION OPTIONS.


RECORD DRAWINGS

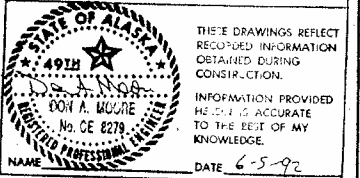


DATE	REVISIONS	INITIALS
12-2-91	RECORD DRAWING	J.E.

U. S. Department of Health & Human Services Public Health Service Indian Health Service	
BEAVER, ALASKA	
HEATING UNIT STACK INSTALLATION PUBLIC LAW 86-121 PROJECT	
PROJECT NO.	
DRAWN BY: JAQ DATE: 2-90	CHECKED BY: DATE:
SANITATION FACILITIES CONSTRUCTION BRANCH ENVIRONMENTAL HEALTH BRANCH ALASKA AREA NATIVE HEALTH SERVICE ANCHORAGE, ALASKA	

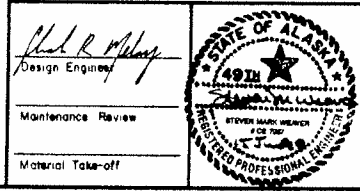


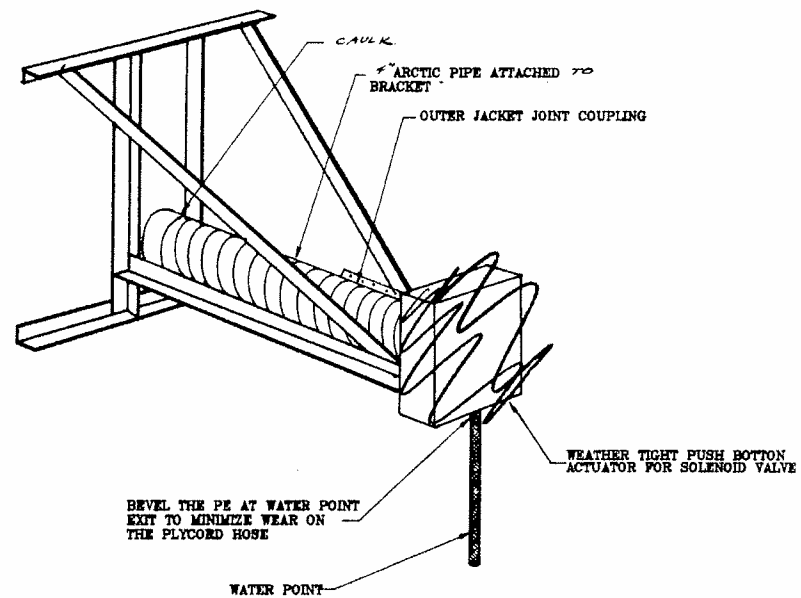


1 WATER POINT INSTALLATION DETAIL
NTS

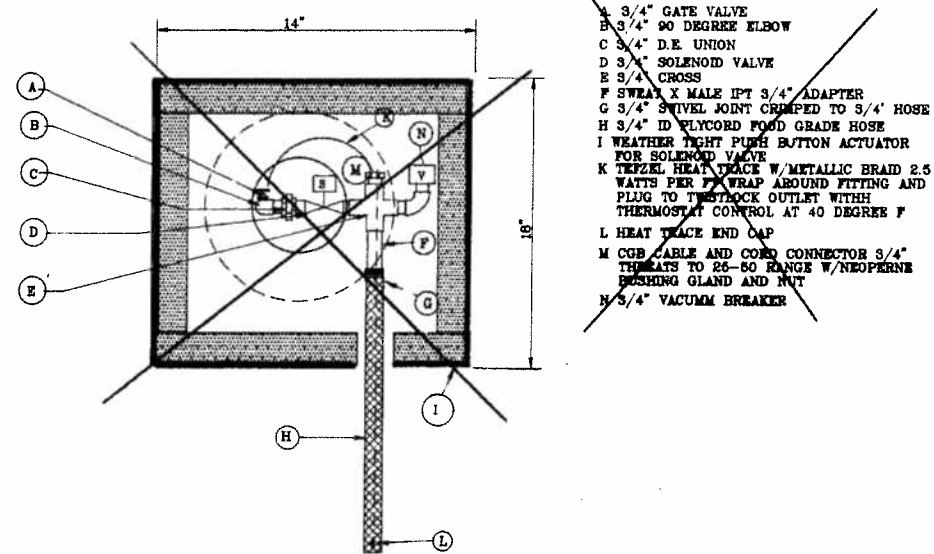

2 WATER POINT HEAD DETAIL
NTS

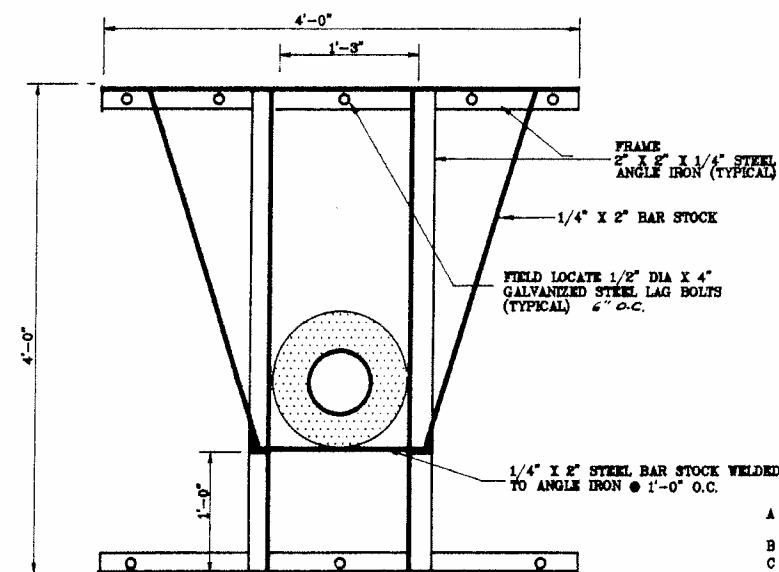

3 WATER POINT BRACKET DETAIL
NTS

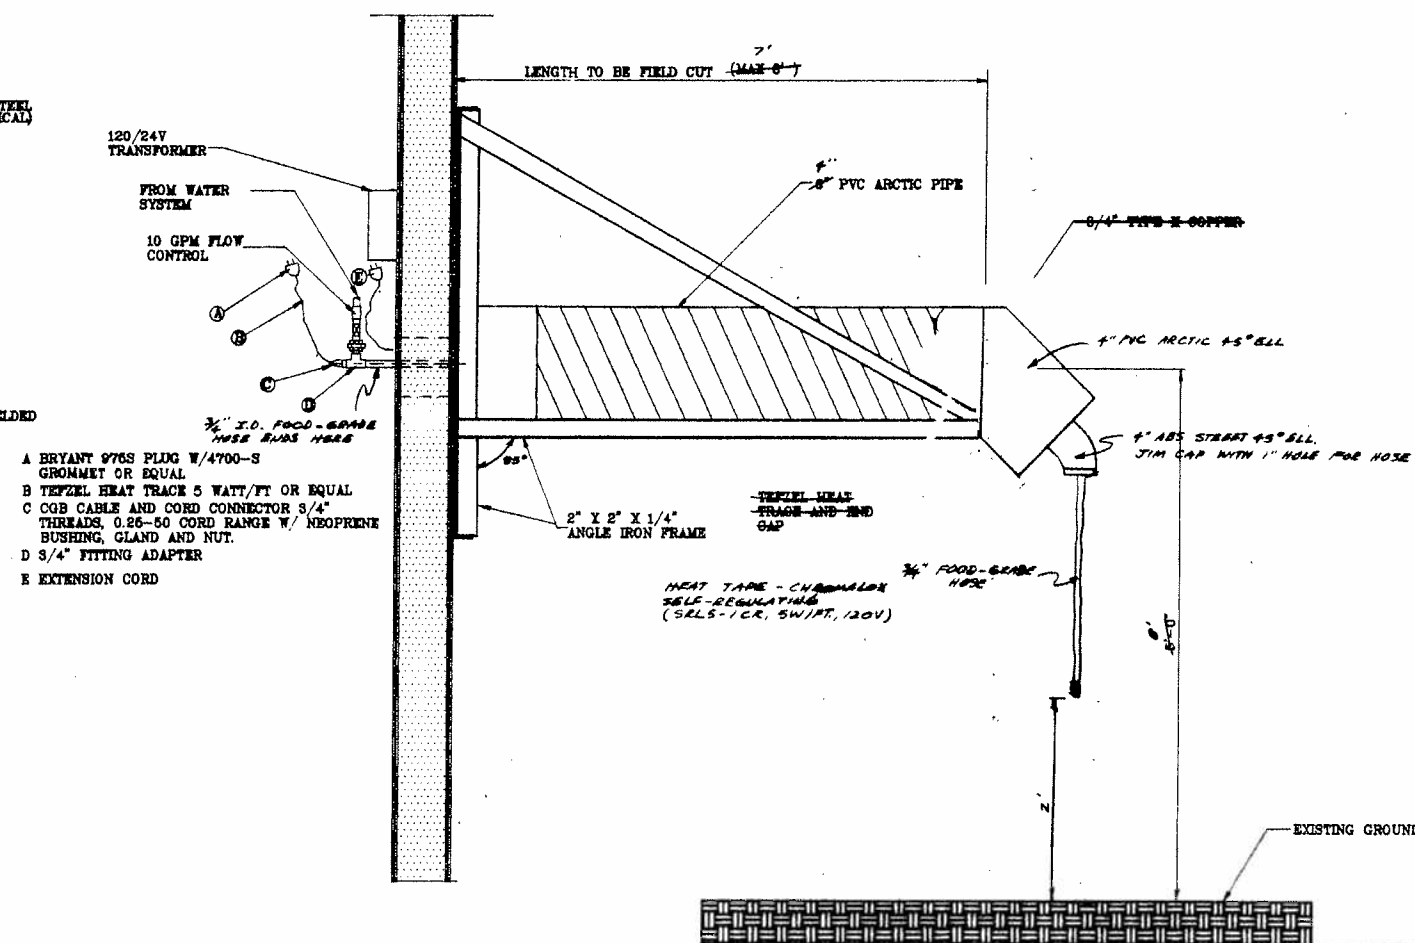

4 WATER POINT SIDE VIEW
NTS



RECORD DRAWINGS		
THESE DRAWINGS REFLECT REVISIONS BY EXAMINATION OF THE DRAWING INFORMATION PROVIDED BY THE ARCHITECT TO THE BEST OF MY KNOWLEDGE. NAME: _____ DATE: 6-5-92		

DATE	REVISIONS	INITIALS
10-23-91	RECORD DRAWING	J.C.

U. S. Department of Health & Human Services Public Health Service Indian Health Service	
BEAVER, ALASKA	SHEET NO. M-II
WATERING POINT DETAILS	OF 17
PUBLIC LAW 94-121 PROJECT	TOTAL SHEETS
PROJECT NO. AN-89-996	

DRAWN BY: JAG	CHECKED BY:
DATE: 9/87	DATE:

SANITATION FACILITIES CONSTRUCTION BRANCH ENVIRONMENTAL HEALTH BRANCH ALASKA AREA NATIVE HEALTH SERVICE ANCHORAGE, ALASKA	
--	--


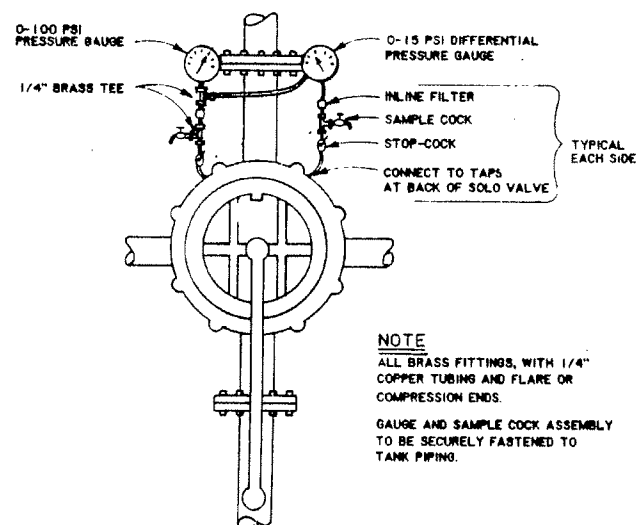
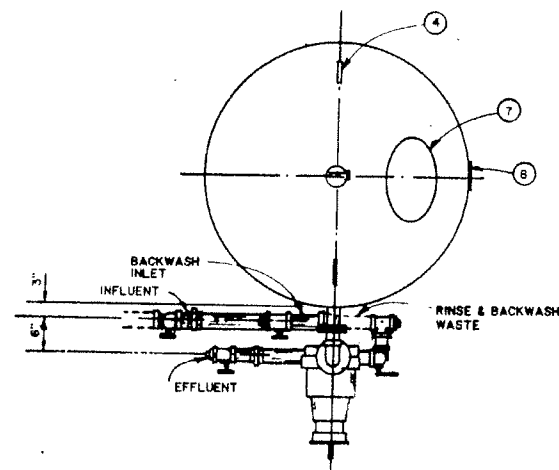


NOTES:

- INTERIOR SURFACES- SANDBLASTED TO "NEAR WHITE" AND COATED WITH 2-PART HIGH SOLIDS EPOXY, 2 COATS, 4-6 MIL EA., 10 MIL MINIMUM TOTAL.
- EXTERIOR SURFACES- SANDBLASTED TO "NEAR WHITE" AND COATED WITH ONE COAT OF RUST-INHIBITIVE INORGANIC ZINC PRIMER, 2.0 MIL MINIMUM THICKNESS.
- FRONT PIPING- SCHEDULE 40 GALVANIZED STEEL, WITH 150 PSI THREADED GALVANIZED MALLEABLE FITTINGS IN SIZES 3" AND SMALLER, AND 125 PSI FLANGES FOR 4" AND LARGER.
- DASH LINE PIPING BY OTHERS.

ITEM No.	DESCRIPTION
1	FILTER TANK- 100 psi ASME CODE - STAMPED
2	MULTI-PORT VALVE- AQUAMATIC SOLO VALVE, PER SPECS.
3	GATE VALVE- 125 LB. BRONZE NRS, 3 EACH
4	LIFTING LUGS- 2 EACH
5	PRESSURE GAUGE/SAMPLE COCK ASSEMBLY (PER DETAILS & SPECS)
6	AIR RELEASE VALVE, VAL-MATIC #15 OR EQUAL
7	11"X15" MANHOLE
8	4"X8" MANHOLE
9	BALLCENTRIC VALVE- BACKWASH WASTE CONTROL, 1 EACH


SUPPLY CONTRACT SCHEDULE					
VILLAGE		BEAVER			
No. OF FILTERS		1			
FILTER DIAMETER		30"			
SIDE WALL HT.		60"			
PIPE AND VALVE SIZE		2 1/2"			
SOLO VALVE SERIES		105 DR			
TOP FIL. MEDIA		8			

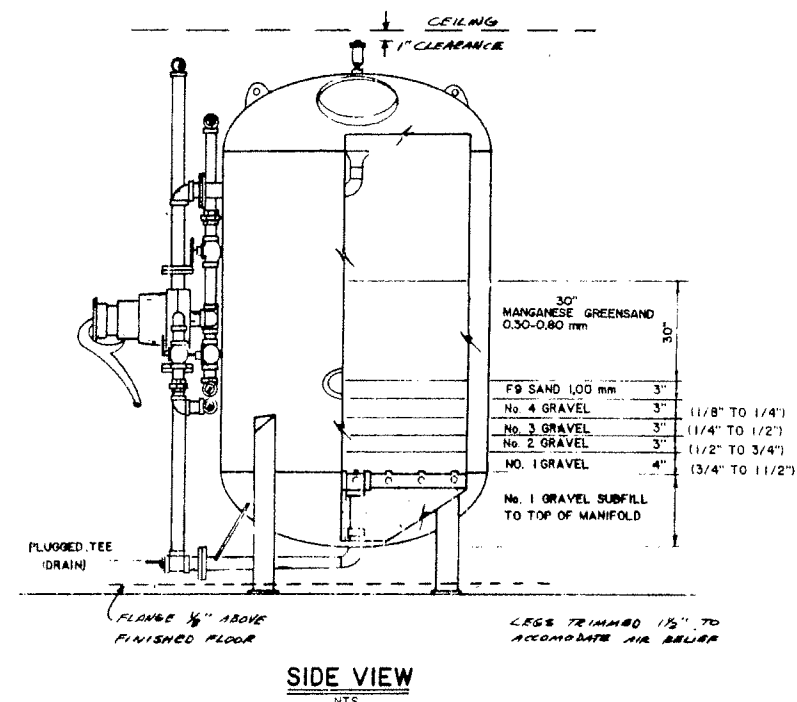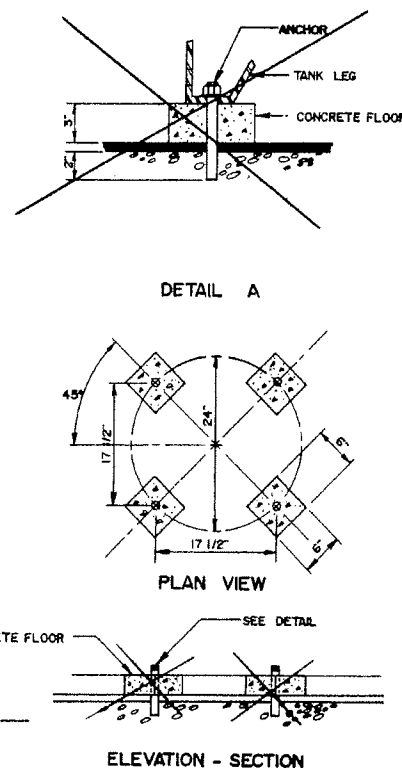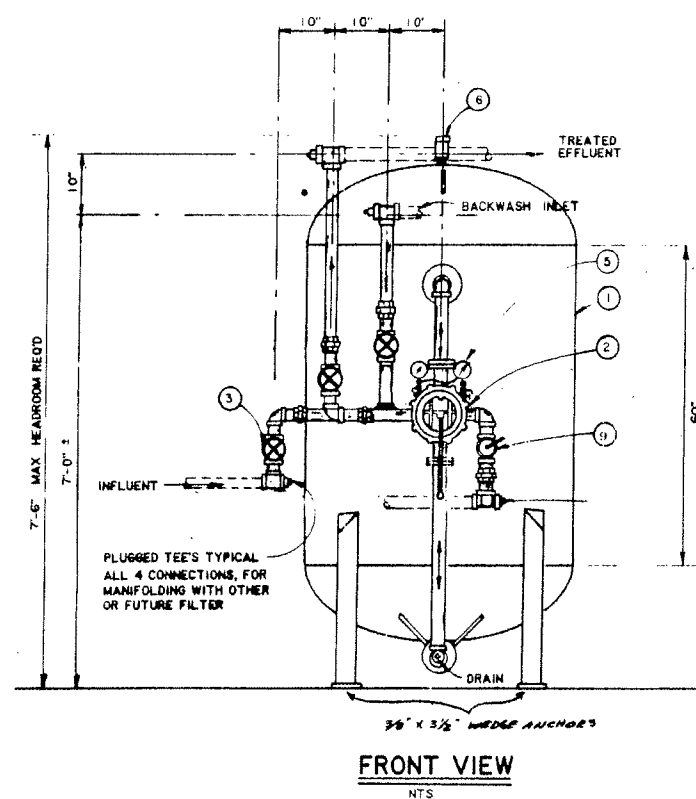


- BACKWASH PROCEDURE
30-INCH DIAMETER GREEN SAND FILTER
WITH SERIES 105 DR AQUAMATIC SOLO VALVE.
- An increase of 7 to 10 psi over the normal pressure differential across the filter would indicate the need for backwash. The differential pressure gages are located on the Solo Valve.
- INITIAL START UP PROCEDURE:
- Close effluent valve.
 - Close influent valve.
 - Rotate Solo Valve index lever from the normal SERVICE position to the BACKWASH position.
 - Set the Waste Control Valve to closed position, and slowly open the Backwash Supply Valve.
 - Slowly open the Waste Control Valve to a flow not exceeding 50 gpm as read on the Aquamatic flow meter located on backwash inlet line. When proper flow rate is achieved, lock the Waste Control Valve with its stop ring. (Steps 4 & 5 are only required during initial plant start-up, and they can be skipped after the Waste Control Valve is set).
 - Backwash for a period of about 10 minutes. Make sure that the sewer lift station pumps are in proper working order, so that backwash water is pumped to the sewer lagoon.
 - Close the Backwash Supply Valve.
 - Rotate the solo valve index lever to Rinse position.
 - Open influent valve.
 - Slowly open Rinse Control Valve. Rinse at a rate of approximately 8 gpm for 2-3 minutes.
 - Close Rinse Control Valve. (When using treated water for backwash the rinse cycle is optional which includes steps 8, 10, and 11).
 - Rotate the Solo Valve Index Lever to SERVICE position.
 - Open effluent valve. Filter is now back in service.

* DIMENSIONS ARE APPROXIMATE AND MAY VARY FROM TANK TO TANK.


REFERENCE DRAWING

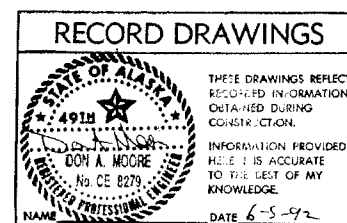

DESIGN ENGINEER
MAINTENANCE REVIEW
MATERIAL TAKE-OFF

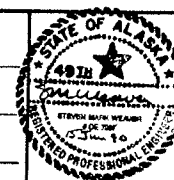


12-6-91	RECORD DRAWING	J.C.
DATE	REVISIONS	INITIALS
U. S. Department of Health & Human Services Public Health Service Indian Health Service		
BEAVER, ALASKA PRESSURE FILTER DETAILS PUBLIC LAW 86-121 PROJECT PROJECT NO. AN-89-996		SHEET NO. M-12 OF 17 TOTAL SHEETS
DRAWN BY: JSP/TM DATE: DECEMBER, 84 / 1-90		CHECKED BY: DATE:
SANITATION FACILITIES CONSTRUCTION BRANCH ENVIRONMENTAL HEALTH BRANCH ALASKA AREA NATIVE HEALTH SERVICE ANCHORAGE, ALASKA		

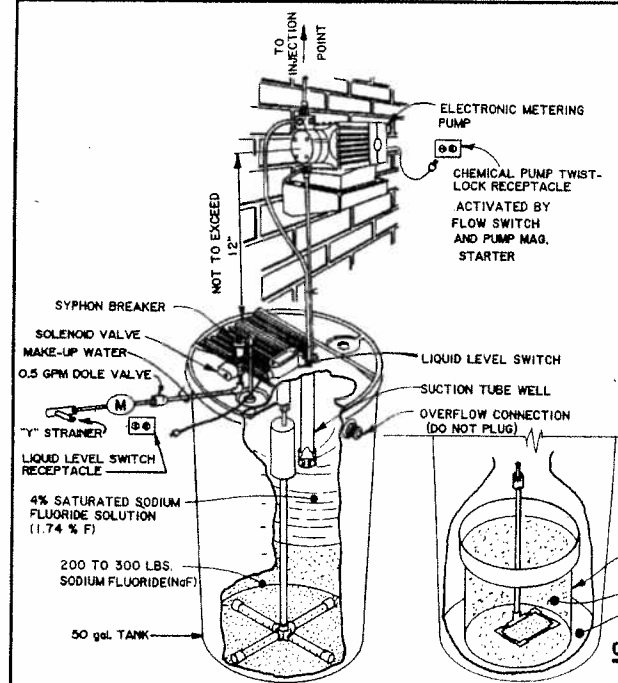


UPFLOW FLUORIDE SATURATOR

NOT TO SCALE

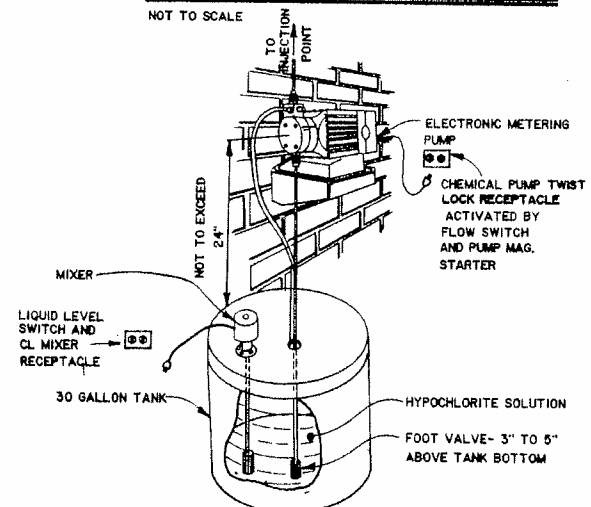

CHLORINATION SYSTEM

NOT TO SCALE

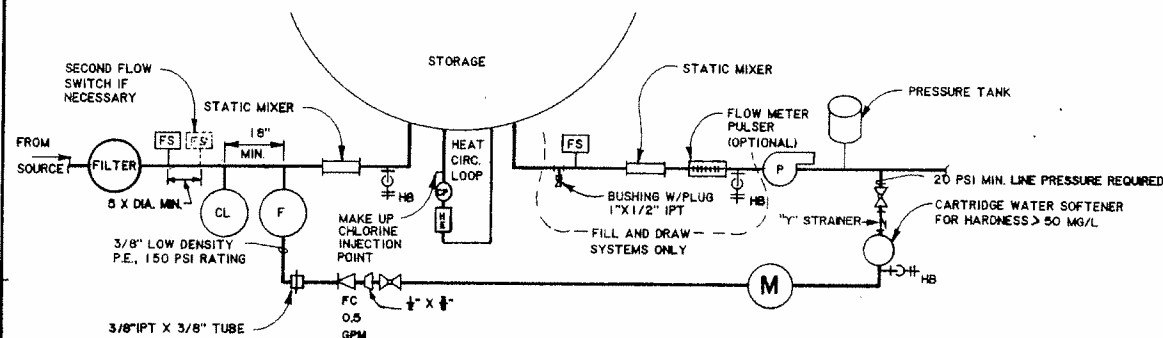

TYPICAL SYSTEM

NOT TO SCALE

NOTES:

1. THE 0.5 GPM FLOW CONTROL VALVE DOES NOT COME WITH THE SATURATOR. THIS SHOULD BE INSTALLED TO MAINTAIN A SLOW UPFLOW MOVEMENT THROUGH THE NaF IN ORDER TO DEVELOP A SATURATED SOLUTION.
2. THE CARTRIDGE TYPE SOFTENER IS REQ'D. IF HARDNESS IS GREATER THAN 75PPM. USE MCG GUARD WATER SOFTENER, MODEL 30H OR EQUAL. AVAILABLE AT MCDONALD & FILS, 5608 CHARLEMAGNE, MONTREAL H1X2H9, CANADA (514)374-0450. CCRG, RFD # 3, SALMON RIVER RD., PLATTSBURGH, N.Y. 12901

OPERATION NOTES

1. WATER FLOW 14 GPM
2. NATURAL FLUORIDE LEVEL 0.06 PPM
3. DESIRED FLUORIDE LEVEL, 1.5 PPM RANGE 1.1 TO 1.7 PPM
4. SODIUM FLUORIDE (NaF) SOLUTION 4% (1.74% F)
5. DOSAGE RATE OF SOLUTION: 9.12 ML/MIN.

FLUORIDE PUMP SELECTION

MAXIMUM CHEMICAL PUMP CAPACITY

$$\left(\frac{0.378 \times 15 \text{ PPM} \times 14 \text{ GPM}}{1.74\% \text{ F}} \right) \times 2 = 9.12 \text{ ML/MIN}$$

WHERE: 0.378 = CONVERSION FROM GAL. TO LITERS

* 15 PPM = DESIRED CONCENTRATION IN WATER

14 GPM = FLOW AT INJECTION POINT

1.74% F = STRENGTH OF SATURATED NaF SOLUTION

(* ASSUMES NO NATURAL F)

OPTIONAL DISTRIBUTOR ASSEMBLY

(LOW FLOW AND FILL-AND-DRAW SYSTEMS)

OPERATION NOTES

1. WATER FLOW 14 GPM
2. DOSAGE RATE: 1-3PPM WELL SOURCE, 3-5PPM RIVER OR LAKE SOURCE
3. 0.2 TO 0.4PPM FREE CHLORINE RESIDUAL
4. HYPOCHLORITE SOLUTION 1/2% (1/2 TO 2%)
5. MIXTURE FOR 25 GALLON SOLUTION
HTH: % SOLUTION
1.5lb 1/2%
3.0lb 1% (TYP)
4.5lb 1 1/2%
6.0lb 2%

CHLORINE PUMP SELECTION

MAXIMUM CHEMICAL PUMP CAPACITY

$$\left(\frac{0.378 \times \text{DOSAGE RATE, PPM} \times 14 \text{ GPM}}{1/2\% \text{ SOLUTION}} \right) \times 2 = 21.20 \text{ ML/MIN}$$

WHERE: 0.378 = CONVERSION GAL. TO LITERS

DOSAGE RATE = FREE RESIDUAL DESIRED & CHLORINE DEMAND

14 GPM = FLOW AT INJECTION POINT

% SOLUTION = STRENGTH OF CHLORINE SOLUTION


TYPICAL PARTS LIST

- TWIST-LOCK RECEPTACLE & 3 TWIST-LOCK PLUGS
SATURATOR FEED WATER LINE, INJECTOR, FLOW SWITCH
4 EA LINE SIZE X 1" TEE SWEAT
4 EA 1" X 1/2" FLUSH BUSHING, SWEAT X FIPT } ADD 2 EA FOR FILL AND DRAW SYSTEMS
3 EA 1/2" X 3" BRASS NIPPLE
1 EA 1/2" TEE, IPT
3 EA 1/2" HOSE BIB
1 EA 1/2" Y-STRAINER
1 EA 1/2" X 3/8" BRASS BUSHING
1 EA 3/8" X 3" BRASS NIPPLE
1 EA 3/8" 0.5 GPM DOLE VALVE
1 EA 3/8" MIPT X 3/8" TUBING ADAPTER, PVC (COLE-PARMER T-6385-50)
1 EA 1/4" MIPT X 3/8" TUBING, ADAPTER, PVC (COLE-PARMER, T-6385-40)
2 EA 1/4" MIPT X 3/8" TUBING, ELBOW, PVC (COLE-PARMER, T-6386-40)
2 EA 1/2" 6V
1 EA MCDONNELL, FS 8W FLOW SWITCH
1 EA LINE SIZE X 1 1/2", C X C X SWEAT, TEE
1 EA 1 1/2" X 1" FLUSH BUSHING, SWEAT X FIPT, NIBCO 718-3 } ADD 1 EA FOR FILL & DRAW
1 EA STATIC MIXER, CHEMINEER-KENICS 2-KME-PVC 4 (2-INCH) OR, CHEMINEER-KENICS 4-KME-PVC 2 (4-INCH)
2 EA LINE SIZE X 1" TEE, C X C X SWEAT
2 EA 1" X 3/4" FLUSH BUSHING, SWEAT X FIPT } FOR NON-FLUSH BUSHING CONDITIONS (ADD 2 EA FOR FILL AND DRAW SYSTEMS)
2 EA LM CORPORATION STOP AND NOZZLE ASSEMBLY (CAT. NO. 10998, 3/4" NPT)
1 EA METER, MODEL C-700*
1 EA PUMP REPAIR KIT

*METER SHALL BE ACCURATE $\pm 1\%$ @ 1/4 GPM


SOLDERING NOTES:

1. ALWAYS SOLDER THE BUSHING IN THE TEE BEFORE SOLDERING THE TEE INTO THE LINE.
2. IF POSSIBLE, SCREW FLOW SWITCH INTO BUSHING AND MEASURE AND CUT PADDLE TO LENGTH, BEFORE SOLDERING TEE INTO THE LINE. REMOVE THE FLOW SWITCH BEFORE SOLDERING.

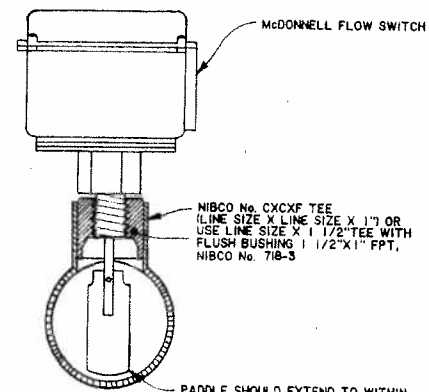

STANDARD FLOW SWITCH INSTALLATION

NOT TO SCALE

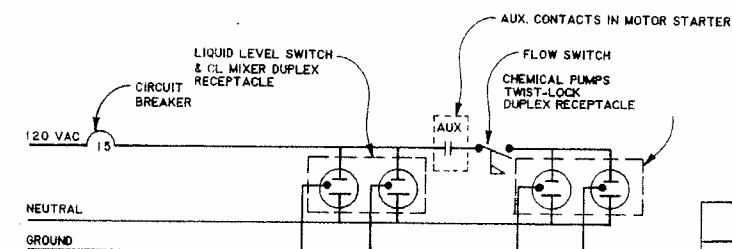


FLOW SWITCH ELECTRICAL

NOT TO SCALE


NOTES:

1. LIQUID LEVEL SWITCH AND CHLORINE MIXER DUPLEX RECEPTACLE SHALL BE SEPARATE FROM DUPLEX RECEPTACLE FOR CHEMICAL PUMPS.
2. IF MOTOR STARTER FOR WATER SOURCE PUMP IS IN THE PUMPHOUSE, ROUTE CIRCUIT THROUGH AUX. CONTACTS AS SHOWN. IF NOT, ANALYZE THE SYSTEM HYDRAULICS TO DETERMINE IF TWO FLOW SWITCHES OR PRESSURE SWITCH, WIRED IN SERIES, CAN BE USED.

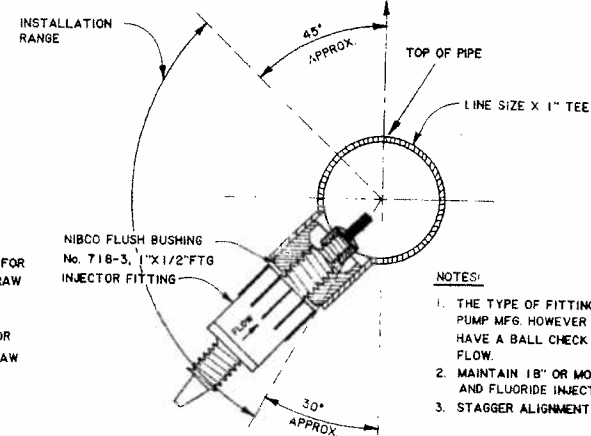

INJECTOR INSTALLATION (FLUSH)

NOT TO SCALE

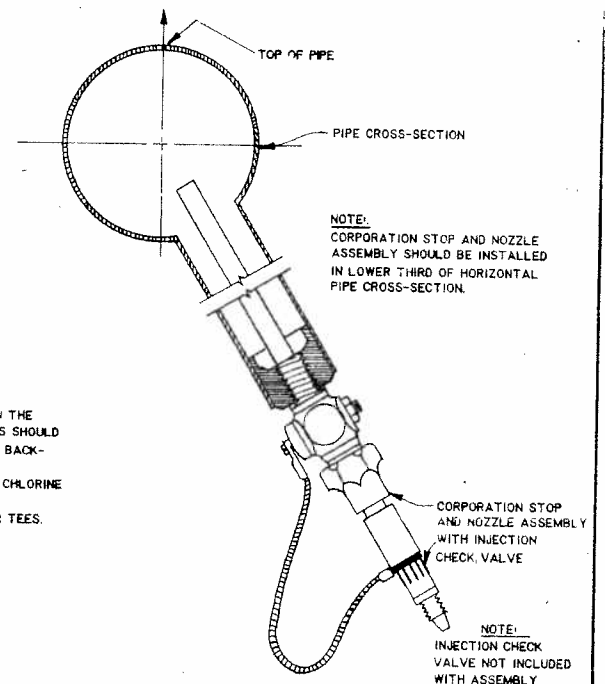

INJECTOR INSTALLATION (NON-FLUSH)

NOT TO SCALE (ONLY FOR PIPE DIAMETER 4\"/>


STANDARD FLOW SWITCH SELECTION

MODEL	PIPE SIZE	FLOW RANGE
FS 8W	2"	15 TO 50 GPM
FS 7-4W	2"	9 GPM
FS 7-4W	1 1/2"	6 GPM
FS 7-4W	1 1/4"	5 GPM

NOTE: THREADED 1/2\"/>

NOTES:


1. IF FLOW IS LESS THAN 15GPM, SEE DETAIL DRAWING FOR LOW FLOW SWITCH.
2. IF PIPE SIZE IS OTHER THAN 2\"/>

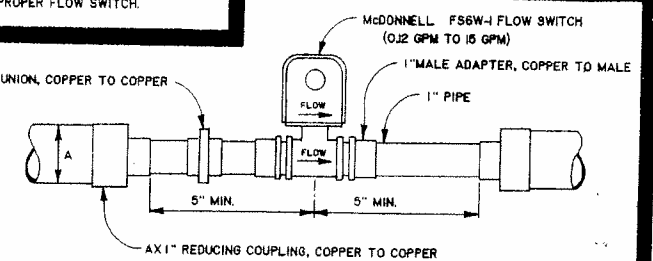

FLOW SWITCH FOR LOW FLOWS

NOT TO SCALE

RECORD DRAWINGS

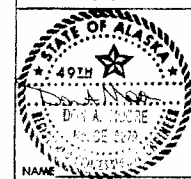


THESE DRAWINGS REFLECT RECORDED INFORMATION OBTAINED DURING CONSTRUCTION.

INFORMATION PROVIDED HEREIN IS ACCURATE TO THE BEST OF MY KNOWLEDGE.

NAME: *David A. Moore*
Design Engineer

Maintenance Review

Material Take-off

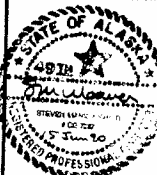

DATE	REVISIONS	INITIALS
12-9-91	RECORD DRAWING	J.C.
4-89	UP DATED	JG/pml
9-86	UP DATED	

U. S. Department of Health & Human Services
Public Health Service
Indian Health Service

BEAVER, ALASKA

FLUORIDATION & CHLORINATION SYSTEMS

PUBLIC LAW 86-121 PROJECT

PROJECT NO.

SHEET NO.

M-13

OF

17

TOTAL SHEETS

DRAWN BY: J. PARKER

DATE:

CHECKED BY:


DATE:

SANITATION FACILITIES CONSTRUCTION BRANCH



ENVIRONMENTAL HEALTH BRANCH

ALASKA AREA NATIVE HEALTH SERVICE

ANCHORAGE, ALASKA

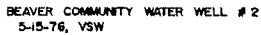

PARAMETER

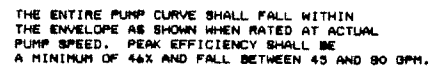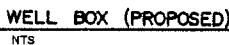


THE PUMP SHALL BE EQUAL TO:

- ~~CONFIDENTIAL~~



THE PUMP SHALL BE EQUAL TO:

1. HYDROMATIC SPQH300, 6.25" IMPELLER, 3 HP, 3450 RPM, 208 V, 3 PHASE

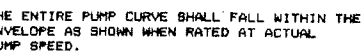








THE PUMP SHALL BE EQUAL TO:

2. CURRENT PUMP IS $\frac{1}{2}$ HP

12-6-91	RECORD DRAWING	J.C.
DATE	REVISIONS	INITIALS

RECORD DRAWINGS	
	THESE DRAWINGS REPRESENT RECORDED INFORMATION OBTAINED DURING CONSTRUCTION. INFORMATION PROVIDED HEREIN IS ACCURATE TO THE BEST OF MY KNOWLEDGE.
NAME _____	DATE <u>6-5-92</u>

<i>Hal K. Oley</i> Design Engineer Maintenance Review Material Take-off	
--	---

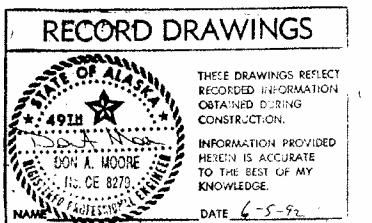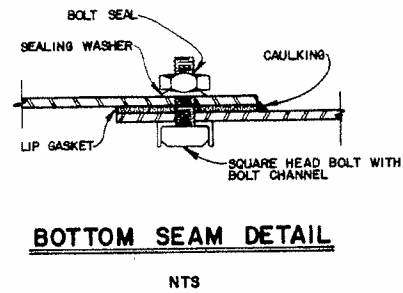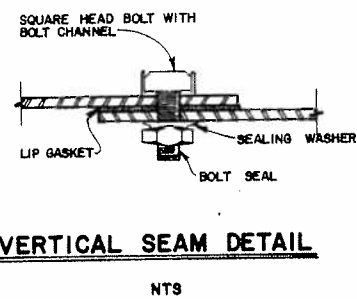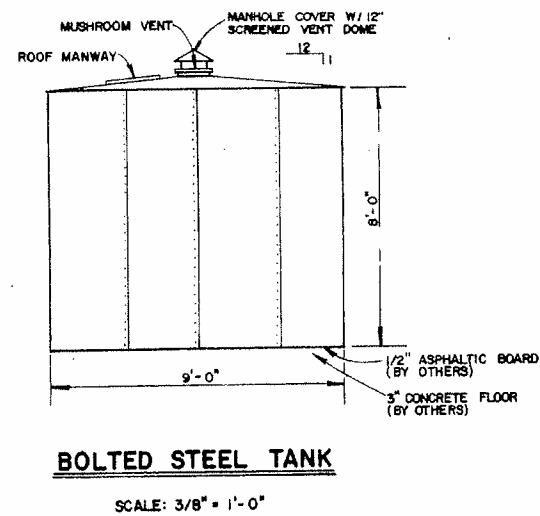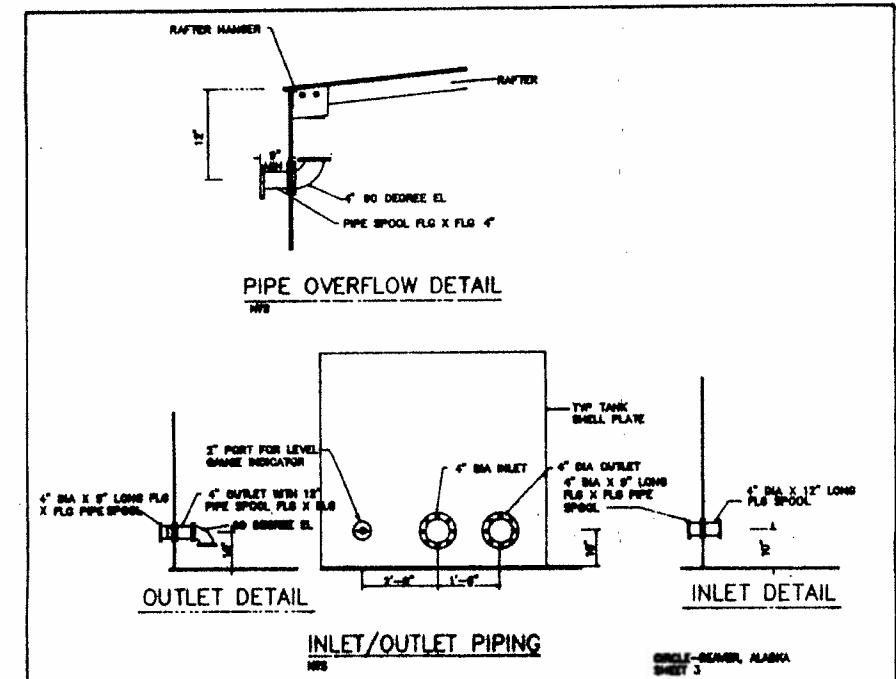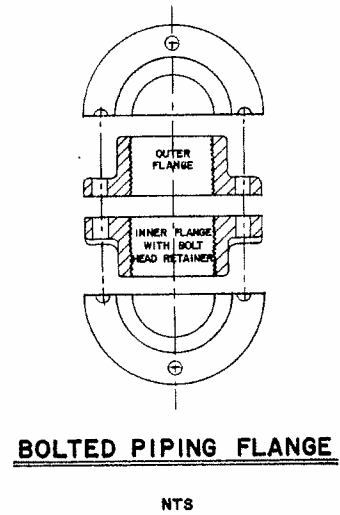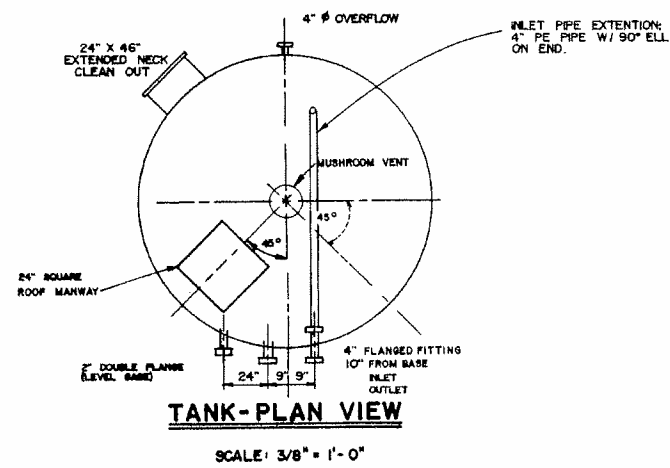

DATE	REVISIONS	INITIALS
12-9-91	RECORD DRAWING	J.C.

U. S. Department of Health & Human Services
Public Health Service
Indian Health Service

BEAVER, ALASKA


WATER STORAGE TANK
PUBLIC LAW 86-121 PROJECT
PROJECT NO. AN-89-996


SHEET NO. M-15
OF 17
TOTAL SHEETS

DRAWN BY: TJM
DATE: 2-90


CHECKED BY: J.C.
DATE: 6-5-92

SANITATION FACILITIES CONSTRUCTION BRANCH
ENVIRONMENTAL HEALTH BRANCH
ALASKA AREA NATIVE HEALTH SERVICE
ANCHORAGE, ALASKA

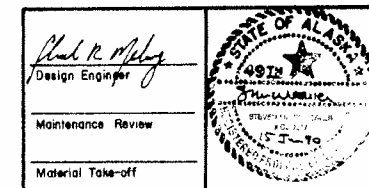


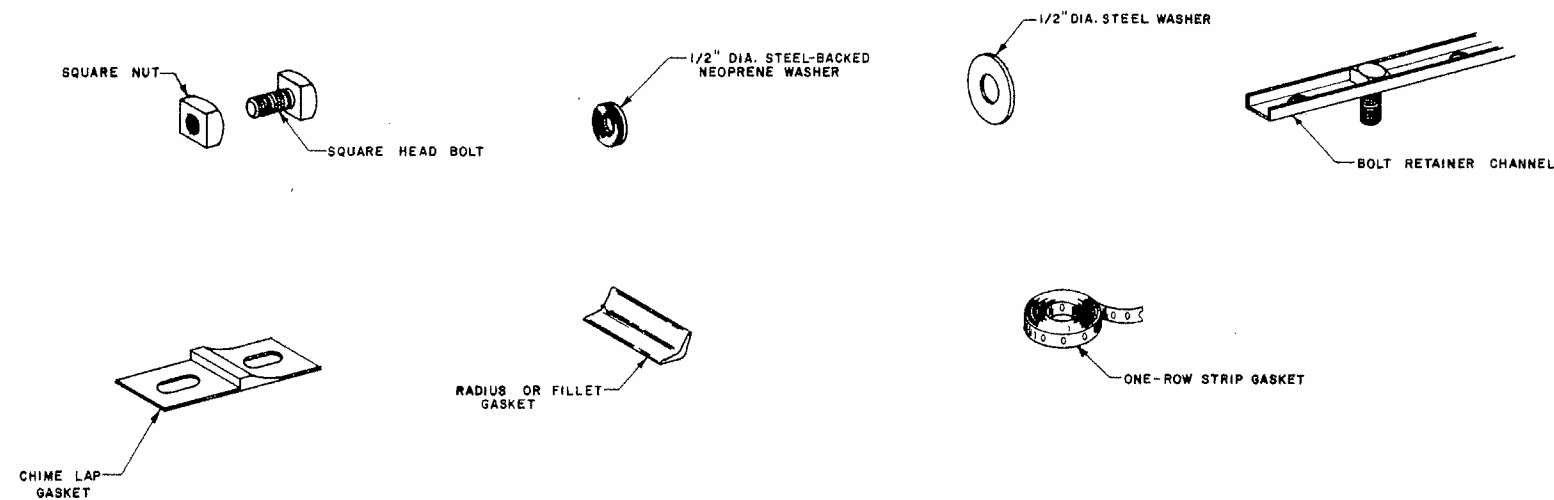




BOLTS & GASKETS

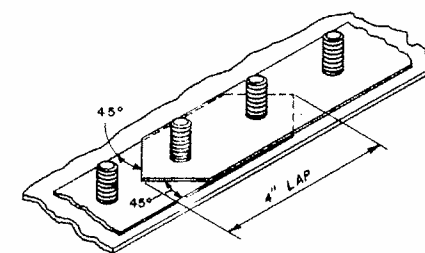


PACKING SPLICE

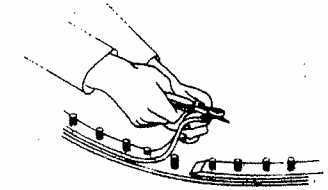

TYPICAL SPLICE

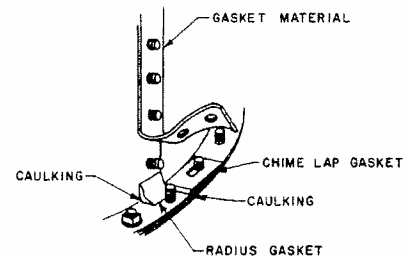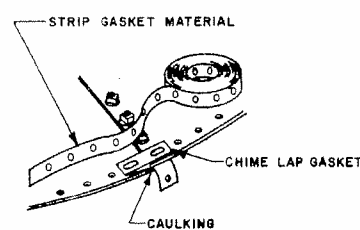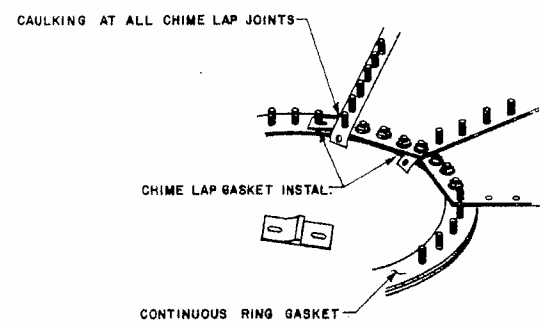



APPLY SUFFICIENT QUANTITY OF CAULKING AT THIS POINT

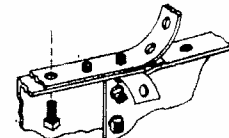

NOTE:
THESE ADDITIONAL TOOLS ARE REQUIRED
(2)-PULLER HOIST (COME ALONG)
(3)-#6 SLEDGE HAMMERS
(4)-#3 HAMMERS
(4)-ONE FOOT DRIFT PINS
(3)-IMPACT WRENCHES

GASKET PLACEMENT-BOTTOM ASSEMBLY

GASKET PLACEMENT-TOP STAVE

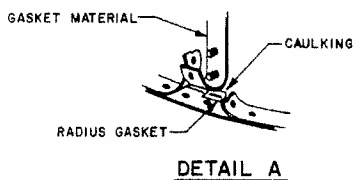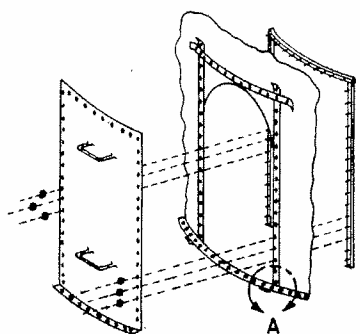

DETAIL A

GASKET PLACEMENT-CLEANOUT

RECORD DRAWINGS		
DATE	REVISIONS	INITIALS

U. S. Department of Health, & Human Services
Public Health Service
Indian Health Service

BEAVER, ALASKA
DETAILS-BOLTED STEEL TANK
PUBLIC LAW 86-121 PROJECT
PROJECT NO. AN-89-996


SHEET NO.
M-16
OF
17
TOTAL SHEETS

Design Engineer
Maintenance Review
Material Take-off



DRAWN BY: TO
DATE: DEC. 1981
CHECKED BY:
DATE:
SANITATION FACILITIES CONSTRUCTION BRANCH
ENVIRONMENTAL HEALTH BRANCH
ALASKA AREA NATIVE HEALTH SERVICE
ANCHORAGE, ALASKA


80-2020

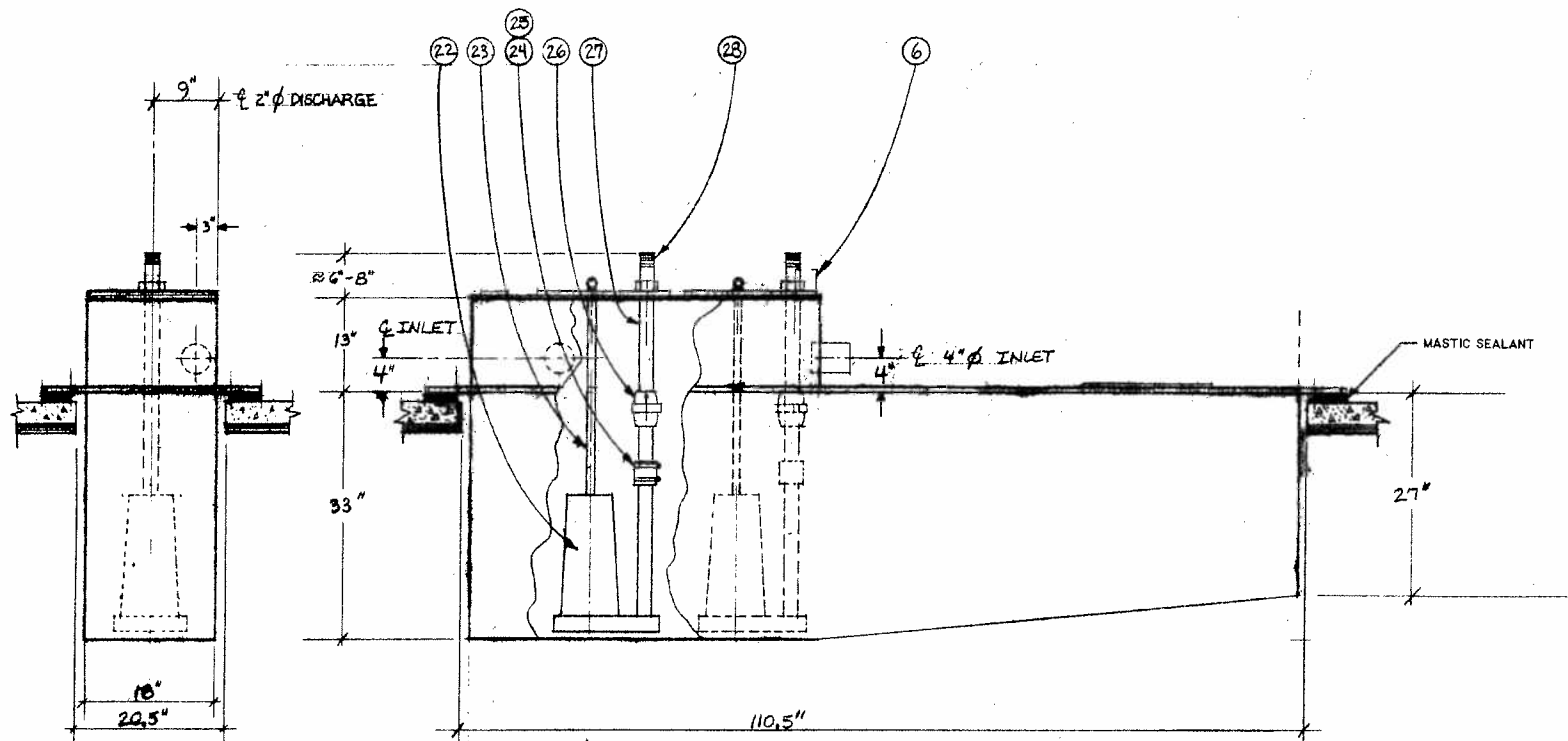

ITEM NO.	QTY EACH	DESCRIPTION	ITEM SIZE OR DIM. NO.
1	1	CUSTOM TANK	DIMENSION PER THIS SHEET
2	1	ACCESS COVER	SAME SIZE AS PUMP COVERS
3	1	BASKET - ACCESS COVER	
4		HEX HEAD BOLT	3/8" x 1 1/2", SS SERIES 300
5		FLAT WASHER	3/8" NOMINAL
6	1	VENT FLANGE	3" DIA.
7	1	VENT BASKET	3" DIA.
8	2	HEX HEAD BOLT	1/2" x 2", SS
9	2	FLAT WASHER	1/2" NOMINAL
10	1	DISCHARGE FLANGE	2" DIA. NOMINAL
11	1	DISCHARGE BASKET	2" DIA. NOMINAL
12	2	HEX HEAD BOLT	1/2" x 2", SS SERIES 300
13	2	FLAT WASHER	1/2" NOMINAL
14	2	EYE BOLT	1/2"
15	2	LOCK NUT	1/2"
16	2	POWER CORD BRIP	3/4" DIA.
17	2	PUMP COVER	SHOP STD. OR APPROX. 12" x 18" x 1/4"
18	2	BASKET - PUMP COVER	
19	4	CONTROL CORD BRIP	1/2" DIA.
20	1	FLOAT COVER	
21	1	BASKET - FLOAT COVER	
22	2	SUBSIDIARY GRINDER PUMP	HYDRA-MATIC BPHM300 OR EQUAL
23	2	SUSPENSION ASSEMBLY	
24	2	RUBBER SLEEVE	2" x 6"
25	4	HOSE CLAMP	3" SS
26	4	CHECK VALVE	2" DIA.
27	2	FLUWINGS	2" DIA. NOMINAL, GI
28	2	HALE NPT	2" DIA. NOMINAL, GI

NOTES :

1. THE LIFT STATION SHOULD BE TEST FITTED INTO THE FLOOR PRIOR TO POURING THE 3 - INCH CONCRETE SLAB TO HELP ENSURE A PROPER FIT.
2. THE LIFT STATION SHALL BE ENCLOSED WITHIN AN INSULATED SHELL CONSISTING OF 6 - INCHES OF BOARD STOCK INSULATION. THE INSULATED SHELL SHALL BE CONSTRUCTED IN THE BELLY PAN OF THE BUILDING PRIOR TO FINAL INSTALLATION OF THE LIFT STATION.
3. THE LIFT STATION SUPPORT RIM SHALL BE SEALED WITH A MASTIC STRIP.

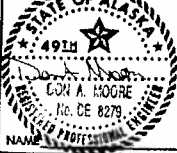RECORD DRAWINGS		
	THESE DRAWINGS REFLECT RECORDING INFORMATION OBTAINED DURING CONSTRUCTION.	
NAME <u>EDN A. MOORE</u> No. CE 8279 REGISTERED PROFESSIONAL ENGINEER	INFORMATION PROVIDED HEREIN IS ACCURATE TO THE BEST OF MY KNOWLEDGE.	
DATE <u>6-5-92</u>		

PL & DT	RECORD DRAWING	JC

DATE	REVISIONS	INITIALS

U. S. Department of Health & Human Services

Public Health Service

Indian Health Service

BEAVER, ALASKA WASHETERIA LIFT STATION PUBLIC LAW 86-121 PROJECT PROJECT NO.	SHEET NO. <u>M-17</u> OF <u>17</u> TOTAL SHEETS
---	--


DRAWN BY: <u>BUD</u> DATE: <u>4-90</u>	CHECKED BY: _____ DATE: _____
---	----------------------------------

SANITATION FACILITIES CONSTRUCTION BRANCH


ENVIRONMENTAL HEALTH BRANCH

ALASKA AREA NATIVE HEALTH SERVICE


ANCHORAGE, ALASKA

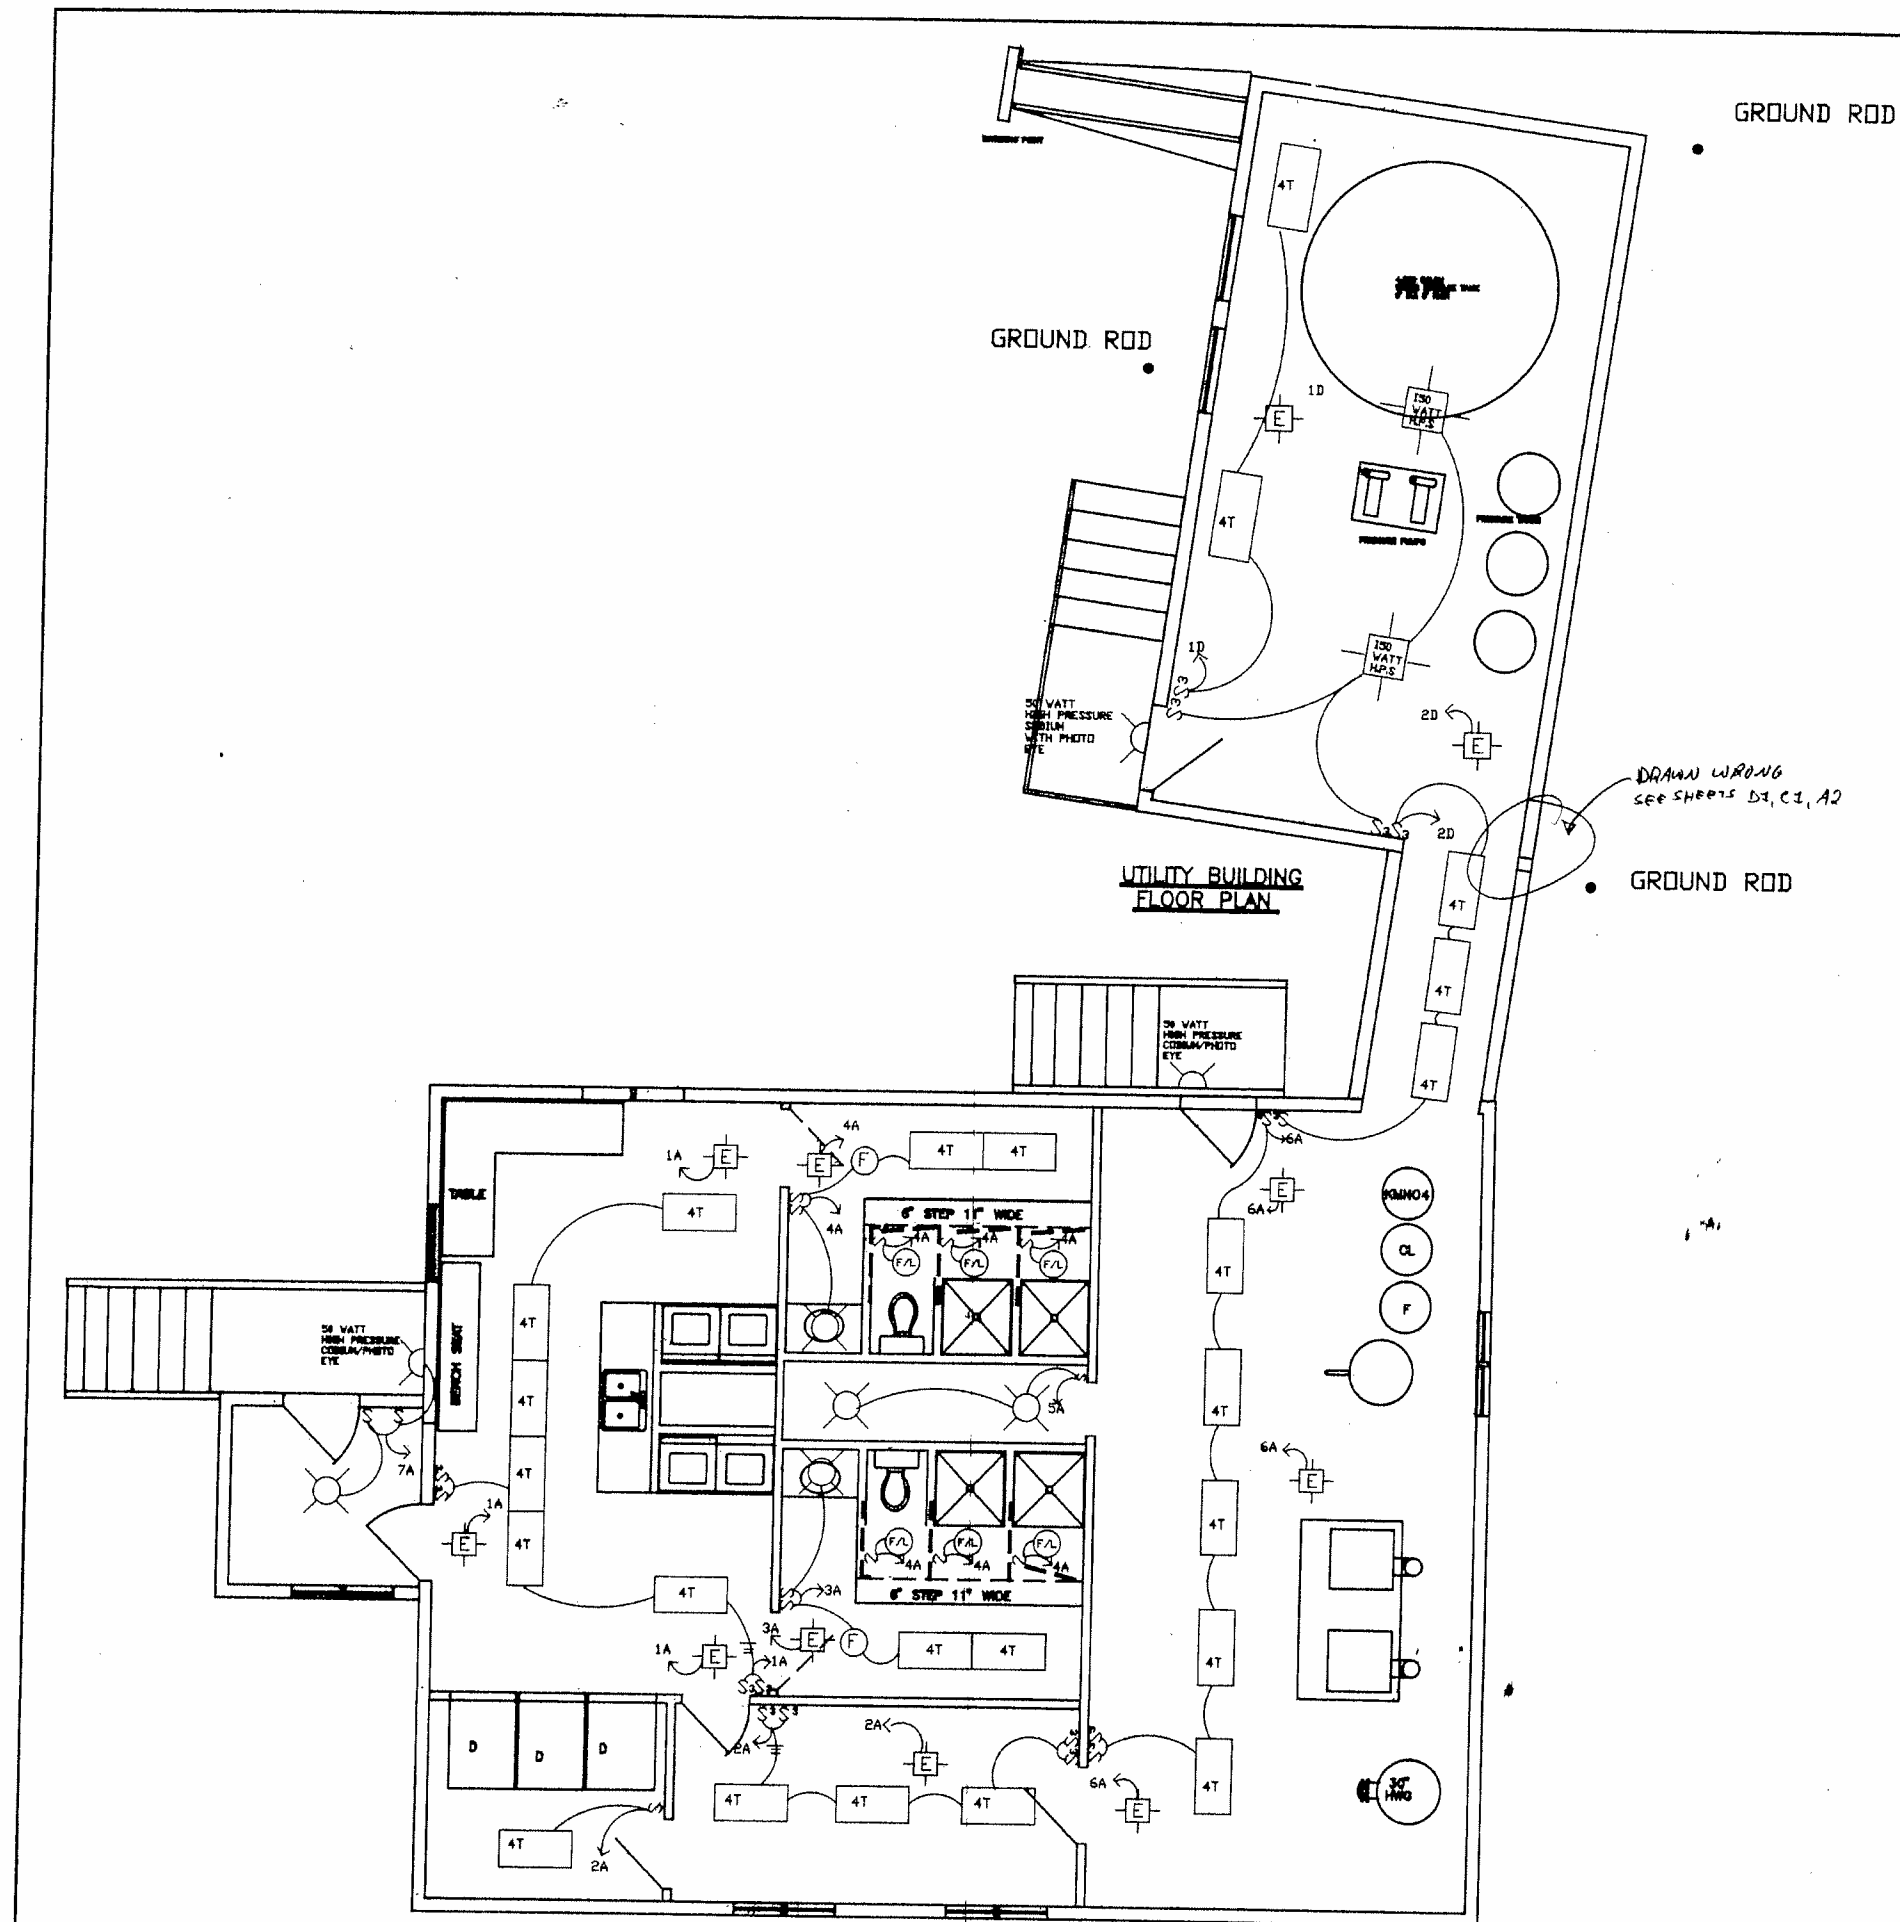


- EMERGENCY LIGHTING-BATTERY OPERATED-1.5 HOURS
 FOUR TUBE FLUORESCENT FIXTURE
 THREE WAY 115 VOLT LIGHT SWITCH (PILOT LIGHT ON IN OFF POSITION)
 SINGLE POLE LIGHT SWITCH (PILOT LIGHT ON IN OFF POSITION)
 CIRCUIT DESIGNATION
 50 WATT HIGH PRESSURE SODIUM LIGHT FIXTURE WITH PHOTO EYE
 200 WATT VAPOR PROOF LIGHT FIXTURE
 FAN/LIGHT COMBINATION FIXTURE

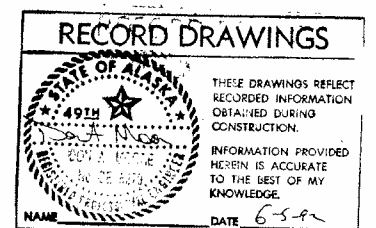

10/2/90 AS-BUILT	T.B.
DATE	REVISIONS
U.S. Department of Health & Human Services Public Health Service Indian Health Service	
BEAVER LIGHTING PUBLIC LAW 88-121 PROJECT PROJECT NO. 89-996	
DRAWN BY: BDHATCH DATE: 3/25/90	CHECKED BY: _____ DATE: _____
SANITATION FACILITIES CONSTRUCTION BRANCH BAYVIEW, ALASKA HEALTH AND HUMAN SERVICES ALASKA AREA NATIVE HEALTH SERVICE ANCHORAGE, ALASKA	

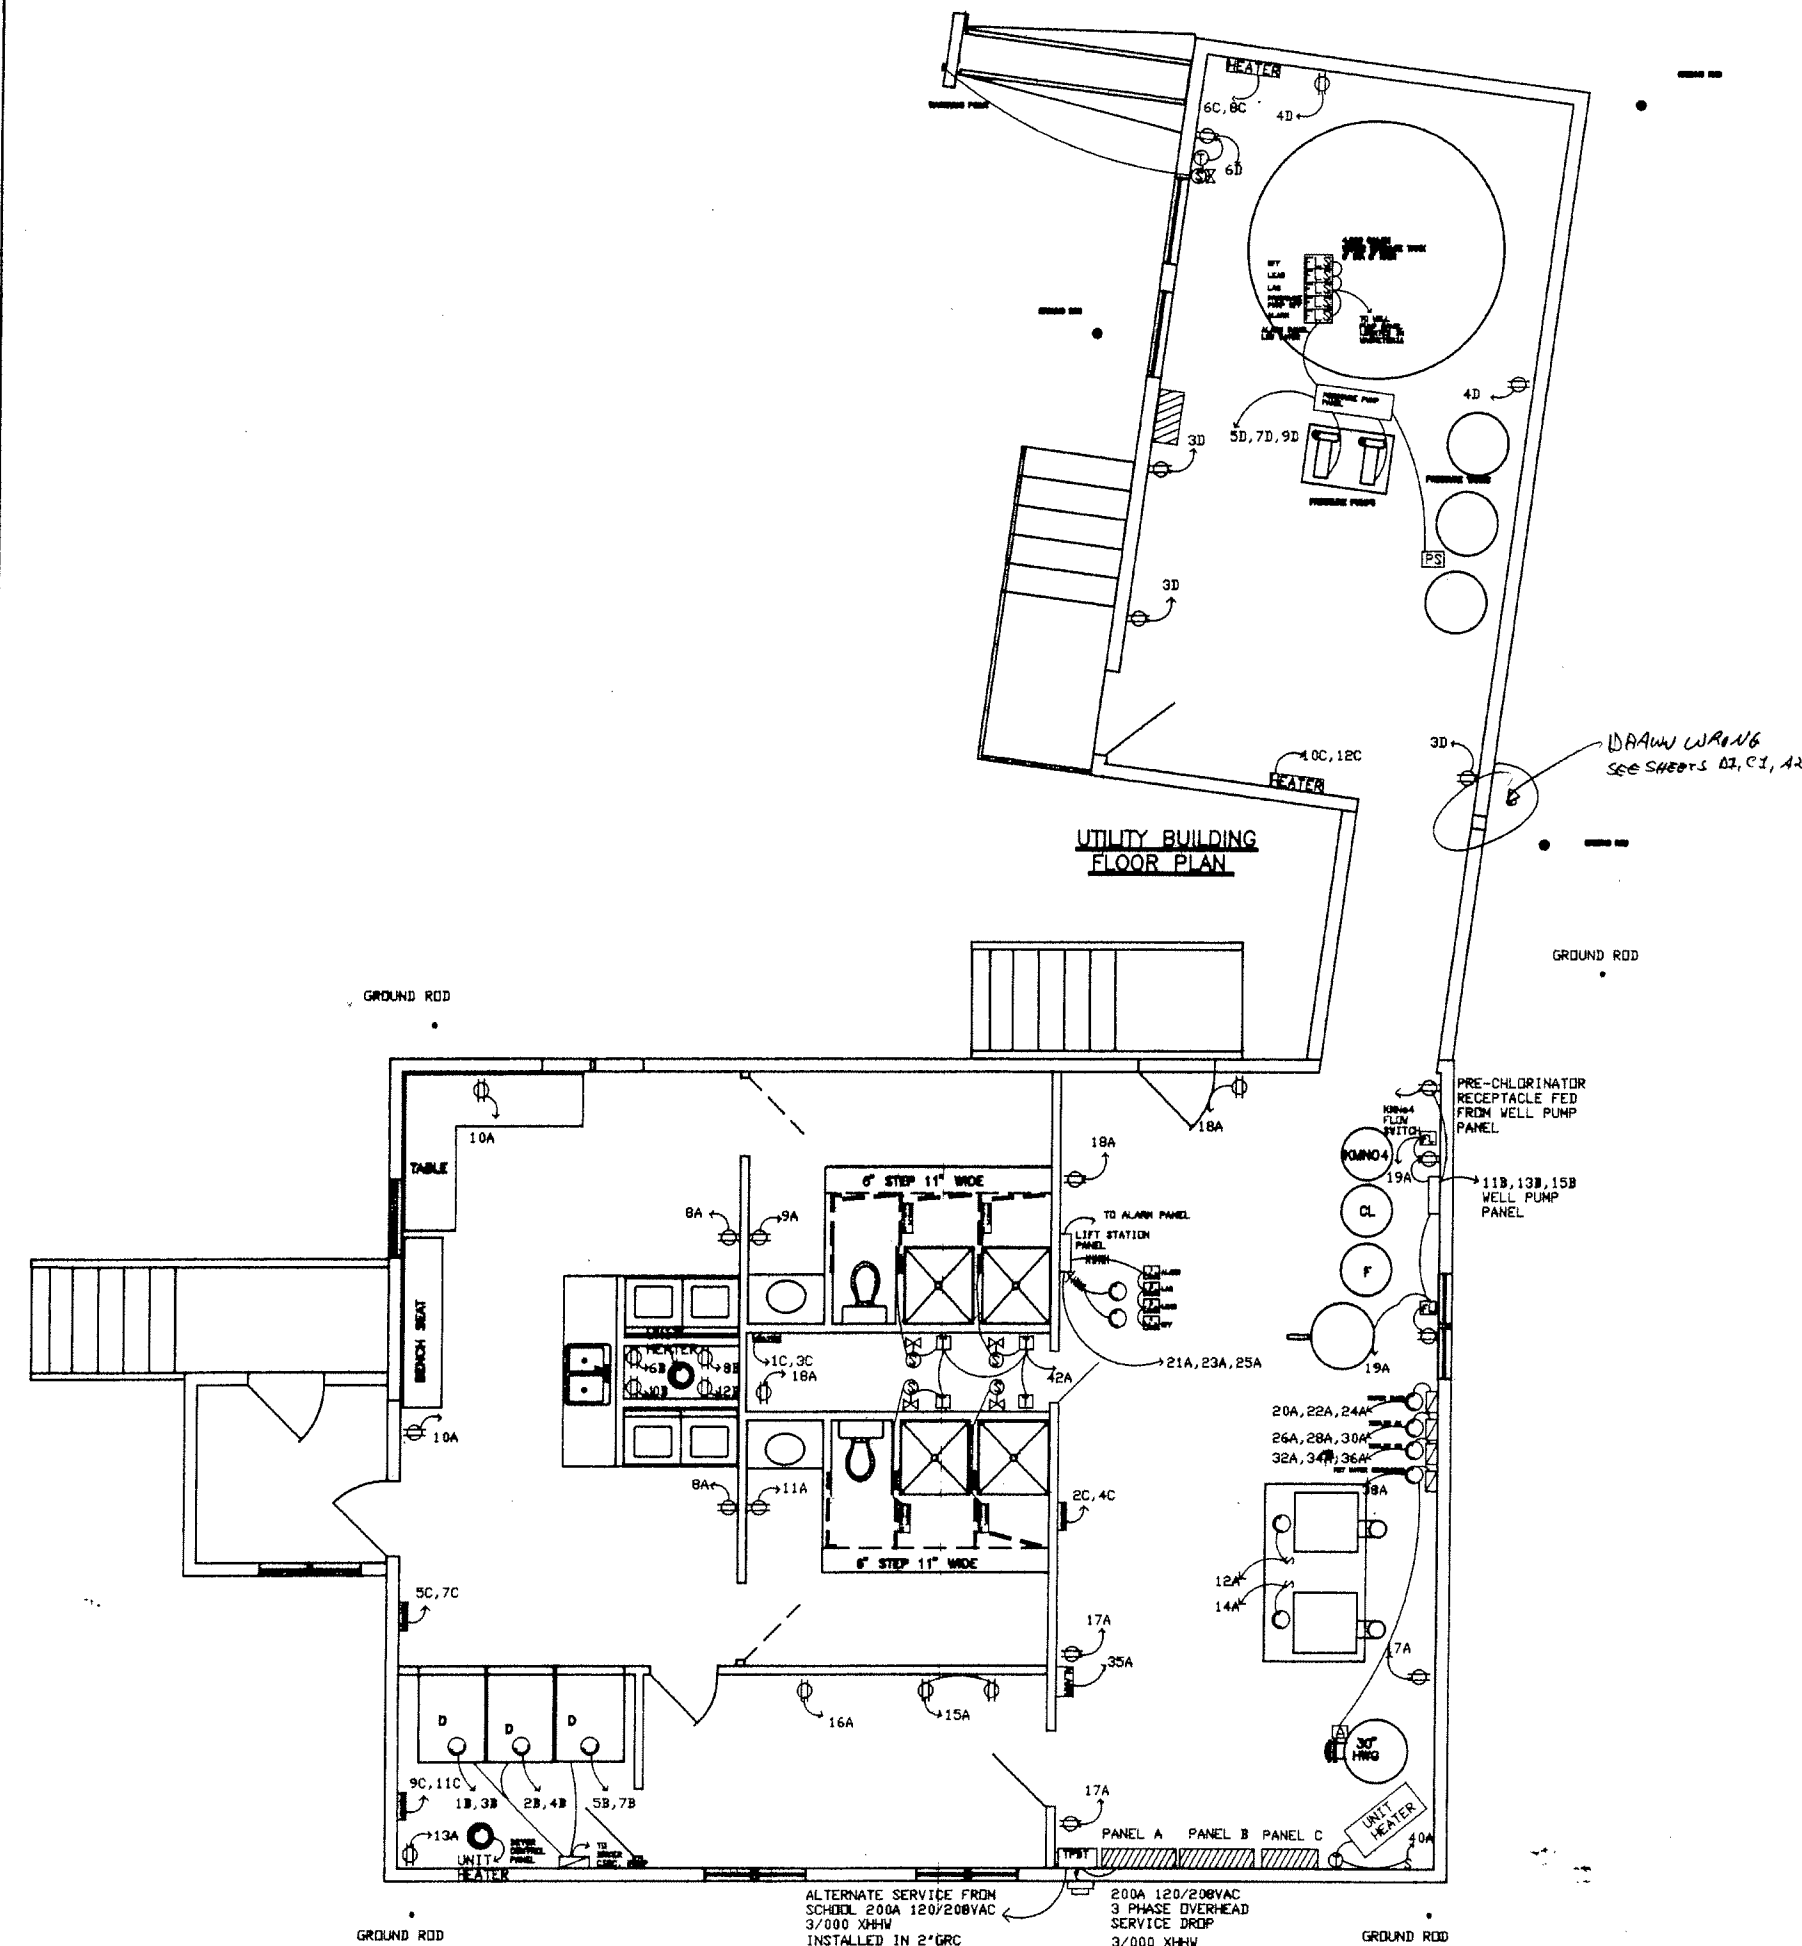

- WATER TANK FLOAT CONTROL (NORMALLY CLOSED)
TOP FLOAT-PUMP OFF TANK FULL
- WATER TANK FLOAT CONTROL (NORMALLY CLOSED)
SECOND FLOAT FROM TOP-LEAD WELL PUMP ON
- WATER TANK FLOAT CONTROL (NORMALLY CLOSED)
THIRD FLOAT FROM TOP-(FUTURE LAG PUMP ON)
- WATER TANK FLOAT CONTROL (NORMALLY CLOSED)
FORTH FLOAT FROM TOP-TANK 3/4 EMPTY
- WATER TANK FLOAT CONTROL (NORMALLY OPEN)
FIFTH FLOAT FROM TOP-TANK EMPTY-PRESSURE PUMPS OFF
- 120 VAC DUPLEX GENERAL PURPOSE RECEPTACLE-SPEC. GRADE
- 120/24 VAC STEP DOWN TRANSFORMER
- 24 VAC SOLENOID VALVE-NORMALLY CLOSED
- CIRCUIT BREAKER PANEL-DISTRIBUTION CENTER
- TRIPLE POLE-DOUBLE POLE SAFETY DISCONNECT-NON FUSIBLE
- SERVICE ENTRANCE METER COMBO-200A, 3 PHASE, 208 VAC
- NON-MAGNETIC MOTOR STARTER
- A.C. MOTOR
- 24 VAC COIN BOX
- GROUND ROD 5/8"x8'
- PRESSURE SWITCH
- FLOW SWITCH
- AQUASTAT TEMPERATURE CONTROLLER
- THERMOSTAT (HONEYWELL AIR TEMP)

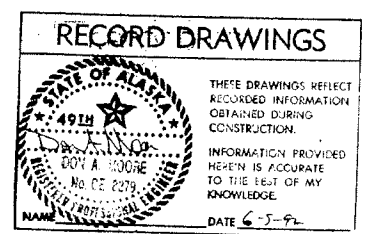

10/2/90 AS-BUILT		10
DATE	REVISIONS	INT
U.S. Department of Health & Human Services Public Health Service Indian Health Service		
BEAVER MECHANICAL-120/208VAC PUBLIC LAW 88-121 PROJECT PROJECT NO. 89-996		SHEET NO. 2-2 OF 10 SHEETS
DRAWN BY: BOHATCH DATE: 3/25/90	CHECKED BY: _____ DATE: _____	
SANITATION FACILITIES CONSTRUCTION BRANCH ENVIRONMENTAL HEALTH AND ENGINEERING BRANCH ALASKA AREA NATIVE HEALTH SERVICE ANCHORAGE, ALASKA		


		L1	L2	L3		L1	L2	L3		
		A	B	C		A	B	C		PANEL A
LIGHTS, WASHETERIA	15	1	1.33			.95			2	15 LIGHTS, HALL
LIGHTS, BATHROOM	15	3		.68			.68		4	15 LIGHTS, BATHROOM
LIGHTS, PLUMBING WALL	15	5						1.14	6	15 LIGHTS, MECH. ROOM
LIGHTS, OUTSIDE	15	7	.56			.36			8	20 RECEPTACLE-WASHETERIA
BATHROOM, RECEPTACLE	20	9		.18			.36		10	20 RECEPTACLE-WASHETERIA
BATHROOM, RECEPTACLE	20	11						.18	12	15 BOILER #1
DRYER RM RECEPTACLE	20	13	.36			1.04			14	15 BOILER #2
WORK BENCH RECEPTACLE	20	15		.36			1.04		16	20 RECEPTACLE, DESK
RECEPTACLES, MECH. RM	20	17						.36	18	20 RECEPTACLE, MECH RM
RECEPTACLES, CHEMICAL	20	19	1.4			.36			20	20 DRYER
LIFT	21	21		6.9			1.4		22	22 CIRCULATING
STATION	23	23						1.4	24	15 PUMP
PANEL	40	25	6.9			1.4			26	15 BOILER #1
UTILITY	27	27		.28			1.4		28	15 CIRCULATING
BUILDING	29	29						1.4	30	15 PUMP
SERVICE	100	31	.28			1.4			32	15 BOILER #2
FIRE ALARM PANEL	15	33		.2			1.4		34	15 CIRCULATING
BUILDING ALARM PANEL	15	35						1.4	36	15 PUMP
PANEL	37	37	.28			1.4			38	15 H.W.G. CIRC. PUMP
B	39	39		.28			.69		40	15 UNIT HEATERS
	100	41						.4	42	15 SOLENOIDS, SHOWERS

		L1	L2	L3		L1	L2	L3		
		A	B	C		A	B	C		PANEL B
DRYER	15	1	.83			.83			2	15 DRYER
#1	15	3		.83			.83		4	15 #2
DRYER	15	5						1.4	6	20 WASHER #1
#3	15	7	.83			1.4			8	20 WASHER #2
WATERING POINT	20	9		1.4			1.4		10	20 WASHER #3
		11						1.4	12	20 WASHER #4
		13							14	
		15							16	
		17							18	
		19							20	
		21							22	
		23							24	

		L1	L2	L3		L1	L2	L3		
		A	B	C		A	B	C		PANEL C
HEATER	15	1	3.12			3.12			2	15 HEATER
#1	20	3		3.12			3.12		4	20 #2
HEATER	20	5						3.12	6	20 HEATER
#3	20	7	3.12			3.12			8	20 #4
HEATER	20	9		3.12			3.12		10	20 HEATER
#5	20	11						3.12	12	20 #6
		13							14	
		15							16	
		17							18	
		19							20	
		21							22	
		23							24	


		L1	L2	L3						
		A	B	C						PANEL D
MAIN LIGHTING	15	1	1.2			1.2			2	15 OUTSIDE LIGHTS
RECEPTACLES	20	3		1.4					4	20 RECEPTACLE
PRESSURE	20	5						8.3	6	20 WATERING POINT
PUMP	20	7	6.9						8	
PANEL	40	9		6.9					10	
AREA.		11							12	
		13							14	
		15							16	
		17							18	
		19							20	
		21							22	
		23							24	
		25							26	
		27							28	
		29							30	

- ALL ELECTRICAL INSTALLATIONS TO BE INSTALLED IN ACCORDANCE WITH 1990 NEC SPECIFICATIONS.
- CLEAR AREA REQUIRED FOR ALL ELECTRICAL PANELS:
36" FROM FACE OF PANEL
75" FROM FLOOR UP TO FIRST OBSTRUCTION
15" CLEAR EACH SIDE FROM CENTER LINE OF PANEL
- ALL CIRCUIT INSTALLATIONS WILL BE INSTALLED IN GALVANIZED E.M.T. CONDUIT WITH THE EXCEPTION - MOTORS, FANS AND BOILERS - SEALTIGHT WITH FLEXIBLE METAL CORE WILL BE USED.
- ALL CIRCUITS WILL BE GROUNDED TO THE CONDUIT PLUS A SEPARATE GROUNDING WIRE WILL BE INSTALLED (GREEN).
- CIRCUITS TO BE GFCI DESIGNATED - BATHROOMS (LIGHTING AND RECEPTACLES), RECEPTACLES IN WATER STORAGE TANK ROOM, AND GENERAL PURPOSE RECEPTACLES IN AREA SUBJECT TO MINOR FLOODING (BOILER ROOMS, PLUMBING WALLS, ETC.).
- MINIMUM OF FOUR GROUND RODS TO BE INSTALLED, ONE IN EACH CORNER OF BUILDING TO FORM A SCREEN GRID. #6 BARE SOLID COPPER WIRE WILL BE USED FOR BONDING FROM GROUND RODS TO LOAD CENTERS. IN AREAS WHERE SALT WATER IS CONCENTRATED OR A HIGH SALT-SILT SOIL IS EVIDENT GROUND WIRE BONDING TO GROUND RODS WILL BE MADE WITH CAD WELL FUSION AS PRIMARY CHOICE OR SILVER SOLDER AS SECONDARY CHOICE.
- ALL ELECTRICAL INSTALLATIONS SHALL BE INSTALLED BY LICENSED ELECTRICIAN. IN THE CASE WHERE ELECTRICAL TRAINEES ARE ASSISTING WITH THE ELECTRICAL WORK, ALL ELECTRICAL WORK SHALL BE PHYSICALLY INSPECTED BY LICENSED PERSONNEL PRIOR TO ENERGIZING THE CIRCUITS.
- TEMPORARY WIRING USED DURING CONSTRUCTION PHASE OF PROJECTS TO BE WIRED TO GFCI BREAKERS AND INSTALLED BY LICENSED ELECTRICIAN. TEMPORARY WIRING TO BE CONSIDERED AS PERMANENT.
- HIGH PRESSURE SODIUM FIXTURES WILL BE MARKED INDICATING WATTAGE AND BULB SIZE WITH A 1"x3" TAG MOUNTED NEAR THE BASE OF THE FIXTURE.
- J-BOXES MOUNTED IN ENCLOSED AREAS (SUSPENDED CEILINGS) WILL BE MARKED ON THE FRONT COVER INDICATING CIRCUIT NUMBERS AND PURPOSE.
- DURING CONSTRUCTION PHASE WHEN ELECTRICAL PANELS AND CIRCUITS ARE EXPOSED WARNING SIGNS WILL BE POSTED INDICATING - DANGER HIGH VOLTAGE, ELECTRICAL CIRCUITS ENERGIZED, DO NOT TOUCH. CONSTRUCTION FOREMAN WILL BE ASKED TO INCLUDE THESE WARNINGS DURING WEEKLY SAFETY MEETINGS. ALL ELECTRICAL PANELS AND CIRCUITS WILL BE COVERED PRIOR TO LICENSED ELECTRICIAN DEPARTING THE
- CIRCUITS WILL BE WIRED ACCORDINGLY:
LIGHTING CIRCUITS-BLACK THHN STRANDED
CARRIER SIDE OF SWITCH-YELLOW THHN STRANDED
GENERAL PURPOSE RECEPTACLES-RED THHN STRANDED
ALARM CIRCUITS-BROWN THHN STRANDED
ALARM CIRCUITS SUPPLY-BLUE THHN STRANDED
208/240 V CIRCUITS-PURPLE THHN STRANDED
- WIRE SIZES ARE AS FOLLOWS:
#14 THHN-15A BREAKER
#12 THHN-20A BREAKER
#10 THHN-30A BREAKER
#8 THHN-50A BREAKER
#6 THHN-70A BREAKER
#4 THHN-80A BREAKER
#1/0THHN-150ABREAKER
#3/0THHN-200ABREAKER

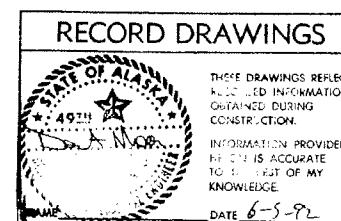

Design Engineer	
Subcontractor	
Material Take-off	


10/2/92	AS-BUILT	TB
DATE	REVISIONS	INIT
U.S. Department of Health & Human Services Public Health Service Indian Health Service		
BEAVER CIRCUIT BREAKER PANELS PUBLIC LAW 86-121 PROJECT PROJECT NO. 89-996		
DRAWN BY: BQHATCH DATE: 3/25/90		CHECKED BY: _____ DATE: _____
SANITATION FACILITIES CONSTRUCTION BRANCH ENVIRONMENTAL HEALTH AND EMERGENCY RESPONSE ALASKA AREA NATIVE HEALTH SERVICE ANCHORAGE, ALASKA		

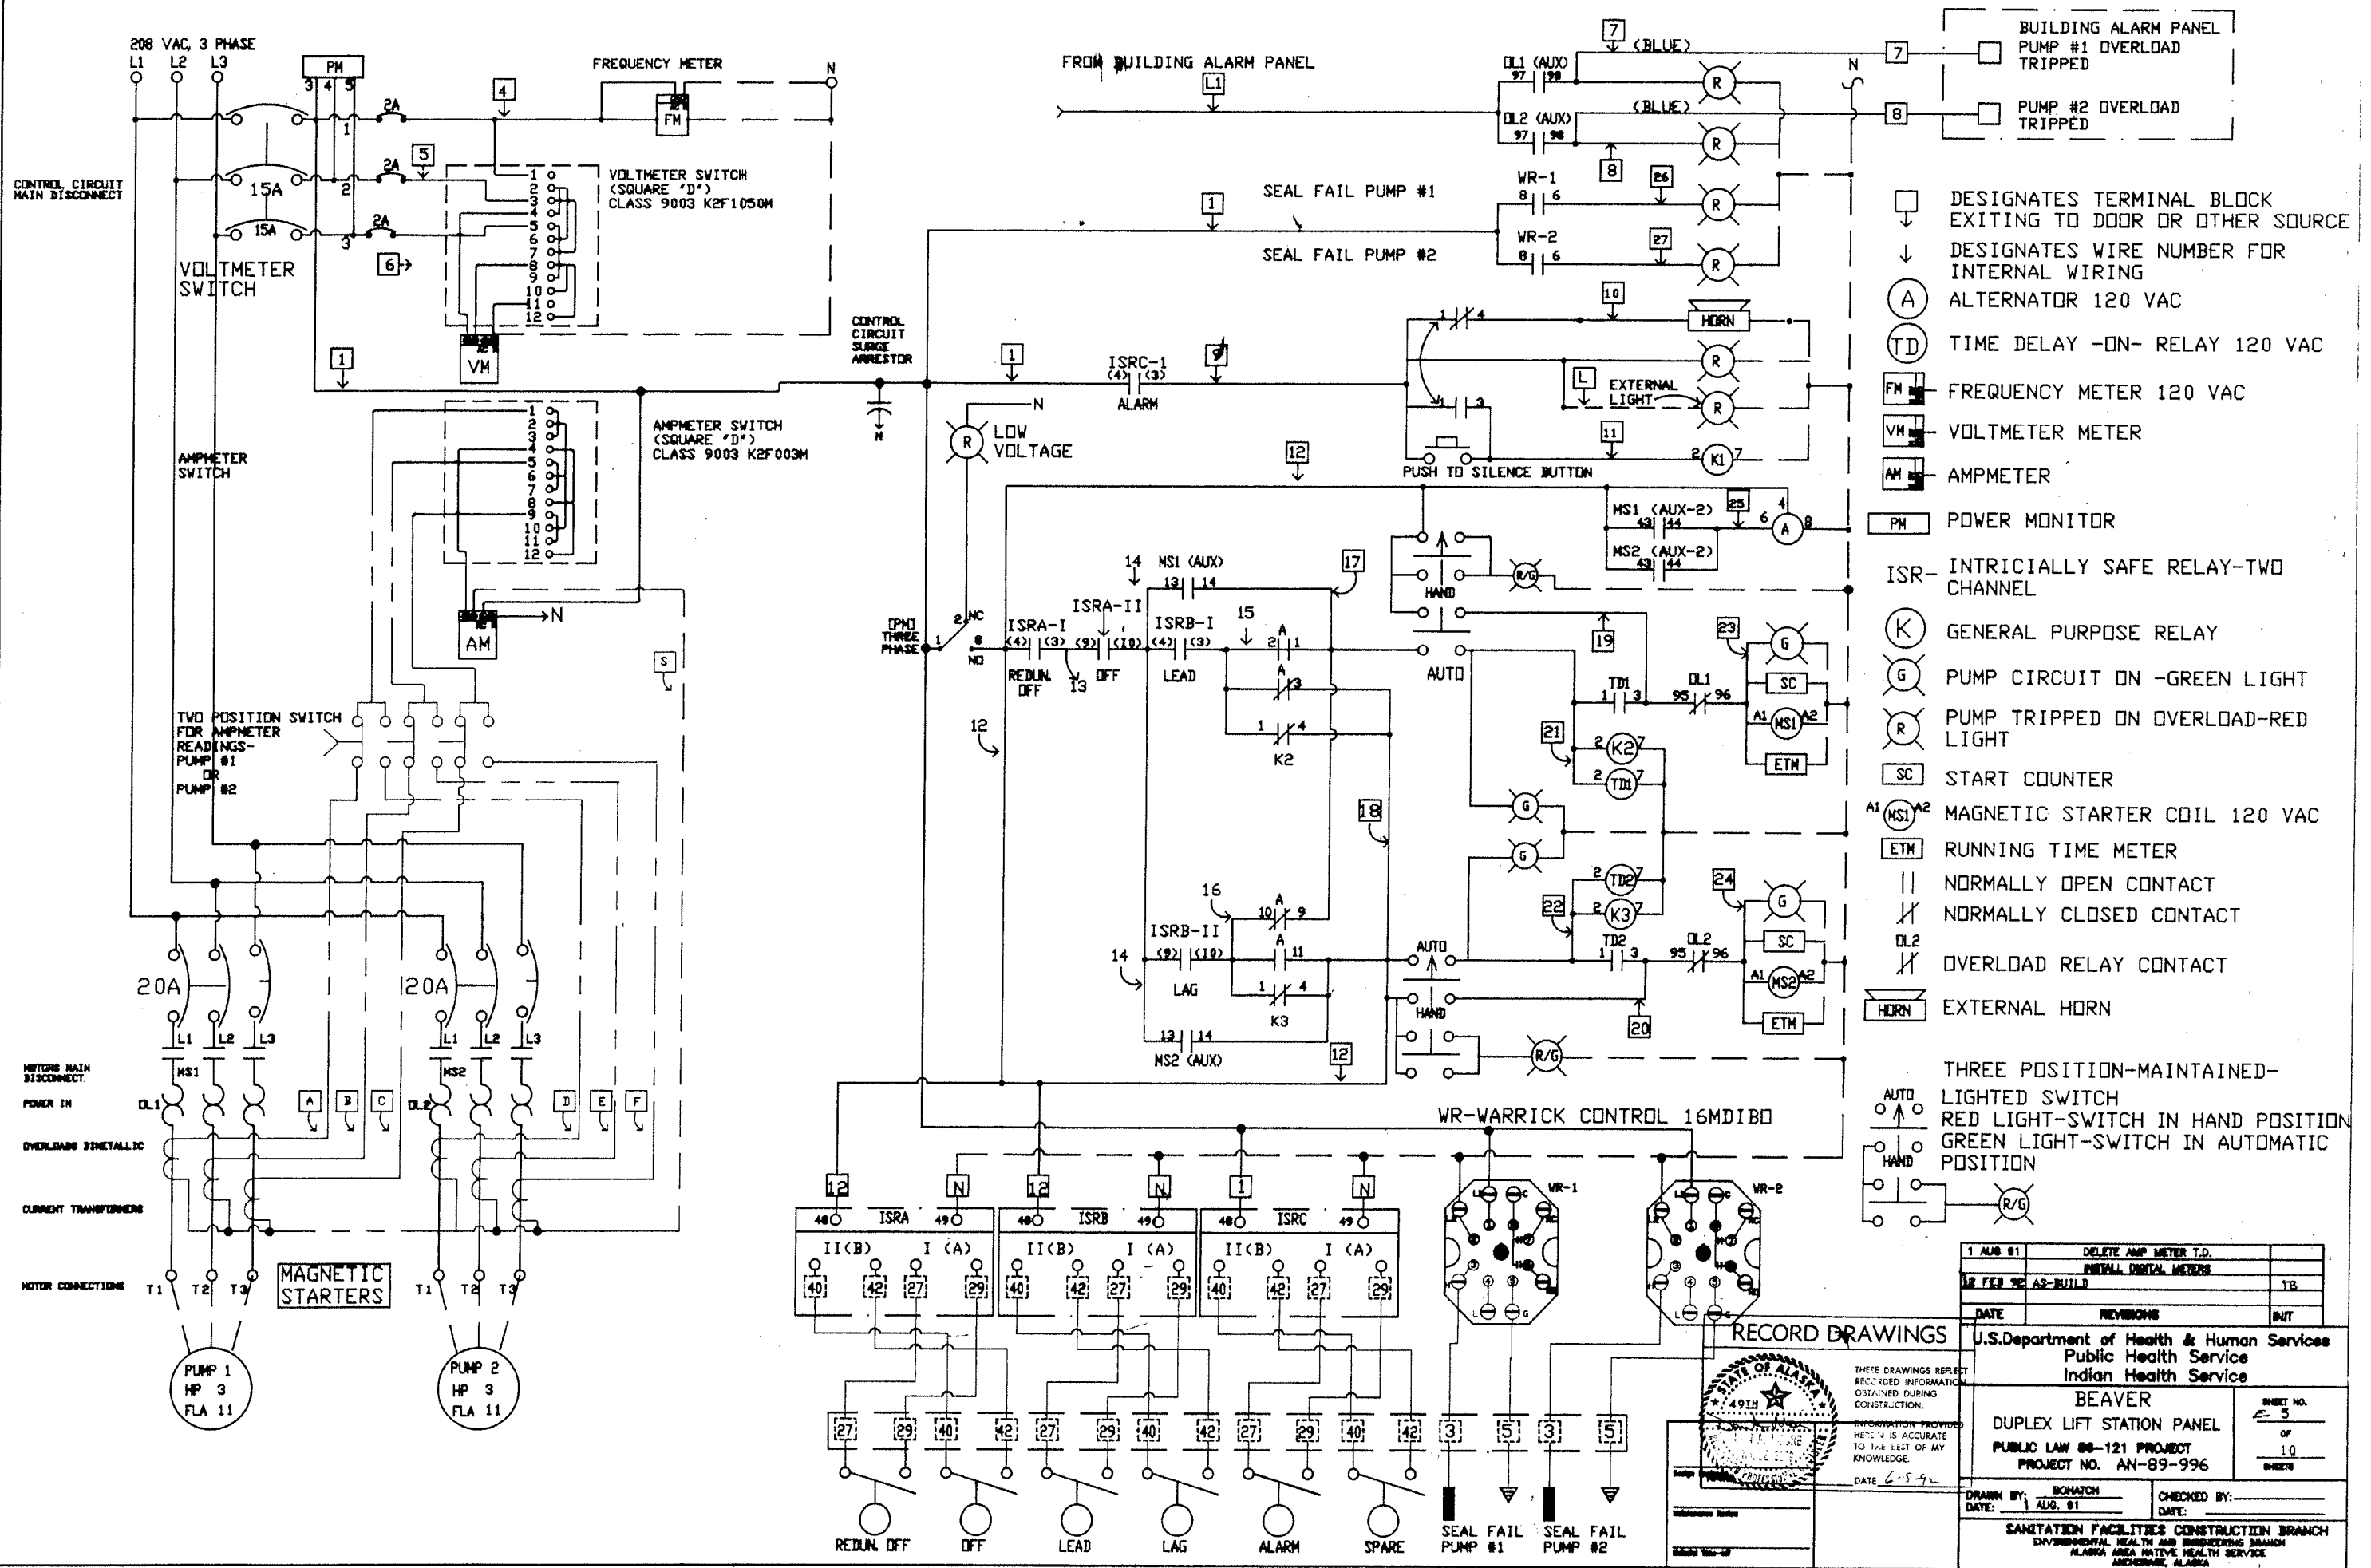


- DESIGNATES TERMINAL BLOCK EXITING TO DOOR OR OTHER SOURCE
- DESIGNATES WIRE NUMBER FOR INTERNAL WIRING
- ALTERNATOR 120 VAC
- TIME DELAY -ON- RELAY 120 VAC
- FREQUENCY METER 120 VAC
- VOLTMETER METER
- AMMETER
- POWER MONITOR
- INTRINSICALLY SAFE RELAY-TWO CHANNEL
- GENERAL PURPOSE RELAY
- PUMP CIRCUIT ON -GREEN LIGHT
- PUMP TRIPPED ON OVERLOAD-RED LIGHT
- START COUNTER
- MAGNETIC STARTER COIL 120 VAC
- RUNNING TIME METER
- NORMALLY OPEN CONTACT
- NORMALLY CLOSED CONTACT
- OVERLOAD RELAY CONTACT
- EXTERNAL HORN
- THREE POSITION-MAINTAINED-LIGHTED SWITCH
- RED LIGHT-SWITCH IN HAND POSITION
- GREEN LIGHT-SWITCH IN AUTOMATIC POSITION




1 AUG 81	DELETE AMP METER T.D.	
18 FEB 82	AS-BUILD	YB
DATE	REVISIONS	BY

RECORD DRAWINGS

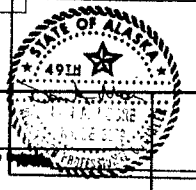



U.S. Department of Health & Human Services Public Health Service Indian Health Service	
BEAVER DUPLIX LIFT STATION PANEL	
PUBLIC LAW 88-121 PROJECT PROJECT NO. AN-89-996	
DRAWN BY: BOHATCH DATE: AUG. 81	CHECKED BY: _____ DATE: _____
SANITATION FACILITIES CONSTRUCTION BRANCH ENVIRONMENTAL HEALTH AND INSPECTING DIVISION ALASKA AREA NATIVE HEALTH SERVICE ANCHORAGE, ALASKA	

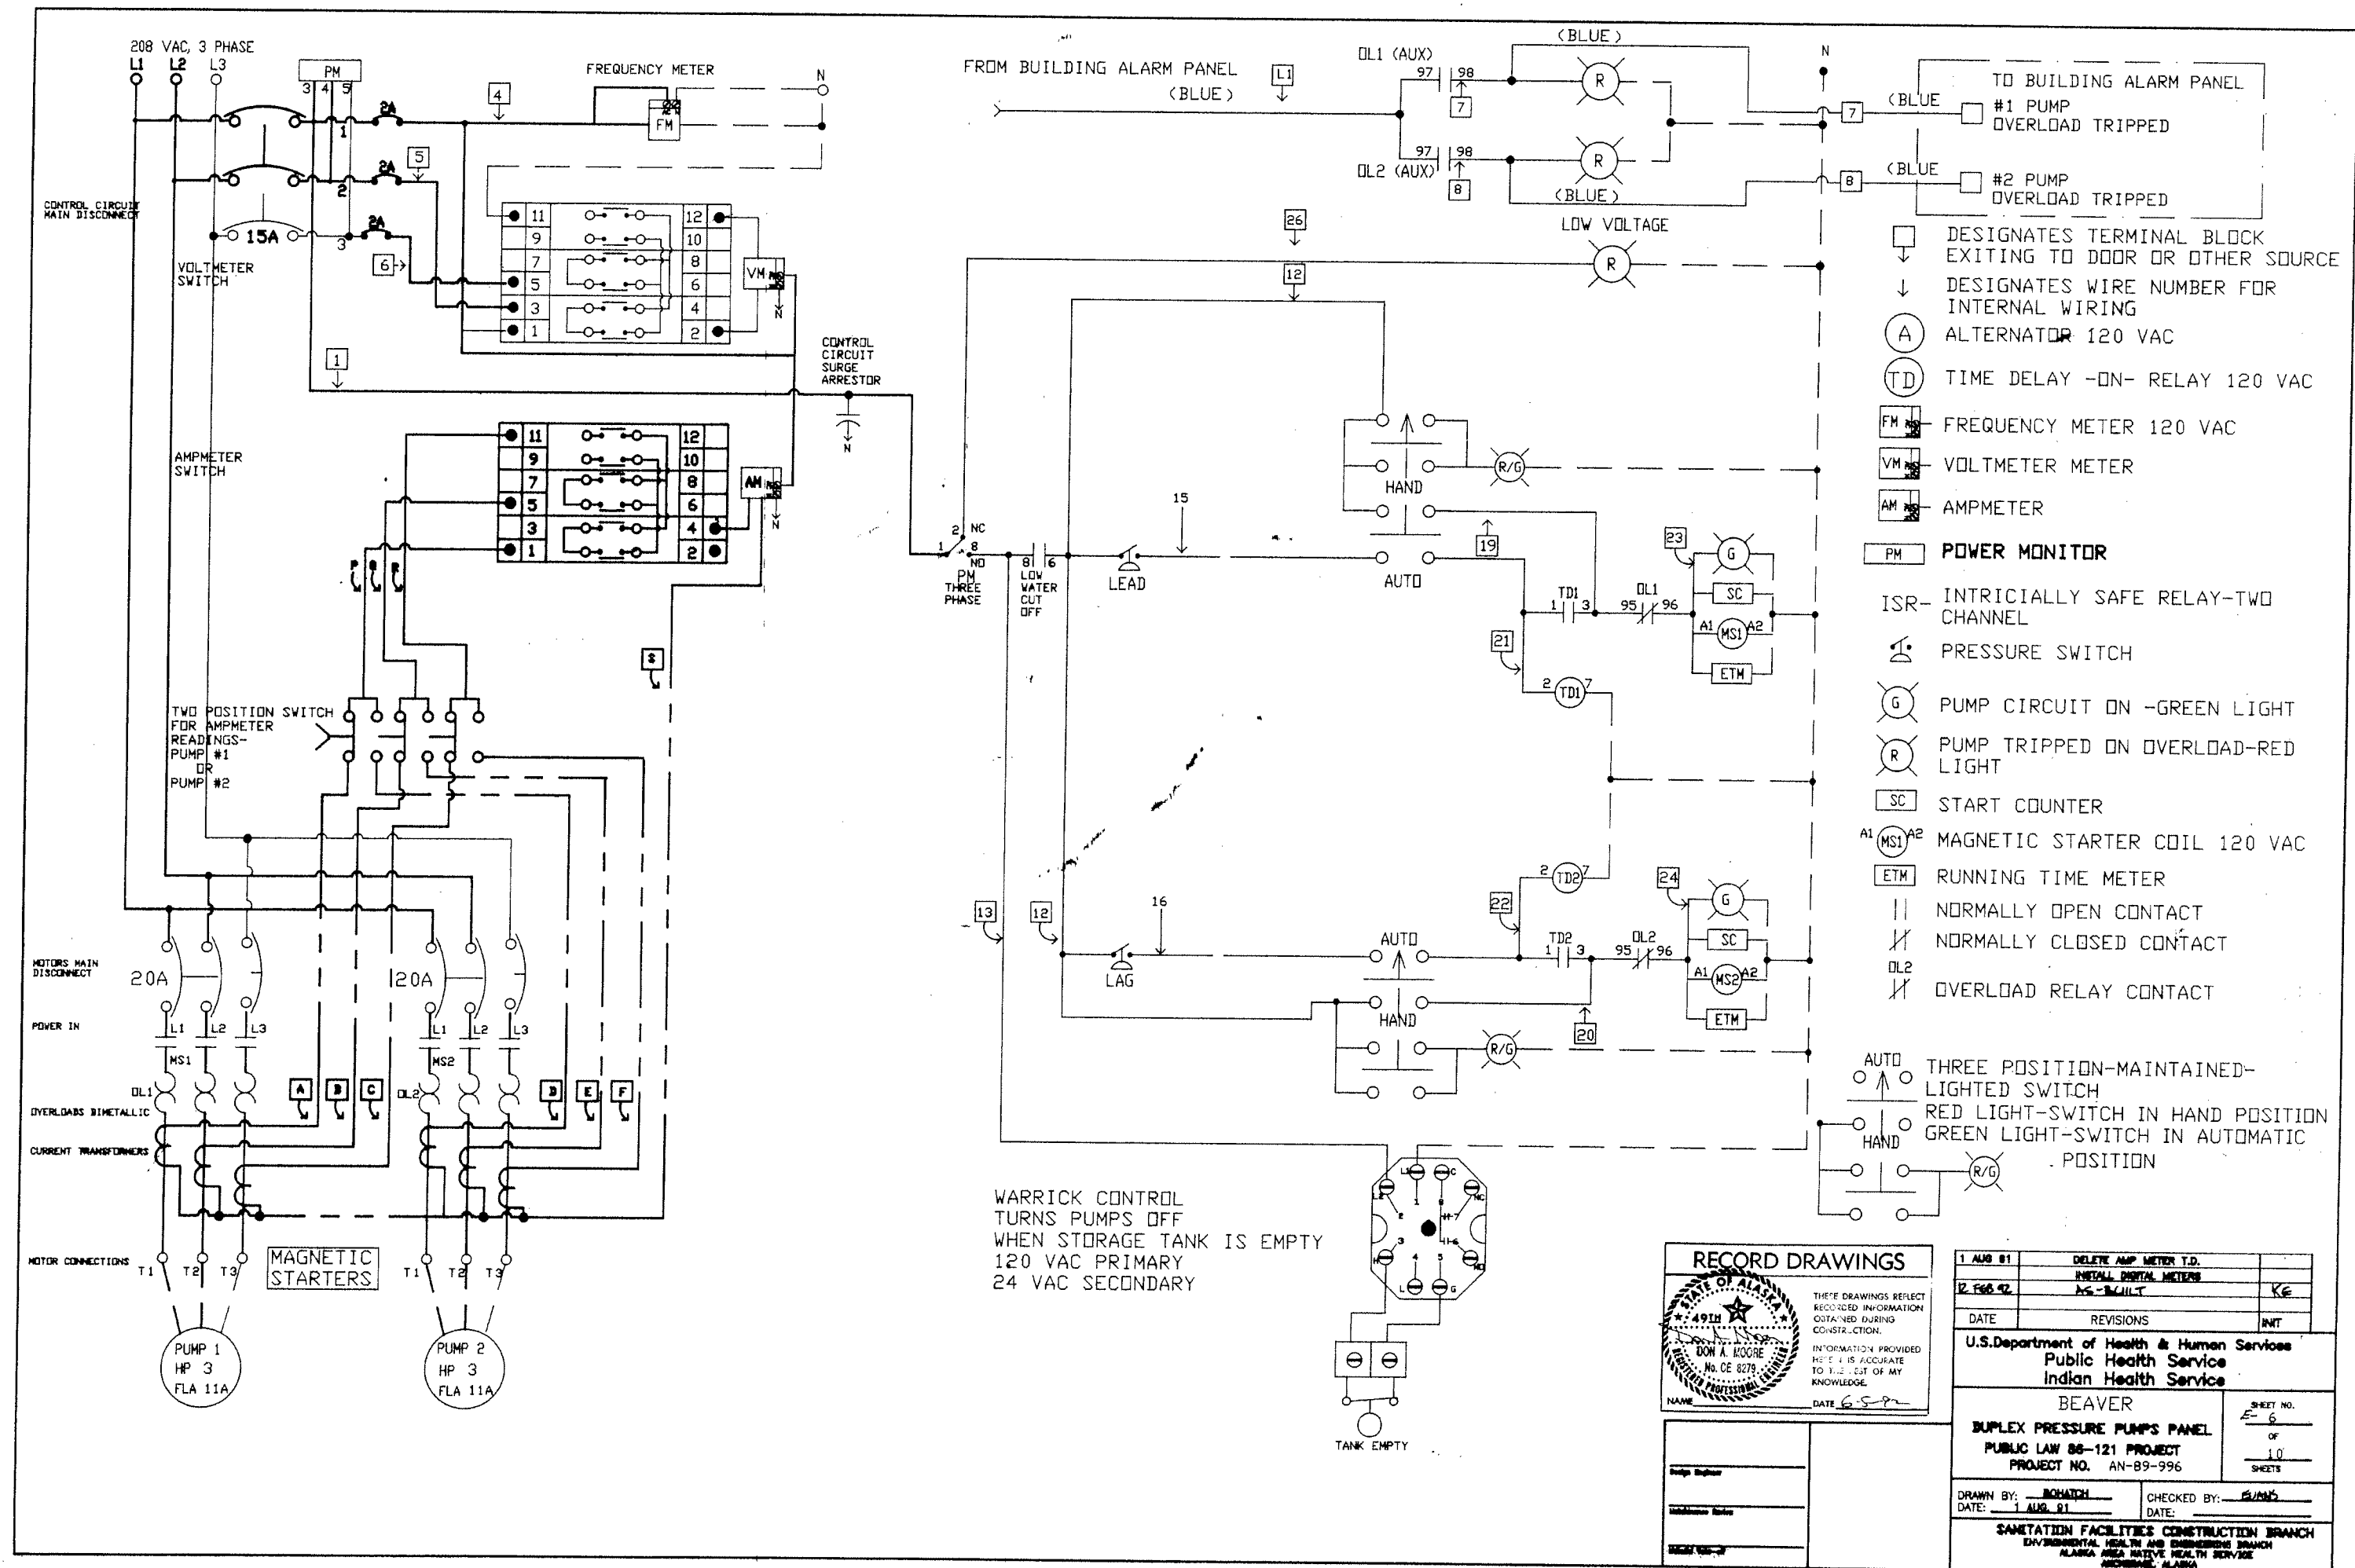

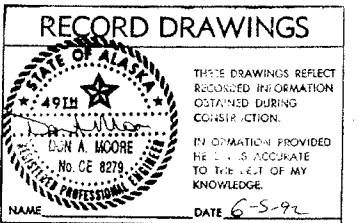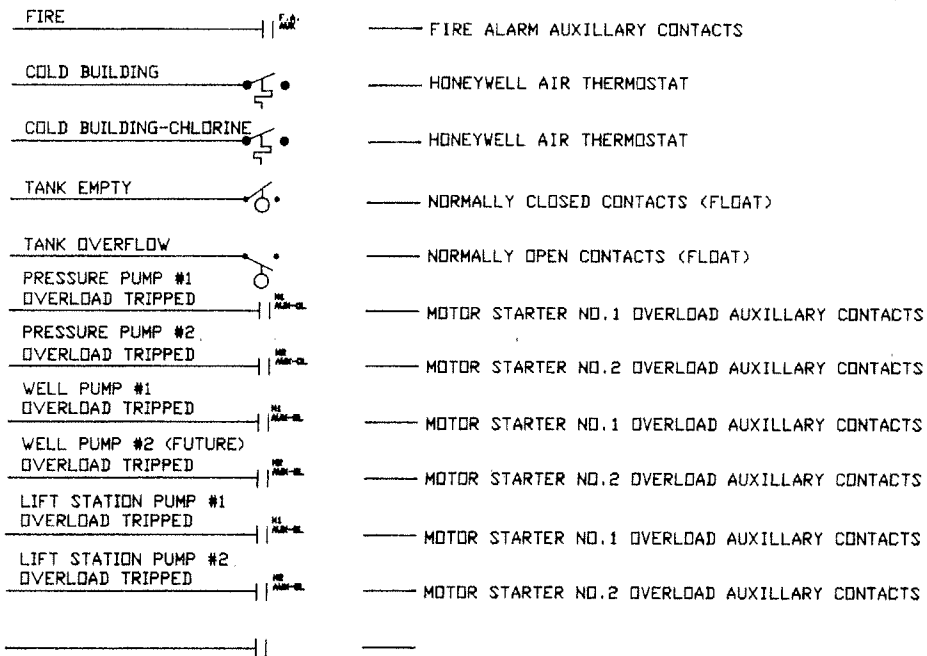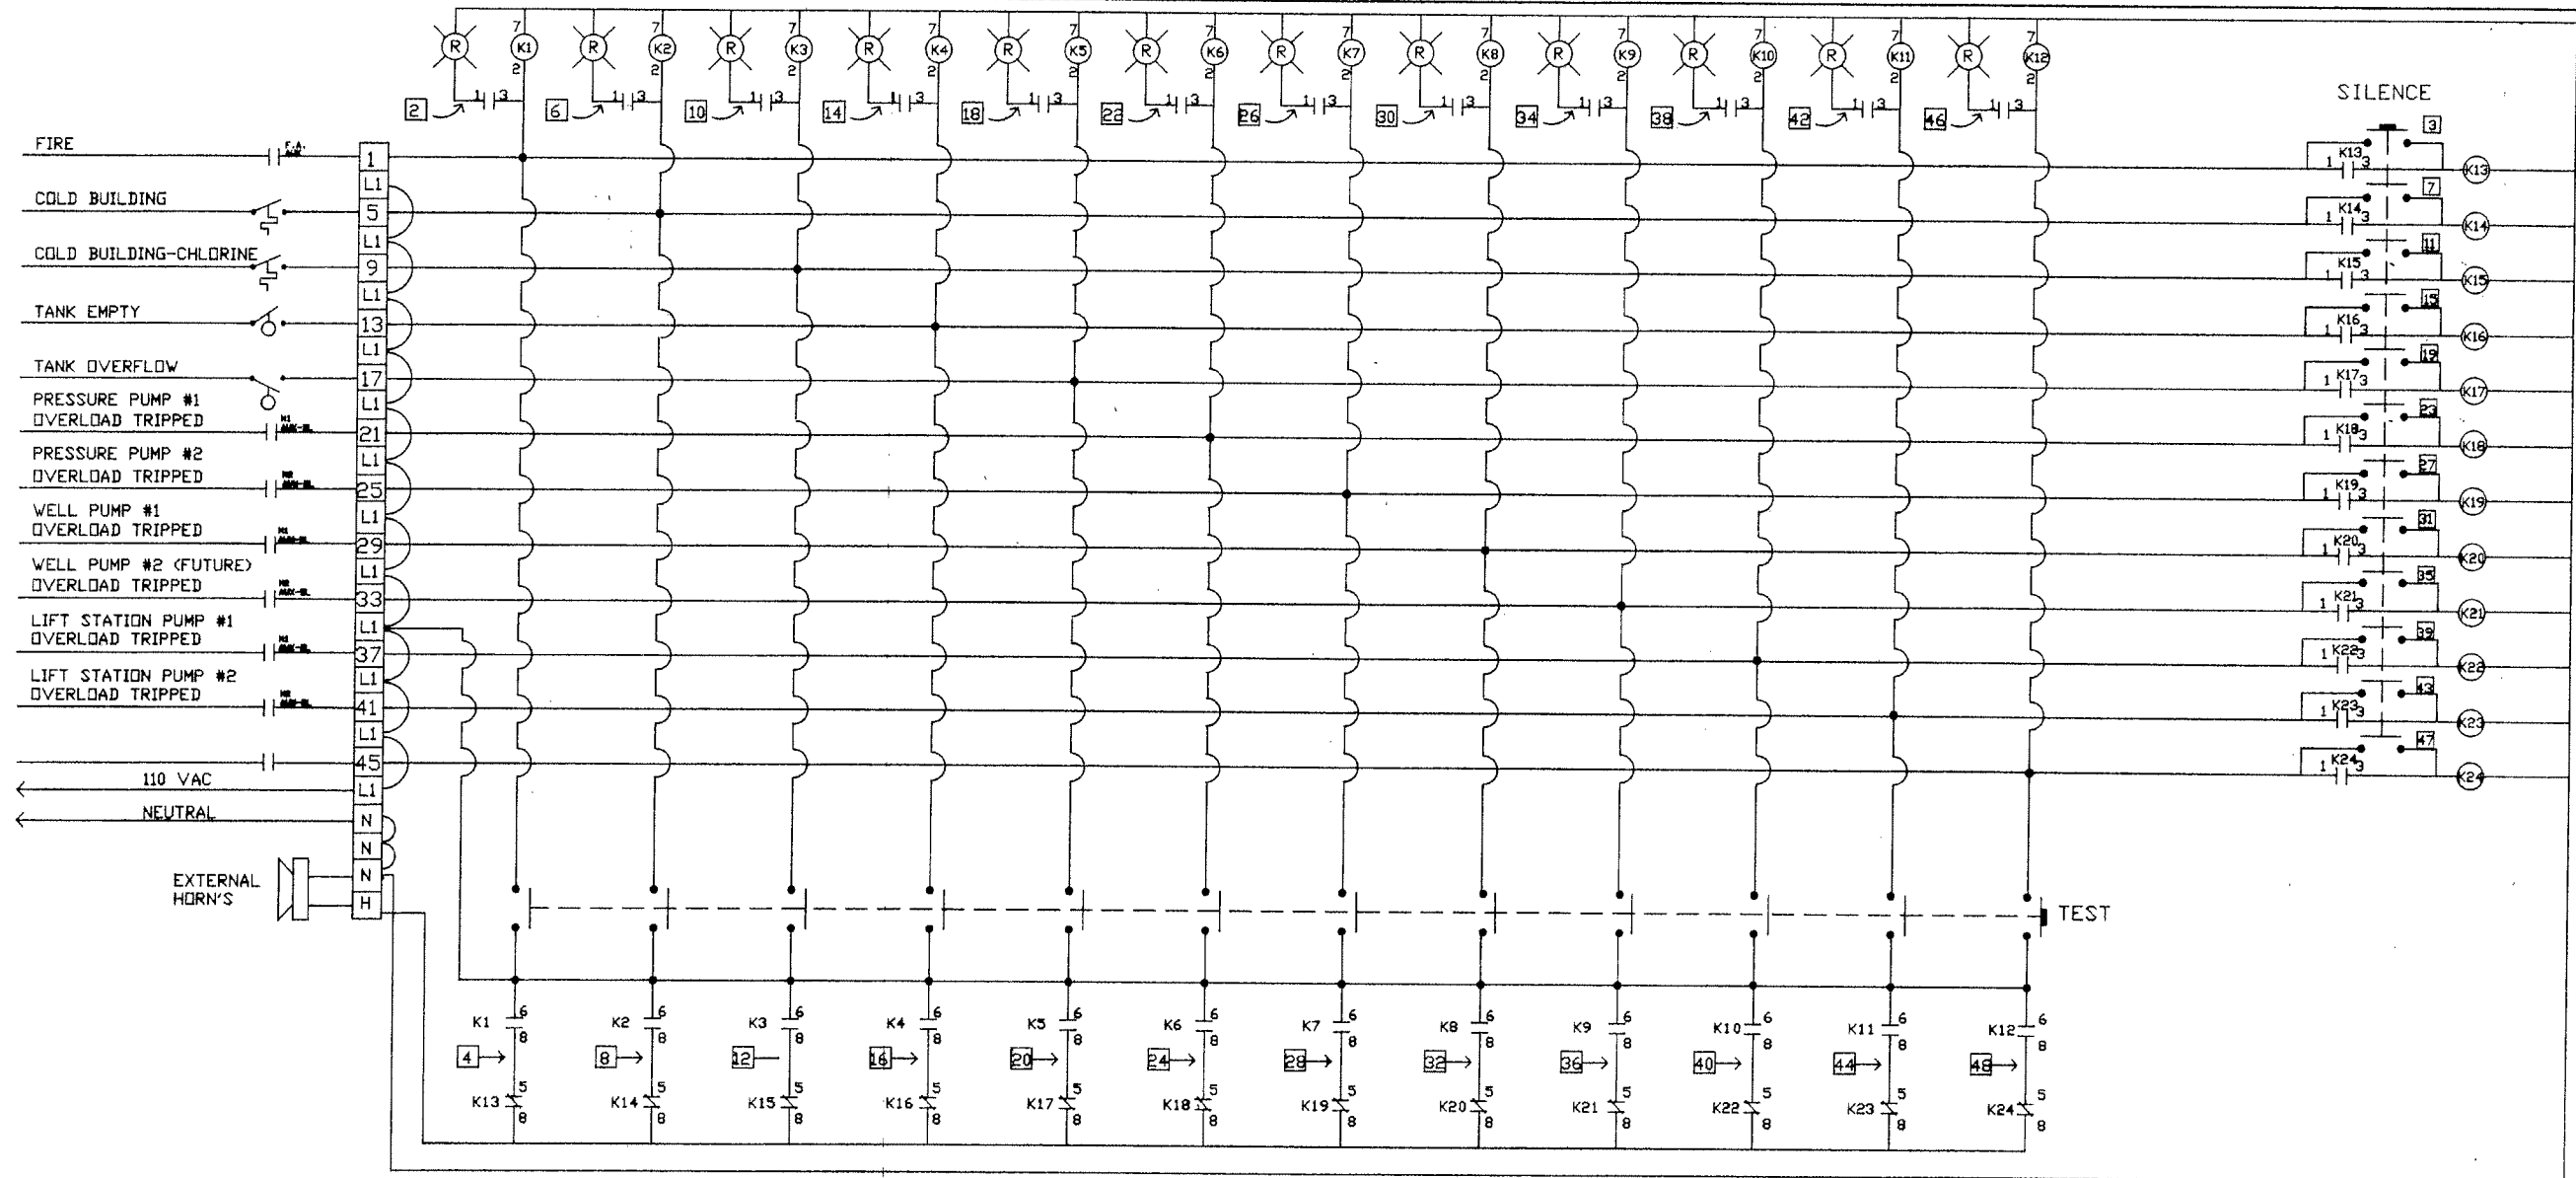


12. 6-5-92	AS-QUALITY	✓
DATE	REVISIONS	INT
U.S. Department of Health & Human Services Public Health Service Indian Health Service		
BEAVER		
12 CIRCUIT ALARM PANEL		SHEET NO. E-7
PUBLIC LAW 88-121 PROJECT		OF 10
PROJECT NO. AN-89-996		SHEETS
DRAWN BY: B. HATCH	CHECKED BY: E. HATCH	
DATE: FEBRUARY 1992	DATE:	
SANITATION FACILITIES CONSTRUCTION BRANCH ENVIRONMENTAL HEALTH AND ENGINEERING DIVISION ALASKA AREA NATIVE HEALTH SERVICE ANCHORAGE, ALASKA		


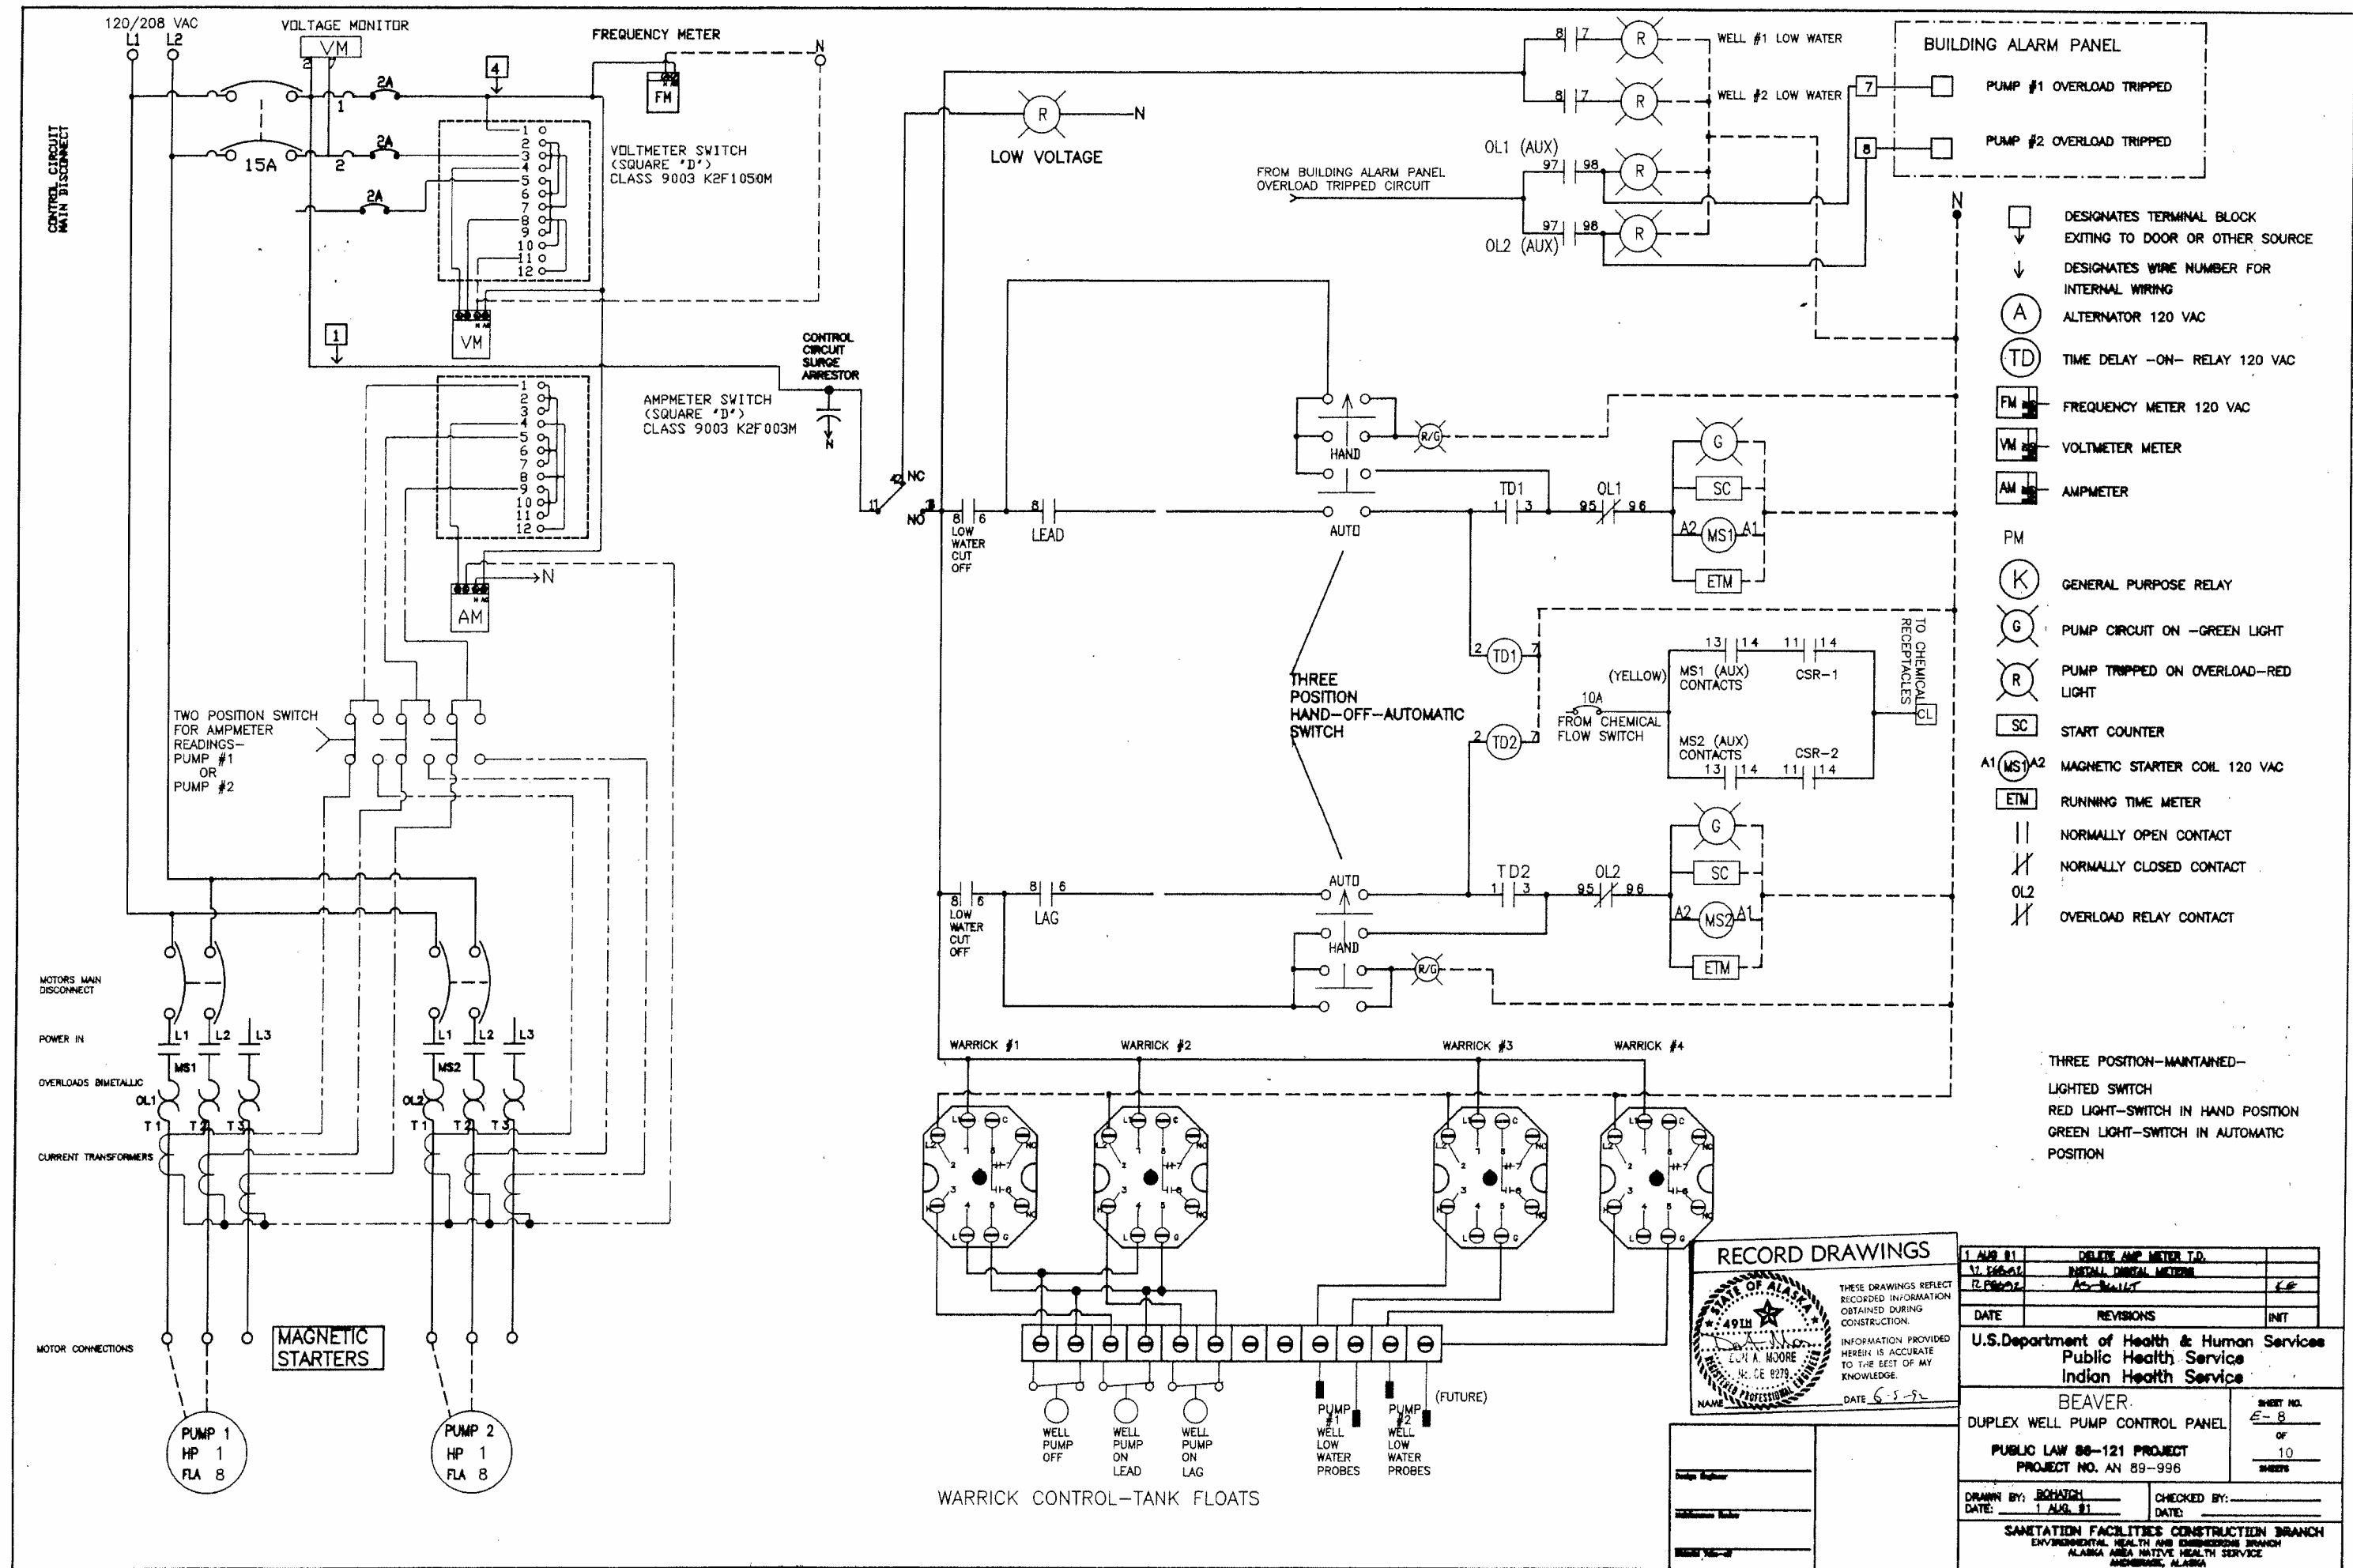


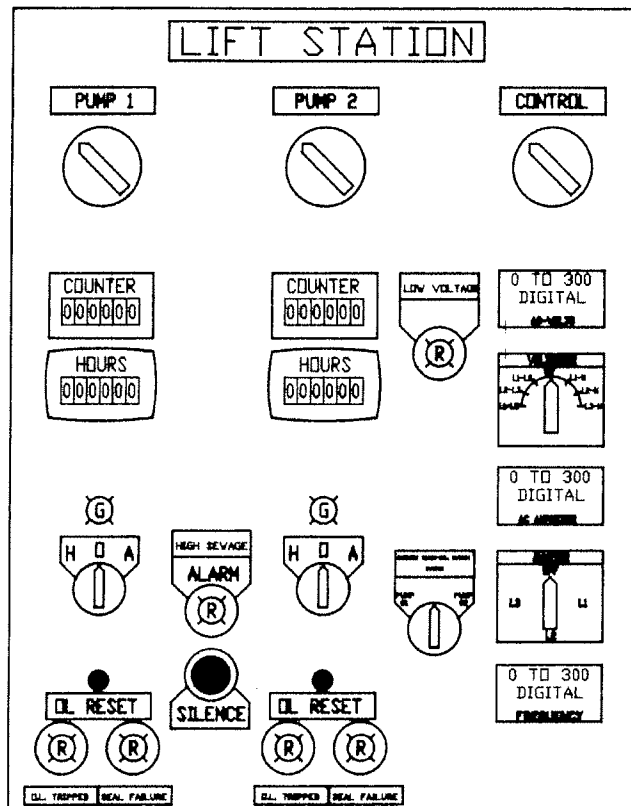


LIFT
STATION
PUMPS
3 HP
208 VAC
11 FLA

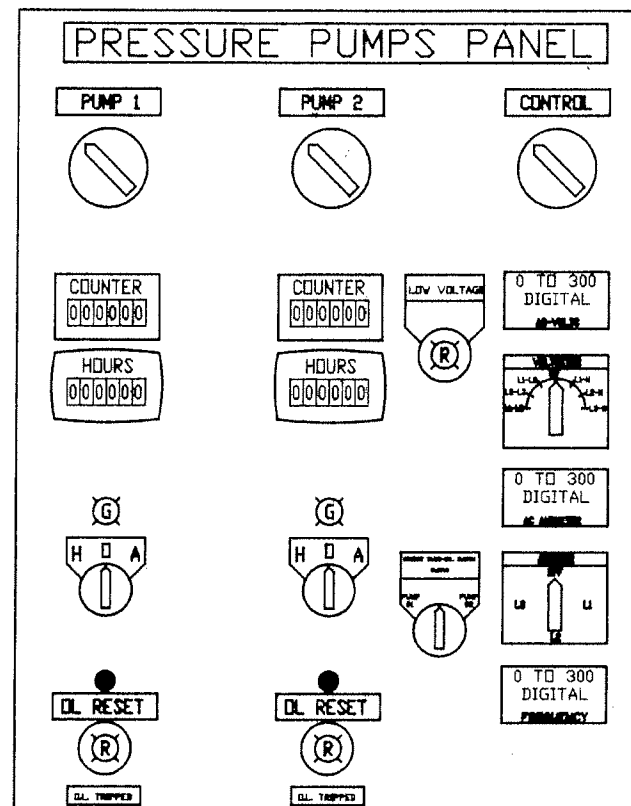

PRESSURE
PUMPS
3 HP
208 VAC
11 FLA

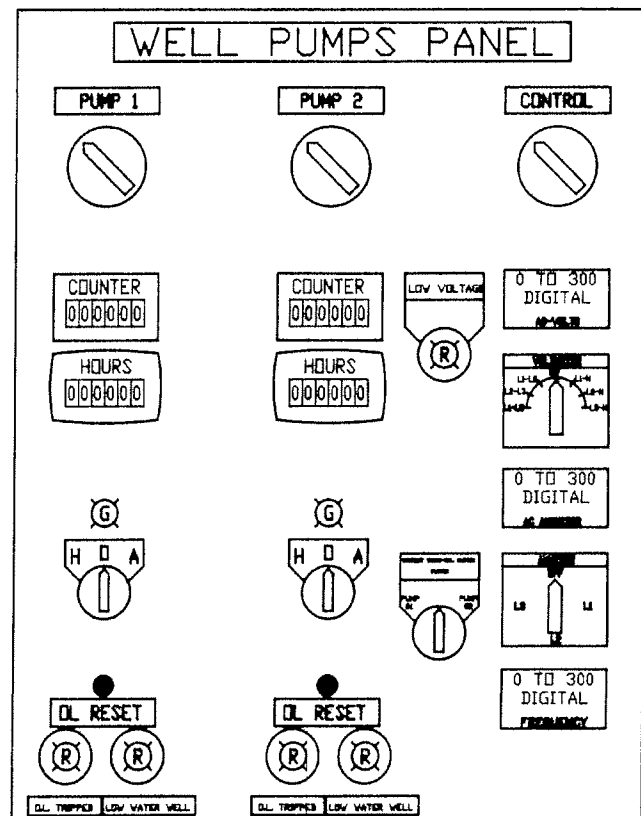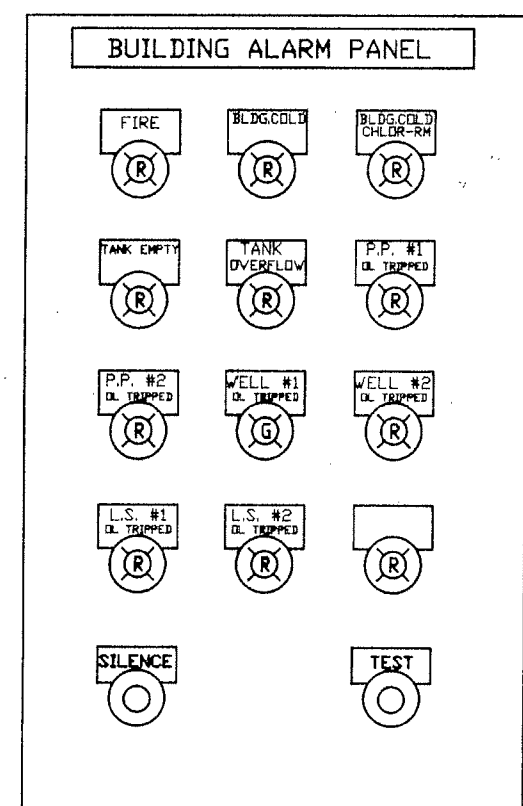

WELL
PUMPS
3 HP
208 VAC
11 FLA

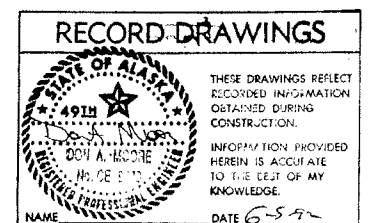

12.0000	AS BUILT	FE
DATE	REVISIONS	INIT
U.S. Department of Health & Human Services Public Health Service Indian Health Service		
BEAVER PANEL FACES		SHEET NO. E-9
PUBLIC LAW 86-121 PROJECT PROJECT NO. AN 89-996		OF 10 SHEETS
DRAWN BY: BOHATCH DATE: 1989		CHECKED BY: _____ DATE: _____
SANITATION FACILITIES CONSTRUCTION BRANCH ENVIRONMENTAL HEALTH AND ENGINEERING BRANCH ALASKA AREA NATIVE HEALTH SERVICE ANCHORAGE, ALASKA		