

TAKOTNA, ALASKA

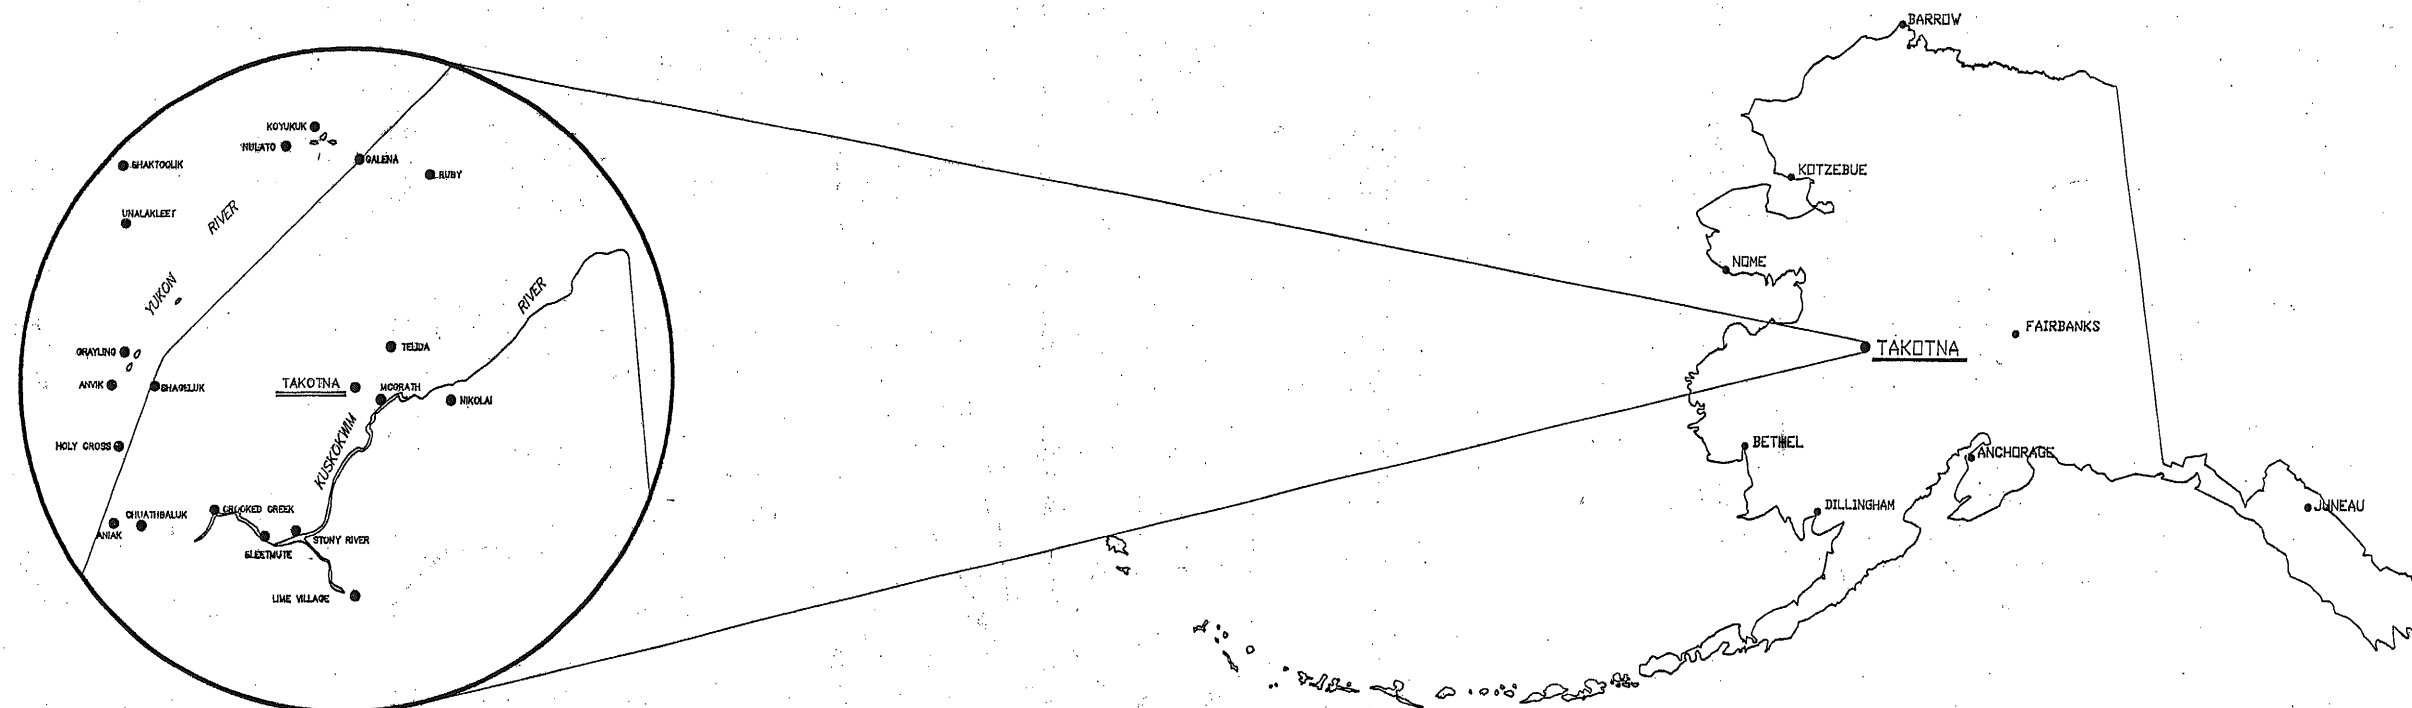


TABLE OF CONTENTS	
SHEET No.	ITEM
1	COVER SHEET
L-1	LEGEND AND NOTES
	DESIGN
D-1	DESIGN CRITERIA
D-2	AERIAL PHOTO
	CIVIL
C-1	SEPTIC TANK AND SEWER SERVICE LINE DETAILS
C-2	ABSORPTION FIELD LAYOUT AND DETAILS
	STRUCTURAL
S-1	WATER INTAKE/OUTLET DETAIL
	ARCHITECTURAL
A-1	WTP FLOOR PLAN AND ELEVATIONS
A-2	WTP CROSS SECTIONS
	MECHANICAL
M-1	WTP PLUMBING SCHEMATIC
M-2	WTP PIPE DETAIL
M-3	TYPICAL BOILER PIPING
M-4	FLUORIDATION AND CHLORINATION SYSTEM
M-5	WTP WATER POINT DETAILS
	ELECTRICAL
E-1	
SP-1	SPECIFICATION SHEET

U. S. DEPT OF HEALTH & HUMAN SERVICE
PUBLIC HEALTH SERVICE
INDIAN HEALTH SERVICE

ALASKA AREA NATIVE HEALTH SERVICE
OFFICE OF ENVIRONMENTAL HEALTH AND ENGINEERING
222 WEST 8 TH AVENUE #65
ANCHORAGE, ALASKA 99513-7561

PUBLIC LAW 86-121 PROJECT
PROJECT NO AN-91-679/057

LEGEND AND GENERAL NOTES

SITE PLAN

EXISTING

	STRUCTURES
	ROADS (PAVED)
	ROADS (UNPAVED)
	PROPERTY LINE
	COMMUNICATIONS LINE
	POWER LINE
	SEWER SERVICE LINE
	WATER SERVICE LINE
	CLEANOUT
	SEWER LINE
	WATER LINE
	FORCE MAIN
	FIRE HYDRANT, IN-LINE
	FIRE HYDRANT, OFFSET
	MANHOLE
	VALVE
	POL LINE (FUEL OIL)
	LIFT STATION W/BUILDING
	R.O.W. LINE
	WELL
	FENCE
	UTILIDOR
	RACEWAY
	RAILROAD
	BENCHMARK
	TEST HOLE
	ELEVATION
	SEPTIC TANK
	LEACHFIELD
	CORPORATION STOP
	BRASS CAP
	WATERING POINT
	POWER POLE
	CURB STOP
	RESIDENTIAL EFFLUENT PUMPING STATION (DOSING TANK)
	PEDESTAL
	TRANSFORMER
	WATER TREATMENT PLANT or WATER TREATMENT BUILDING
	WATER STORAGE TANK

PROPOSED THIS PROJECT

	STRUCTURES
	ROADS (PAVED)
	ROADS (UNPAVED)
	PROPERTY LINE
	COMMUNICATIONS LINE
	POWER LINE
	SEWER SERVICE LINE
	WATER SERVICE LINE
	CLEANOUT
	SEWER LINE
	WATER LINE
	FORCE MAIN
	FIRE HYDRANT, IN-LINE
	FIRE HYDRANT, OFFSET
	MANHOLE
	VALVE
	POL LINE (FUEL OIL)
	LIFT STATION W/BUILDING
	R.O.W. LINE
	WELL
	FENCE
	UTILIDOR
	RACEWAY
	RAILROAD
	BENCHMARK
	TEST HOLE
	ELEVATION
	SEPTIC TANK
	LEACHFIELD
	CORPORATION STOP
	BRASS CAP
	WATERING POINT
	POWER POLE
	CURB STOP
	RESIDENTIAL EFFLUENT PUMPING STATION (DOSING TANK)
	PEDESTAL
	TRANSFORMER
	WATER TREATMENT PLANT or WATER TREATMENT BUILDING
	WATER STORAGE TANK

MECHANICAL

	PRIMARY SYSTEM
	HOT WATER LINES
	HOT WATER RETURN LINES
	DRAIN & OVERFLOW LINE
	COLD WATER MAKE-UP LINE
	BY-PASS LINE
	BACK WASH LINE
	COLD WATER LINES
	LOW WATER CUT-OFF
	CHEMICAL PUMP
	CIRCULATING PUMP
	WATER METER
	GATE VALVE
	CHECK VALVE
	UNION
	DIELECTRIC UNION
	AUTOMATIC AIR RELIEF
	PRESSURE RELIEF VALVE
	ADAPTOR
	FLEX PIPE
	FLEX COUPLING
	AQUASTAT
	FLOW SWITCH
	PRESSURE SWITCH
	THERMOMETER
	PRESSURE REDUCING VALVE
	PRESSURE GAUGE
	FLOW INDICATOR
	THERMOFLO INDICATOR
	CIRCUIT SETTER
	DIRECTION OF FLOW
	VACUUM BREAKER
	TANK LEVEL INDICATOR

PIPE FITTING & VALVE SYMBOLS

	ANGLE VALVE		90° LONG RADIUS ELBOW
	CAP		VICTAULIC COUPLING
	CROSS		VACUUM BREAKER
	ELBOW (ELL), 45°		FLOOR DRAIN
	ELBOW, 90°		BALL VALVE
	LATERAL		CHECK BALL VALVE
	TEE		SOLENOID VALVE
	STRAINER		MOTORIZED VALVE
	DIELECTRIC FLANGE PKG.		MOTORIZED 3-WAY VALVE
	FLANGE JOINT		GLOBE VALVE
	SCREWED JOINT		BALANCING VALVE
	WELDED JOINT		AUTO. TEMP CONTROL VALVE
	SOLDERED JOINT		AUTO. TEMP CONTROL VALVE
	SLEEVE		QUICK OPENING VALVE
	DRESSER COUPLING		FUSIBLE VALVE
	EXPANSION JOINT		BUTTERFLY VALVE
	REDUCER, CONCENTRIC		

ELECTRICAL

	CONDUIT, SURFACE MOUNTED
	CONDUIT, BURIED OR IN-SLAB
	HOMERUN TO CIRCUIT BREAKER PANEL
	CONDUIT W/NO. OF WIRES INDICATED, ONE NEUTRAL, TWO HOT, AWG 12, CU
	INCANDESCENT FIXTURE
	INCANDESCENT FIXTURE, WALL MOUNTED
	FLUORESCENT FIXTURE
	VAPOR TIGHT LIGHT FIXTURE
	HIGH PRESSURE SODIUM LIGHT FIXTURE
	INCANDESCENT FIXTURE, RECESSED
	FLUORESCENT FIXTURE, RECESSED
	DUPLEX RECEPTACLES
	QUADRAPLEX RECEPTACLES
	SPECIAL PURPOSE RECEPTACLES
	SINGLE POLE SWITCH
	3-WAY SWITCH
	JUNCTION BOX
	THERMOSTAT
	TRANSFORMER
	AQUASTAT
	PHOTO CELL
	RELAY
	MOTOR OPERATED VALVE (ZONE VALVE)
	SOLENOID VALVE
	CONTROLLER
	MOTOR STARTER, MANUAL
	MOTOR STARTER, MAGNETIC
	SWITCHING PANEL
	CIRCUIT BREAKER PANEL
	ALARM PANEL
	HEAT DETECTOR
	SMOKE DETECTOR
	BELL
	ALARM HORN
	METER BASE
	MOTOR W/HORSEPOWER INDICATED
	FLOAT SWITCH
	PRESSURE SWITCH
	FLOW SWITCH
	UNIT HEATER
	EMERGENCY LIGHT
	EXIT LIGHT
	SYSTEM GROUND
	THERMOSTAT
	SWITCHED RECEPTACLE
	PUSH-BUTTON SWITCH
	FAN
	FIXTURE W/PULL CHAIN

NOTES

CIVIL

1. MINIMUM VERTICAL SEPARATION BETWEEN WATER LINE & SEWER LINE AT THE CROSSING POINT SHALL BE 18".
2. MINIMUM HORIZONTAL SEPARATION BETWEEN WATER LINE & SEWER LINE SHALL BE 10.0'.
3. MINIMUM BURY ON WATER LINE SHALL BE 4 FEET
4. LOCATION OF ALL WELLS, SEPTIC TANKS, MANHOLES, CLEANOUTS, VALVES, ETC. SHALL BE REFERENCED TO THREE PERMANENT ABOVE GROUND STRUCTURES.
5. CLEANOUTS, LEACHFIELDS AND SEPTIC TANKS ARE NUMBERED ACCORDING TO CORRESPONDING MANHOLE, i.e., MH-1, ST-1A, LF-1A AND CO-1A.


MECHANICAL

1. ALL EXPOSED PIPING SHALL BE PAINTED USING THE FOLLOWING COLOR CODE:
GREEN - RAW WATER
BLUE - POTABLE WATER
BLACK - HEATING
RED - FIRE
BROWN - SEWAGE
GRAY - COMPRESSED AIR
ORANGE - FUEL
YELLOW - WASTE HEAT RECOVERY
2. TYPE OF PAINT TO BE USED SHALL BE GARLOCK OR APPROVED EQUAL.
3. DIRECTION OF FLOW SHALL BE INDICATED BY ARROWS AND A NAME PLATE SHALL BE ATTACHED DESCRIBING MATERIAL BEING CARRIED.
4. ALL PIPING SHALL BE COPPER UNLESS OTHERWISE INDICATED.
5. ALL SOLDER CONNECTIONS SHALL BE LEAD FREE ANTIMONY FREE SOLDER.
6. ALL HOT WATER LINES SHALL BE INSULATED.
7. ALL PIPE SUPPORTS AND HANGERS SHALL HAVE 1/2" INSULATION BETWEEN COPPER PIPE AND SUPPORTS OR HANGERS.
8. PRESSURE TESTING REQUIREMENTS FOR WATER MAINS AND SERVICES, AND SEWER MAINS AND SERVICES SHALL BE IN ACCORDANCE WITH SFS GUIDELINE C-39.
9. TESTING REQUIREMENTS FOR DRAIN WASTE AND VENT PLUMBING, WATER SUPPLY PIPING AND HYDRONICS PIPING SHALL BE IN ACCORDANCE WITH SECTION 318 OF 1988 UNIFORM PLUMBING CODE.

ELECTRICAL

1. CLEAR AREA REQUIRED FOR ELECTRICAL PANELS:
36" FROM FACE OF PANEL
75" FROM FLOOR UP TO FIRST OBSTRUCTION
15" CLEAR EACH SIDE FROM CENTER LINE OF PANEL
2. GROUND SYSTEM NEUTRAL AND ALL METALLIC SURFACES PER 1990 NATIONAL ELECTRICAL CODE (N. E. C.).
3. ALL WIRING SHALL BE IN CONDUIT, UNLESS OTHERWISE SPECIFIED

DATE	REVISIONS	INITIALS
U. S. Department of Health, & Human Services Public Health Service Indian Health Service		
TAKOTNA, ALASKA		SHEET NO. OF TOTAL SHEETS
LEGEND & NOTES PUBLIC LAW 86-121 PROJECT PROJECT NO. AN-91-679/057		
DRAWN BY: WKT	CHECKED BY:	

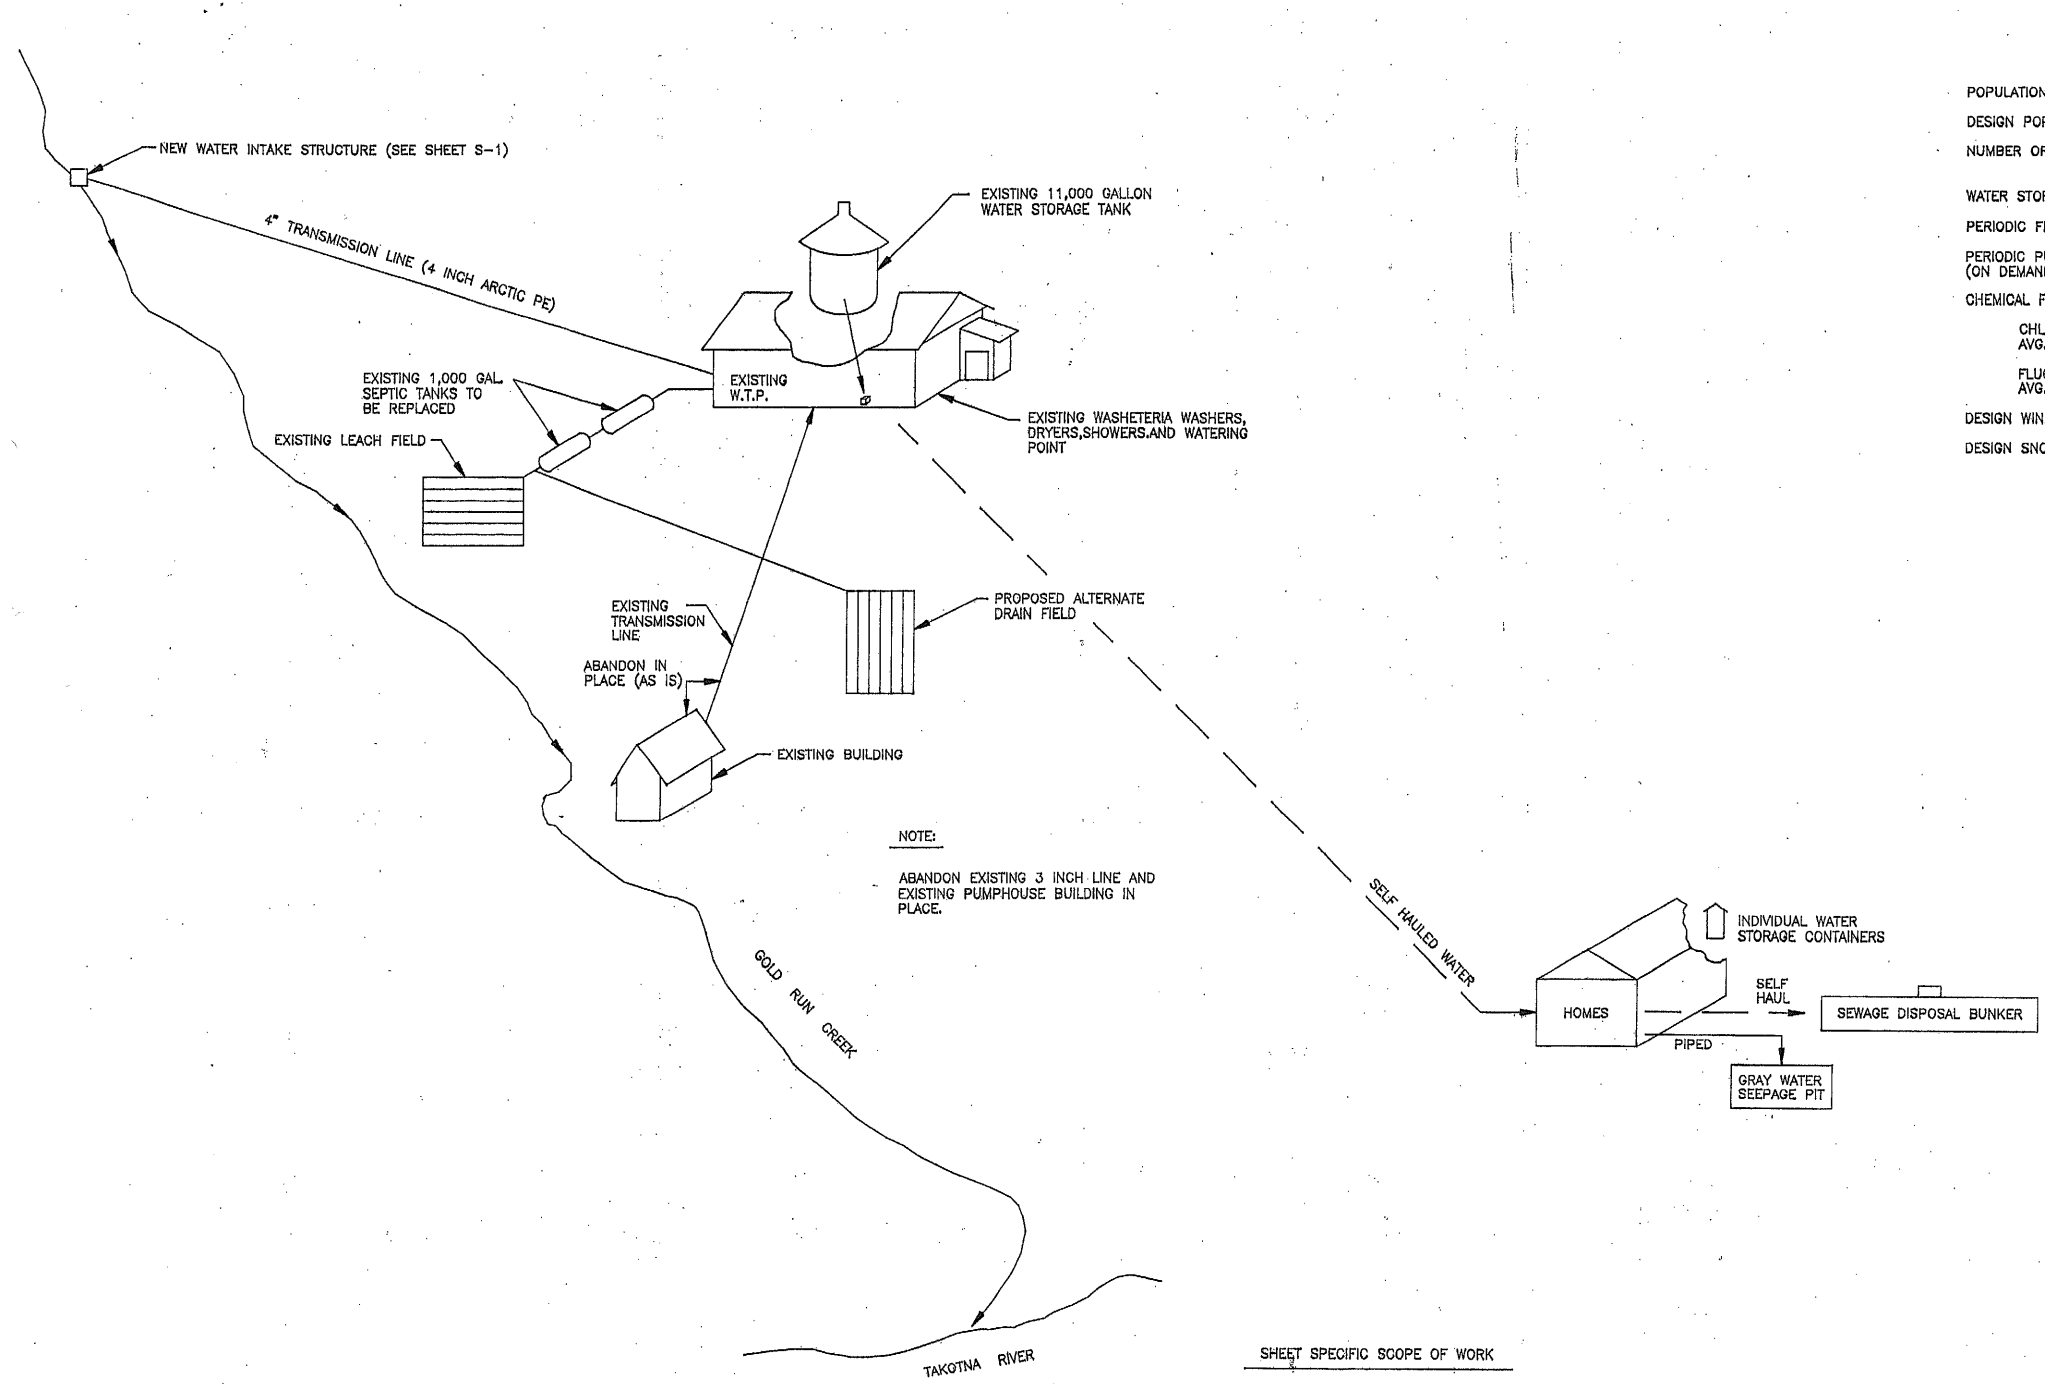

DESIGN CRITERIA	
POPULATION	40
DESIGN POPULATION	50
NUMBER OF HOUSES	24 (OCCUPIED FULL TIME) 36 (TOTAL EXISTING HOUSES)
WATER STORAGE	11,000 GALLONS
PERIODIC FILL PUMP	1 @ 1 HP
PERIODIC PUMPING RATE (ON DEMAND)	25 gpm
CHEMICAL FEED SYSTEM	
CHLORINE SOURCE	CALCIUM HYPOCHLORITE
AVG. FEED RATE	1 PPM
FLUORIDE SOURCE	GRANULAR SODIUM FLUORIDE
AVG. FEED RATE	1 PPM
DESIGN WIND LOAD	40 POUNDS/SQ. FT. (HORIZONTAL)
DESIGN SNOW LOAD	30 POUNDS/SQ. FT. (VERTICAL)

- SHEET SPECIFIC SCOPE OF WORK
1. CONSTRUCT ALTERNATE DRAINFIELD.
 2. REPLACE EXISTING 1,000 GALLON SEPTIC TANKS LOCATED IN ROADWAY (2) AND PLACE NEW SEPTIC TANKS OUT OF ROADWAY.
 3. CONSTRUCT NEW WATER INTAKE STRUCTURE APPROXIMATELY 400 FEET. UPSTREAM OF EXISTING WATER INTAKE STRUCTURE.
 4. INSTALL NEW 4 INCH ARCTIC PE TRANSMISSION LINE BETWEEN NEW INTAKE STRUCTURE AND EXISTING WTP.

U.S. Department of Health & Human Services Public Health Service Indian Health Service	
TAKOTNA, ALASKA	
DESIGN CRITERIA	
PUBLIC LAW 86-121 PROJECT	
PROJECT NO. AN-91-679/057	
DRAWN BY: WKT DATE: 4-92	CHECKED BY: DATE:

SHEET NO. D-1	OF 2
TOTAL SHEETS	


- SCOPE OF WORK
1. TO INSTALL A 4 INCH ARCTIC P.E. WATER TRANSMISSION LINE AND WATER INTAKE STRUCTURE.
 2. UPGRADE WTP APPURTANENCES.
 3. REHAB WASHETERIA (RESTROOMS, WASHERS, AND DRYERS).
 4. CONSTRUCT ALTERNATE DRAINFIELD.
 5. TO RELOCATE ORIGINAL SEPTIC TANKS AND REPLACE THEM WITH NEW SEPTIC TANKS SO THAT THE TANKS ARE NO LONGER IN THE ROAD.

DATE	REVISIONS	INITIALS

U. S. Department of Health & Human Services
Public Health Service
Indian Health Service

TAKOTNA, ALASKA AERIAL PHOTO PUBLIC LAW 86-121 PROJECT PROJECT NO. AN-91-679/057	SHEET NO. D-2 OF 2 TOTAL SHEETS
---	---

Design Engineer
[Signature]

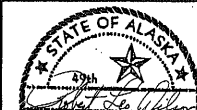

DATE OF PHOTO 9-15-89
SCALE 1" = 100'

DRAWN BY: WKT
CHECKED BY:

TABLE 1


STRUCTURE	SIZE OF ABSORPTION FIELD REQUIRED(FT ²)	TOTAL LENGTH OF TRENCH REQUIRED(FT)	APPROXIMATE NUMBER OF INFILTRATOR SECTIONS(EA)
2 BEDROOM	N/A	N/A	N/A
3 BEDROOM	N/A	N/A	N/A
4 BEDROOM	N/A	N/A	N/A
WASHETERIA	2,600 SQ FT	867 FEET	144

TABLE 2

MINIMUM SEPARATIONS TO BE OBSERVED IN INSTALLATION OF SEPTIC TANK AND ABSORPTION FIELD IN ACCORDANCE WITH 1890 ADCE WASTE WATER REGULATIONS:		
FROM	TO	MINIMUM SEPARATION
SEPTIC TANK	DWELLING	10 FEET
SEPTIC TANK	ABSORPTION FIELD	10 FEET
ABSORPTION FIELD	PROPERTY LINE	10 FEET
ABSORPTION FIELD	WATER LINE	10 FEET
SEPTIC TANK	WATER LINE	10 FEET
ABSORPTION FIELD	WELL (PRIVATE)	100 FEET
SEPTIC TANK	WELL (PRIVATE)	100 FEET
PRIVATE SEWER LINE	WELL (PRIVATE)	25 FEET
ABSORPTION FIELD	LAKE, RIVER	100 FEET
ABSORPTION FIELD	CUT OR FILL BANK	50 FEET
PRIVATE SEWER CLEANOUT	WELL (PRIVATE)	25 FEET

TABLE 3

GEOGRAPHICAL LOCATION	MINIMUM DEPTH OF GROUND COVER (IN FEET)	MINIMUM DEPTH TO SEASONAL HIGH WATER TABLE (IN FEET)	MINIMUM DEPTH TO IMPERMEABLE STRATA (IN FEET)
SOUTHEAST ALASKA (EAST OF 141 DEGREE W, LONGITUDE	3	8	10
SOUTHWEST ALASKA (KODIAK ISLAND BOROUGH AND ALL AREAS SOUTHWEST OF CHIGNIK INCLUDING CHIGNIK)	2	7	9
VALDEZ AND THE AREA ENCLOSED BY THE VALDEZ BASIN	3	8	10
ALL REMAINING AREAS OF THE STATE	4	9	11

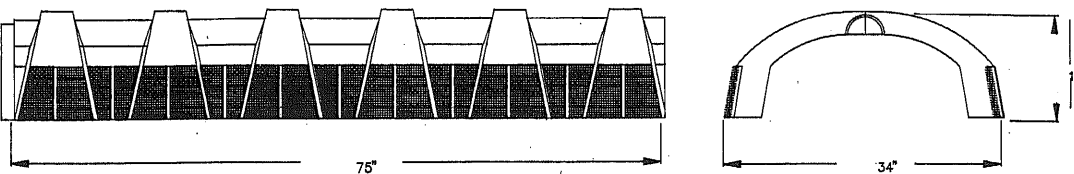


STANDARD INFILTRATION UNIT

NOT TO SCALE


NOTES:

1. MINIMUM DEPTH OF GROUND COVER OVER INFILTRATOR SHALL BE IN ACCORDANCE WITH TABLE 3. SUBSTITUTION OF 2 INCHES OF EXTRUDED POLYSTYRENE INSULATION FOR EACH FOOT OF EARTH COVER LESS THE SPECIFIED COVER DEPTH IS ALLOWED, HOWEVER AT LEAST 2 FEET MINIMUM EARTH COVER IS REQUIRED.
2. BOTTOM OF INFILTRATOR SYSTEM SHALL BE PLACED 4 FEET ABOVE HIGHEST RECORDED WATER TABLE. HIGH WATER TABLE SHALL BE VERIFIED BY THE FIELD ENGINEER AT TIME OF EXCAVATION.
3. BACKFILL MATERIAL AROUND INFILTRATOR UNITS MAY BE OBTAINED FROM THE TRENCH EXCAVATION. MATERIAL MUST BE NON-ORGANIC.
4. INSTALL INFILTRATOR UNITS IN ACCORDANCE WITH MANUFACTURER'S RECOMMENDATIONS AND THESE PLANS.
5. ABSORPTION FIELD SYSTEM SHALL BE STANDARD CAPACITY INFILTRATOR AS MANUFACTURED BY INFILTRATOR SYSTEM INC. 123 ELM STREET, SUITE 12, OLD SAYBROOK CT. 06475 OR APPROVED EQUAL.
6. THE ABSORPTION FIELD MAY BE DOWN-SIZE OR ENLARGE TO MATCH THE SOIL CONDITIONS AND PERCOLATION RATES AT A PARTICULAR LOCATION. THE SIZE OF THE ABSORPTION FIELD WILL BE DETERMINED BY THE PROJECT ENGINEER ACCORDING TO THE DEPARTMENT OF ENVIRONMENTAL CONSERVATION REGULATIONS.
7. THE SIZE OF THE ABSORPTION FIELD WILL BE DETERMINED BY THE PROJECT ENGINEER ACCORDING TO THE DEPARTMENT OF ENVIRONMENTAL CONSERVATION REGULATIONS.
8. A STANDARD INFILTRATOR SPLASH PAD OR APPROVED EQUAL SHALL BE INSTALLED AT THE INLET OF EACH INFILTRATOR ROW.
9. MONITORING TUBES ARE REQUIRED AT THE END OF EACH LATERAL ABSORPTION FIELD LINE.

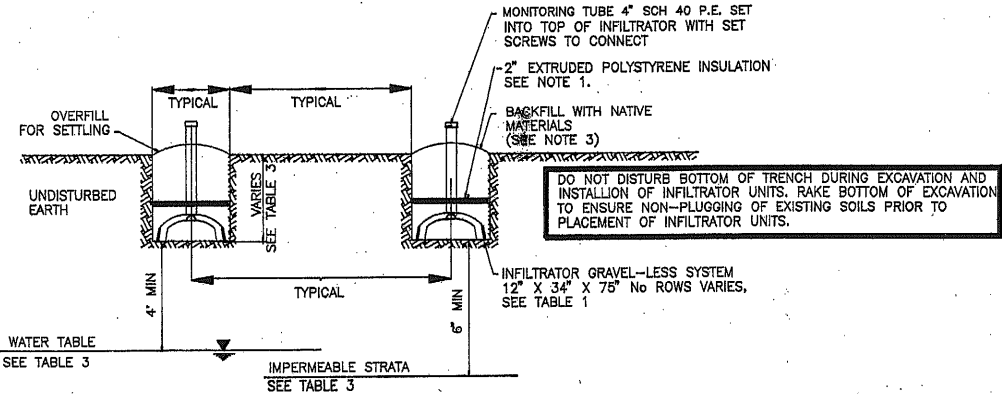

TYPICAL ABSORPTION FIELD SECTION

NOT TO SCALE

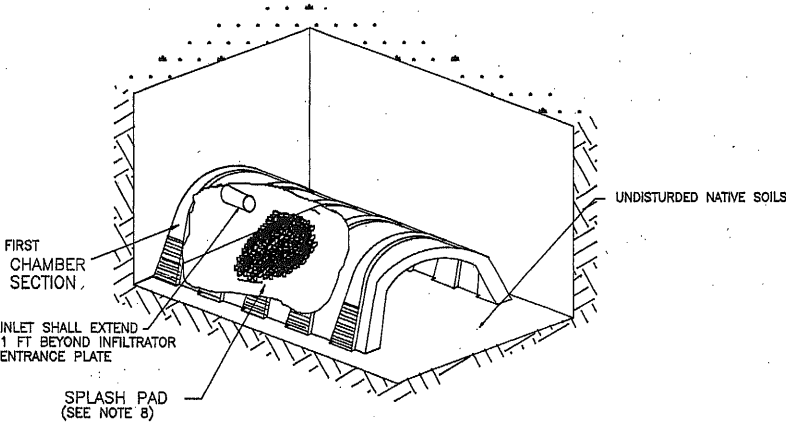


ISOMETRIC VIEW CHAMBER ABSORPTION FIELD

NOT TO SCALE


NOTE: THIS DRAWING WAS DEVELOPED AS A STANDARD DETAIL FOR AANH'S SANITATION FACILITIES CONSTRUCTION PROGRAM. PROJECT SPECIFIC MODIFICATIONS SHALL BE HIGHLIGHTED AND ARE THE RESPONSIBILITY OF THE PROJECT DESIGN ENGINEER.

- SITE SPECIFIC NOTES:
1. WASHETERIA WASTEWATER SYSTEM SHALL BE LOCATED OUTSIDE OF 200 FOOT PROTECTION RADIUS OF WATER SOURCE.
 2. WASHETERIA SEPTIC TANK SHALL BE 1,000 GALLON STEEL SEPTIC TANK (TWO-SEPTIC TANKS TOTAL).

- SHEET SPECIFIC SCOPE OF WORK:
1. CONSTRUCT NEW SEPTIC DRAINFIELD.
 2. PLACE BOARDSTOCK INSULATION OVER HEADER (2\"/>

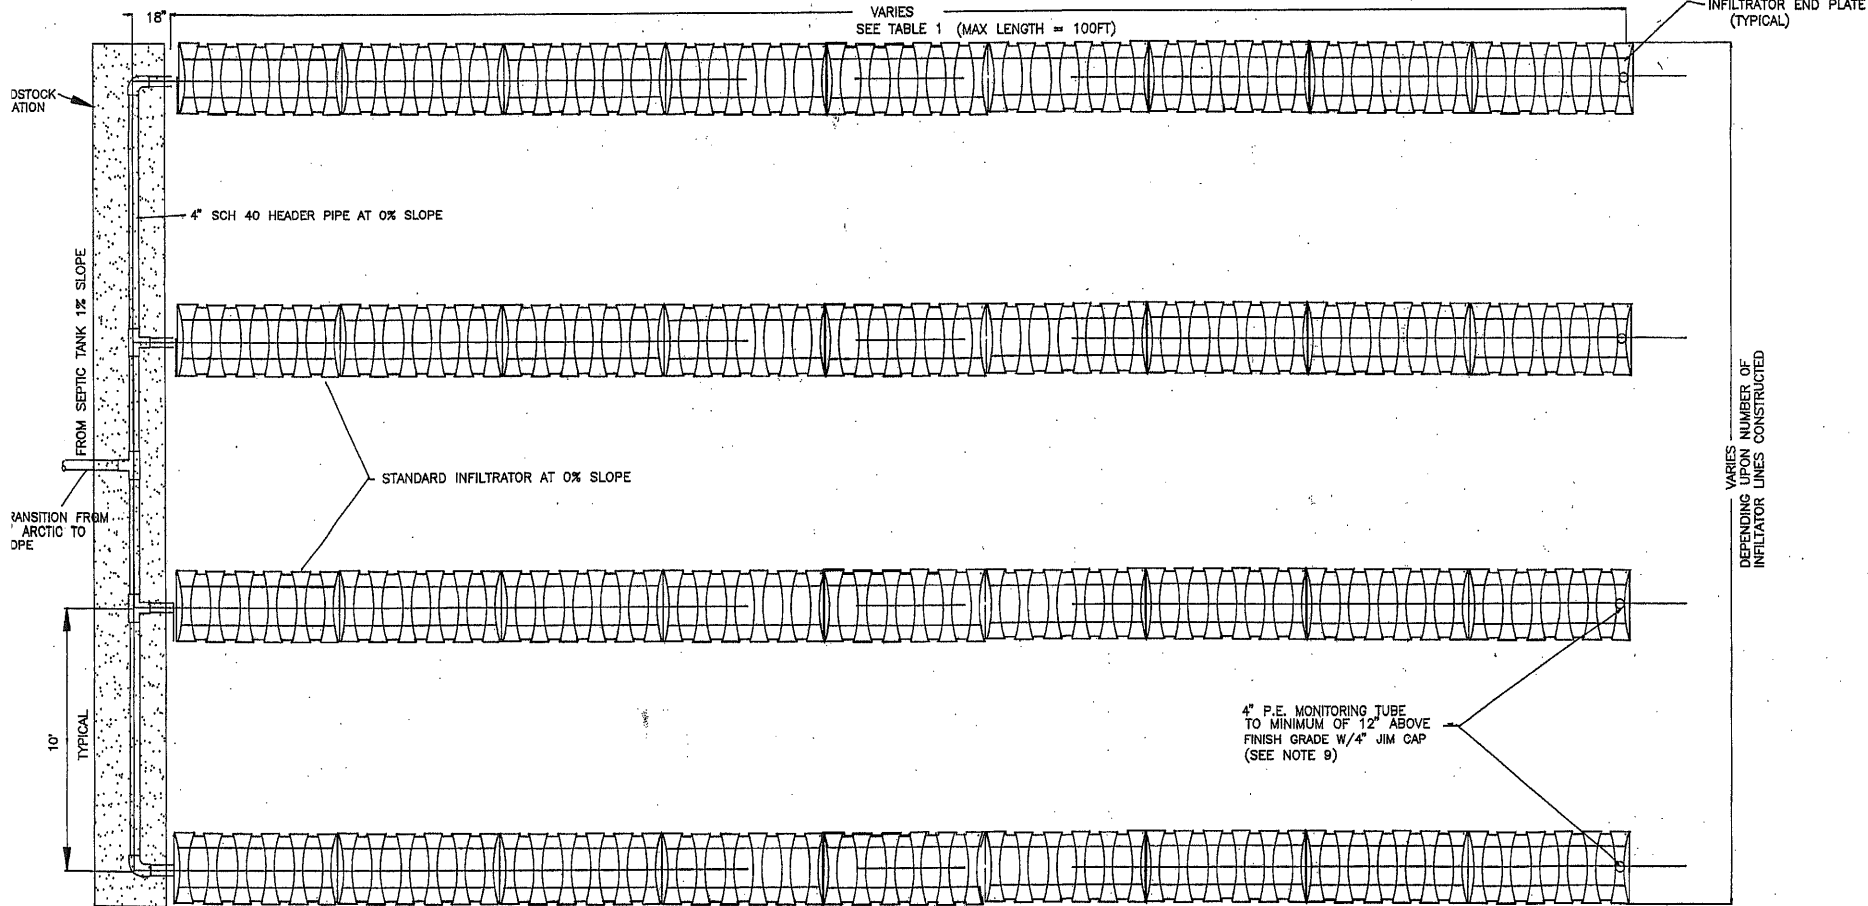


TYPICAL ABSORPTION FIELD PLAN

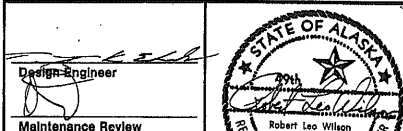


DATE	REVISIONS	INITIALS
U.S. Department of Health & Human Services Public Health Service Indian Health Service		
TAKOTNA, ALASKA		
TYPICAL ABSORPTION FIELD		
PUBLIC LAW 86-121 PROJECT		
PROJECT NO. AN-91-679/057		
DRAWN BY: JAQ / WKT		CHECKED BY:
DATE: 8-91 / 4-92		DATE:

SHEET NO.
C-2
OF
2
TOTAL SHEETS

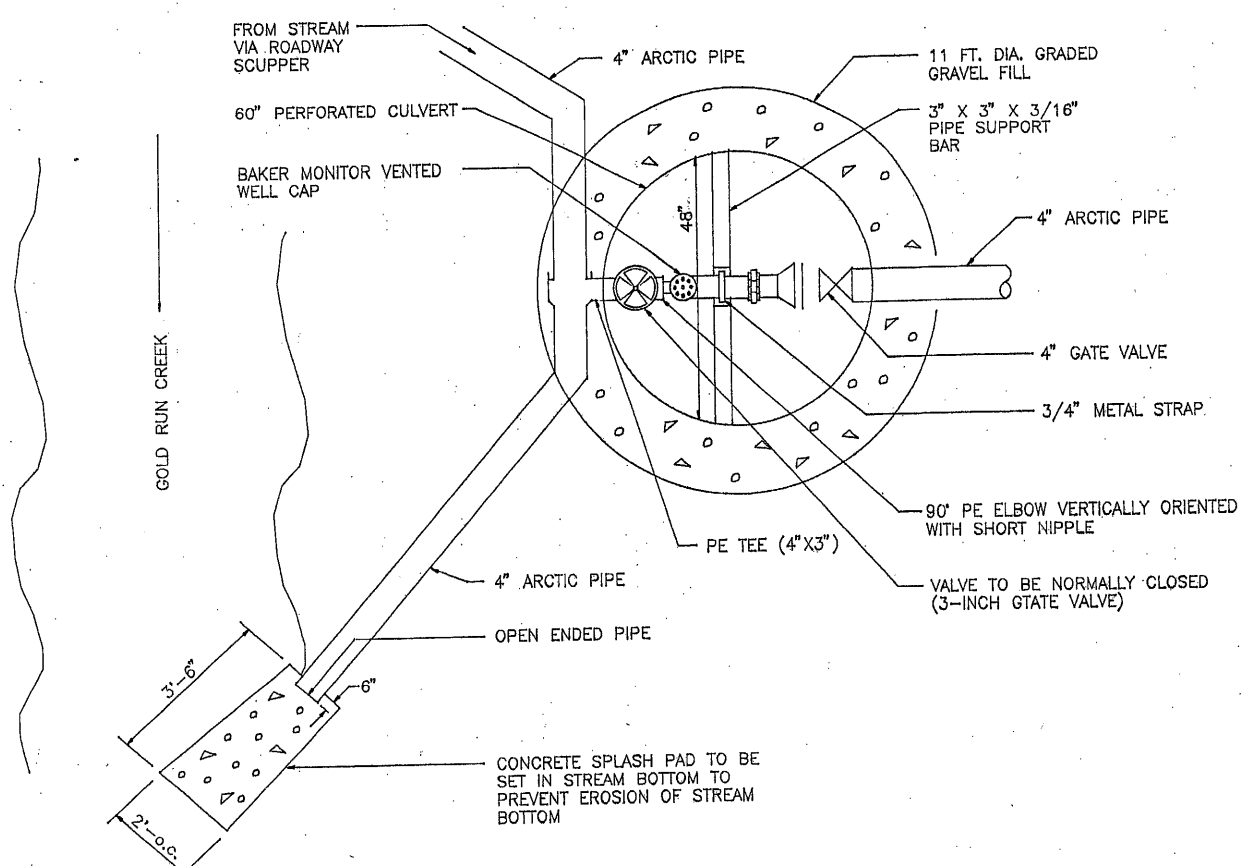


INFILTRATION GALLERY (TOP VIEW)

NOT TO SCALE

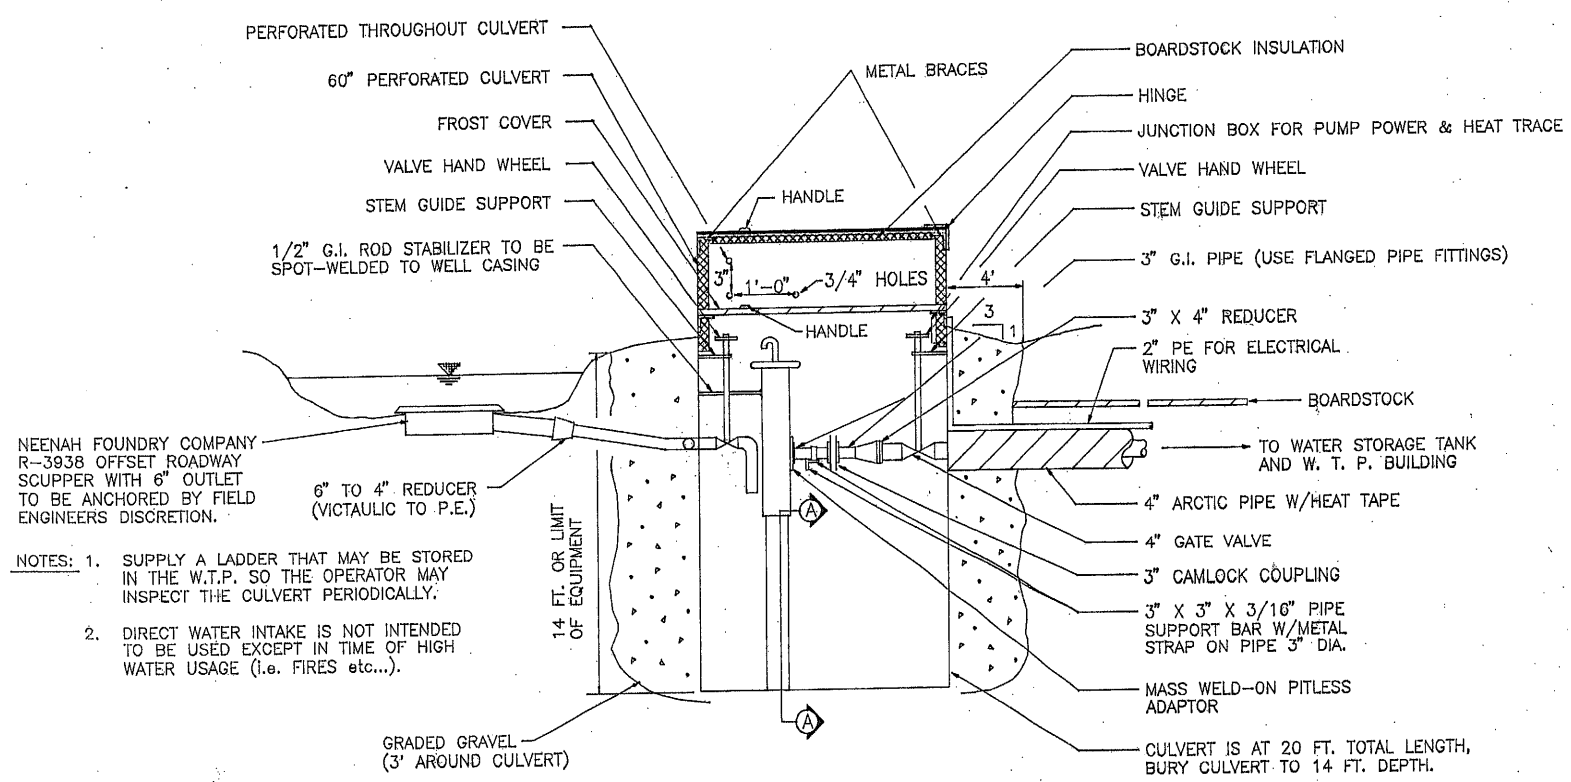


INFILTRATION GALLERY (SIDE VIEW)

NOT TO SCALE

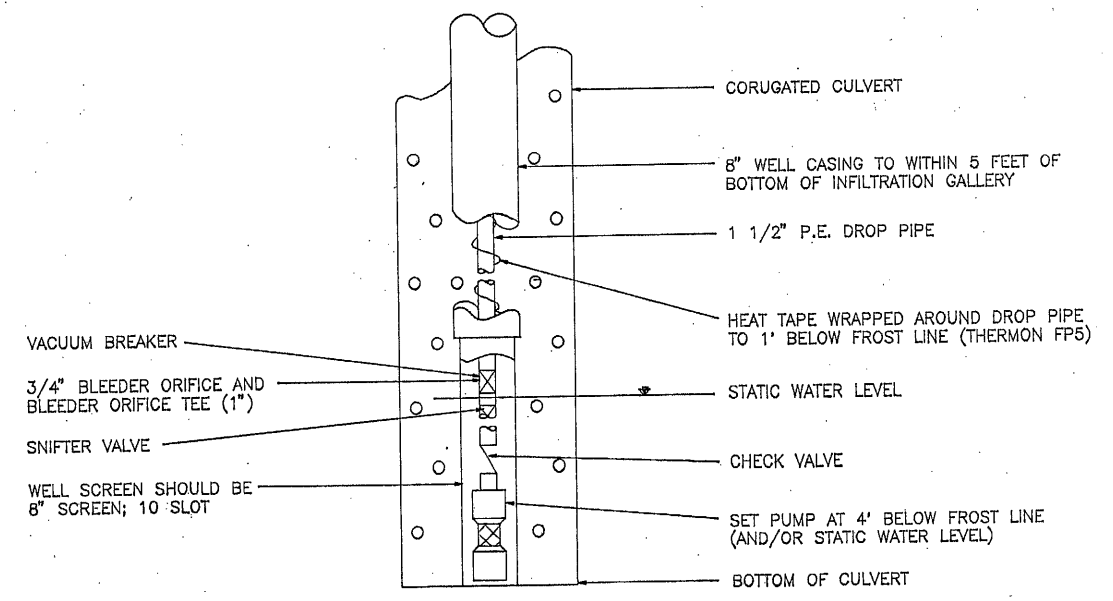

SECTION A-A

NOT TO SCALE

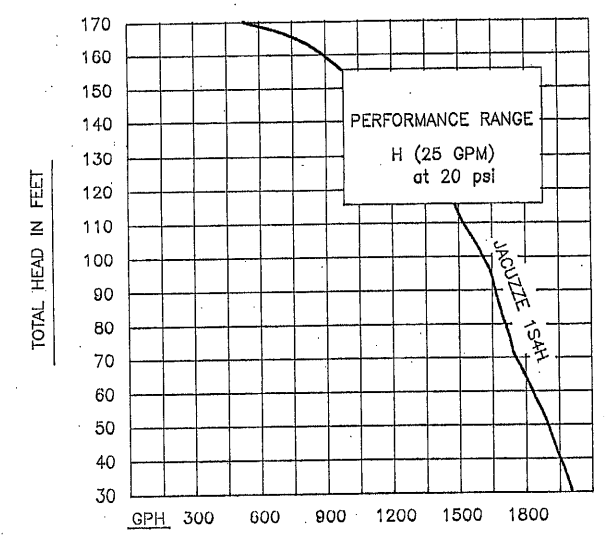


SHEET SPECIFIC SCOPE OF WORK


1. CONSTRUCT WATER INTAKE STRUCTURE

NOTES :

1. 4" PE ARCTIC PIPE SHALL BE BURIED AT A MINIMUM OF 4 FEET.
2. SCREEN SLOT SIZE IS PREDICATED ON THE GRAIN-SIZE DISTRIBUTION OF THE FILTER PACK; ALWAYS OBTAIN 100% OF FILTER PACK.
3. USE CORUGATED CULVERT.
4. FILTER PACK SHOULD BE CLEAN, SILICEOUS, ROUNDED AND UNIFORM, (3/4" PLUS).
5. INSULATE TOP AND SIDES (TO WINTER WATER LEVEL) OF THE WET WELL.
6. WATER FILL SYSTEM IS A DRAINBACK SYSTEM.

DATE	REVISIONS	INITIALS
U.S. Department of Health & Human Services Public Health Service Indian Health Service		
TAKOTNA, ALASKA WATER INTAKE/OUTLET DETAIL PUBLIC LAW 86-121 PROJECT PROJECT NO. AN-91-679/057		SHEET NO. S-1 OF 1 TOTAL SHEETS
DRAWN BY: WKT DATE: 4-92	CHECKED BY: DATE:	

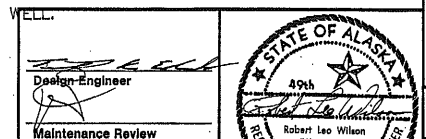

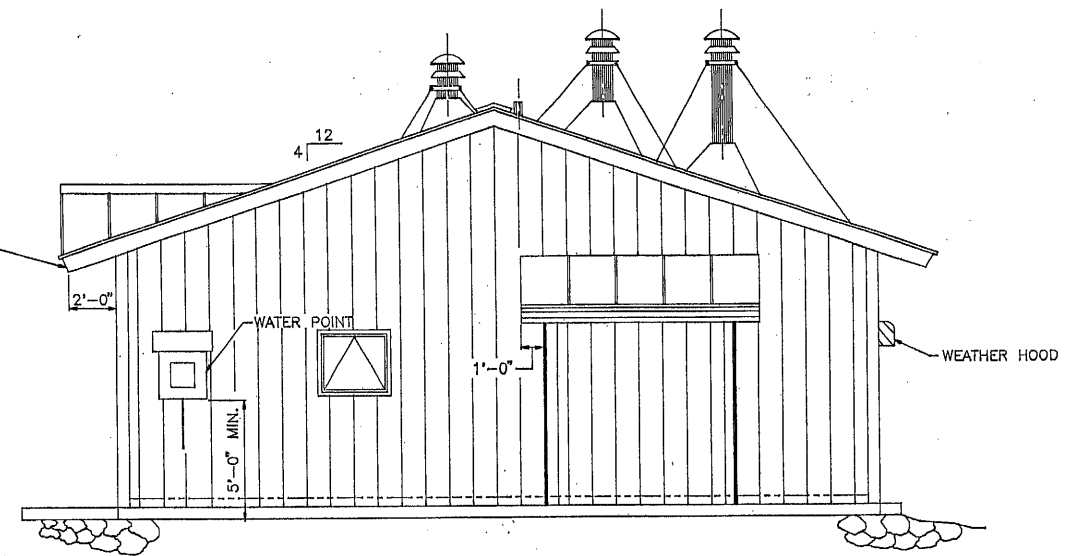

SCALE: $1/4" = 1'-0"$



1. REPLACE OLD WASHERS AND HYDRONIC DRYERS.
2. REPLACE ALL MEDIA IN PRESSURE SANDFILTERS.
3. REHAB BOTH BATHROOMS.
4. REPLACE ALL PUMPS LISTED.
5. REPLACE BOILERS.
6. REPLACE WATERING POINT.
7. REPLACE PRESSURE TANKS.
8. REPLACE CHLORIDE AND FLUORINE INJECTION EQUIPMENT (ie. PUMPS AND VATS).
9. INSTALL NEW RAW WATER SUPPLY LINE.
10. REPLACE PIPING AS NEEDED.
11. REWIRE AS NEEDED.
12. REPLACE UNIT HEATERS.
13. CLEAN AND DISINFECT INTERIOR OF WATER STORAGE TANK.
14. REPLACE DOORS LISTED BELOW.
15. REPLACE WINDOWS.
16. PAINT EXTERIOR AND INTERIOR OF BUILDING (EXTERIOR-BLUE; INTERIOR-WHITE).
17. REPLACE ALUMINUM ROOFING W/CLIPPED RIBBED ROOFING.
18. INSTALL EXTRACTOR (SINGLE PHASE).
19. REPLACE W/C

ITEMS TO BE REPLACED IN WTP AND WASHETERIA

<u>ITEM</u>	<u>MAKE</u>	<u>MODEL</u>
CIRCULATING PUMPS # 1 & 2	GRUNDFOS	UP26-64F OR EQUAL
PRESSURE PUMP	JACUZZI	1DS1-S/B OR EQUAL
DRYERS # 1 & 2	LOADSTAR BY HUEBSCH	
BOILER # 1 & 2	BURNHAM	V-74 (OR EQUAL)
FLUORIDE PUMP	LMI	A37
CHLORINE PUMP	LMI	A18
UNIT HEATER	TRANE	
WASHER # 1,2 & 3	WHIRLPOOL	
PRESSURE TANK # 1 & 2	WELL-X-TROL	WX 252

DOOR SCHEDULE

REQ'D	DOOR	TYPE OF DOOR	TYPE OF FRAME	TYPE OF HINGE	TYPE OF LOCKSET	DOOR CLOSER	TYPE OF THRESHOLD	TYPE OF DOOR BOTTOM	SWING
1	D1	EXTERIOR	METAL	EXTERIOR	ENTRANCE	NO	EXTERIOR IN SWING	EXTERIOR	LH
1	D2	EXTERIOR	METAL	EXTERIOR	ENTRANCE	YES	EXTERIOR	EXTERIOR	RH
1	D3	EXTERIOR	METAL	EXTERIOR	ENTRANCE	YES	EXTERIOR IN SWING	EXTERIOR	RH
1	D4	FIRE DOOR	METAL	EXTERIOR		YES	EXTERIOR	EXTERIOR	LH

SCALE: $1/4" = 1'-0"$

KEY


 - PROPOSED CONSTRUCTION
OR REPLACEMENT.

DATE	REVISIONS	INITIALS
<p align="center">U.S. Department of Health & Human Services Public Health Service Indian Health Service</p>		
<p align="center">TAKOTNA, ALASKA</p>		<p align="center">SHEET NO. A-1</p>
<p align="center">WTP FLOOR PLAN AND ELEVATIONS</p>		<p align="center">OF 2</p>
<p align="center">PUBLIC LAW 86-121 PROJECT</p>		<p align="center">TOTAL SHEETS</p>
<p align="center">PROJECT NOAN-91-679/057</p>		

DRAWN BY: WKT	CHECKED BY:
DATE: 4-92	DATE:


SHEET SPECIFIC SCOPE OF WORK

1. REPLACE HYDRONIC DRYERS (DRYERS ALREADY IN PLACE)
2. REPLACE WASHERS.
3. REPLACE ROTTING FLOORING IN BOTH BATHROOMS.
4. INSTALL HEAT CIRCULATING FAN TO MOVE WARM AIR FROM MEZZANINE AREA TO LOWER AREAS IN PUBLIC AREA. (OR CHECK AND REPAIR EXISTING HEAT CIRCULATING FAN).
5. INSTALL FIRE DAMPERS FOR HEAT CIRC. FAN DUCT (FUSIBLE-LINK AUTOMATIC CLOSING ASSEMBLY).

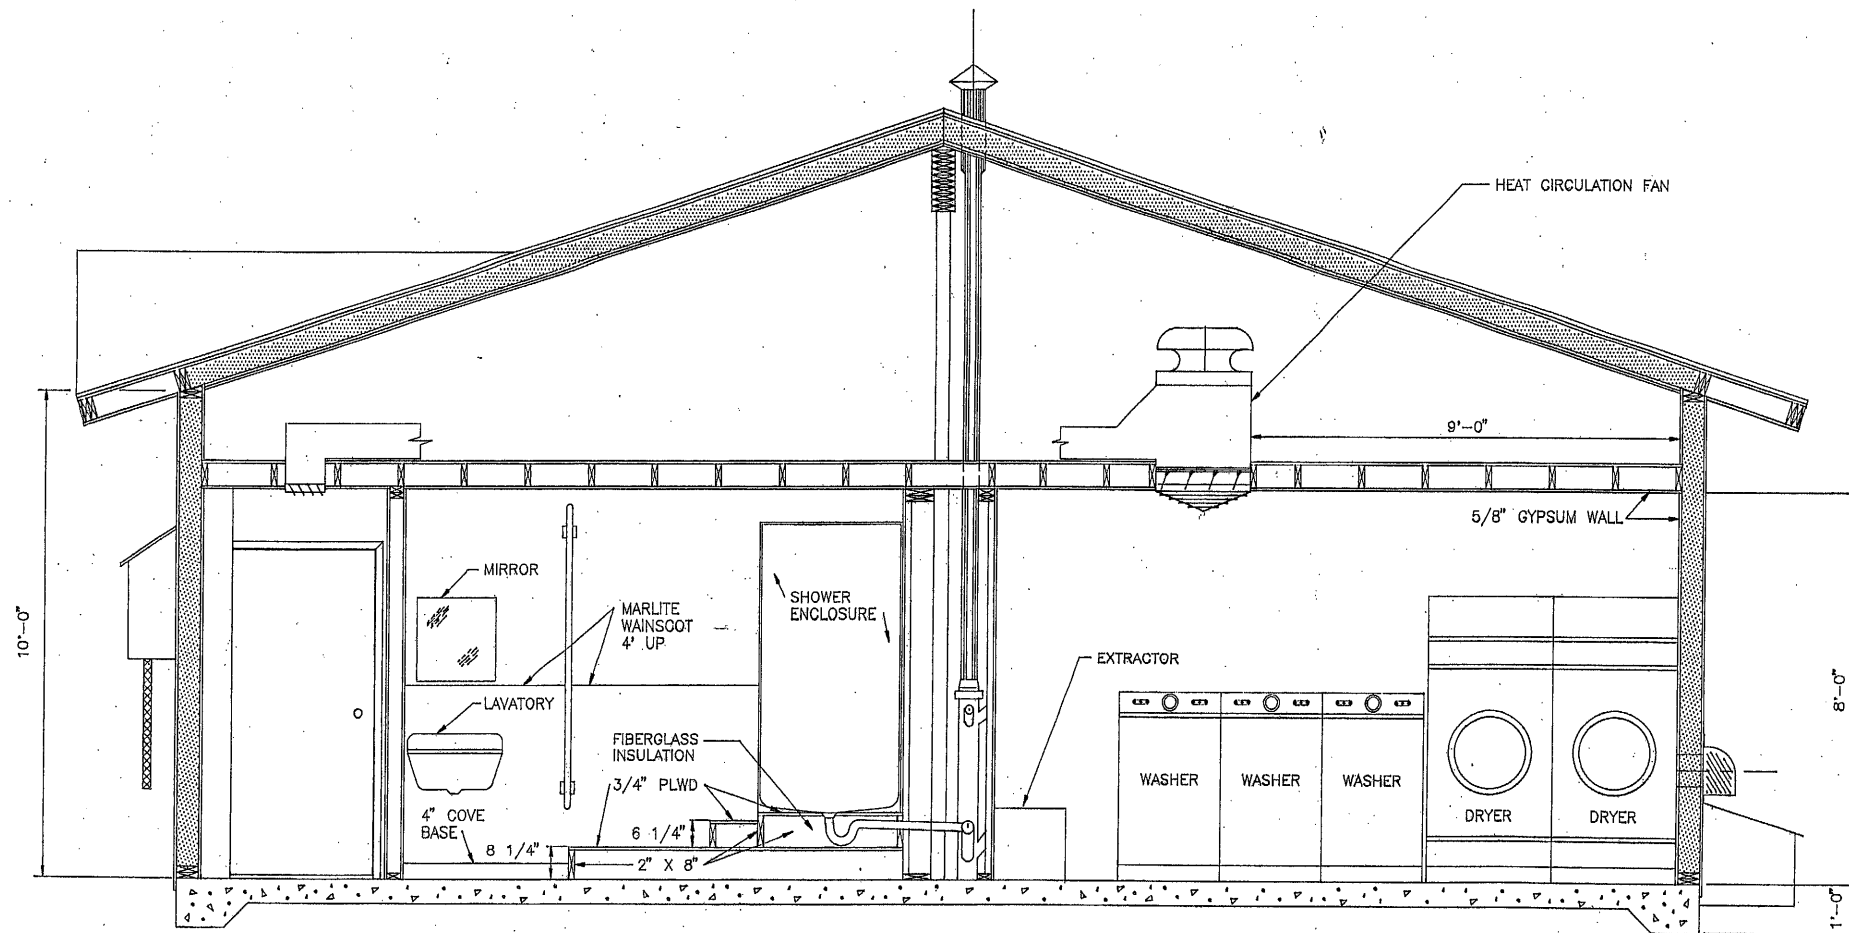

CROSS SECTION C-C


SCALE: 1/2" = 1'-0"

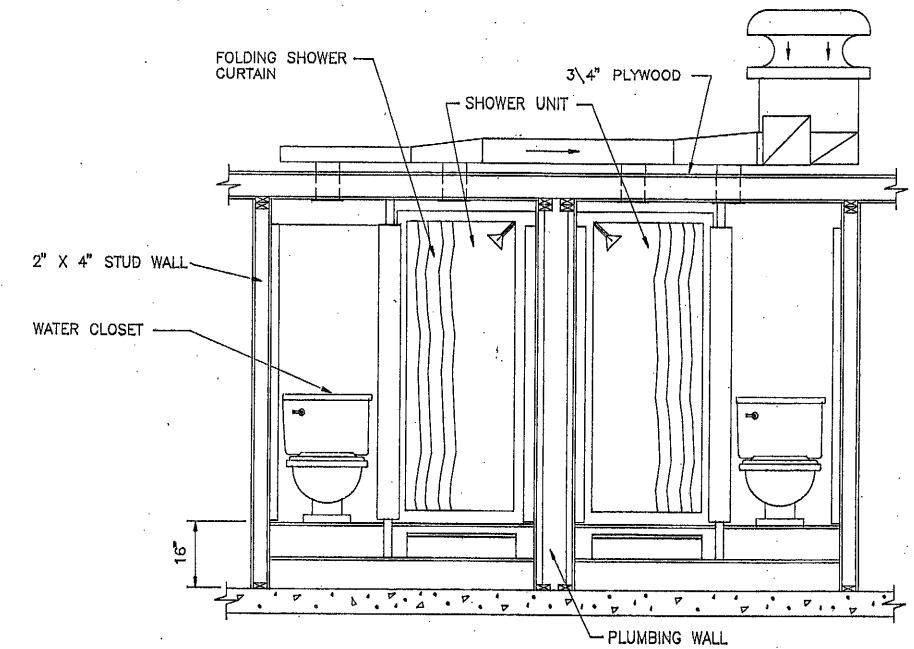



CROSS SECTION D-D

SCALE: 1/2" = 1'-0"

DATE	REVISIONS	INITIALS
U.S. Department of Health & Human Services Public Health Service Indian Health Service		
TAKOTNA, ALASKA		SHEET NO. A-2
WTP CROSS SECTIONS		OF 2
PUBLIC LAW 86-121 PROJECT		TOTAL SHEETS
PROJECT NO. AN-91-679/057		

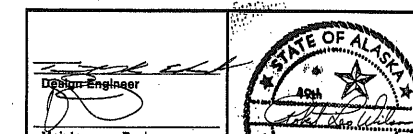


DRAWN BY: WKT	CHECKED BY:
DATE: 4-92	DATE:

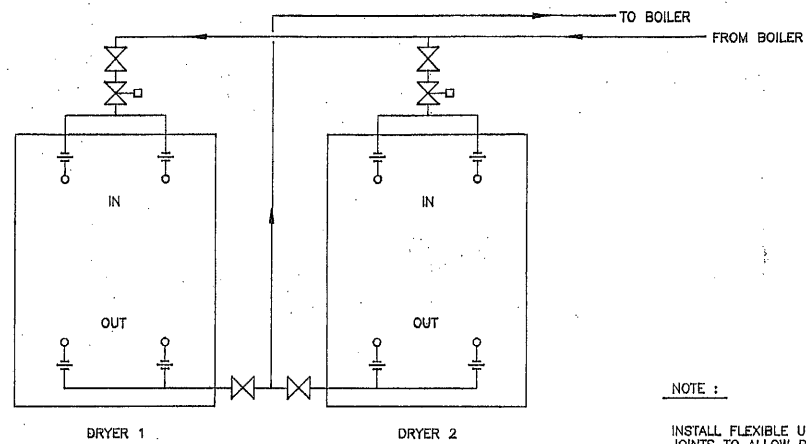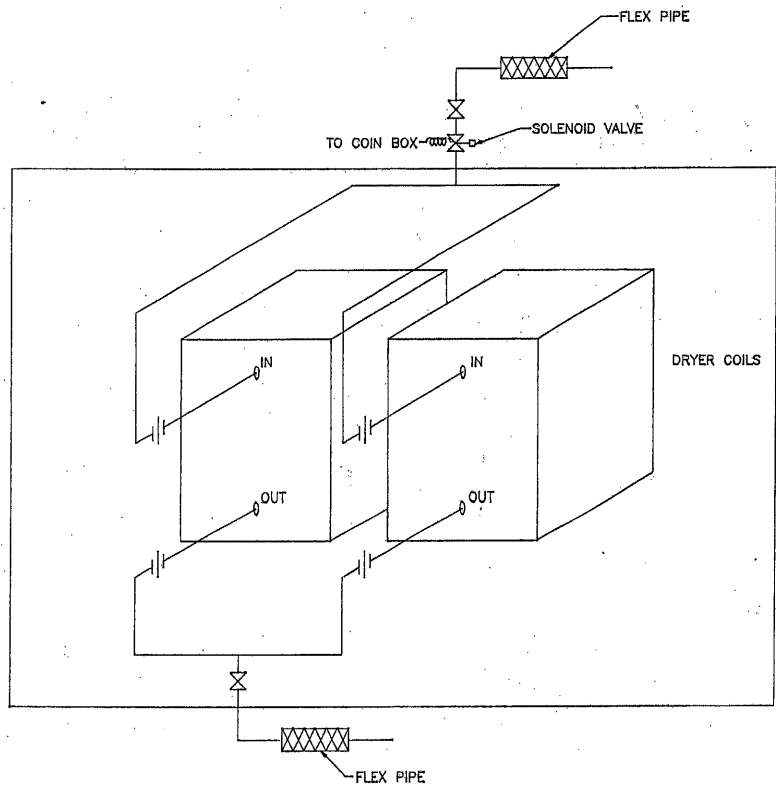

NOTE :



INSTALL FLEXIBLE UPPER EXPANSION JOINTS TO ALLOW REMOVAL OF DRYERS FOR SERVICE.

DRYERS ARE TO BE HEUBSCH, 30CSL, 115V HYDRONIC DRYERS.

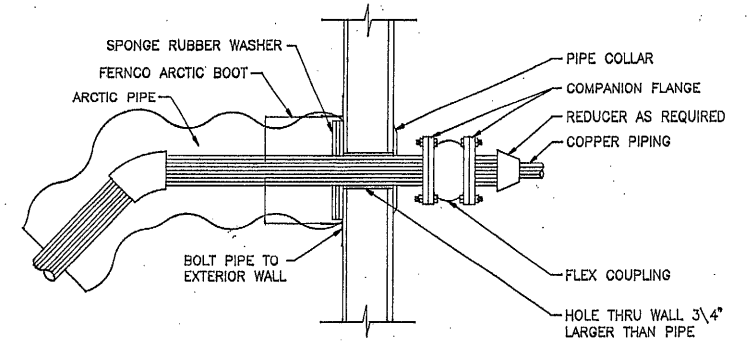


NOTES :

1. INSTALL SOLENOID VALVE SO IT IS ACCESSIBLE.
2. PUT MINI-TROLS ON HOT AND COLD WATER LINES.

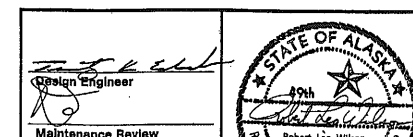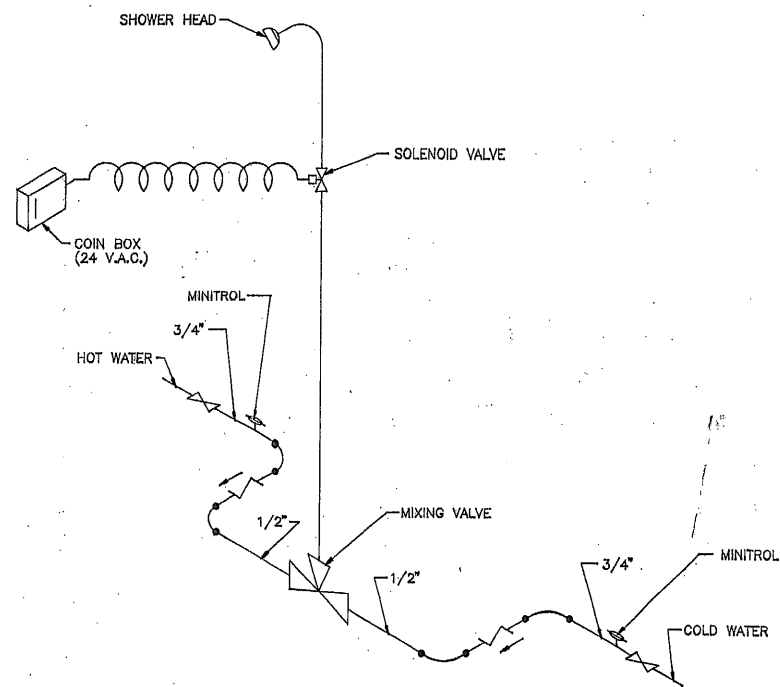


DATE	REVISIONS	INITIALS
U.S. Department of Health & Human Services Public Health Service Indian Health Service		
TAKOTNA, ALASKA WTP PIPE DETAIL PUBLIC LAW 86-121 PROJECT PROJECT NO. AN-91-679/057		SHEET NO. M-2 OF 5 TOTAL SHEETS
DRAWN BY: WKT DATE: 4-82	CHECKED BY: DATE:	

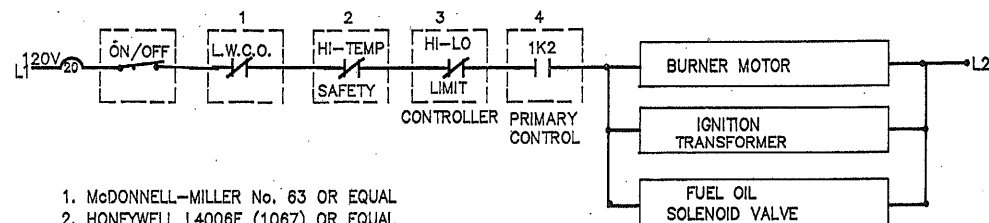

1. McDONNELL-MILLER No. 63 OR EQUAL
2. HONEYWELL L4006E (1067) OR EQUAL
3. HONEYWELL L6006A (1244) FIXED 10 DEGREE F DIFF OR EQUAL
4. HONEYWELL R8184G (1138) OR EQUAL

5 TYPICAL BOILER CONTROL COMPONENTS SCHEMATIC LAYOUT
NTS

4 TYPICAL AUTOMATIC AIR VENT
NTS

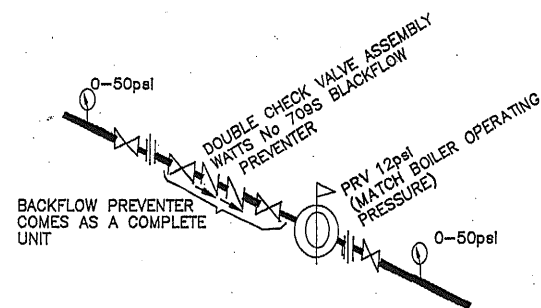

2 TYPICAL WATER SYSTEM/HYDRONICS SYSTEM
INTERFACE
NTS

- NOTES:
1. PROVIDE GYCOL HYDROMETER FOR OPERATOR.
 2. THE OPERATING PRESSURE FOR THE POTABLE WATER SUPPLY SHOULD BE GREATER THAN THAT OF THE HYDRONICS SYSTEM

BOILER OPERATING CHARACTERISTICS

1. STACK TEMP 400 TO 550 DEGREE F
2. OIL PRESSURE 100 psi UNLESS OTHERWISE SPECIFIED BY BURNER MANUFACTURER
3. SMOKE DOT: 0-1
4. STACK DRAFT: .02-.04" WATER COLUMN
5. H₂O OVERFIRE DRAFT: 0.01-0.02" WATER COLUMN UNLESS OTHERWISE SPECIFIED BY BOILER MANUFACTURER
6. 12-20 psi BOILER OPERATING PRESSURE
7. 160 TO 190 DEGREE OPERATING TEMP

TEST KITS REQUIRED

- BACHARACH KIT #10-5022 OR EQUAL


SPARE PARTS TO BE PROVIDED FOR EACH TYPE BOILER/BURNER INSTALLATION

1. ONE EACH COMPLETE BURNER UNIT
2. ELECTRODE ASSEMBLY 1 EACH
3. IGNITION TRANSFORMER, 1 EACH
4. CAD CELL FLAME DETECTION WITH HONEYWELL R8184G PRIMARY CONTROL OR EQUAL
5. FUEL PUMP, 1 EACH
6. HI-TEMPERATURE SAFETY CONTROL WITH MANUAL RESET HONEYWELL L4006E OR EQUAL
7. HI-LO OPERATING CONTROLLER, HONEYWELL L6006A (1244) WITH 10 DEGREE FIXED OPERATING DIFFERENTIAL OR EQUAL

FIRE EXTINGUISHER REQUIREMENTS


1. SET PORTABLE FIRE EXTINGUISHERS PER REQUIREMENTS OF CHAPTER 10, 1988 NATIONAL FIRE CODE. WASHETERIA PUBLIC ROOMS ARE CONSIDERED A "LIGHT HAZARD" WITH CLASS A COMBUSTIBLES. WATER TREATMENT PLANTS OR MECHANICAL ROOMS ARE AN ORDINARY HAZARD" WITH CLASS A COMBUSTIBLES AND CLASS B FLAMMABLES.
2. USE 5-6 POUNDS PORTABLE FIRE EXTINGUISHERS IN LIGHT HAZARD AND ORDINARY HAZARD LOCATIONS. AMEREX MODEL No 443, UL RATING 3-A40BC OR APPROVED EQUAL, WITH MULTIPURPOSE ABC DRY CHEMICAL (NONAMONIUM PHOSPHATE) POWDER. INSTALL THE UNIT(S) IN ACCESSIBLE AREAS (MAX STRAIGHT WALKING DIST. =70') OR AS REQUIRED BY FIRE MARSHAL. IN ANY CASE, PROVIDE A MINIMUM OF 2 UNITS IN EACH TREATMENT PLANT OR WASHETERIA.
3. IN ADDITION, USE AUTOMATIC FIRE EXTINGUISHERS IN ORDINARY HAZARD LOCATIONS. AD-X FIRE SYSTEMS, INC. MODEL No 103-, 20 SQ FOOT COVERAGE OR APPROVED EQUAL, WITH MULTIPURPOSE ABC DRY CHEMICAL POWDER. INSTALL ONE UNIT OVER EACH HEAT APPLIANCE BURNER. SET BETWEEN 3 FEET AND 7.5 FEET ABOVE THE BURNER.

1 TYPICAL BOILER PIPING
NTS

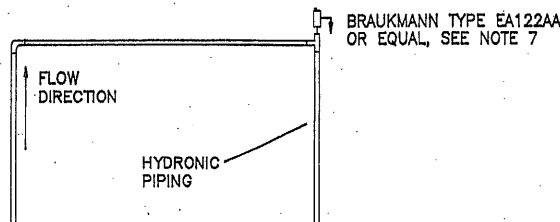

NOTES ON BOILER PIPING.

1. HYDRONIC PIPING SHOWN IS FOR REPRESENTATION OF REQUIRED FITTINGS ONLY. ACTUAL LOCATION OF TAPS WILL VARY BY BOILER MANUFACTURER.
2. BOILERS SHALL BE PLUMBED IN PARALLEL.
3. BOILER HOT WATER SAFETY RELIEF VALVES SHALL BE RATED FOR 30 psi. A RIGID PIPE WITH THREADED CONNECTIONS SHALL BE ATTACHED TO BRING THE BLOW-OFF DISCHARGE WITHIN 6 INCHES OF THE FLOOR.
4. THE EXPANSION TANK SHALL BE INDIVIDUALLY SIZED FOR EACH HYDRONIC SYSTEM, BASED ON OPERATING TEMPERATURES, VOLUME OF SYSTEM, AND TANK MANUFACTURES RECOMMENDATIONS.
5. DIELECTRIC JOINTS SHALL BE MADE BY ISOLATION KITS (NIPPLES AND NOT UNIONS) AT ALL CONNECTIONS OF DISSIMILAR METALS.
6. MINIMUM CLEARANCE REQUIRED BY UNIFORM CODE IS 18 INCHES ON ALL SIDES. FOR REAR EXIT BOILERS A REAR CLEARANCE OF 36 INCHES IS REQUIRED TO MAINTAIN ADEQUATE SEPARATION BETWEEN STACK AND WALL. FOR EASY O&M ACCESS 24-INCHES BETWEEN BOILERS, 36-INCHES SIDE CLEARANCE AND 48-INCHES FRONT CLEARANCE IS RECOMMENDED. THESE DISTANCES ARE AS MEASURED FROM THE BOILER BOX. ALLOWANCE FOR PROTRUDING PIPING AND APPURTENANCES ARE INCORPORATED INTO THE RECOMMENDED VALUES.
7. INSTALL AUTOMATIC AIR VENT AT DOWNSTREAM END OF ANY HYDRONICS PIPING HIGH POINT. INSTALL AN ISOLATION BALL VALVE WITH EACH VENT IF NOT PART AN INTERGAL PART OF THE VENT ASSEMBLY (ie HONEYWELL BRAUKMANN TYPE EA122AA)
8. A HEATING FLUID ADD LINE 30 psi RELIEF VALVE IS ONLY REQUIRED WHEN MIX VAT IS LOCATED OUT OF SIGHT OF BOILER RELIEF VALVES. WHEN UTILIZED, POSITION HEATING FLUID ADD LINE 30 psi RELIEF VALVE AND ATTACH HOSE SUCH THAT ANY DISCHARGE DRAINS INTO GYCOL MIXING VAT
9. CIRCULATION PUMPS ARE TYPICALLY PLUMBED IN PARALLEL ON THE RETURN LINE AT AN ELEVATION BELOW THE LOW WATER CUTOFF. PUMPS ARE SHOWN IN A TYPICAL CONFIGURATION. SEE HYDRONICS SCHEMATIC FOR LOCATION.
10. PROVIDE 2 EACH 10' WASHER HOSES FOR DRAINING SYSTEMS AND GENERAL HOUSEKEEPING.
11. PROVIDE PETCOCK TYPE ISOLATION VALVE ON ALL PRESSURE GAUGES.
12. PROVIDE THE STANDARD MODEL FLOW CELL FLOWMETER WITH NEOPRENE "O" RINGS AND METAL STRAINER CAP RATED FOR OPERATION TO A MAXIMUM 194 DEGREE F. PROVIDE THE "K" TYPE NICKEL PLATED BRASS "CHECKMATE" ISOLATION VALVE RATED FOR OPERATION TO A MAXIMUM 194 DEGREE F. SIZE THE METER PER MANUFACTURER'S RECOMMENDATION. IF BOILER OPERATION IN EXCESS OF 190 DEGREE F IS DESIRED PROVIDE TEFLON "O" RINGS TO BRING MAXIMUM TEMPERATURE RATING TO 302 DEGREES F.
13. CALIBRATE ALL THERMOMETERS IN BOILING WATER PRIOR TO INSTALLATION.

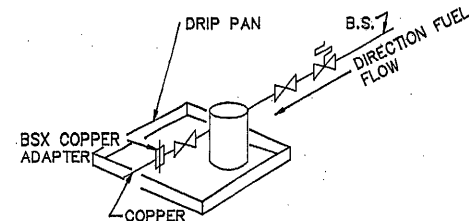

3 TYPICAL FUEL FILTER INSTALLATION
NTS

FUEL FILTER NOTES

1. APPLIANCE FUEL FILTER INSTALLATION: USE GENERAL 1A25A OR EQUAL (TYP) AT EACH FUEL USING APPLIANCE.
4. PROVIDE DRAIN PANS UNDER ALL FUEL FILTER INSTALLATIONS.

NOTE: THIS DRAWING WAS DEVELOPED AS A STANDARD DETAIL FOR AANHS SANITATION FACILITIES CONSTRUCTION PROGRAM PROJECT SPECIFIC MODIFICATIONS SHALL BE HIGHLIGHTED AND ARE THE RESPONSIBILITY OF THE PROJECT DESIGN ENGINEER.


DATE	REVISIONS	INITIALS

U. S. Department of Health & Human Services
Public Health Service
Indian Health Service

TAKOTNA, ALASKA
TYPICAL BOILER PIPING
PUBLIC LAW 86-121 PROJECT
PROJECT NO. AN-91-679/057

SHEET NO.
M-3
OF
5
TOTAL SHEETS

 DRAWN BY: JAO / WKT
CHECKED BY:



- DESIGN NOTES:FLUORIDE PUMP

- ### L. DISTRIBUTOR ASSEMBLY

- DESIGN NOTES: CHLORINE PUMP

- ### TYPICAL PARTS LIST

*METER SHALL BE ACCURATE $\pm 1\%$ @ 1/4 GPM



- NOTE:**
INJECTION CHECK
VALVE NOT INCLUDED
WITH ASSEMBLY.

CAUTION:


INJECTOR INSTALLATION (NON-FLUSH)

NOT TO SCALE
(ONLY FOR PIPE DIAMETER 4" OR GREATER)

NOTE: THREADED 1 1/4" N.P.T.

- ## STANDARD FLOW SWITCH INSTALLATION

NOT TO SCALE

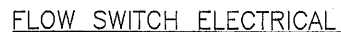

NOT TO SCALE

- ## VARIABLE FLOW SYSTEMS

- ## FLOW SWITCH FOR LOW FLOWS

**U.S. Department of Health & Human Services
Public Health Service
Indian Health Service**

TAKOTNA, ALASKA

FLUORIDATION AND CHLORINATION

PUBLIC LAW 86-121 PROJECT

PROJECT NO. AN-91-679/057

SHEET NO.
M-4

M-4
OF


5

TOTAL SHEETS

DRAWN BY: JAQ / WKT	CHECKED BY:
---------------------	-------------


SHEET SPECIFIC SCOPE OF WORK

1. REPLACE WATERING POINT.

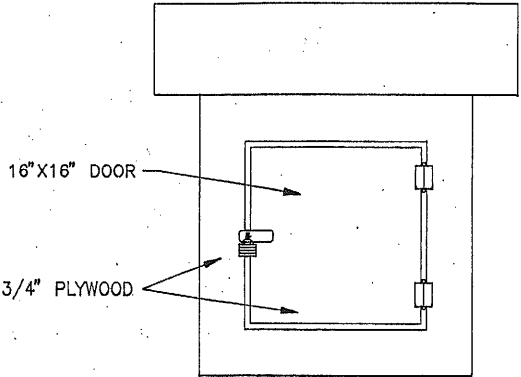

EXTERIOR BOX ELEVATION

NOT TO SCALE

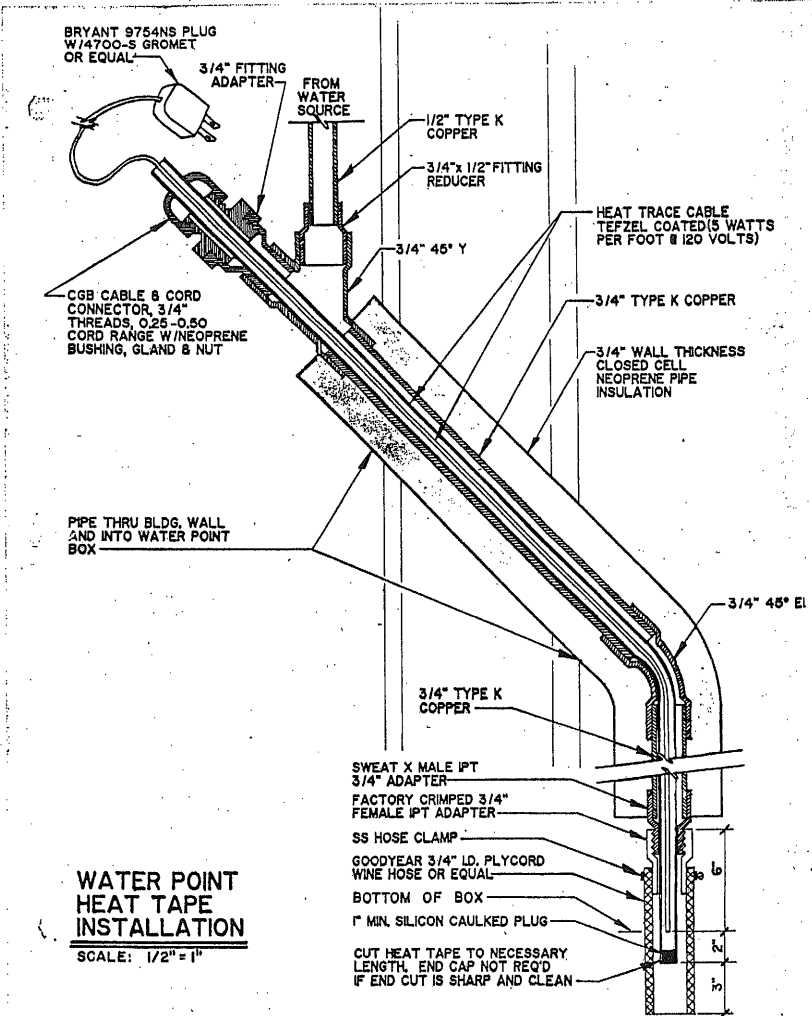


Alaska Rubber

"Boston" Royal Flex

Arctic Grade Potable Water Hose

1"

2" - 1" Female Pipe Threaded Swivels

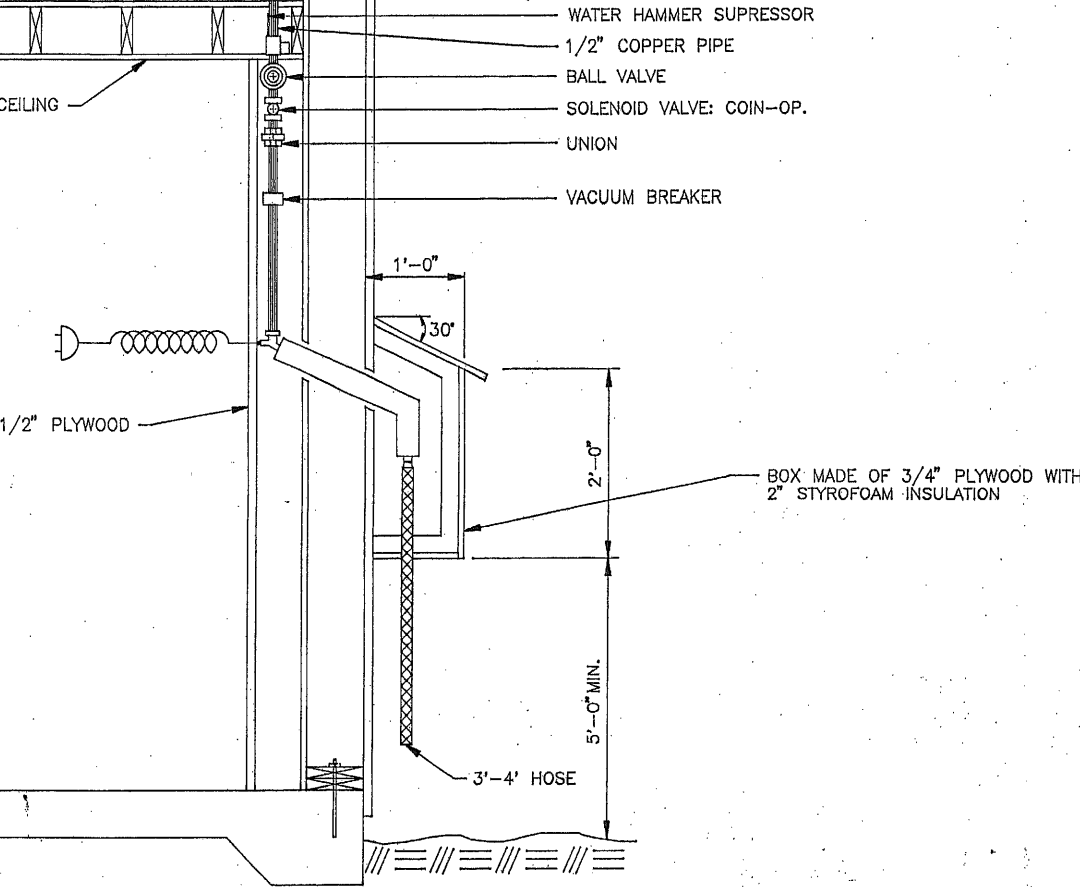

WATER POINT ASSEMBLY SECTION


NOT TO SCALE

NOTE: ALL WATERING POINT PIPING AS NOTED.



Design Engineer	STATE OF ALASKA
Marked for Review	Robert Leo Wilton

DATE	REVISIONS	INITIALS
U.S. Department of Health & Human Services Public Health Service Indian Health Service		
TAKOTNA, ALASKA		SHEET NO. M-5
WTP WATER POINT DETAILS		OF 5
PUBLIC LAW 86-121 PROJECT		TOTAL SHEETS
PROJECT NO. AN-91-679/057		


DRAWN BY: WKT	CHECKED BY:
DATE: 4-92	DATE:

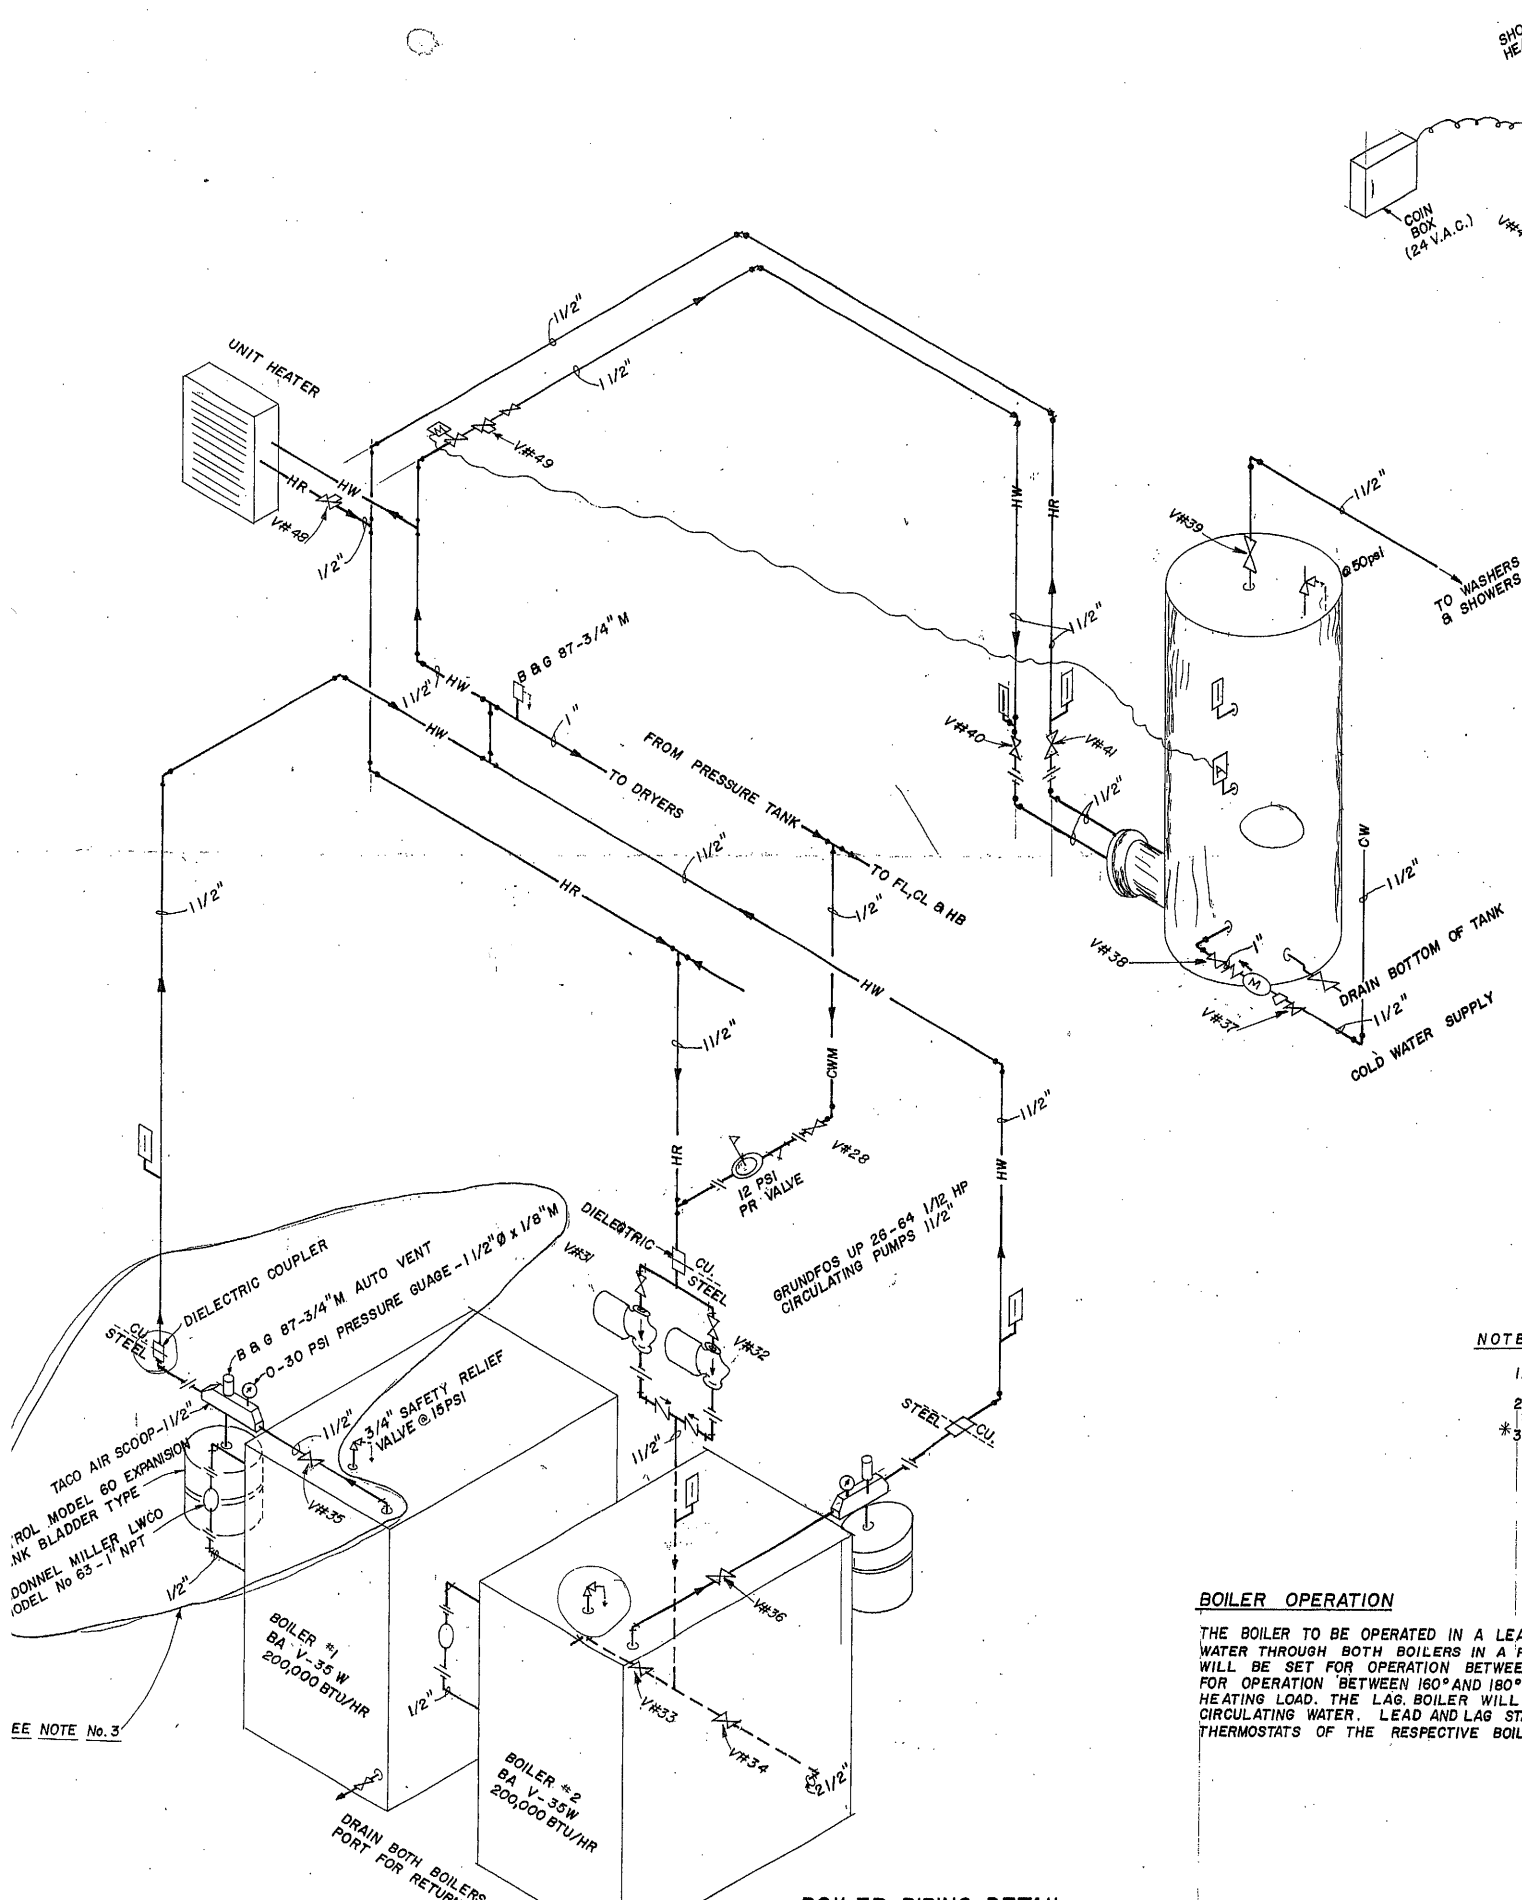

SHOWER PIPING
NTS

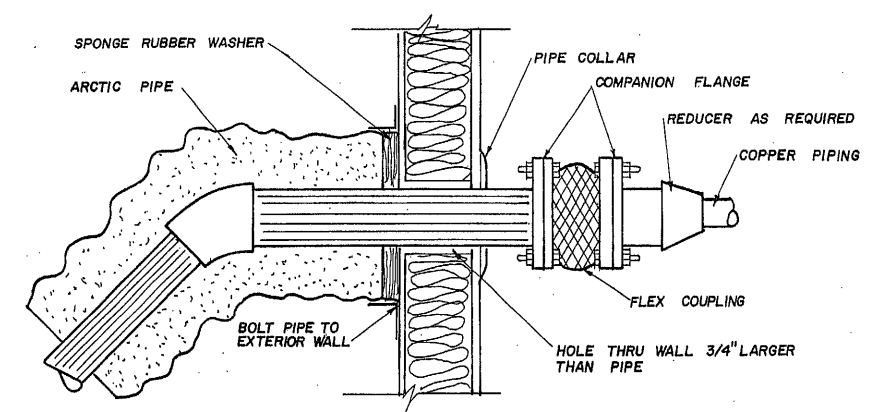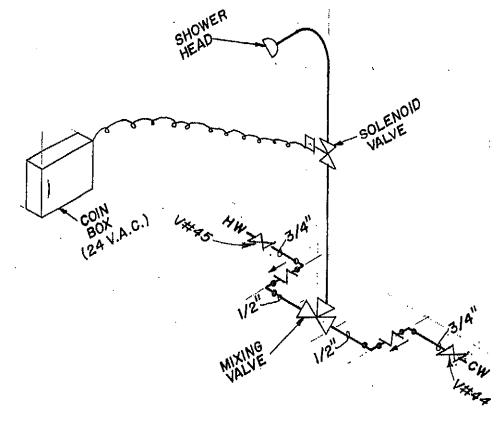

TYPICAL PIPE THRU WALL SECTION
NTS

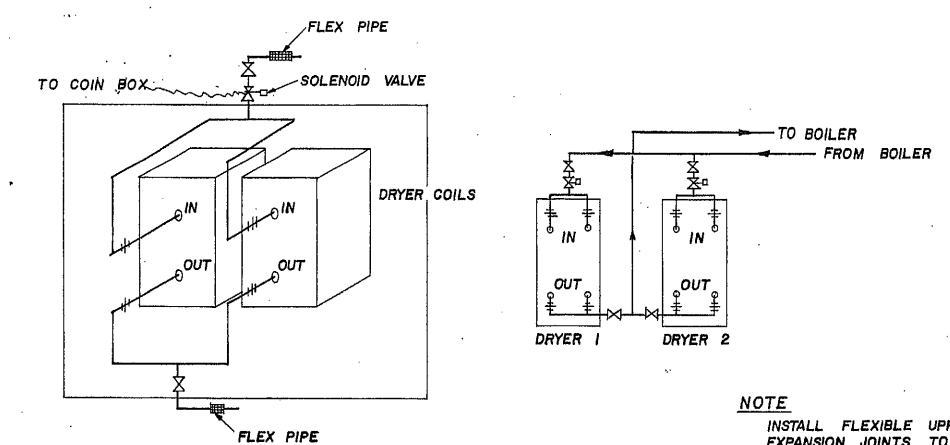

NOTE
INSTALL FLEXIBLE UPPER EXPANSION JOINTS TO ALLOW REMOVAL OF DRYERS FOR SERVICE.

- NOTES:**
1. ALL LINES TO BE GRADED TO DRAIN.
 2. ALL PIPING TO BE INSULATED.
 - *3. RUN HW PIPING STRAIGHT BACK INSTEAD OF TO SIDE FOR CLEARANCE ON SIDE TO ALLOW ACCESS TO PANELS AND ROOM ON SIDE OF BOILER LIKE SHOWN ON BOILER #2.


BOILER OPERATION

THE BOILER TO BE OPERATED IN A LEAD/LAG MANNER. THE CIRCULATION PUMP WILL PUSH WATER THROUGH BOTH BOILERS IN A PARALLEL FLOW ARRANGEMENT. THE LEAD BOILER WILL BE SET FOR OPERATION BETWEEN 180° AND 200°F. THE LAG BOILER WILL BE SET FOR OPERATION BETWEEN 160° AND 180°F. WHEN THE LEAD BOILER CANNOT CARRY THE HEATING LOAD, THE LAG BOILER WILL FIRE, DUE TO THE LOW TEMPERATURE OF THE CIRCULATING WATER. LEAD AND LAG STATUS CAN BE CHANGED BY ADJUSTING THE THERMOSTATS OF THE RESPECTIVE BOILER.

PLUMBING DIAGRAM HOT WATER DRYERS
NTS

11-11-81	AS BUILT	B.K.
DATE	REVISIONS	INITIALS
U. S. Department of Health, Education & Welfare Public Health Service Indian Health Service		
TAKOTNA, ALASKA WATER TREATMENT PLANT BOILER PIPING & PIPE DETAIL PUBLIC LAW 86-121 PROJECT PROJECT NO. AN-79-170		SHEET NO. 13 OF 31 TOTAL SHEETS
DRAWN BY: MD DATE: MAY, 1979		CHECKED BY: TRD DATE: 12-10-79

Blank Newell
Design Engineer
Maintenance Review

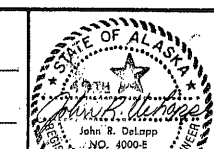


NOTES:

1. ALL EXPOSED PIPING WILL BE PAINTED USING THE FOLLOWING COLOR CODE:
GREEN - RAW WATER
BLUE - POTABLE WATER
BLACK - HEATING
RED - FIRE
BROWN - SEWAGE
GRAY - COMPRESSED AIR
ORANGE - FUEL
2. TYPE OF PAINT TO BE USED GARLOCK OR EQUAL.
3. DIRECTION OF FLOW TO BE INDICATED BY ARROWS AND NAME PLATES FOR MATERIAL BEING CARRIED.
4. ALL HOT WATER PIPING TO RECEIVE MINIMUM OF 1/2" INSULATED JACKETING (K=28).
5. 20-25 FEET TOTAL LENGTH OF COMMERCIAL DUTY BASEBOARD HEATERS REQUIRED IN WASHETERIA AREA, TO BE PLACED UNDER WINDOWS.
6. ALL WATER LINES TO BE GRADED TO DRAIN.
7. ALL COIN - OPERATED MOTORIZED VALVES TO BE LOW VOLTAGE AC(24V).

LEGEND

- PRIMARY SYSTEM
- DIRECTIONAL FLOW
- SOLDERED JOINT
- BP - BYPASS LINE
- BW - BACKWASH LINE
- CW - COLD WATER LINE
- HR - HEAT RETURN LINE
- HW - HOT WATER LINE
- CWM - COLD WATER MAKEUP LINE
- GATE VALVE
- VALVE QUICK OPENING
- BALANCING COCK VALVE
- CHECK VALVE
- MOTORIZED VALVE - NORMALLY CLOSED
- PRESSURE GAUGE
- MIXING VALVE
- UNION
- METRIC FLEX-COUPLING
- EXPANSION JOINT
- THERMOMETER
- AQUASTAT
- CAP
- PRESSURER RELIEF VALVE
- WATER METER
- AIR RELIEF VALVE
- SOLENOID VALVE - NORMALLY CLOSED
- AIR CUSHION
- PRESSURE REDUCING VALVE
- VACUUM BREAKER
- FLOW SWITCH
- Y SCREEN
- ADAPTOR
- FLEX PIPE
- TEMP. GAUGE
- KEY OPERATED VALVE W/LOCK SHIELD INSTALLED




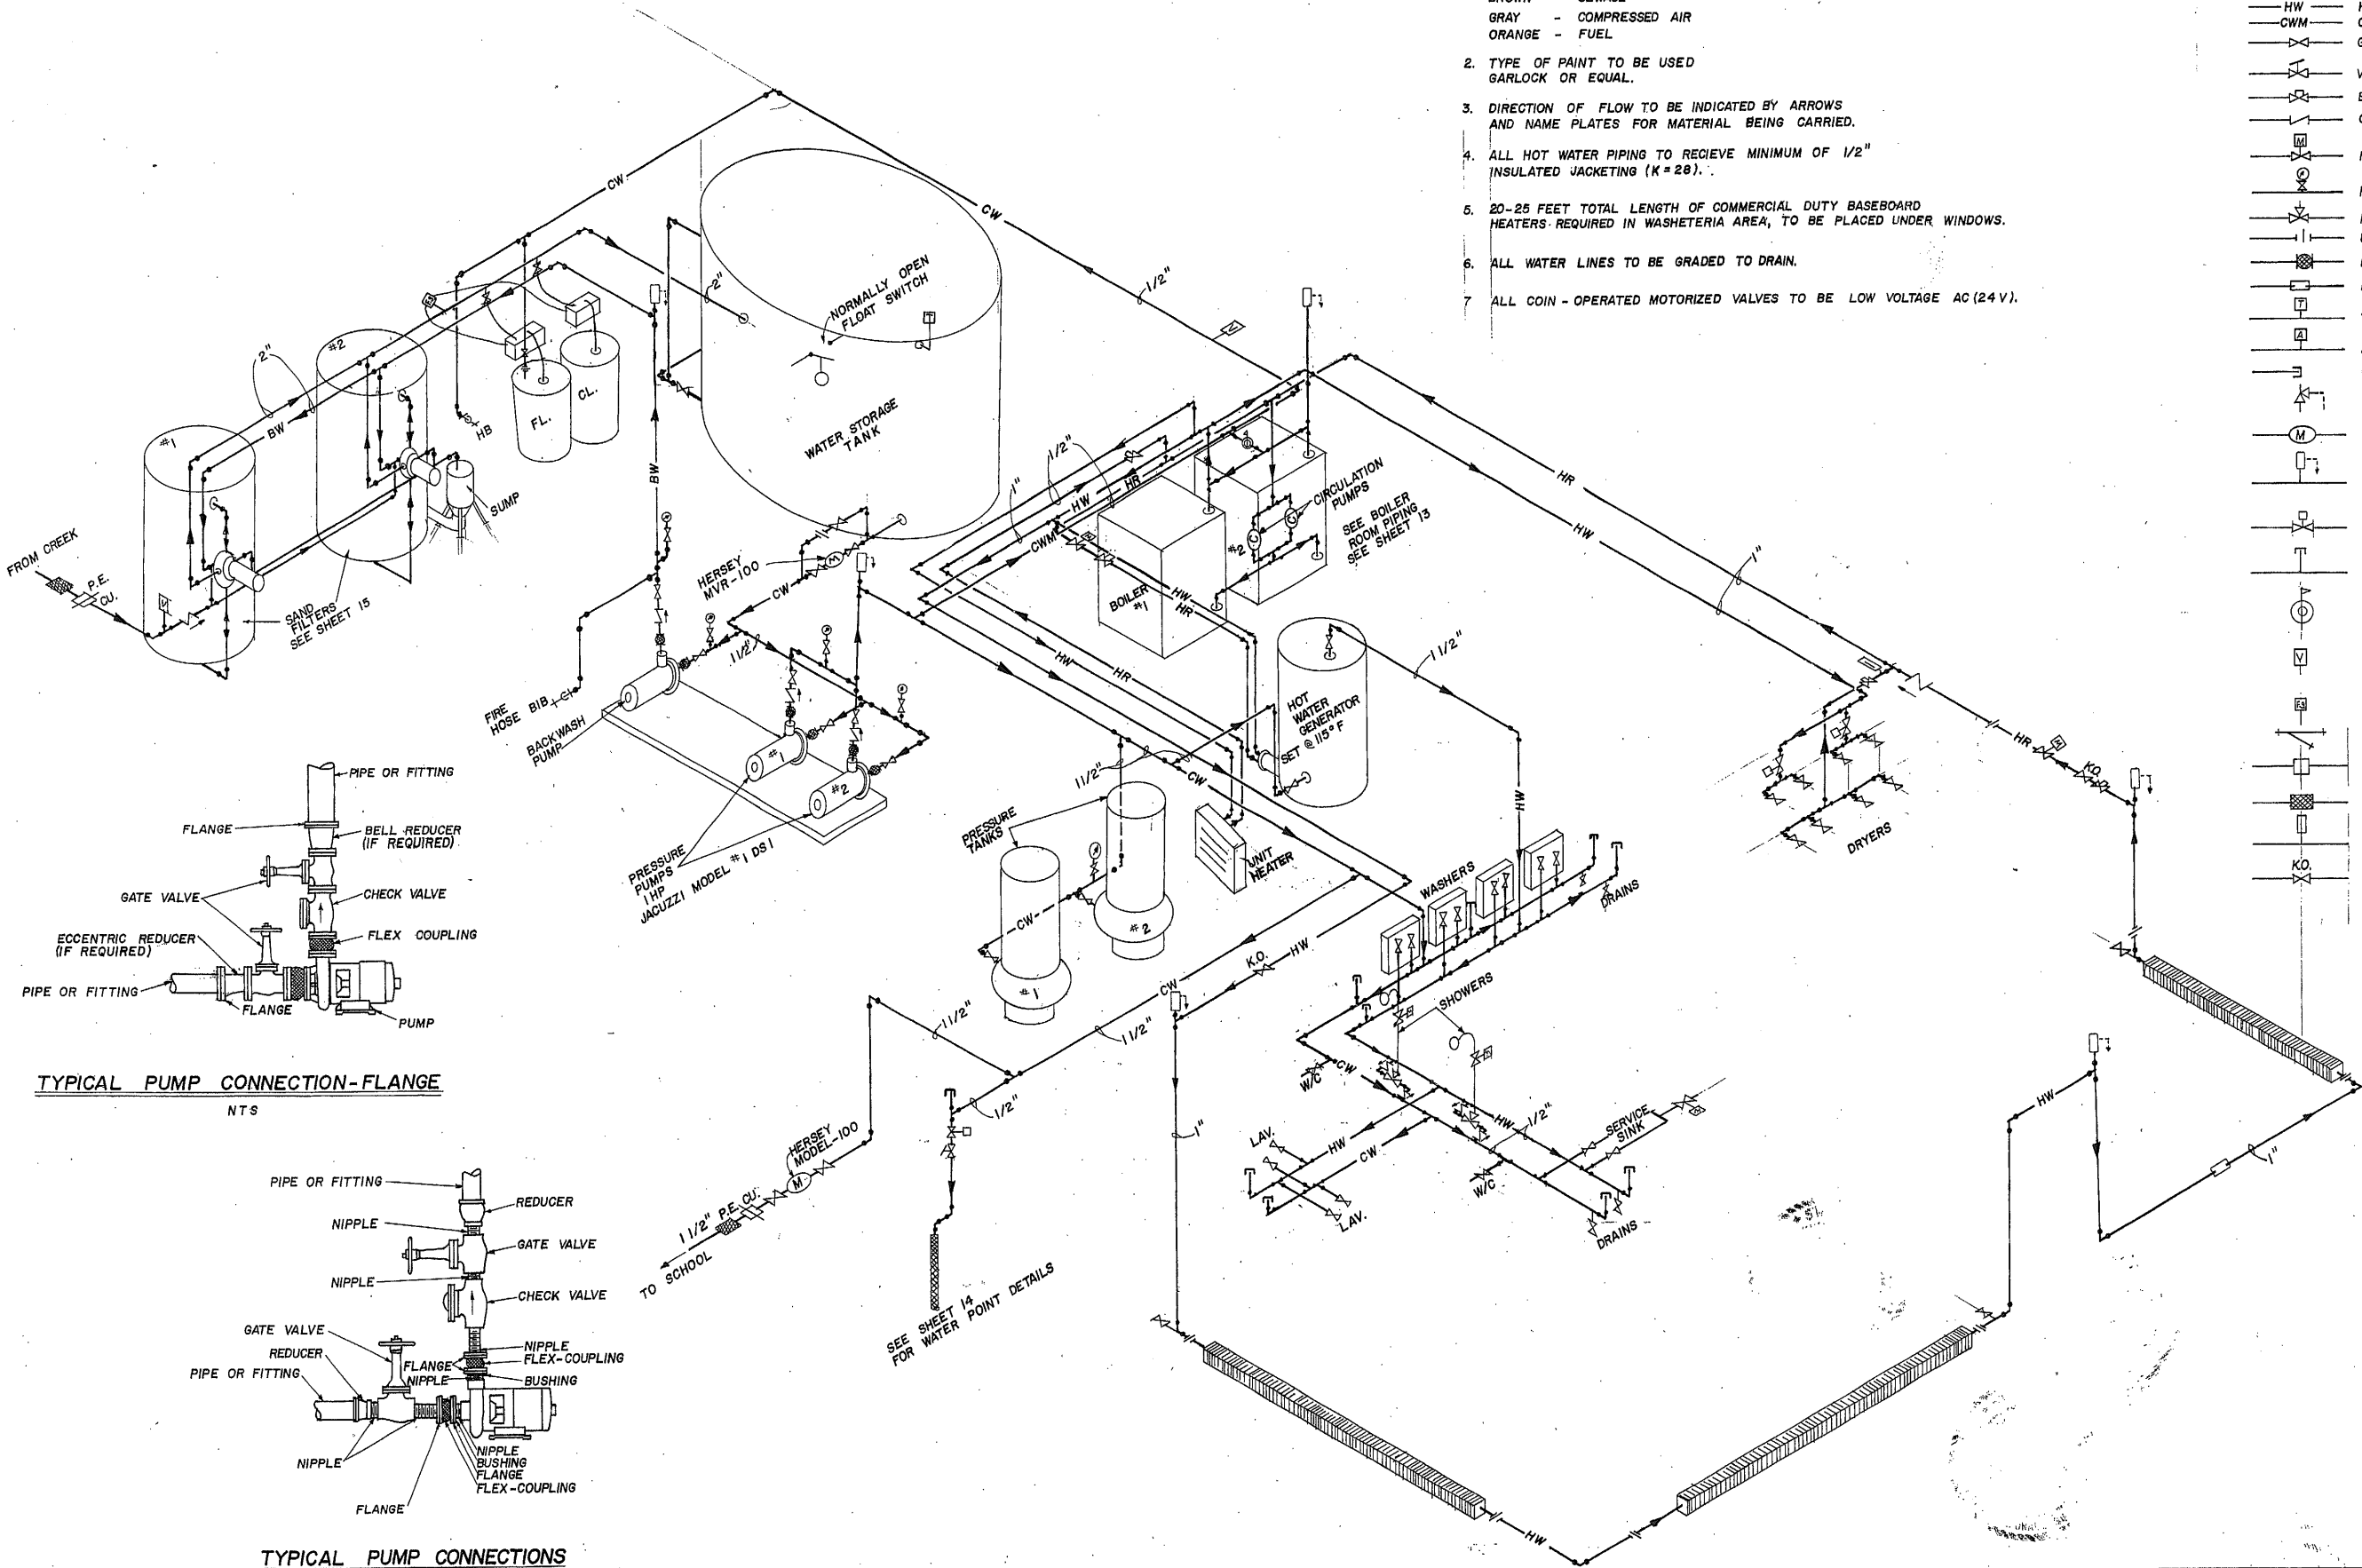


NOTE

WHEN USING COPPER & BRONZE FITTING & VALVES, DIELECTRICAL UNION MAY BE OMITTED.


DATE	REVISIONS	INITIALS
U. S. Department of Health, Education & Welfare Public Health Service Indian Health Service		
TAKOTNA, ALASKA		
WATER TREATMENT PLANT		
PLUMBING SCHEMATIC		
PUBLIC LAW 86-121 PROJECT		
PROJECT NO. AN-79-170		
SHEET NO. 12 OF 31 TOTAL SHEET		
DRAWN BY: MD		CHECKED BY: JRD
DATE: JUNE, 1979		DATE: 12-10-79



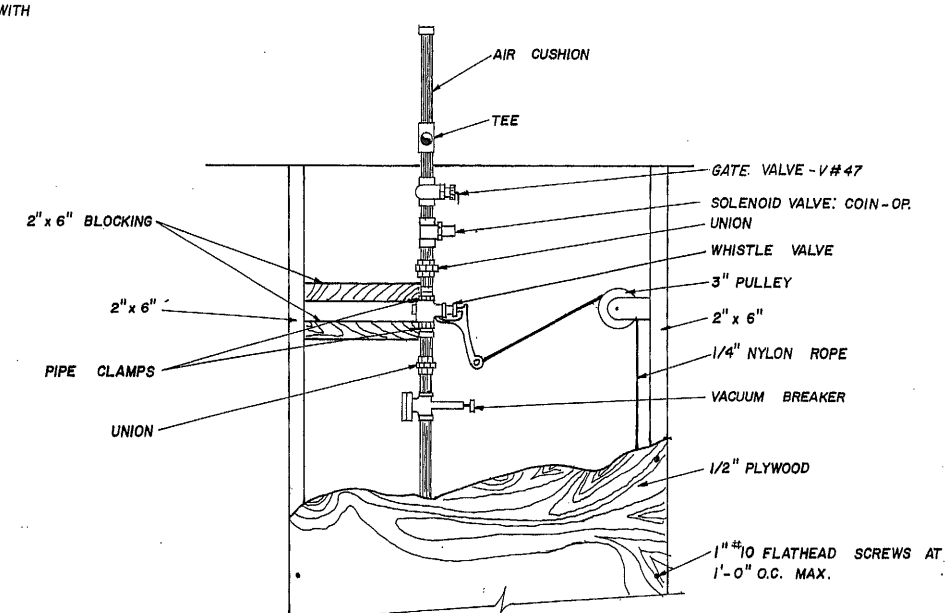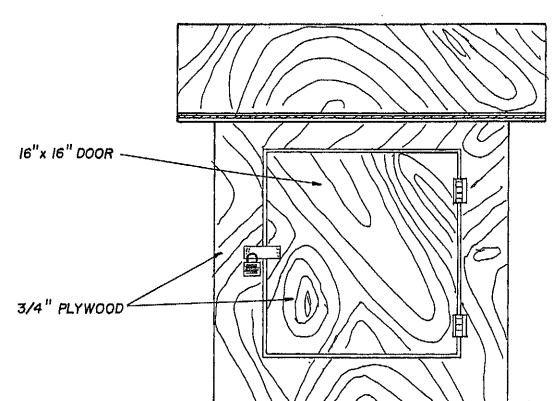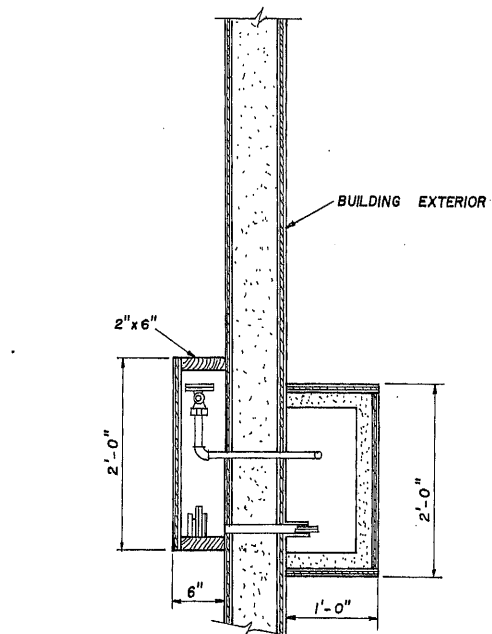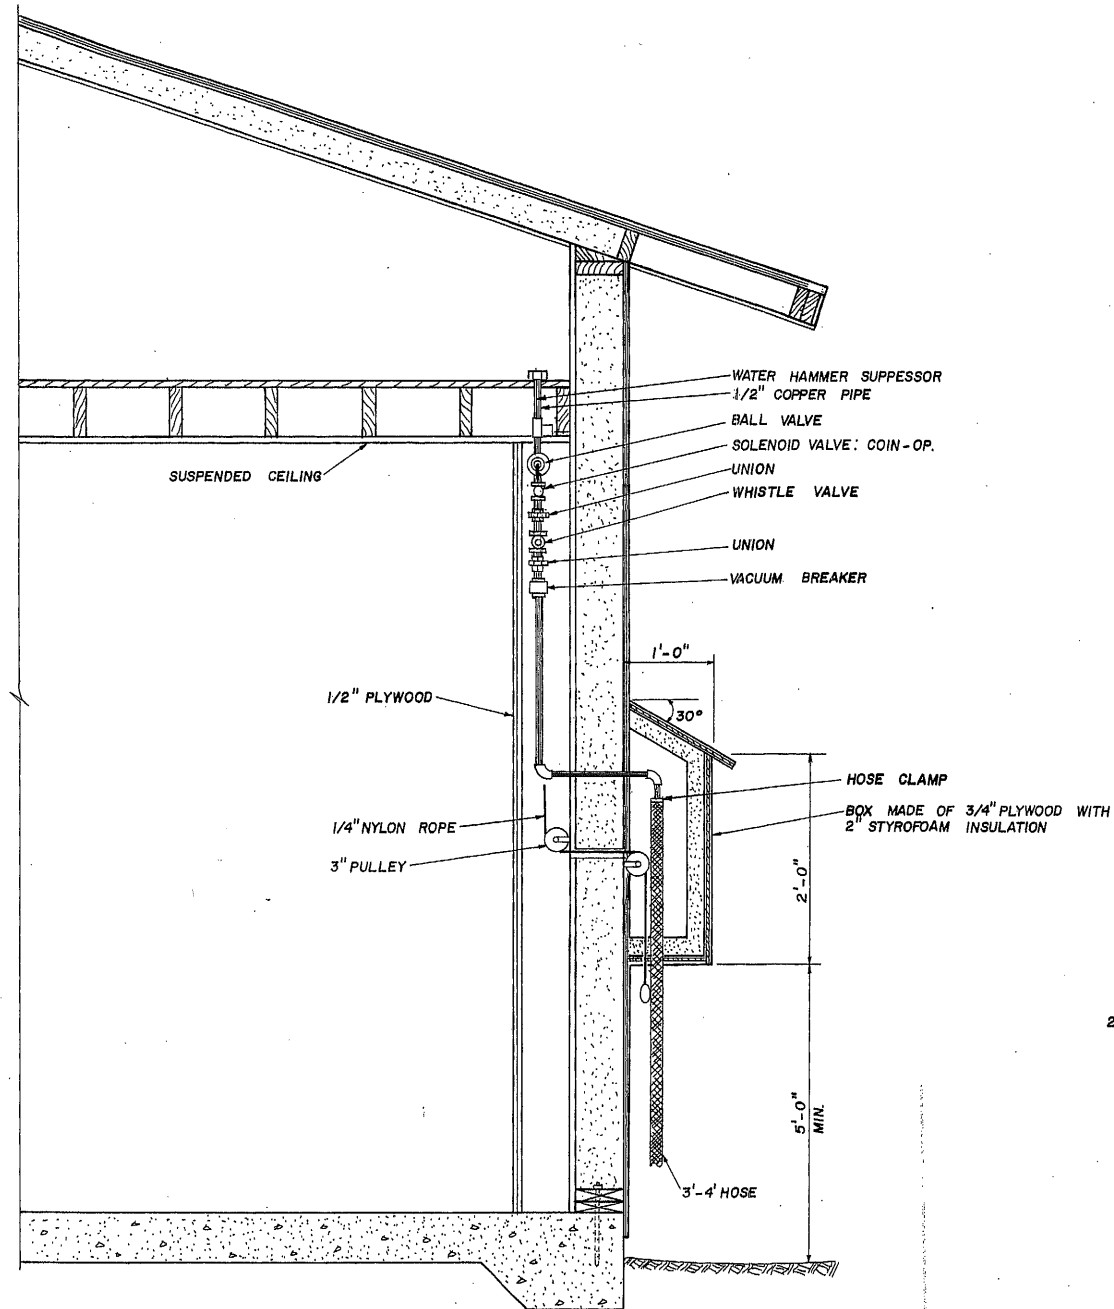




NOTE: ALL WATERING POINT PIPING - 1/2"

11-9-81	AS BUILT	B.K.
DATE	REVISIONS	INITIALS
U. S. Department of Health, Education & Welfare Public Health Service Indian Health Service		
TAKOTNA, ALASKA		SHEET NO.
WATER TREATMENT PLANT		14
WATER POINT DETAILS		OF
PUBLIC LAW 86-121 PROJECT		31
PROJECT NO. AN-79-170		TOTAL SHEETS
DRAWN BY: MD	CHECKED BY: JRD	
DATE: MAY, 1979	DATE: 12-10-79	

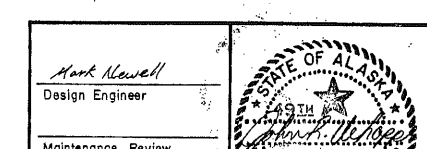

DESCRIPTION	
1.	FILTER TANK 48x60 100PSI ASME CODE-STAMPED
2.	2" MULTIPOINT VALVE-AQUAMATIC SOLO VALVE SERIES 105 D R
3.	2" GATE VALVE-125LB BRONZE SCR.D. NRS, 6 EACH
4.	IMPACT FLOW METER 4 EACH
5.	PRESSURE GAUGE/SAMPLE COCK 4 EACH
6.	AIR RELEASE
7.	11" x 15" MANHOLE
8.	4" x 6" HANDHOLE
9.	2" BALLCENTRIC VALVE - BACKWASH WASTE CONTROL, 2 EACH


- NOTES**
- A. INTERIOR SURFACES - SANDBLASTED AND COATED WITH COAL TAR EPOXY, 2 COATS 8-10 MIL EACH, 16 MIL MINIMUM TOTAL.
- B. EXTERIOR SURFACES, SAND BLASTED AND COATED WITH ONE COAT ZINK PRIMER 2.5 MILS MINIMUM THICKNESS.
- C. FRONT PIPING - SCHEDULE 40 BLACK STEEL WITH 150 PSI FITTINGS, 2".
- D. DASH LINE PIPING BY OTHERS.
- E. DRAINS TO BE PLUMBED TO DRAIN INTO SUMP (BY OTHERS).

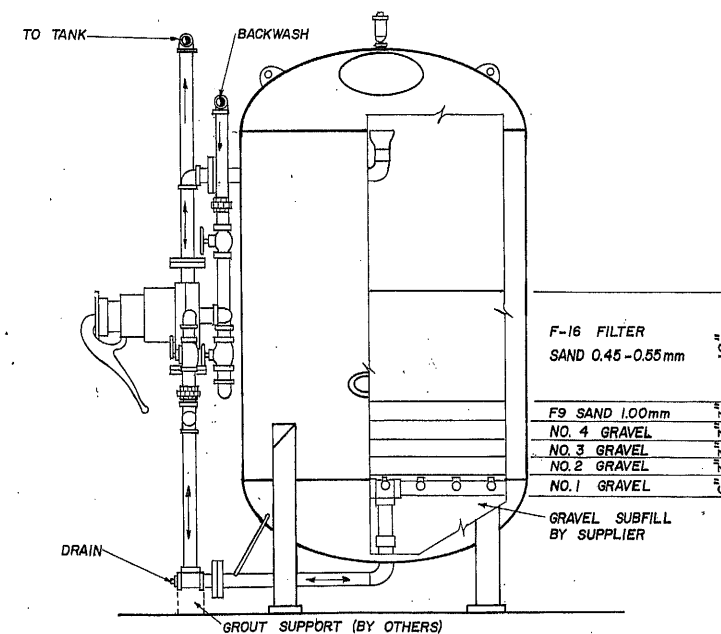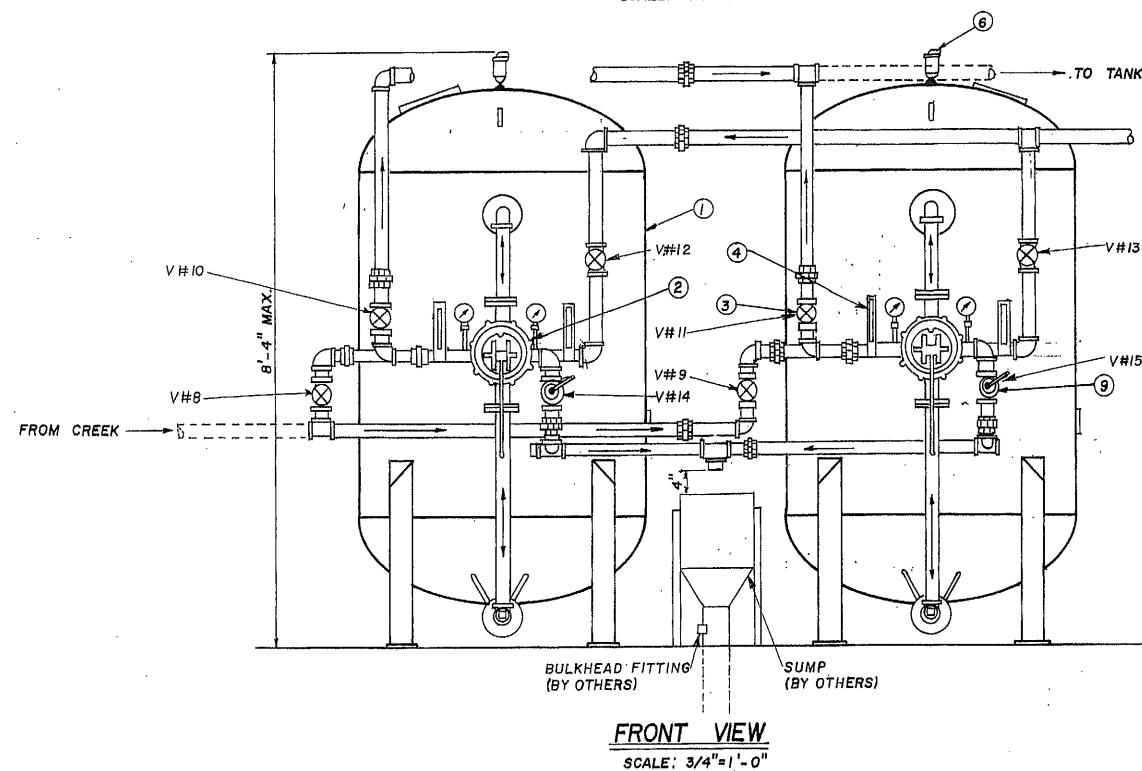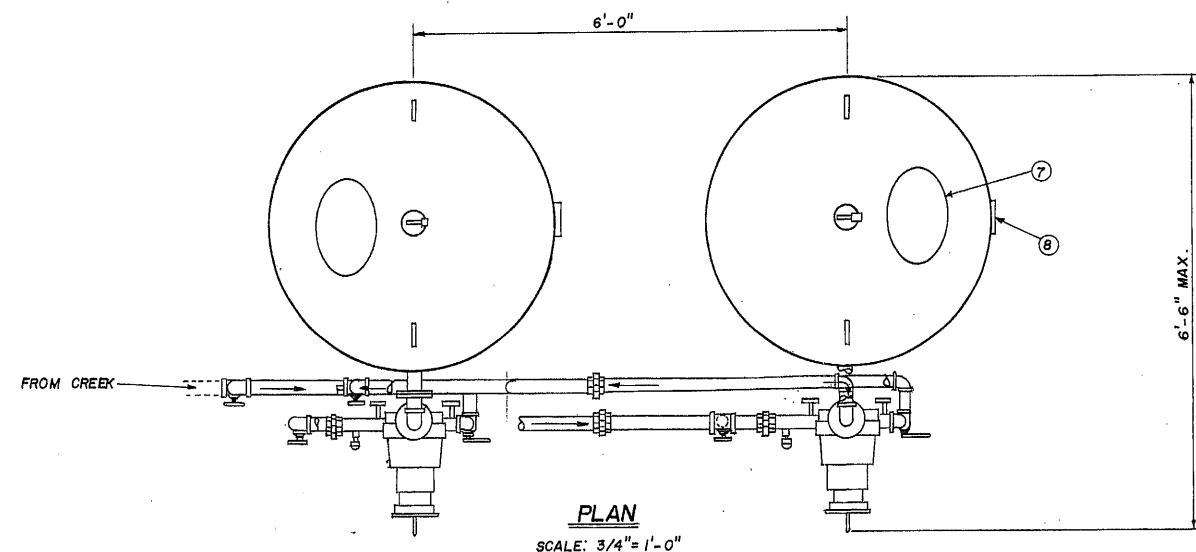


11-13-81	AS BUILT	B.K.
DATE	REVISIONS	INITIALS
U. S. Department of Health, Education & Welfare Public Health Service Indian Health Service		
TAKOTNA, ALASKA STANDARD 2" MULTIPOINT VALVE PIPING FOR 48' SAND FILTER PUBLIC LAW 86-121 PROJECT PROJECT NO. AN-79-170		SHEET NO. 15 OF 31 TOTAL SHEETS
DRAWN BY: MD DATE: APRIL, 1979		CHECKED BY: JED DATE: 12-10-79

Mark Newell
Design Engineer

Maintenance Review

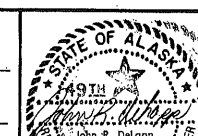

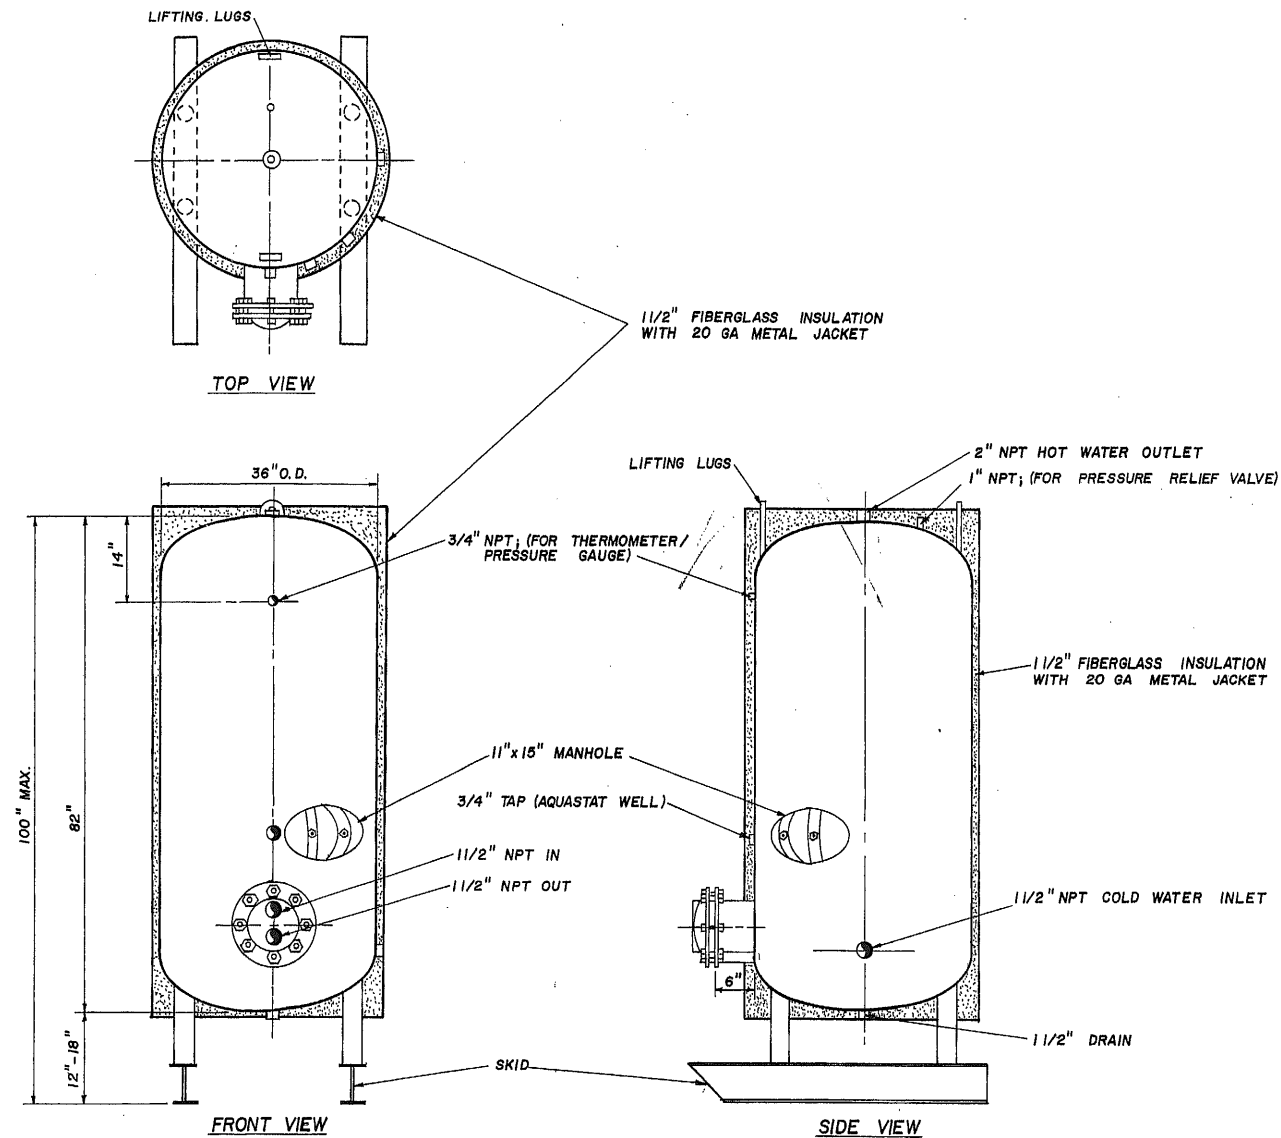

HOT WATER GENERATOR DETAIL
SCALE: 3/4"=1'-0"

NOTES

1. ASME PRESSURE RATED TO 125 PSI.
2. APPROXIMATE STORAGE CAPACITY 325 GALLONS.
3. ALL TAPS TO BE EXTRA STORAGE COUPLINGS.
4. EXTERIOR OF TANK TO BE PAINTED WITH ZINC PRIMER, MINIMUM DRY FILM THICKNESS 2 MIL.
5. TANK INTERIOR SHALL HAVE CATALYTIC SET PHENOLIC COATING, MINIMUM DRY FILM THICKNESS 6 MIL.

DATE	REVISIONS	INITIALS
U. S. Department of Health, Education & Welfare Public Health Service Indian Health Service		
TAKOTNA, ALASKA		SHEET NO.
WATER TREATMENT PLANT		16
HOT WATER GENERATOR DETAIL		OF
PUBLIC LAW 86-121 PROJECT		31
PROJECT NO. AN-79-170		TOTAL SHEETS
DRAWN BY: MD		CHECKED BY: TPO
DATE: MAY, 1979		DATE: 12-10-79

Mark Newell Design Engineer	ALASKA John R. Dalapp NO. 4000-E
Maintenance Review	