



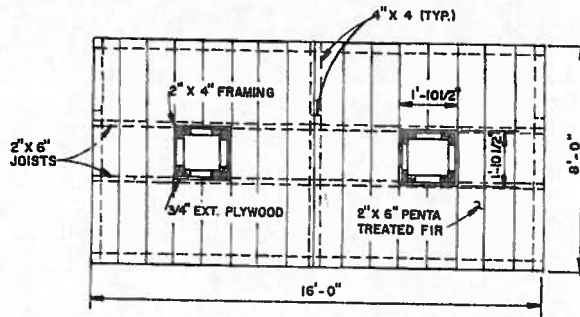


PLAN
NTS

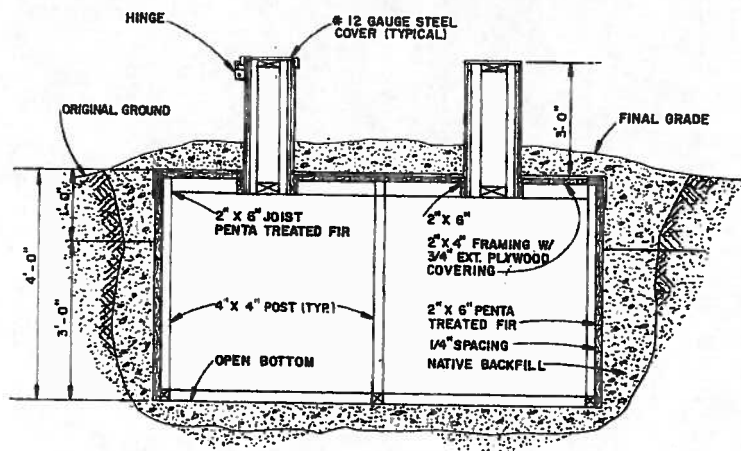


ELEVATION
NTS



SEWAGE DISPOSAL BUNKER

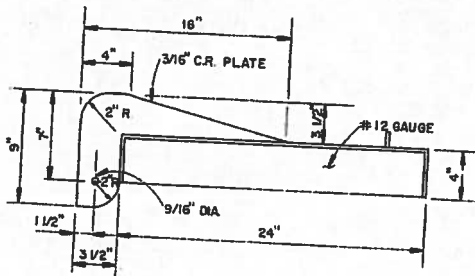

HINGE LID
NTS

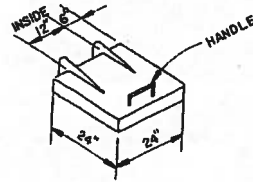

NOTE:
PRIME COAT WITH RED
OXIDE OR EQUAL

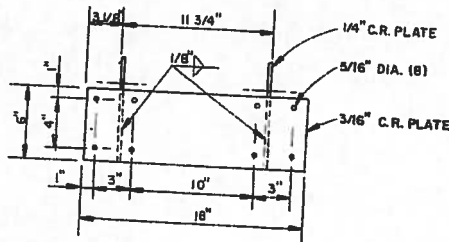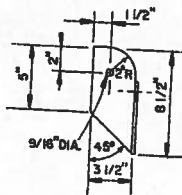

HINGE PLATE
NTS

NOTE:

INSTALL 4 BUNKERS AT LOCATIONS SELECTED BY THE
CITY COUNCIL AND PROJECT ENGINEER.

2/2/84 AS BUILT		PCB
DATE	REVISIONS	INITIALS
U. S. Department of Health, & Human Services Public Health Service Indian Health Service		
TUNTUTULIAK, ALASKA		SHEET NO. M-13
SEWAGE DISPOSAL BUNKER DETAILS PUBLIC LAW 86-121 PROJECT PROJECT NO. AN-81-263		OF 14 TOTAL SHEETS
DRAWN BY: B. KIRSCHBAUM	CHECKED BY: J. Bond	
DATE: JULY 1981	DATE: 8/82	
SANITATION FACILITIES CONSTRUCTION BRANCH ENVIRONMENTAL HEALTH BRANCH ALASKA AREA NATIVE HEALTH SERVICE ANCHORAGE, ALASKA		

