

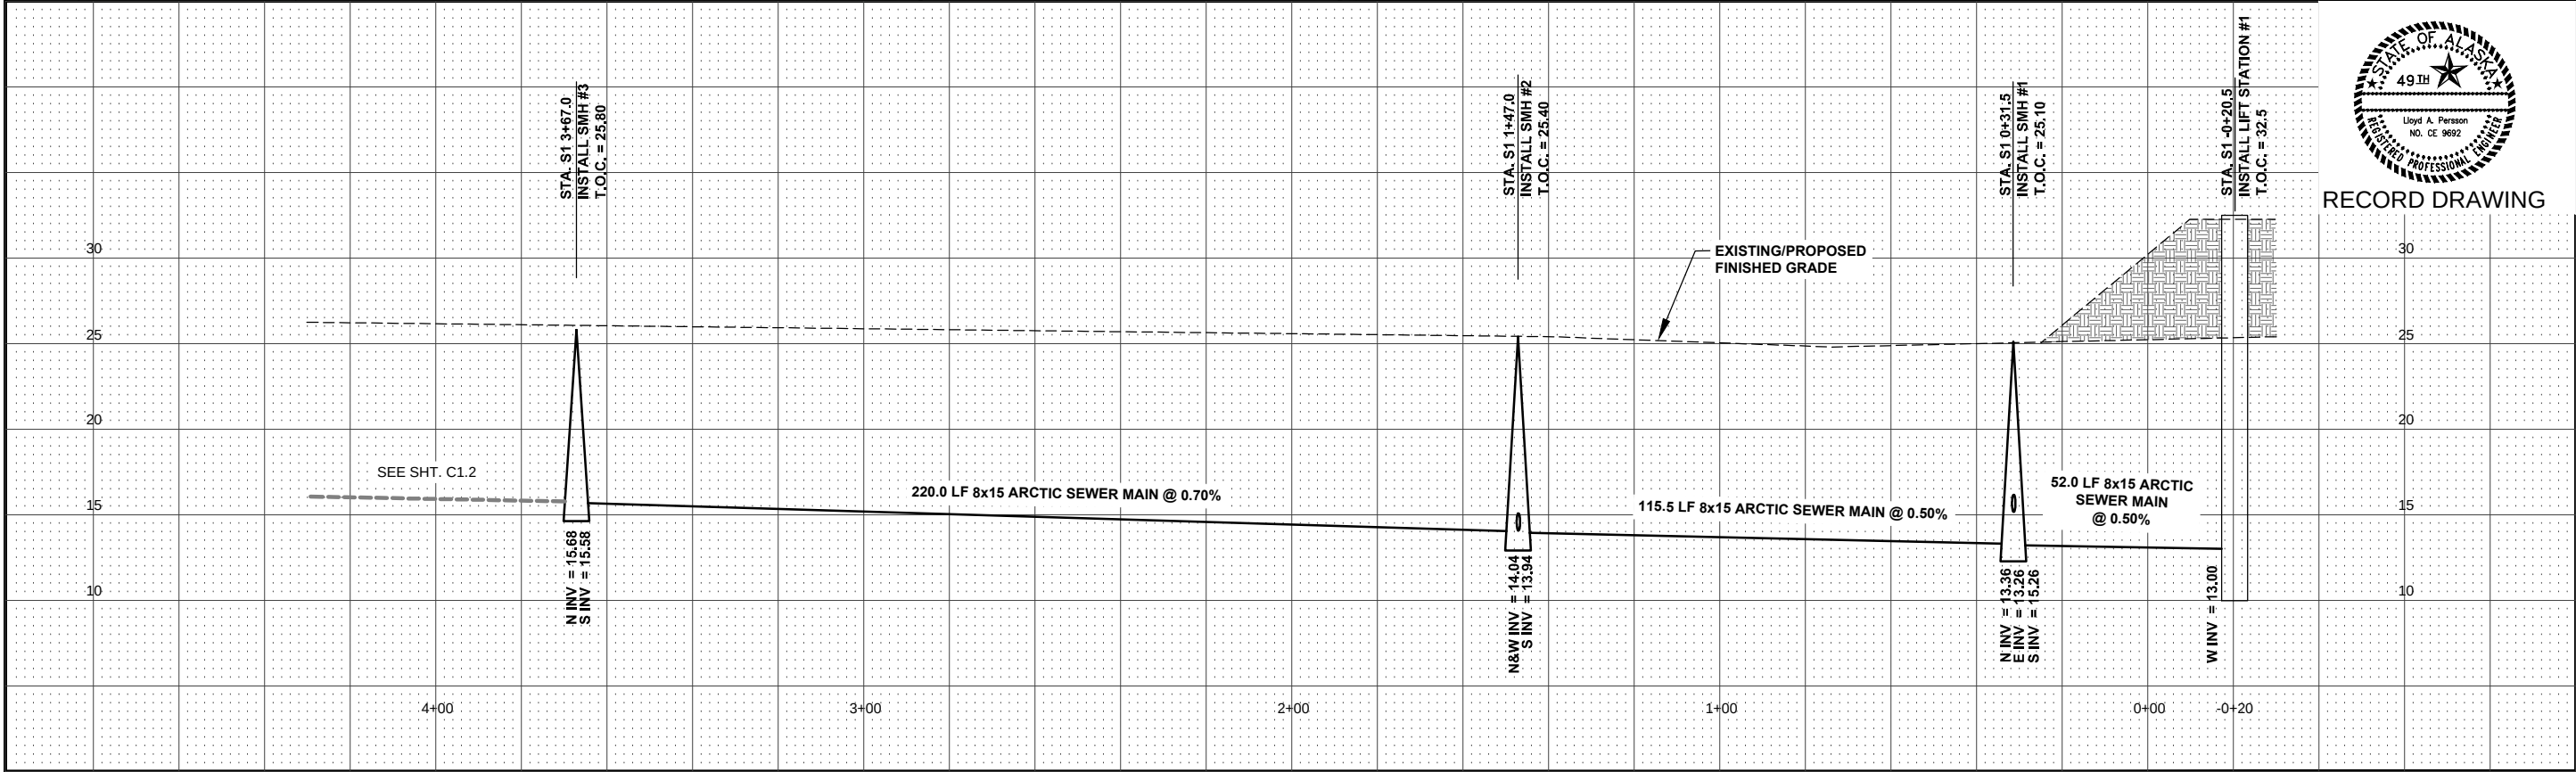
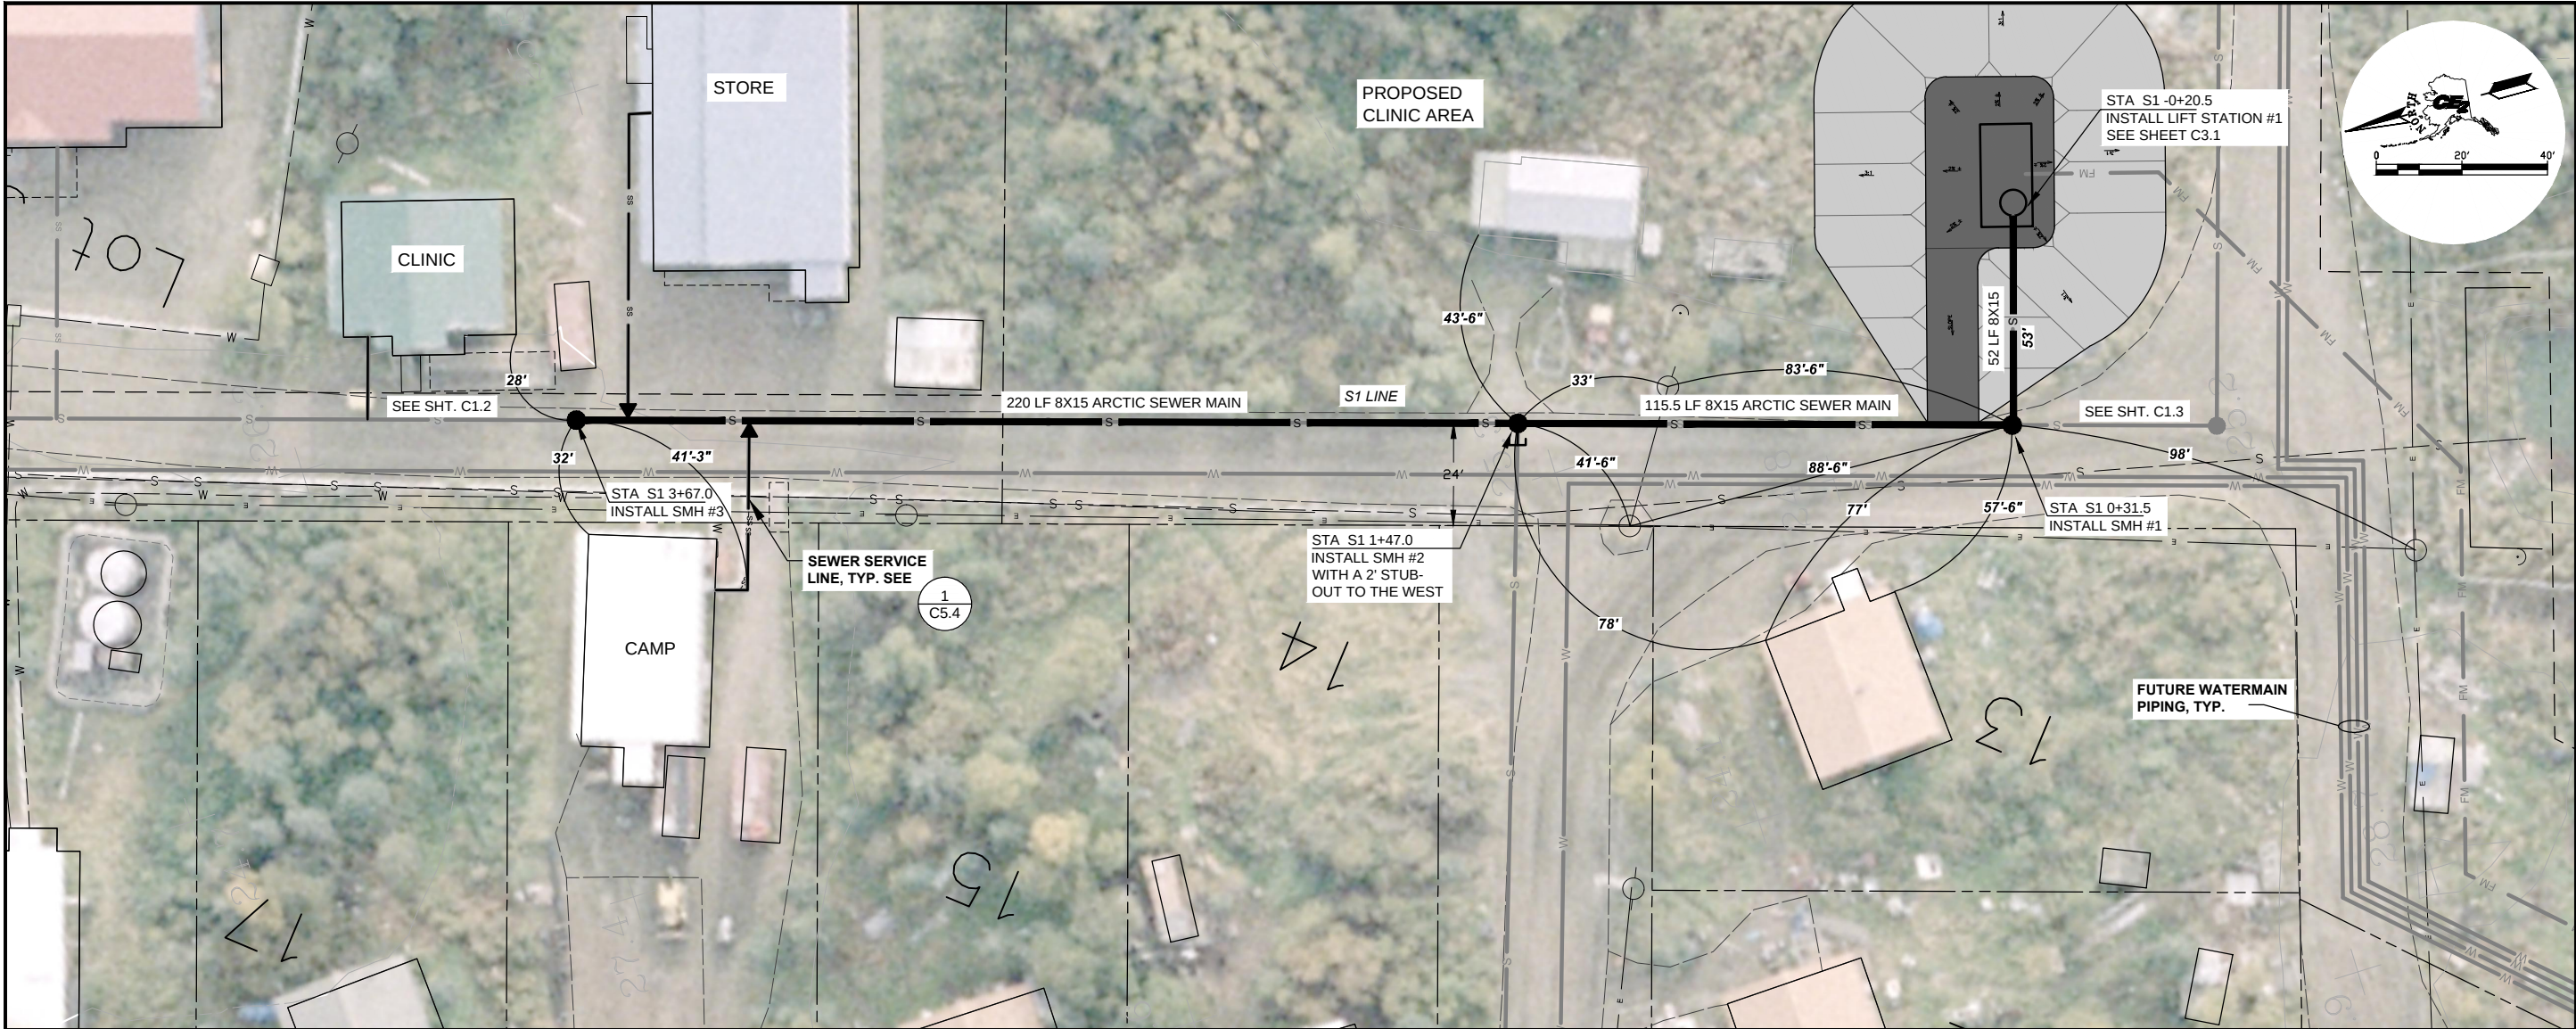


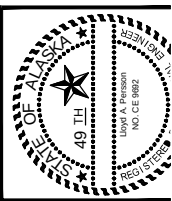

RECORD DRAWING CERTIFICATE
THESE DRAWINGS REFLECT RECORDED
INFORMATION OBTAINED DURING
CONSTRUCTION. INFORMATION PROVIDED
HEREIN IS ACCURATE TO THE BEST OF MY
KNOWLEDGE.

SCALE:
PLAN 1"=20'
PROF 1"=5'
BARS ONE INCH ON
ORIGINAL DRAWING
0 1'
IF NOT ONE INCH ON


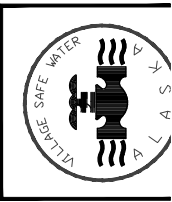


2010-11 WASTEWATER
SYSTEM IMPROVEMENTS
S1 GRAVITY SEWER
PLAN AND PROFILE





REVISION	BY	DATE

Project No. _____
Date JUNE 2009
Designed LAP
Drawn LAW
Sheet No. C1.1

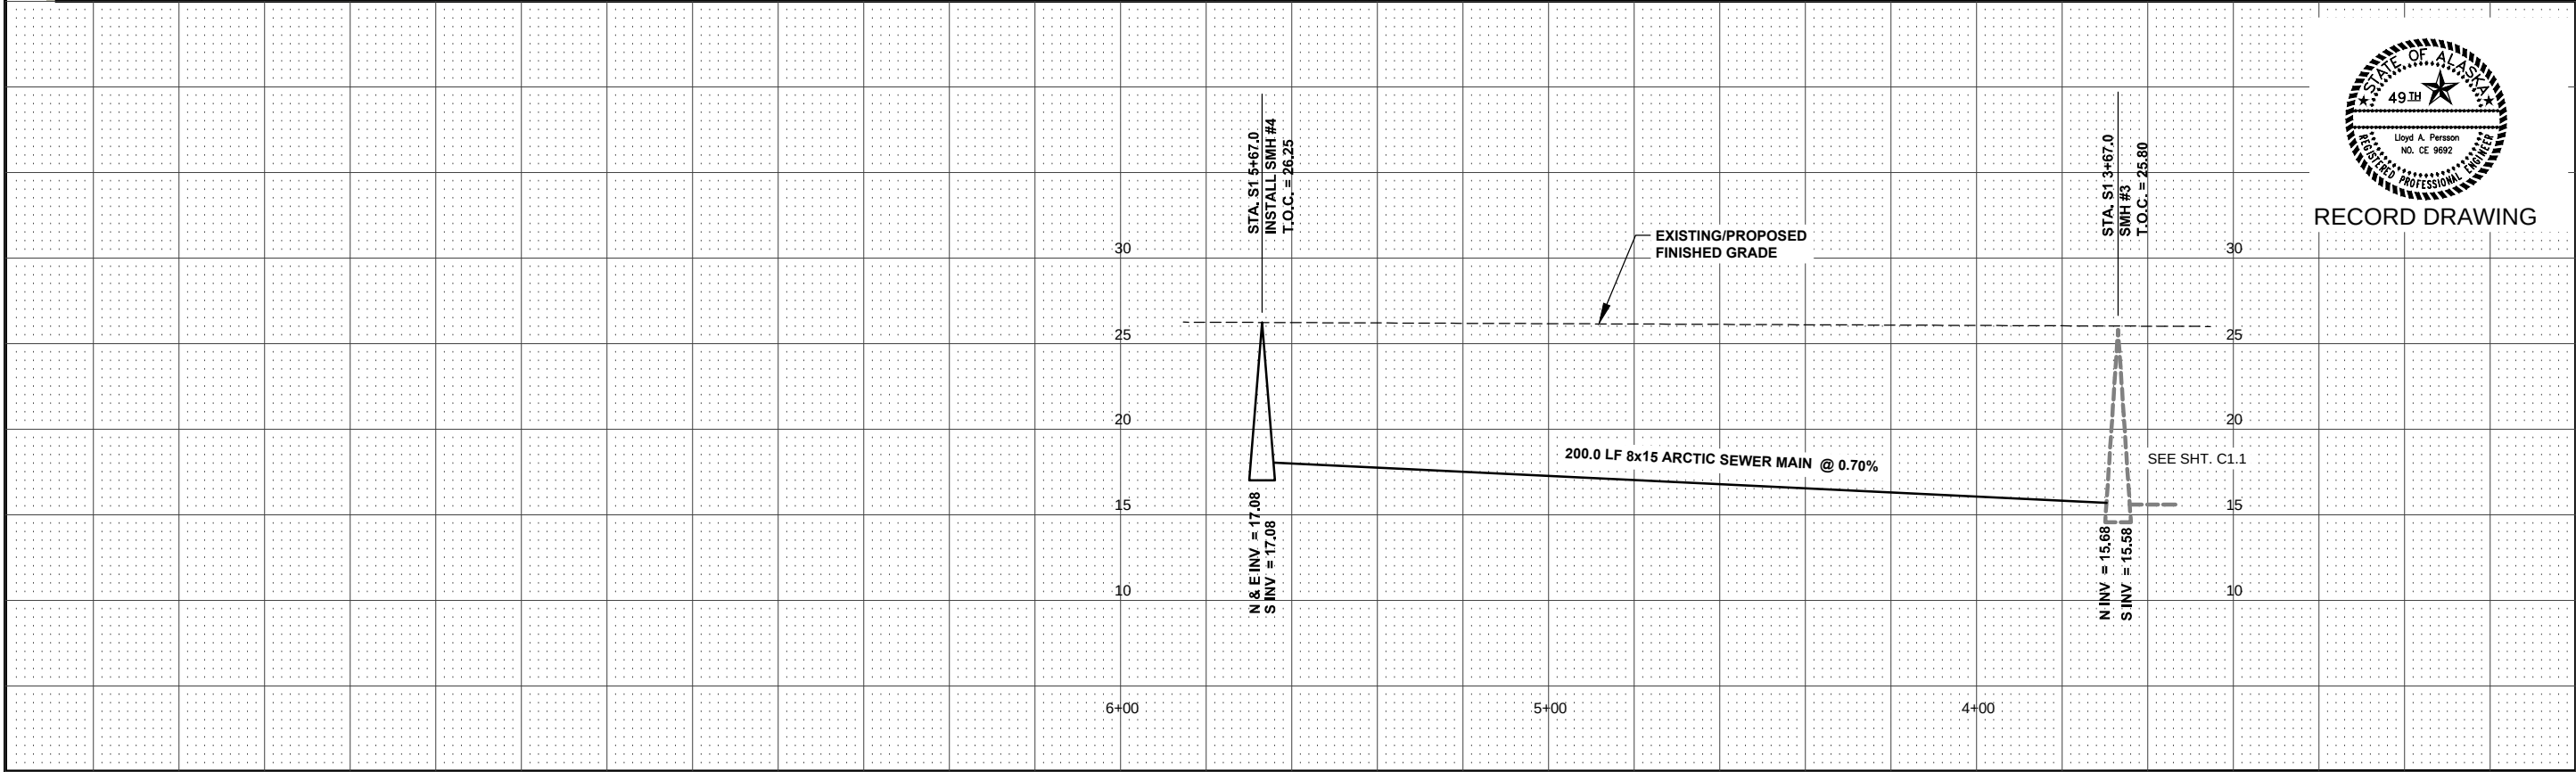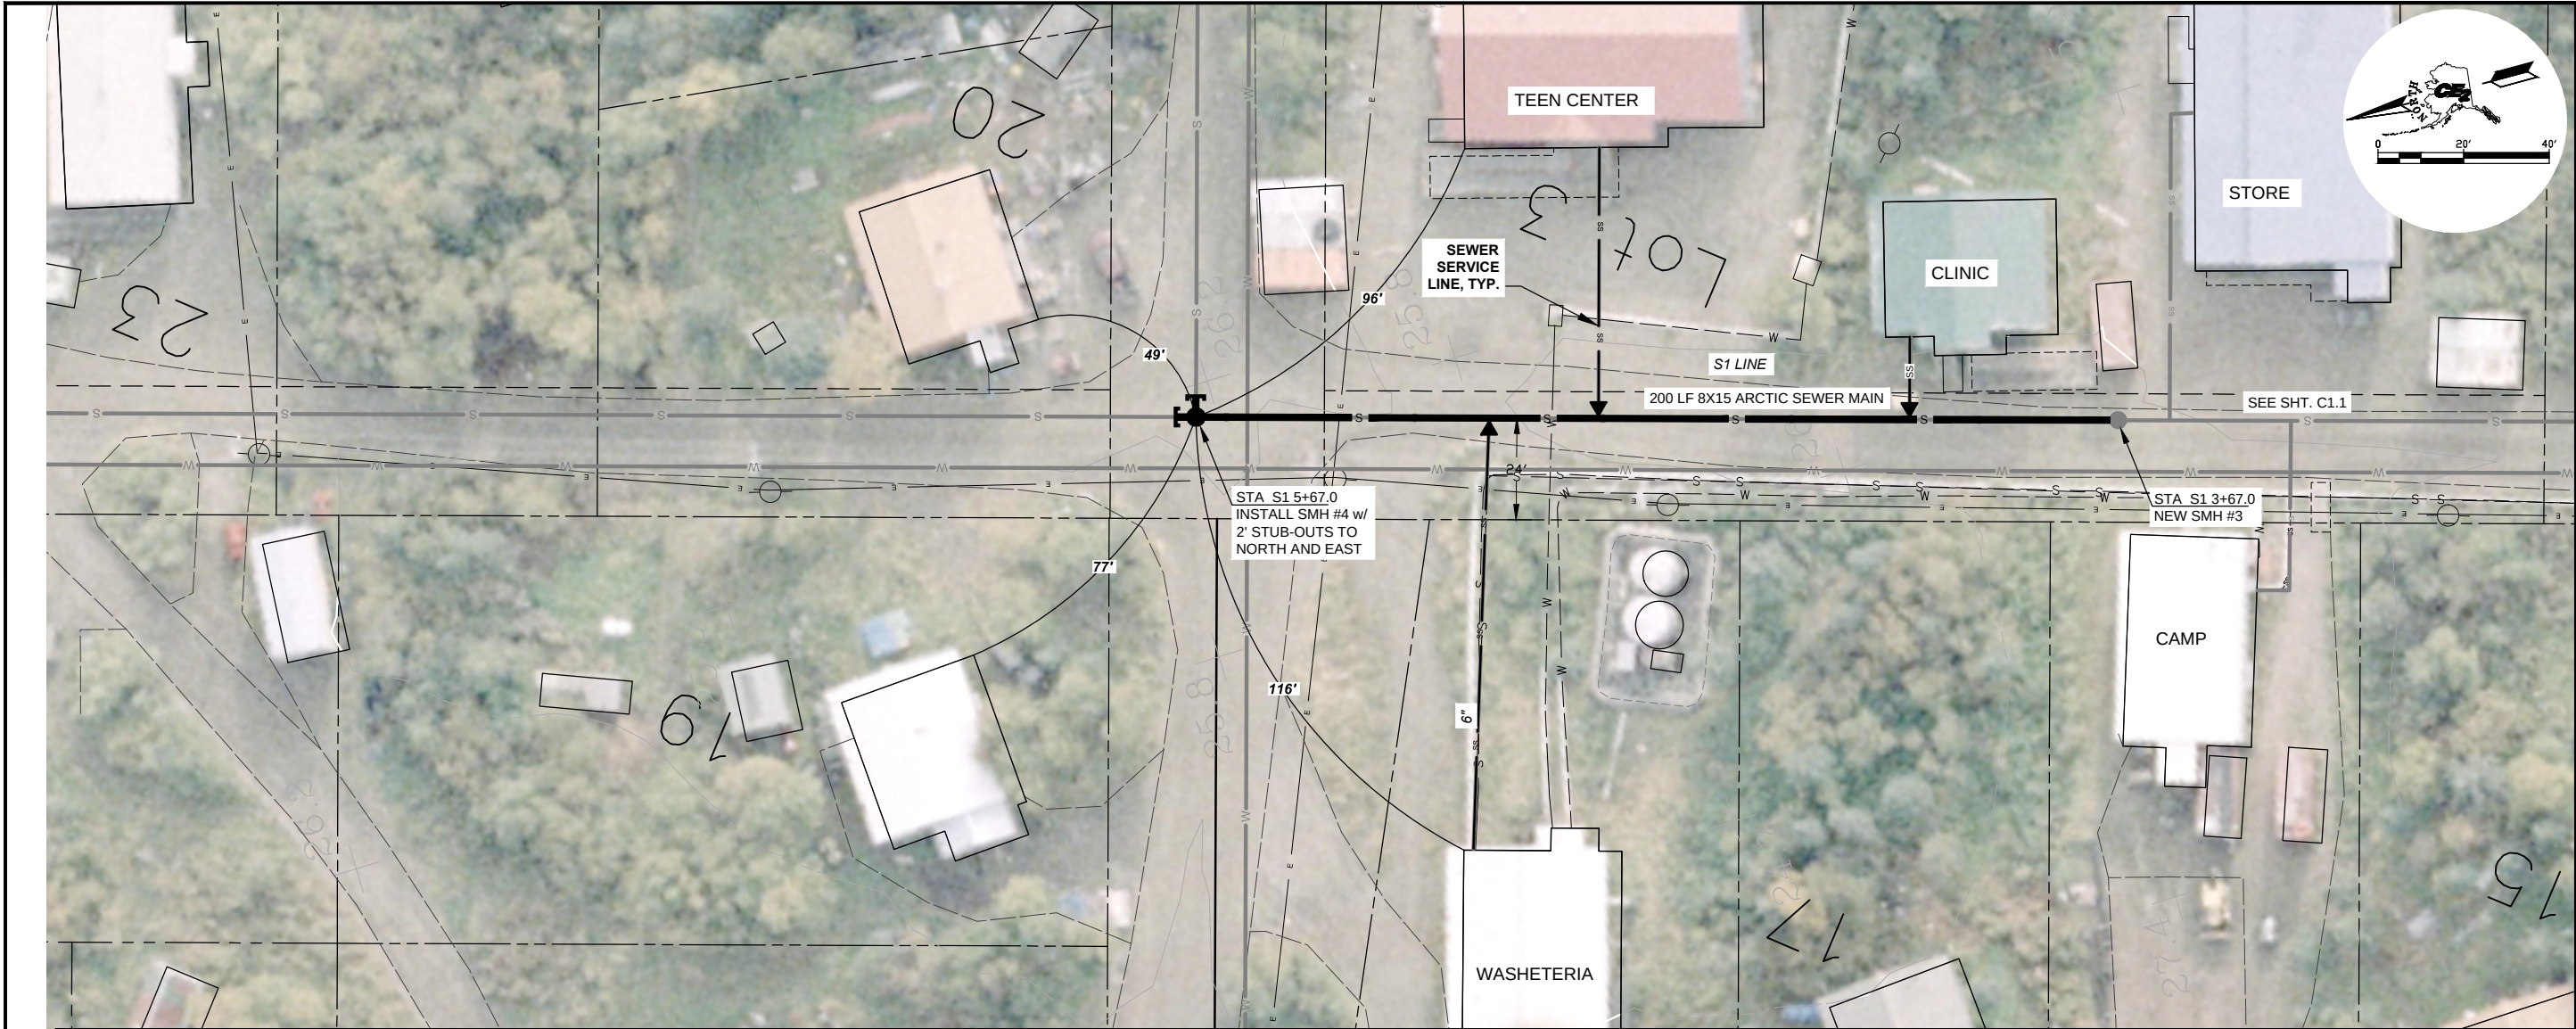

RECORD DRAWING CERTIFICATE
THESE DRAWINGS REFLECT RECORDED
INFORMATION OBTAINED DURING
CONSTRUCTION. INFORMATION PROVIDED
HEREIN IS ACCURATE TO THE BEST OF MY
KNOWLEDGE.

SCALE:
PLAN 1"=20'
PROF 1"=5'
BAR IS ONE INCH ON
ORIGINAL DRAWING
0 1' IF NOT ONE INCH ON

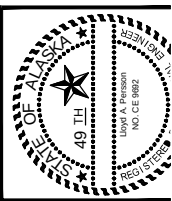
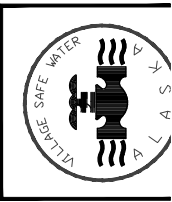


2010-11 WASTEWATER
SYSTEM IMPROVEMENTS
S1 GRAVITY SEWER
PLAN AND PROFILE





REVISION	BY	DATE

Project No. _____ Date JUNE 2009 Designed LAP
Drawn LAW LAY
Sheet No. C1.2

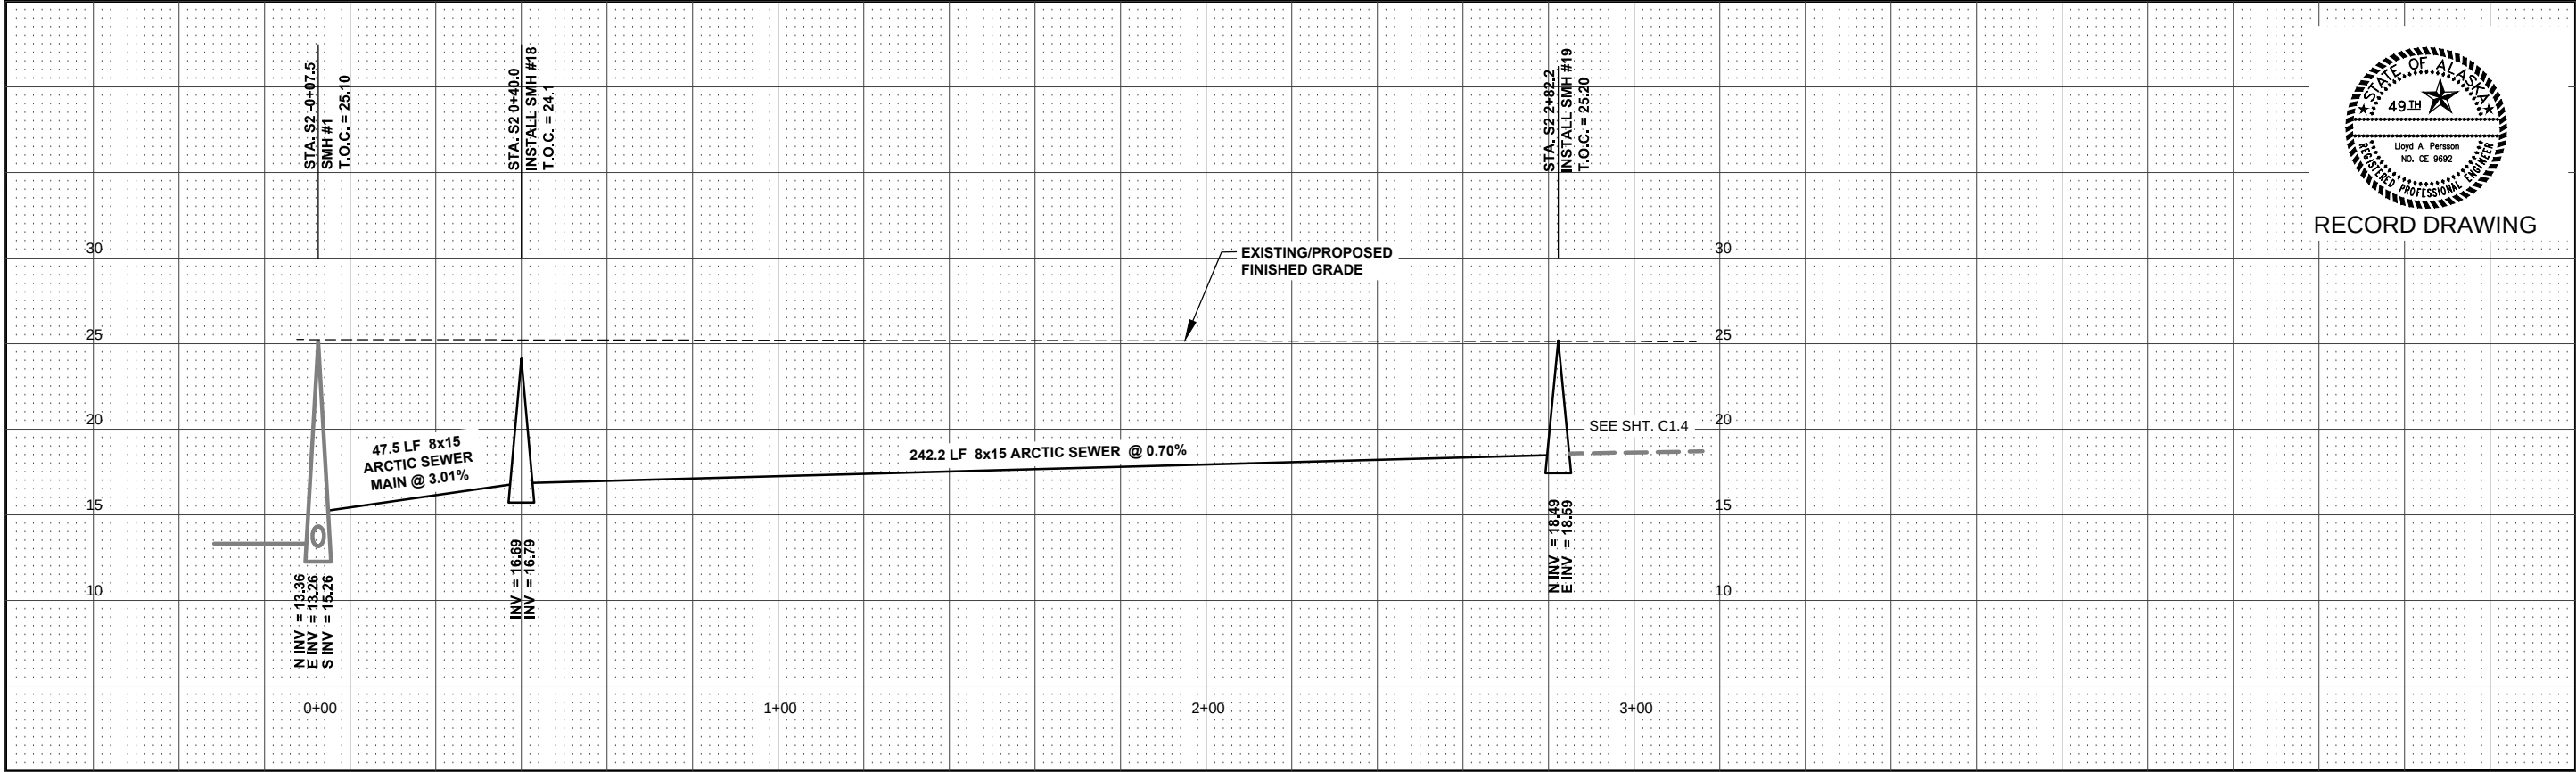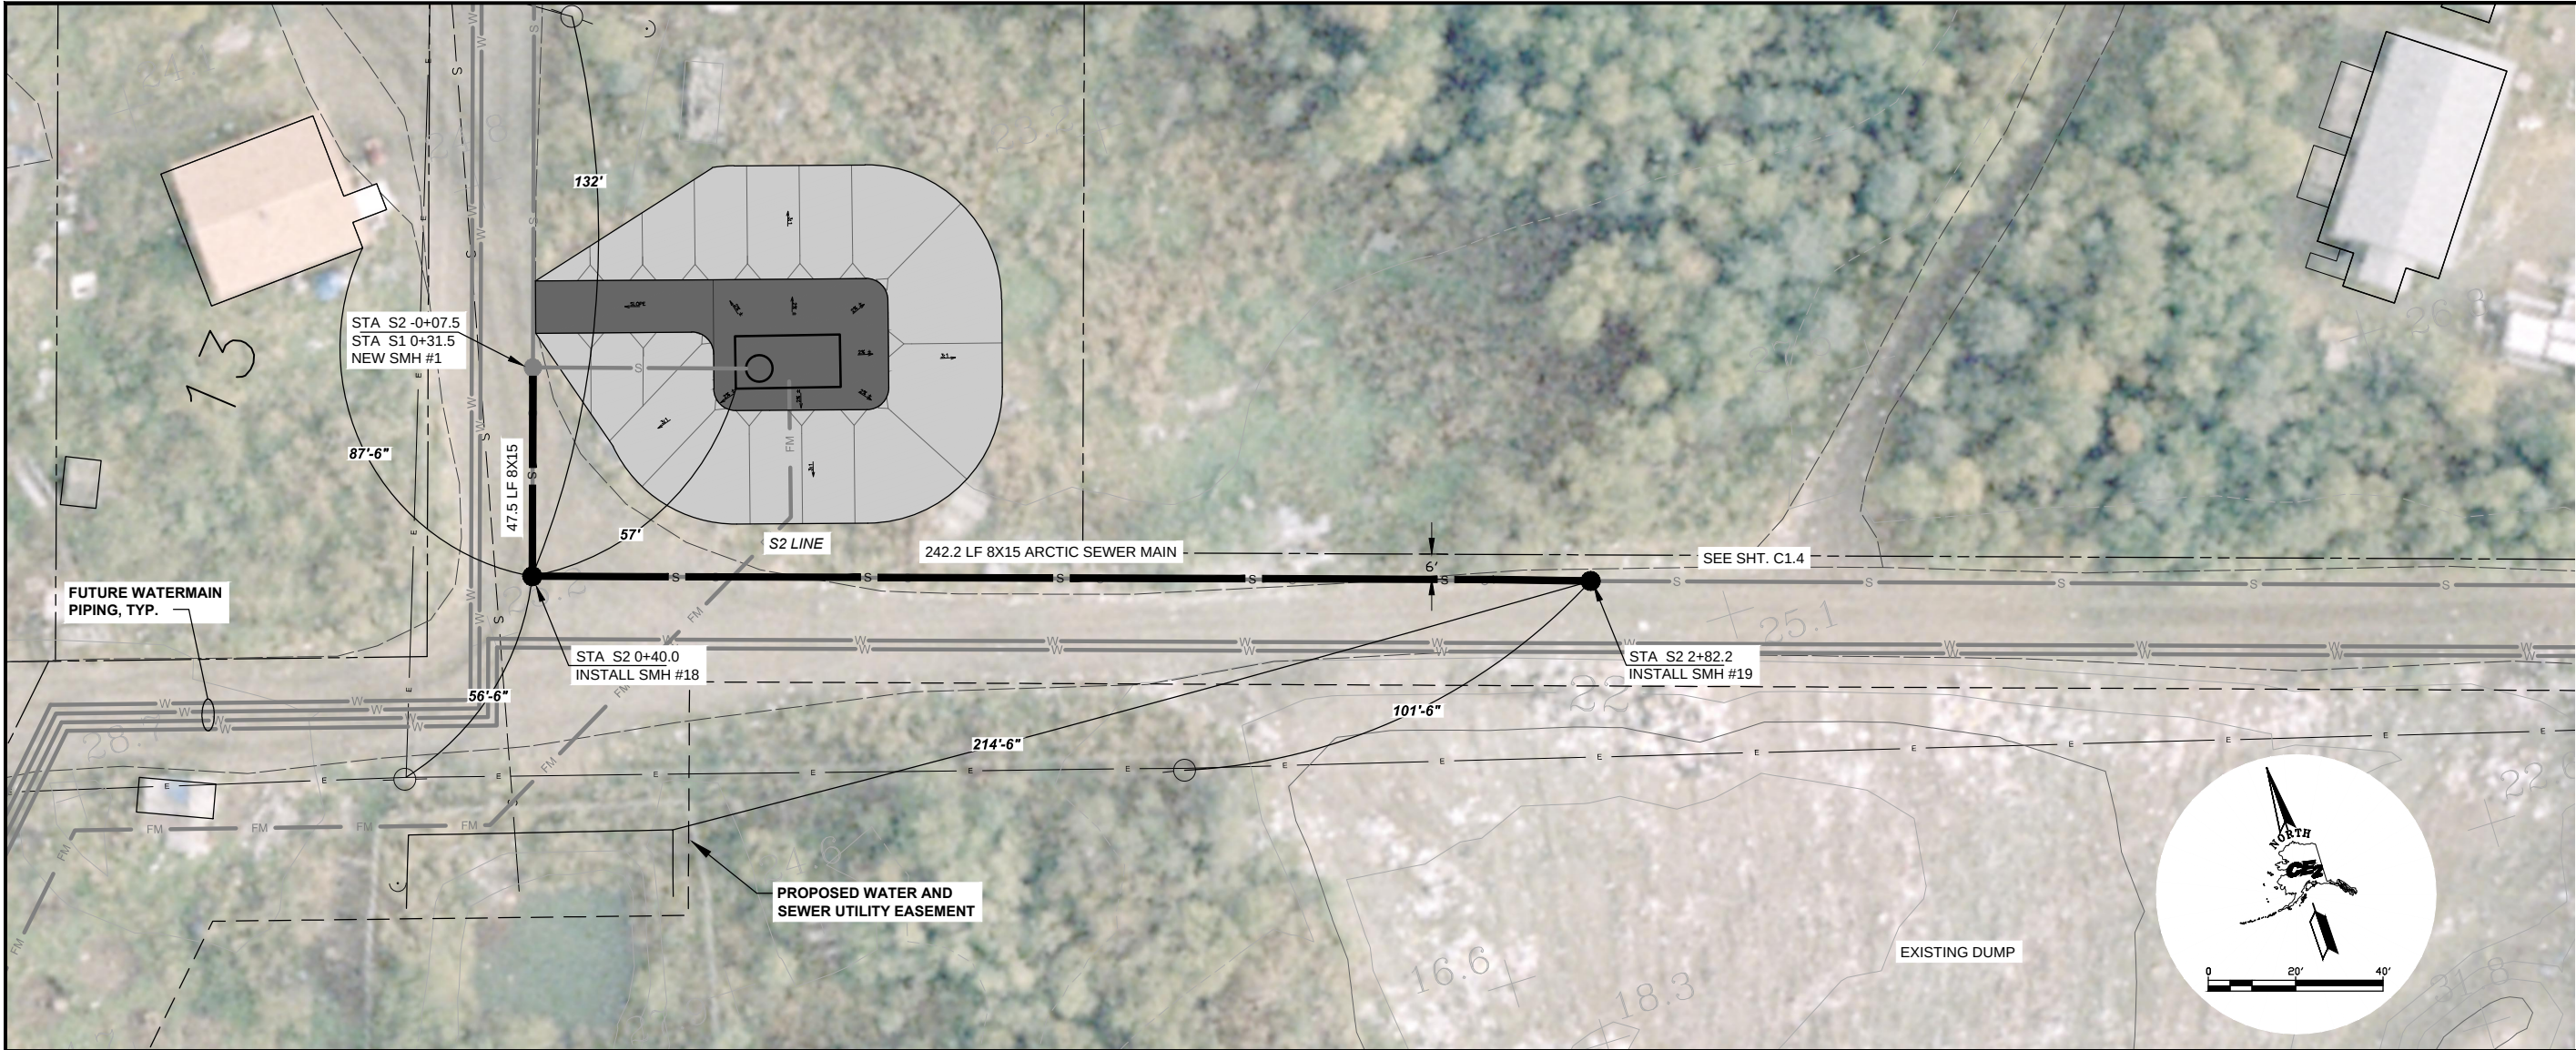

RECORD DRAWING CERTIFICATE
THESE DRAWINGS REFLECT RECORDED
INFORMATION OBTAINED DURING
CONSTRUCTION. INFORMATION PROVIDED
HEREIN IS ACCURATE TO THE BEST OF MY
KNOWLEDGE.

SCALE:
PLAN 1"=20'
PROF 1"=5'
BAR IS ONE INCH ON
ORIGINAL DRAWING
0 1' IF NOT ONE INCH ON

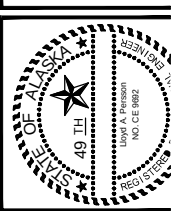
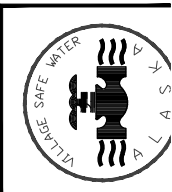


2010-11 WASTEWATER
SYSTEM IMPROVEMENTS
S2 GRAVITY SEWER
PLAN AND PROFILE



REVISION	BY	DATE

Project No. _____ Date JUNE 2009
Designed by LAP
Drawn by LAW
Annotator LAP
Sheet No. C1.3

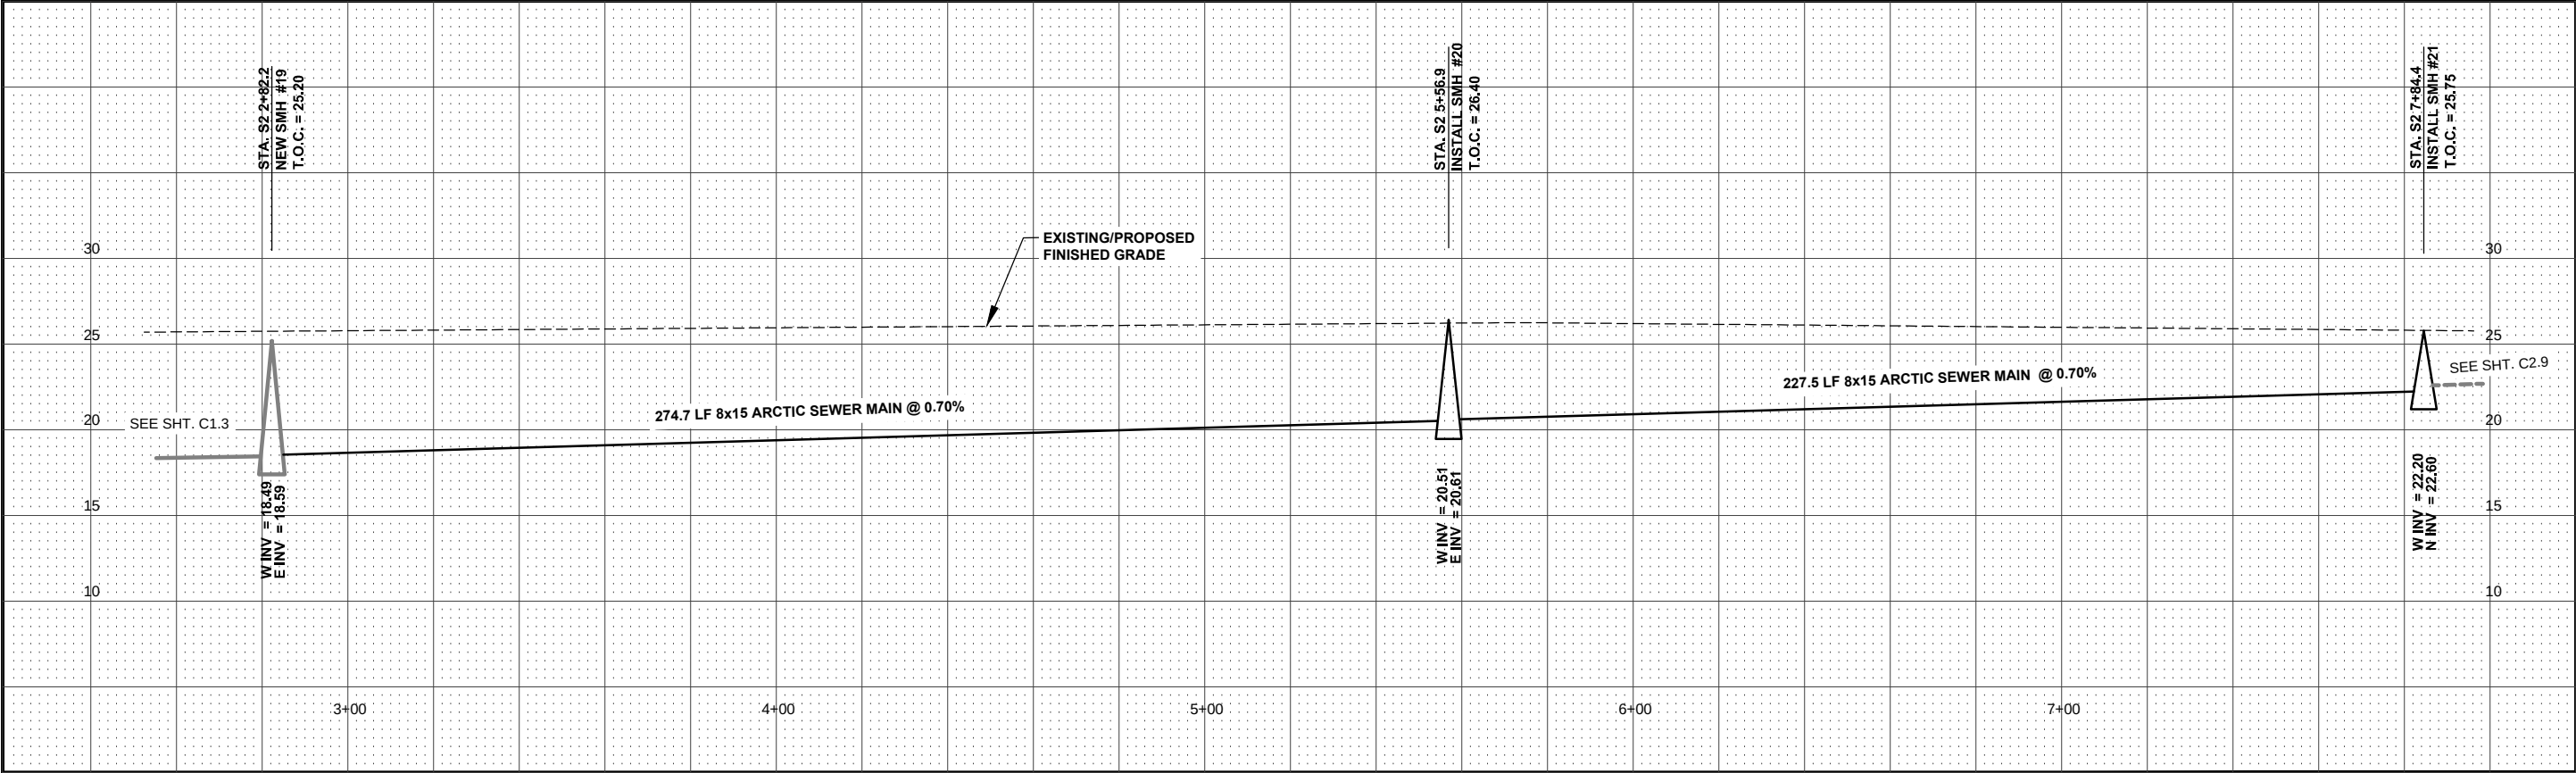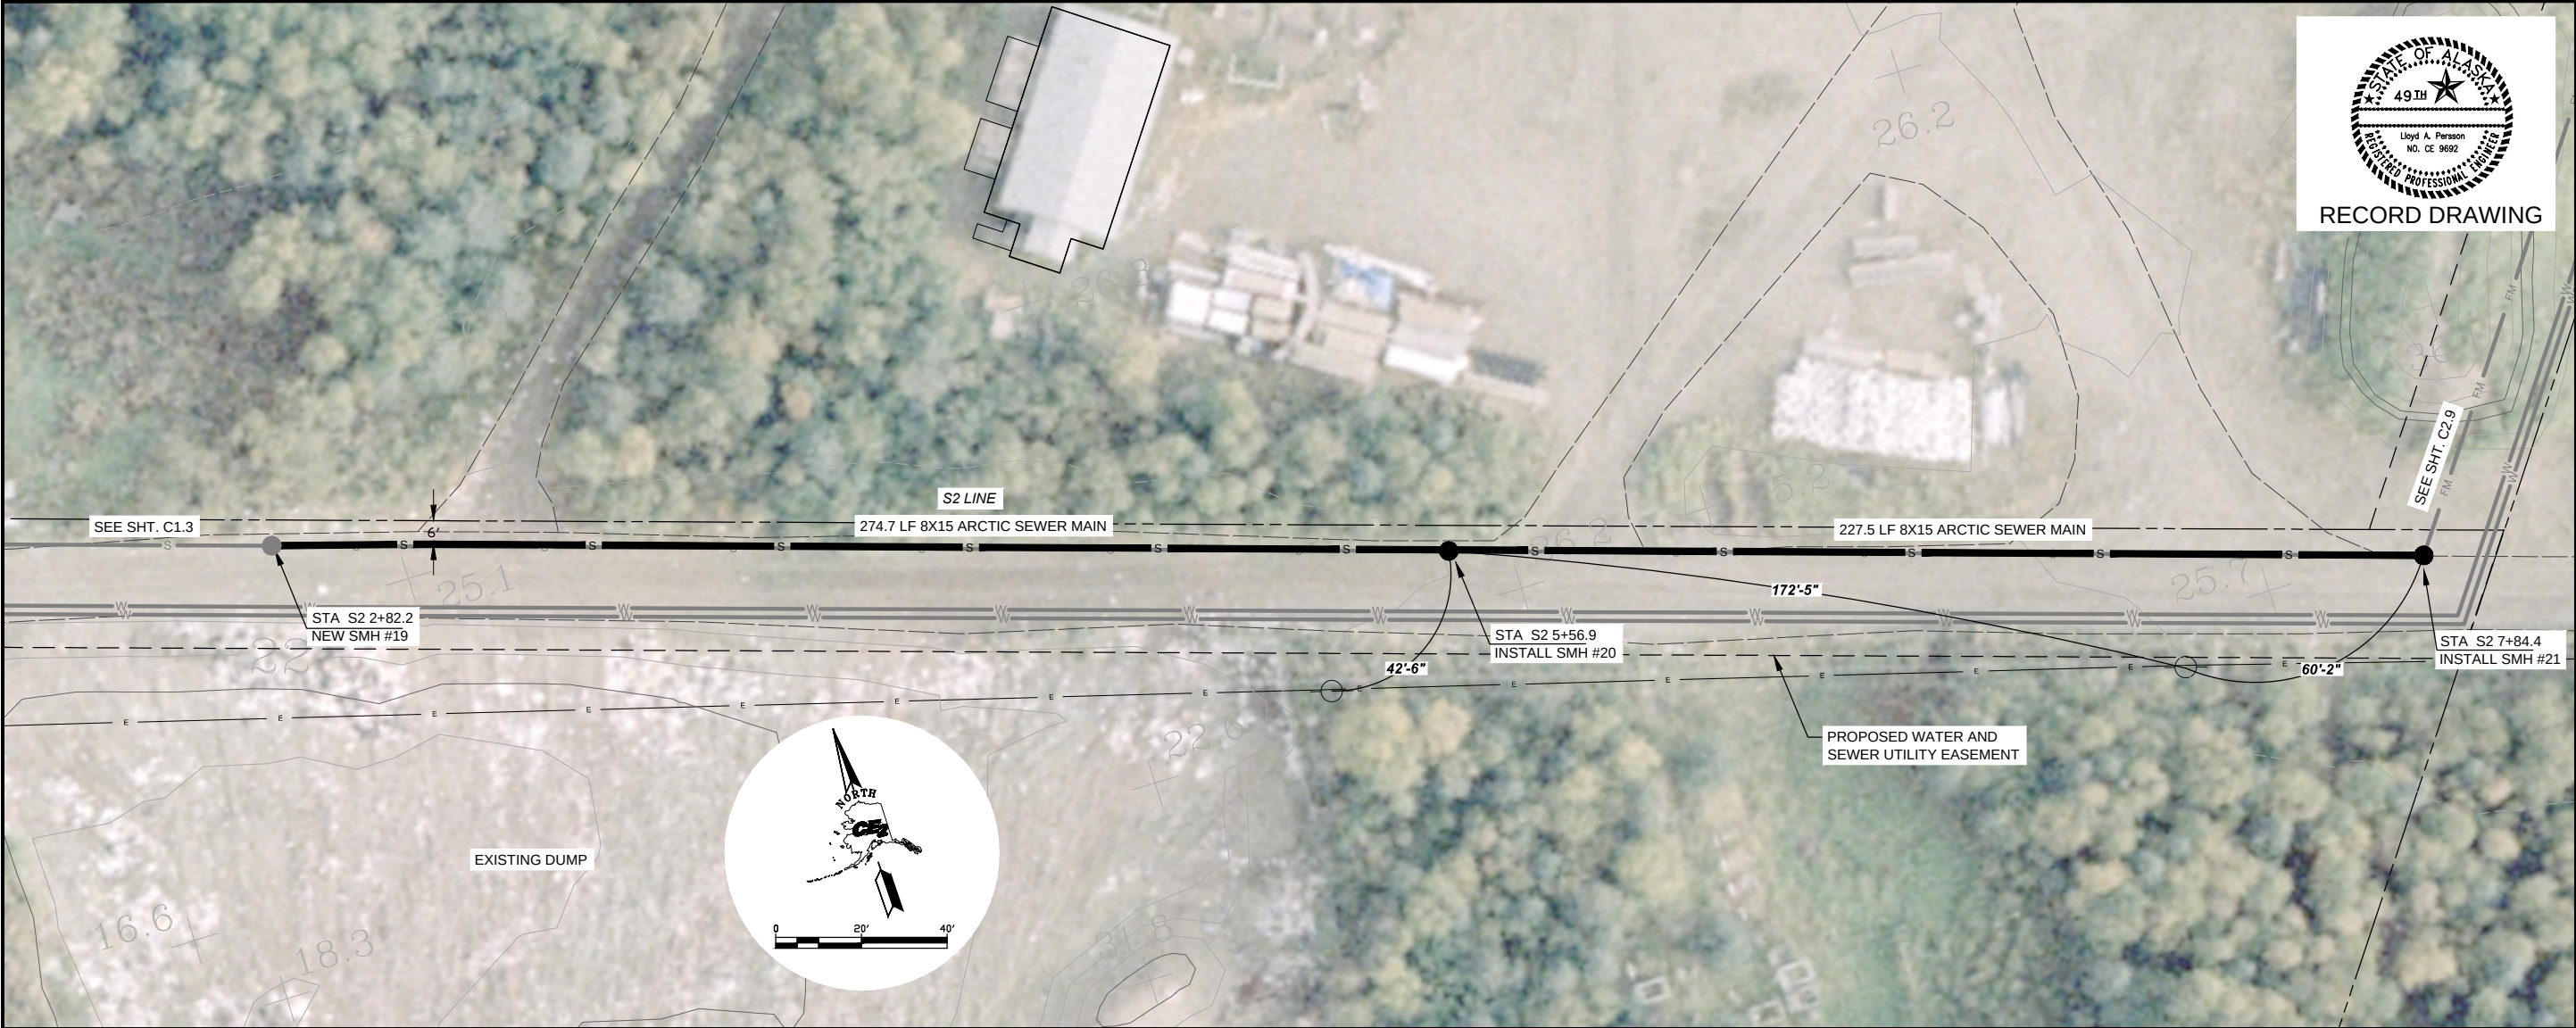

RECORD DRAWING CERTIFICATE
THESE DRAWINGS REFLECT RECORDED
INFORMATION OBTAINED DURING
CONSTRUCTION. INFORMATION PROVIDED
HEREIN IS ACCURATE TO THE BEST OF MY
KNOWLEDGE.

SCALE:
PLAN: 1"=40'
PROFILE: 1"=5'
BAR IS ONE INCH ON
ORIGINAL DRAWING
0 1' IF NOT ONE INCH ON





2010-11 WASTEWATER
SYSTEM IMPROVEMENTS
S2 GRAVITY SEWER
PLAN AND PROFILE



REVISION	BY	DATE


Project No.	Date	Designed	LAP
	JUNE 2009		
		Drawn	LAW

Sheet No.
C1.4

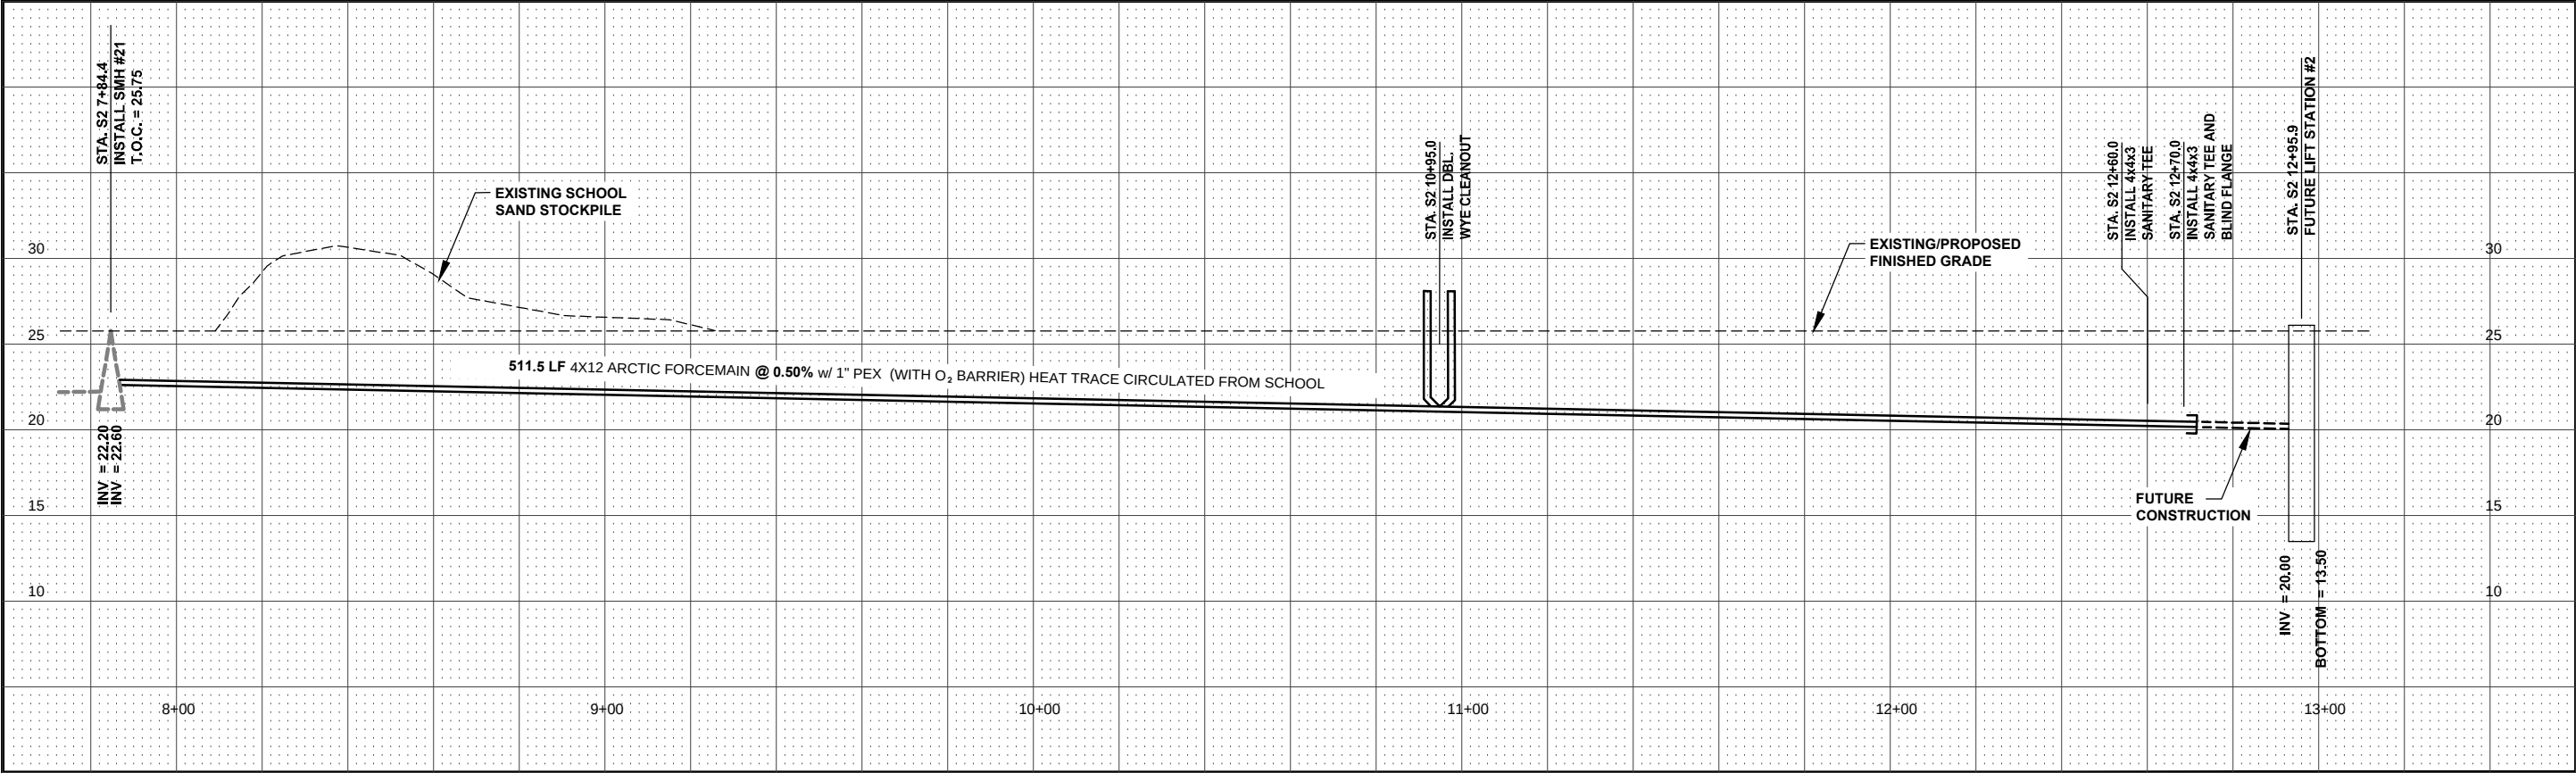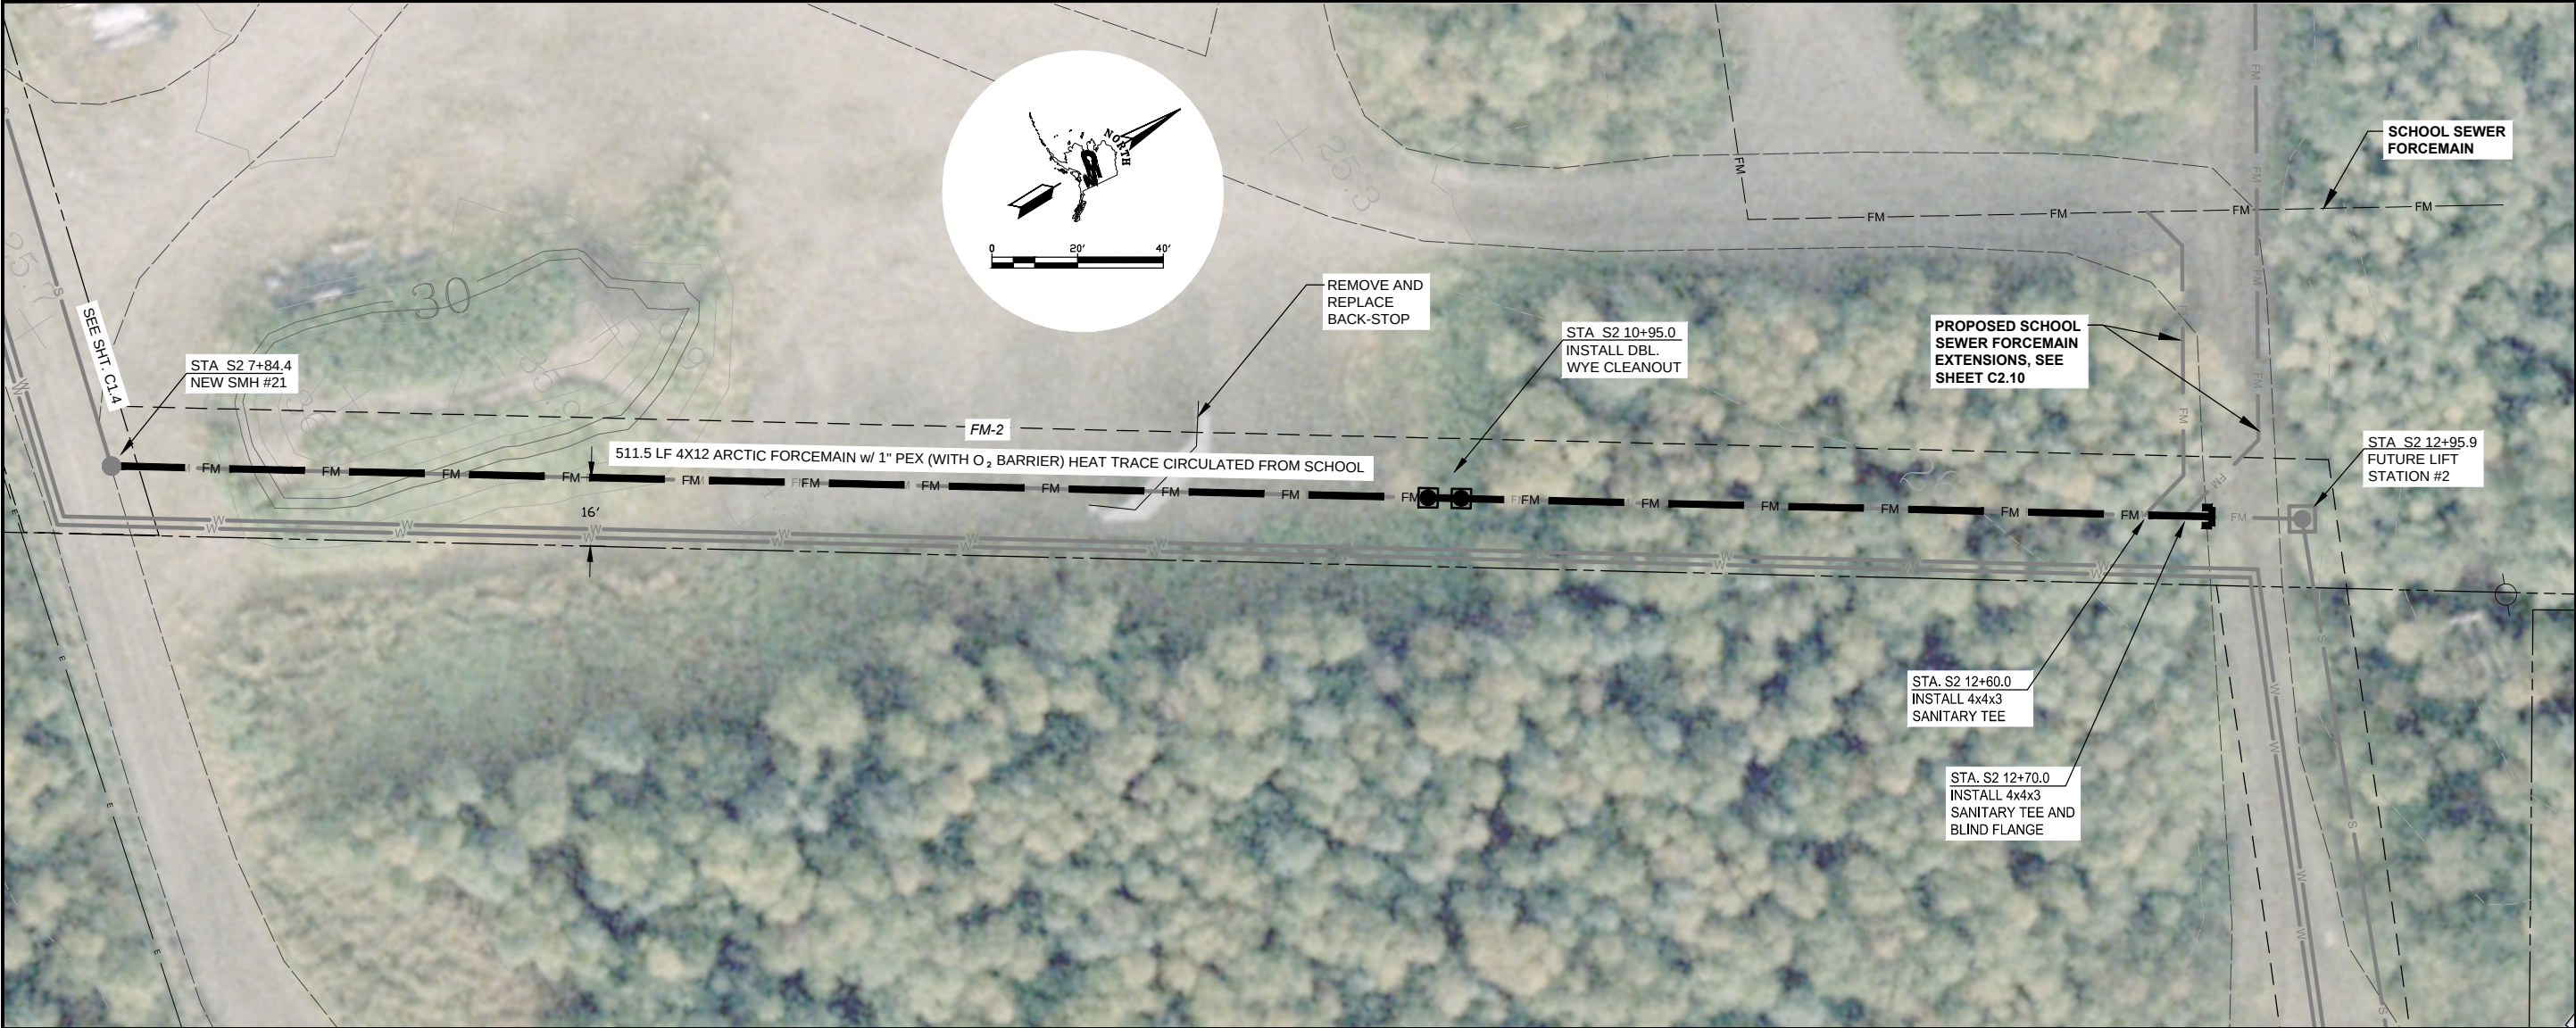

RECORD DRAWING CERTIFICATE
THESE DRAWINGS REFLECT RECORDED
INFORMATION OBTAINED DURING
CONSTRUCTION. INFORMATION PROVIDED
HEREIN IS ACCURATE TO THE BEST OF MY
KNOWLEDGE.

SCALE:
PLAN: 1"=20'
PROF: 1"=5'
BAR IS ONE INCH ON
ORIGINAL DRAWING
0 1' IF NOT ONE INCH ON

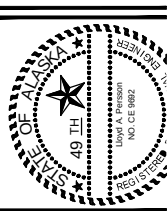

2010-11 WASTEWATER
SYSTEM IMPROVEMENTS
FM2 FORCEMAIN
PLAN AND PROFILE



REVISION	BY	DATE
LAGOON RELOCATION	CM	8/10

Project No. _____ Date JUNE 2009 Designed LAP
Drawn LAW Amman LAP
Sheet No. **C2.9**