

This is a detailed engineering plan of a city block, showing streets, lots, buildings, and utility lines. The plan is oriented with North at the top, indicated by a north arrow in the upper right corner.

Streets:

- MILL STREET:** Runs vertically along the left side of the plan.
- GREEN STREET:** Runs vertically along the right side of the plan.
- PARK AVENUE:** Runs horizontally along the top of the plan.
- SECOND AVENUE:** Runs horizontally across the middle of the plan.
- FIRST AVENUE:** Runs horizontally along the bottom of the plan.
- HILL STREET:** Runs vertically along the right edge of the bottom section.


Utility Lines and Features:

- Water Lines:** Indicated by solid lines with 'W' markers. Includes a 'NEW WATER LINE' and an 'EXISTING WATER LINE'.
- Sewer Lines:** Indicated by dashed lines with 'S' markers. Includes a 'NEW SEWER LINE' and an 'EXISTING SEWER LINE'.
- Gas Lines:** Indicated by dotted lines with 'G' markers.
- Force Main:** An 'EXISTING FORCE MAIN' is shown running horizontally across the middle of the block.
- Manholes (MH):** Labeled with numbers (e.g., MH 1, MH 2, MH 3, MH 4) and elevations.
- Buildings:** Various structures are shown, including a 'FIRE STATION', 'CITY BUILDING', 'LODGE', 'AC STORE', and 'BUN. BUILDING'.
- Other Features:** A 'POWER PLANT' is located near Hill Street. A 'NEW 8" GRAVITY DRAIN' is also indicated.

Lot Numbers: The plan shows numerous lots, numbered 1 through 15 in various sections. Some lots are further subdivided.


Key:

- W — NEW WATER LINE
- S — NEW SEWER LINE
- G — NEW GAS LINE
- W — EXISTING WATER LINE
- S — EXISTING SEWER LINE

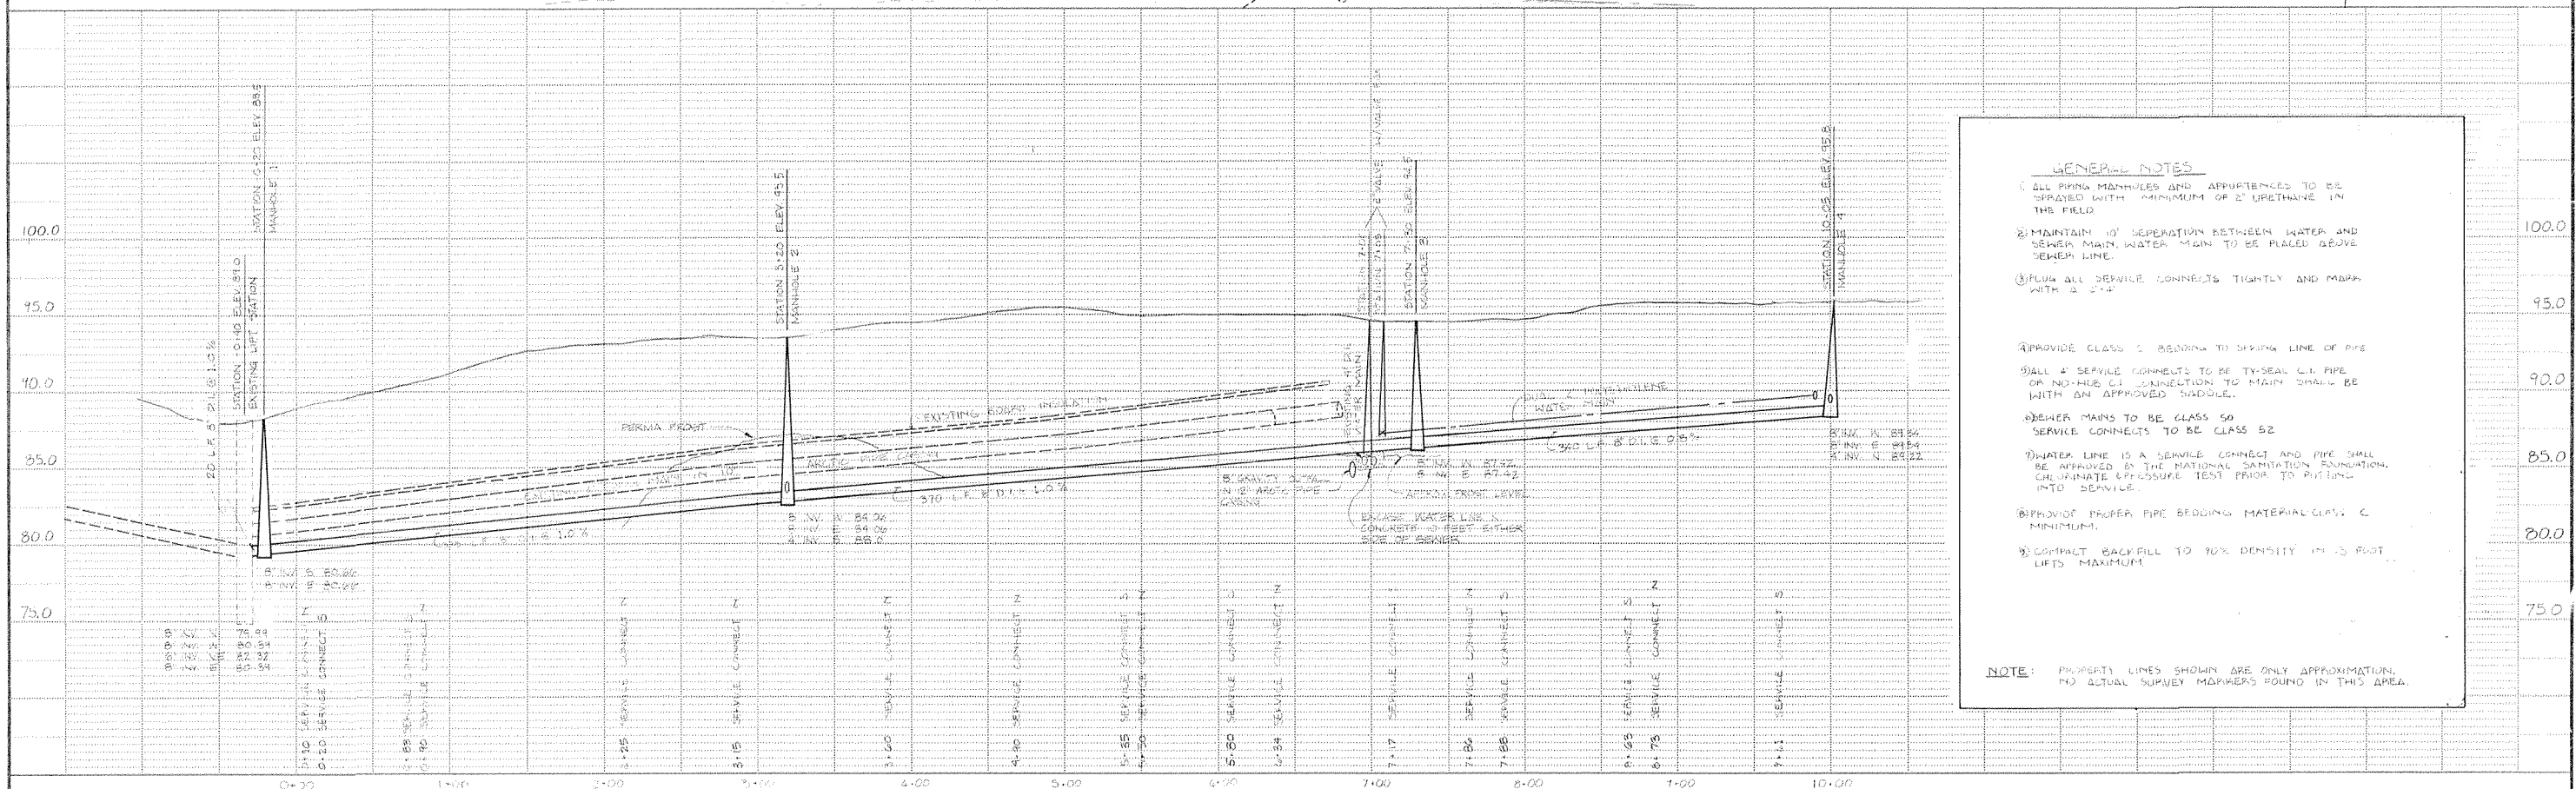

Arctic Environmental Engineers
Anchorage, Alaska


PROJECT NO. 72-13 TWS
DESIGNED : W.V.H
DRAWN : BDL
CHECKED : S.E.C.
DATE : AUG 3, 1974
SCALE : 1"=50'-0" = HOR
1"=5'-0" = VERT

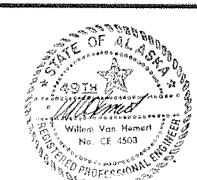[illegible]


CITY OF TANANA
WATER & SEWER EXTENSION
CITY BUILDING-FIRE STATION

S-1

SHEET 1 OF 3

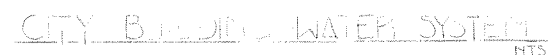

FIRE STATION PLUMBING IMPROVEMENT

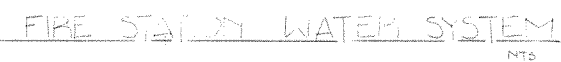


	THERMOMETER
	PRESSURE GAUGE
	FLOW SWITCH
	PRESSURE REDUCING VALVE
	GLOBE VALVE
	SOLENOID VALVE

3	DELETION OF HEAT TRACE DETAIL	11-14-79	SZ
2	AS BUILT ON CITY BUILDING WATER SYSTEM	11-14-79	SZ
1	AS BUILT ON FIRE STATION PLUMBING	11-14-79	SZ
NO.	REVISION	DATE	BY




PROJECT NO. 79-010-TWS
DESIGNED : W. V. H.
DRAWN : B. D. L.
CHECKED : S. E. C.
DATE : AUG 4, 1979
SCALE : AS SHOWN

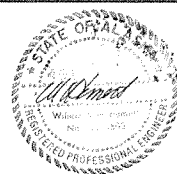

CITY OF TANANA
WATER & SEWER EXTENSION
CITY BUILDING - FIRE STATION

S-2

SHEET 2 OF 3

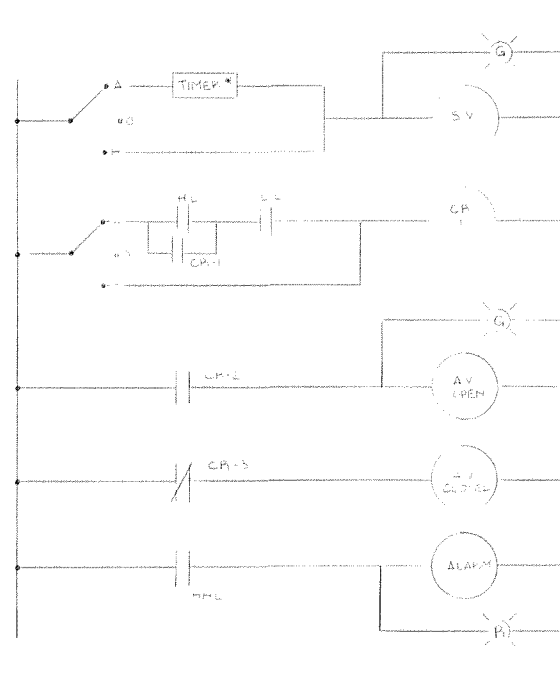


* 2 HP TIME INCREMENTS

OPERATION

- (A) SOLENOID VALVE - SOLENOID VALVE IS ACTUATED BY A 24HR TIMER AND FEEDS HOT WATER INTO THE SEWAGE TANK. FLOW RATE IS CONTROLLED BY A GLOBE VALVE.
- (B) AUTOMATIC VALVE - WHEN THE TANK FILLS TO THE HIGH LEVEL FLOAT, CR1 IS ACTIVATED CAUSING THE VALVE TO OPEN. WHEN THE LOW LEVEL IS REACHED, CR1 IS DE-ENERGISED AND THE VALVE IS CLOSED THROUGH A NORMALLY CLOSED CONTACT.
- (C) IF THE HIGH LEVEL FLOAT IS REACHED AN ALARM IS ACTIVATED.


SEWAGE SYSTEM CONTROLS

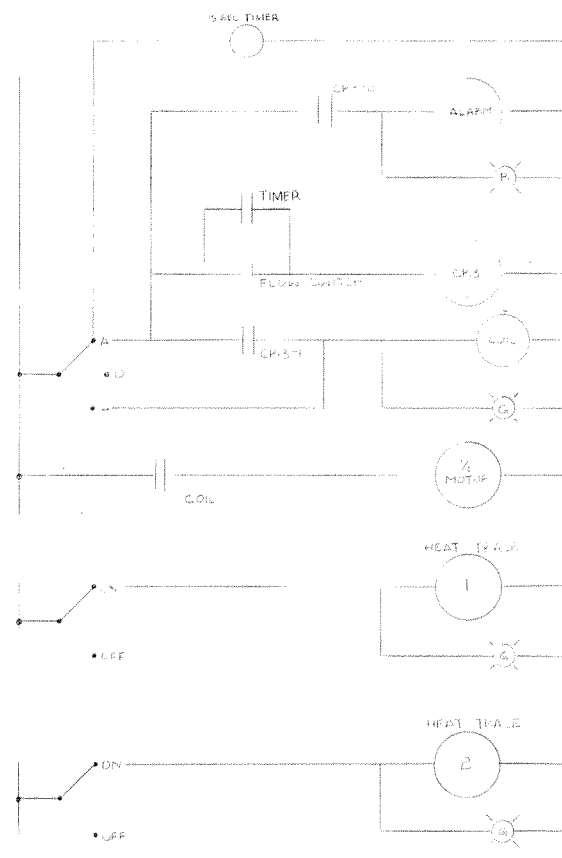

OPERATION:

- (A) RECIRCULATION PUMP - IN AUTOMATIC PUMP IS PROTECTED WITH A FLOW SWITCH. WHEN PUMP IS TURNED ON, A 15 SECOND TIMER ALLOWS FLOW TO BEGIN. ON HAND THE FLOW SWITCH IS BY-PASSED, PUMP RUNS CONTINUOUSLY.
- (B) HEAT TRACE - OPERATED BY ON-OFF SWITCH AND PLUG IN.


WATER SYSTEM CONTROLS

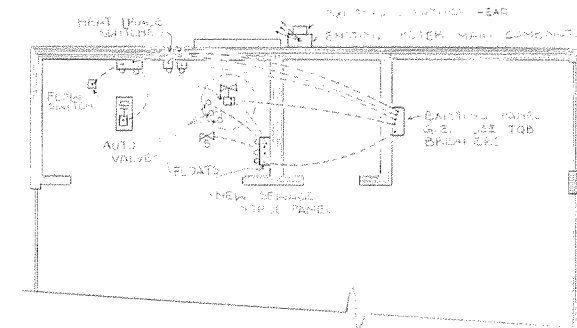

ELECTRICAL DIAGRAM

	NO. BREAKERS	SIZE	VOLTS	WIPE SIZE
24HR. MI.	1	20/2	120/120	12
FLOW SWITCH	1	3/4	120	12
AUTOMATIC VALVE	1	15/4	120	12

NO.	REVISION	DATE	BY
-----	----------	------	----

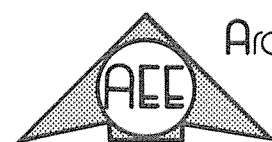

Arctic Environmental Engineers
Anchorage, Alaska

PROJECT NO. 7-80-THS
DESIGNED: W.V.H.
DRAWN: M.D.L.
CHECKED: S.B.L.
DATE: AUG 4 1979
SCALE: AS SHOWN



CITY OF TANANA
WATER & SEWER EXTENSION
CITY BUILDING - FIRE STATION

S-3

SHEET 3 OF 3