




2



AGS CONSULTING & DESIGN			
CITY OF TANANA LAGOON EXPANSION			
DRAWN			
D. S. J. S. SERVICES			
SCALE 1" = 100'		DATE 15 MAY 1987	
SHEET OF		432-2048	

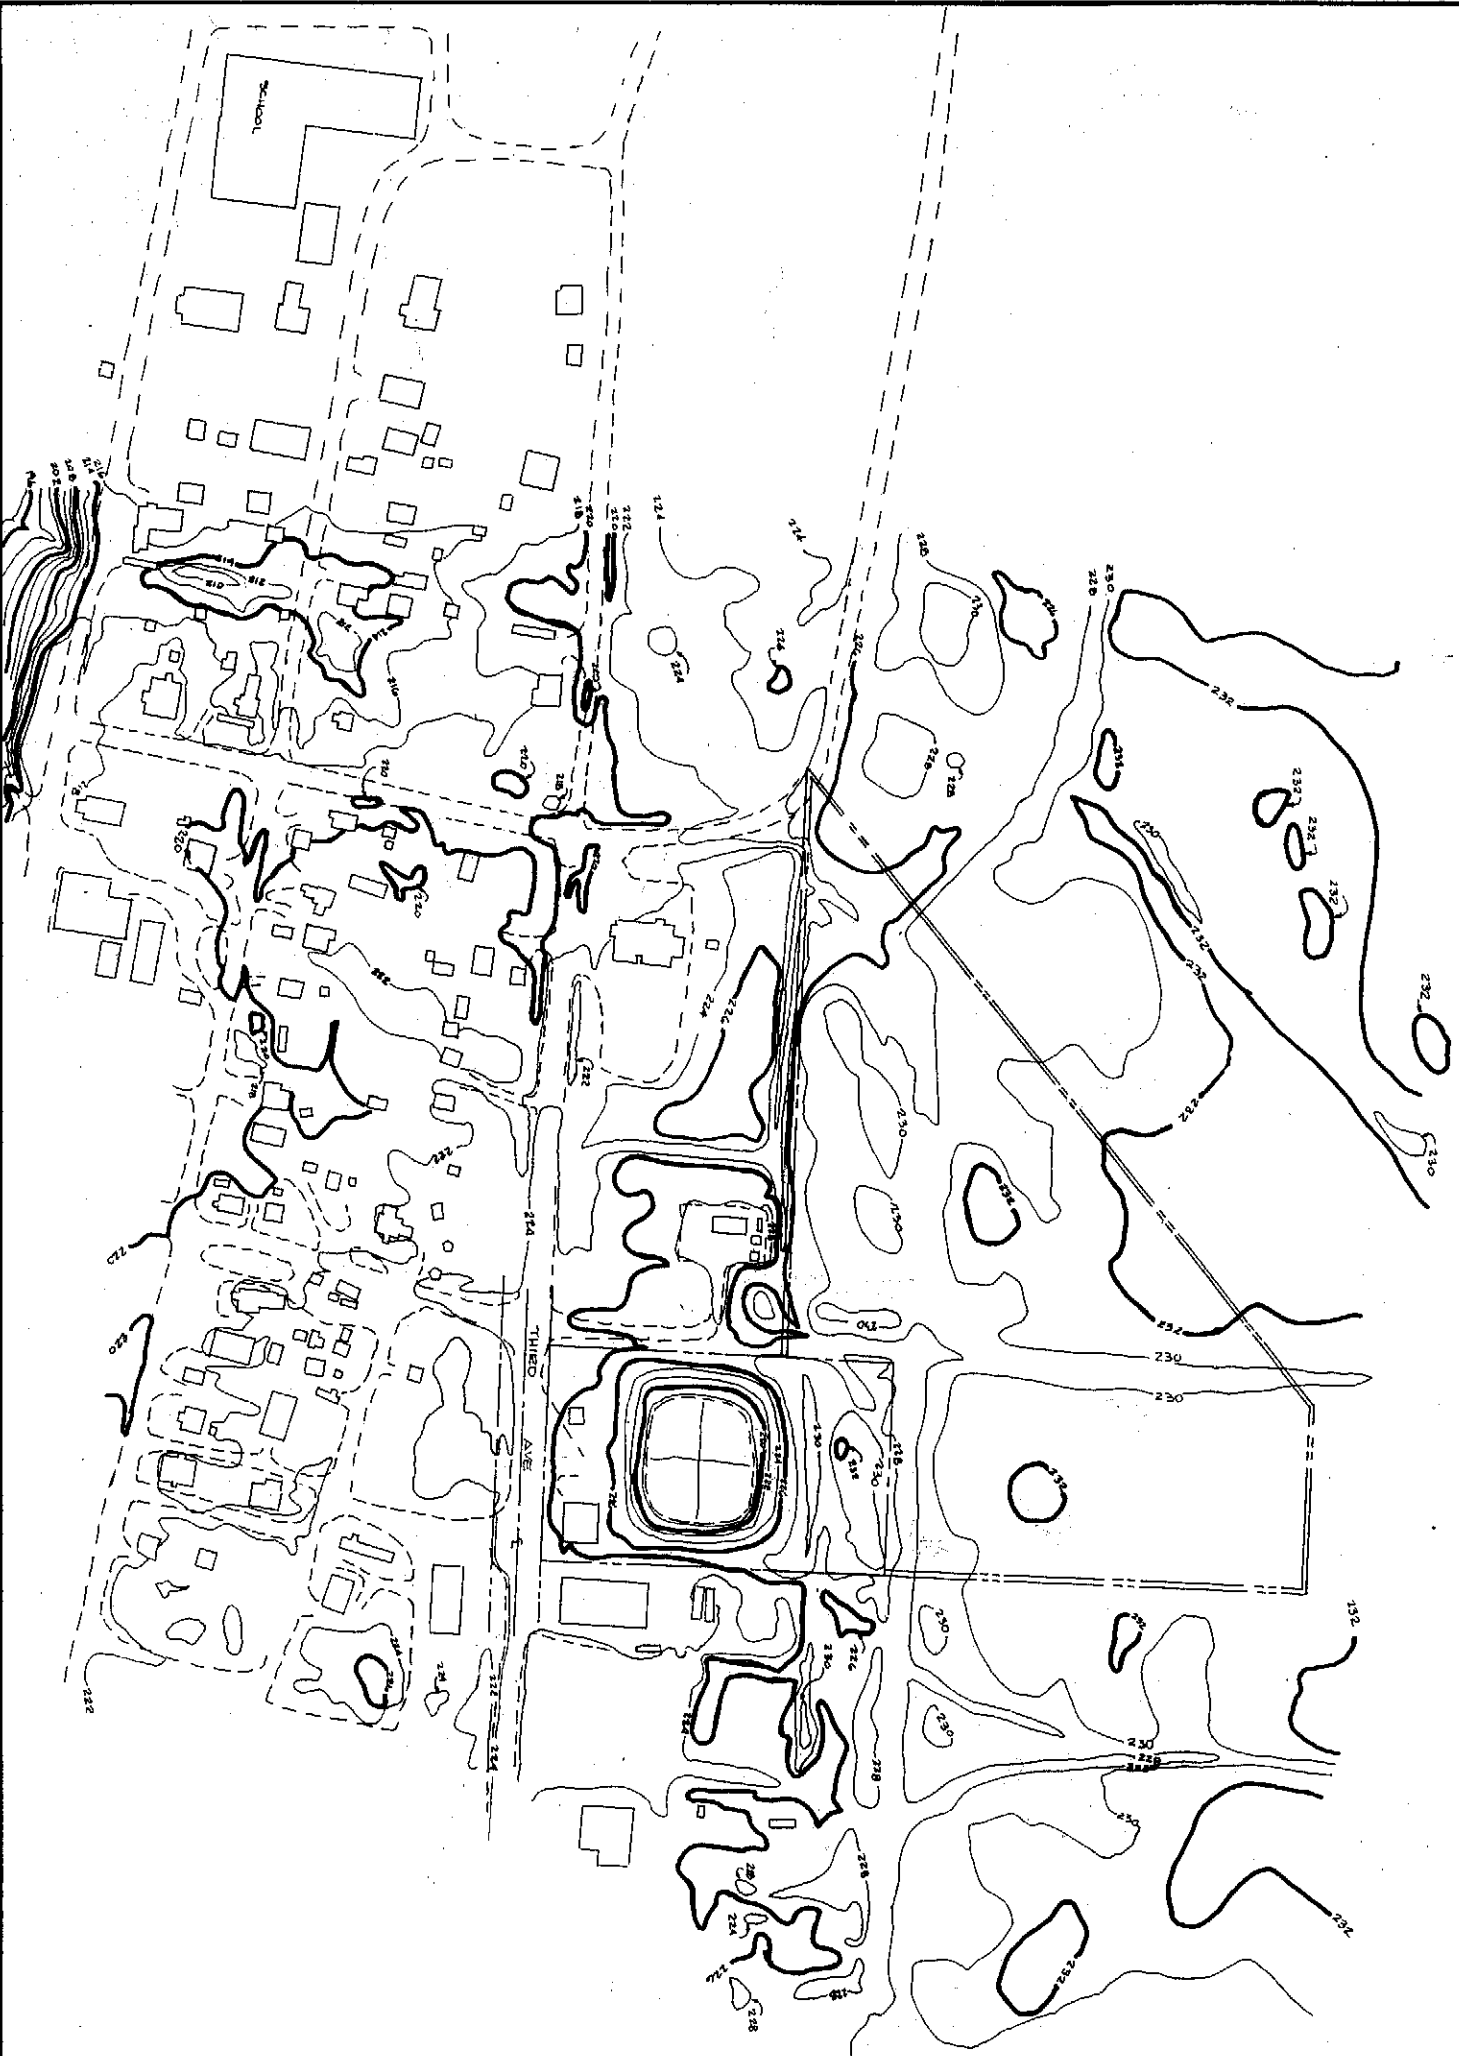


A LAGOON SECTION
SCALE 1"=30'

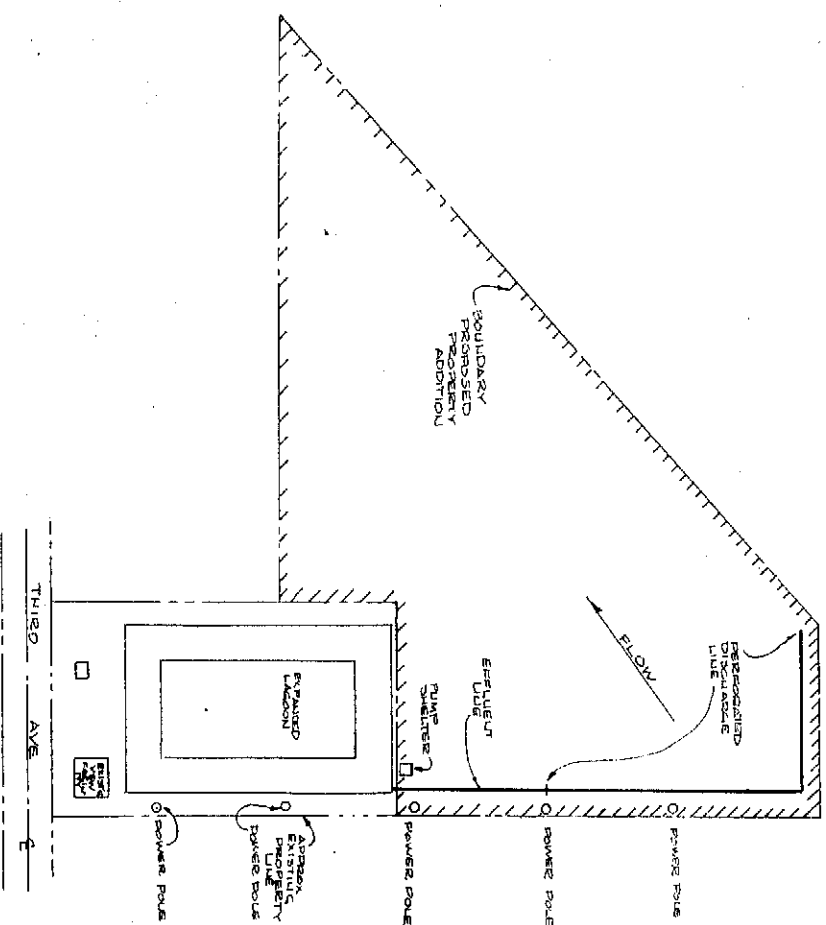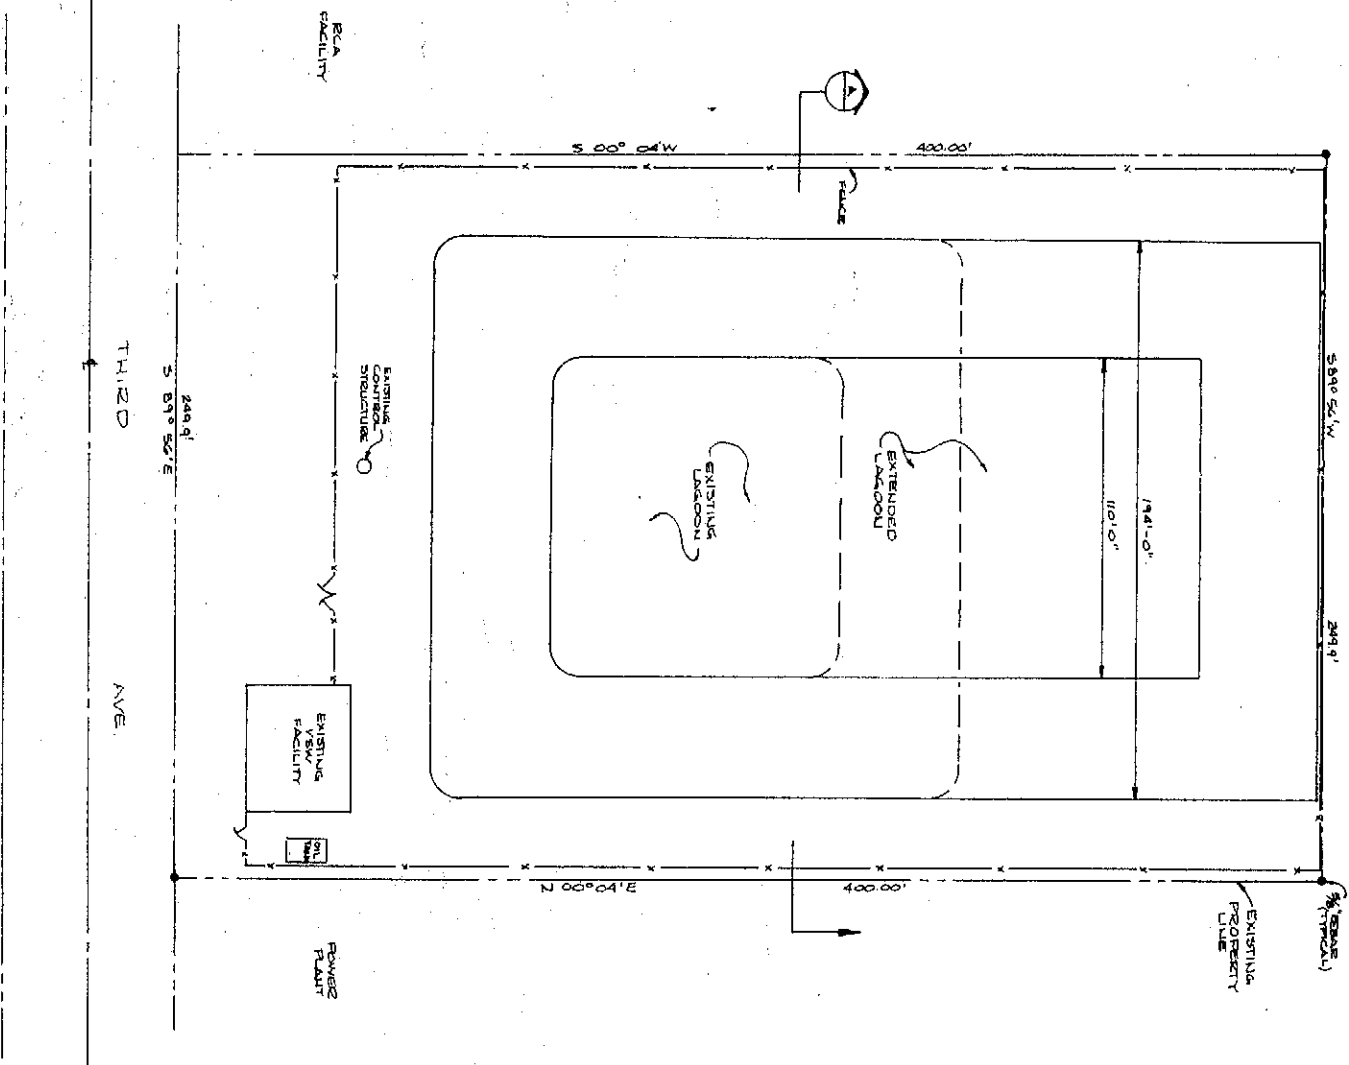

SITE PLAN
1"=100'

AGS CONSULTING & DESIGN
CITY OF TANANA
LAGOON EXPANSION



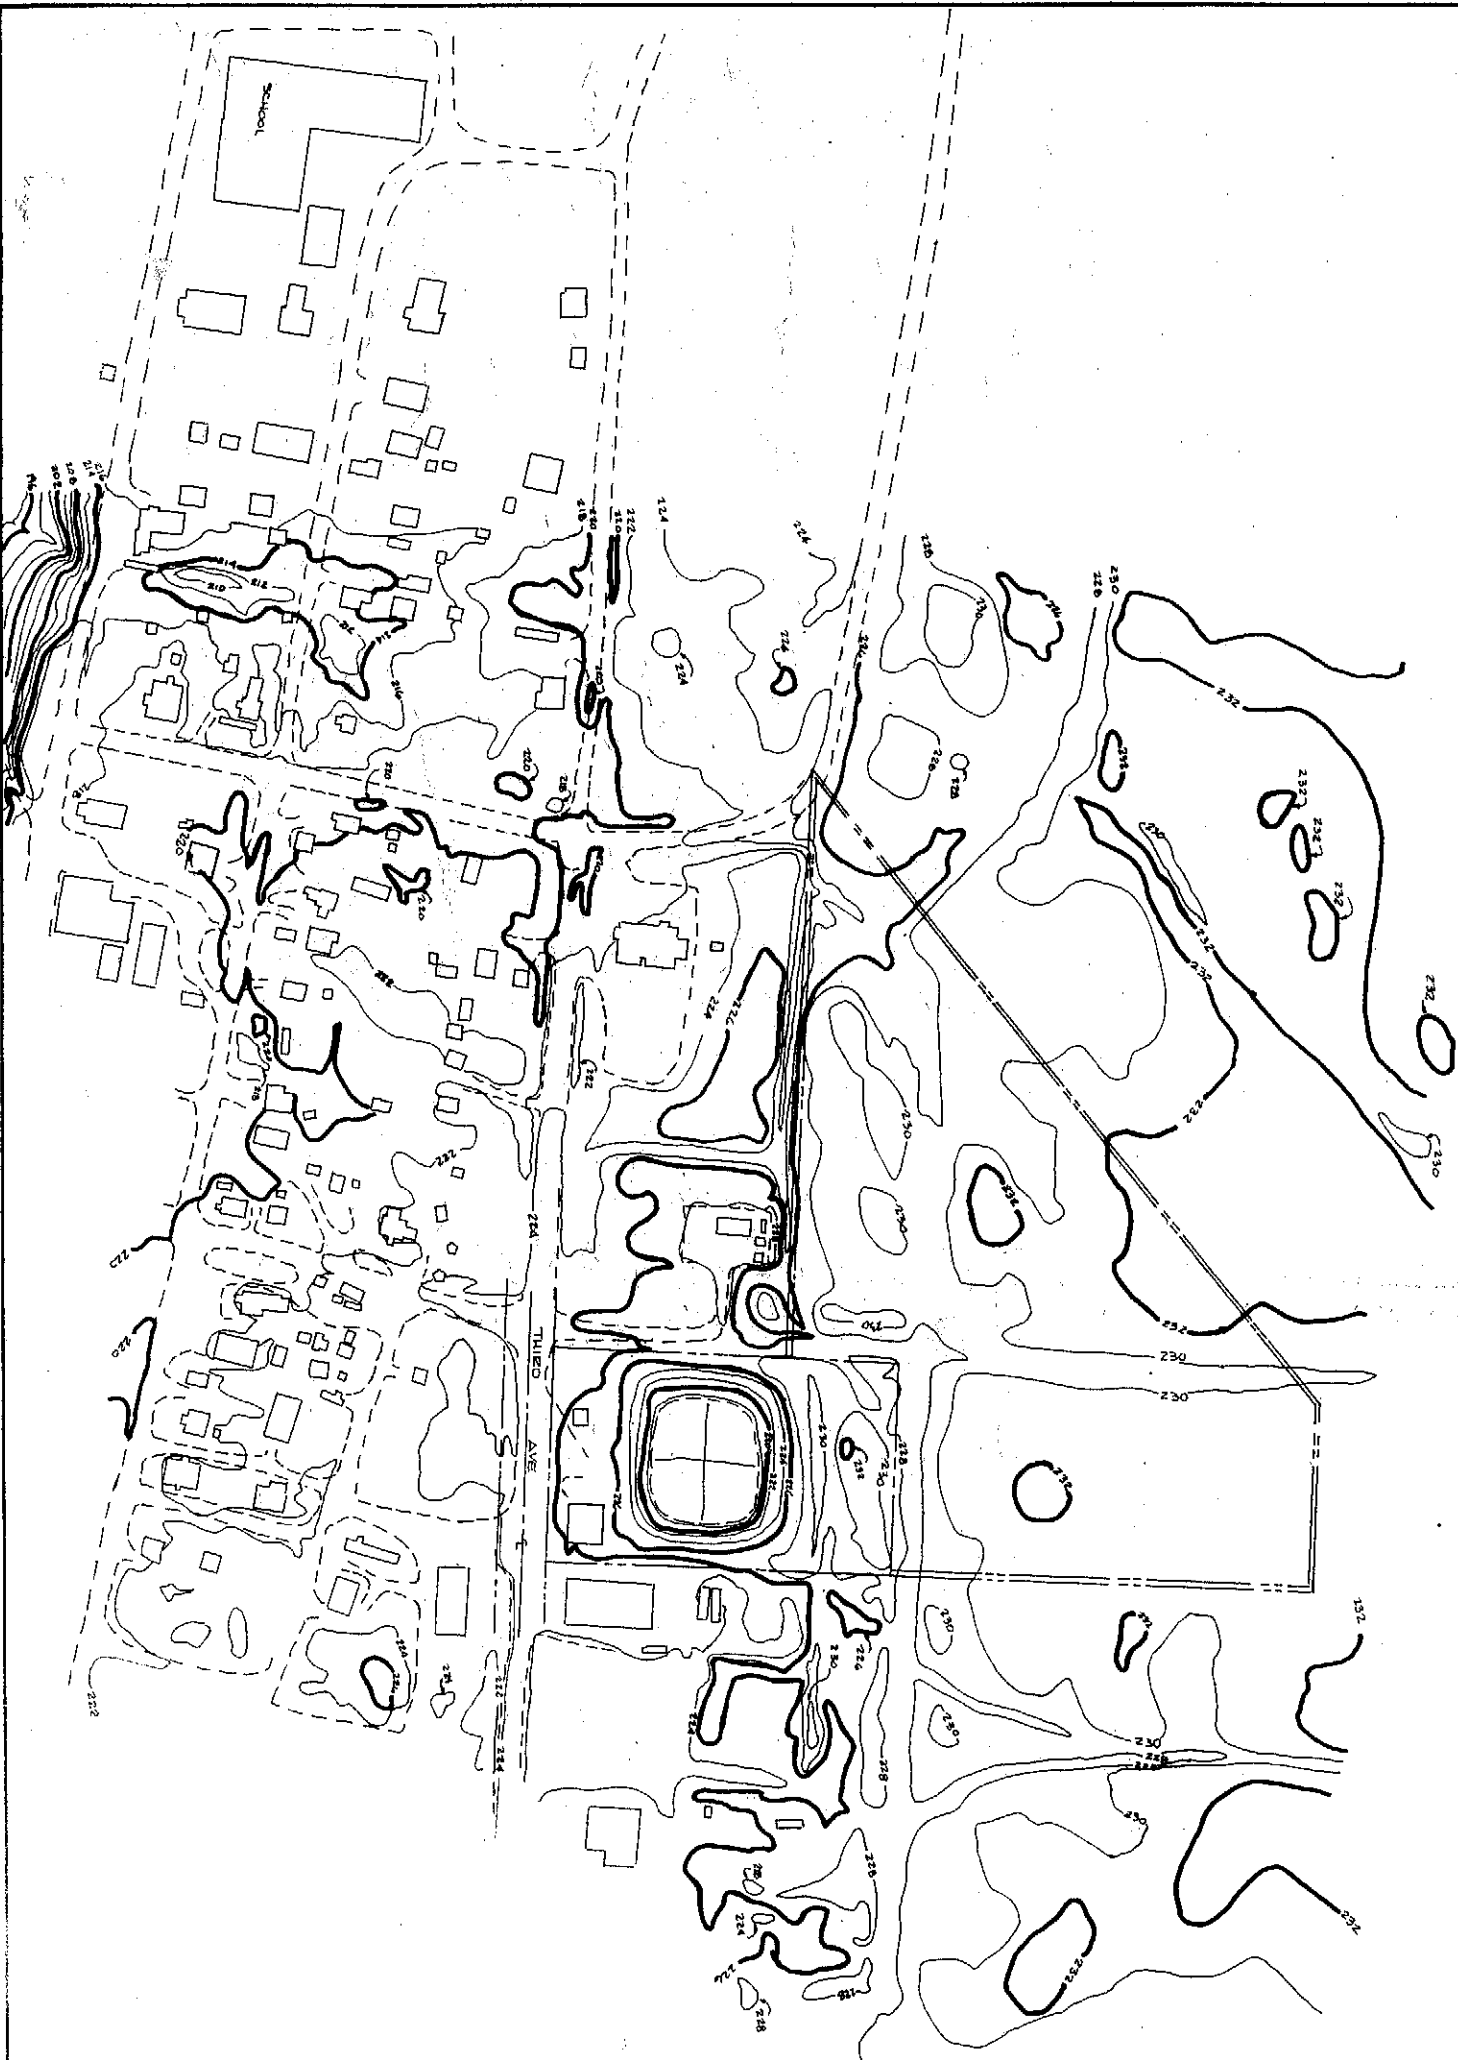


AGS CONSULTING & DESIGN

CITY OF TANANA
LAGOON EXPANSION

DRAWN			
D. S. J. S. SERVICES			
SCALE	DATE	452-2049	
1" = 100'	15 MAY 1987	SHEET	
		OF	

25 MAY 1987 1400H 324W32

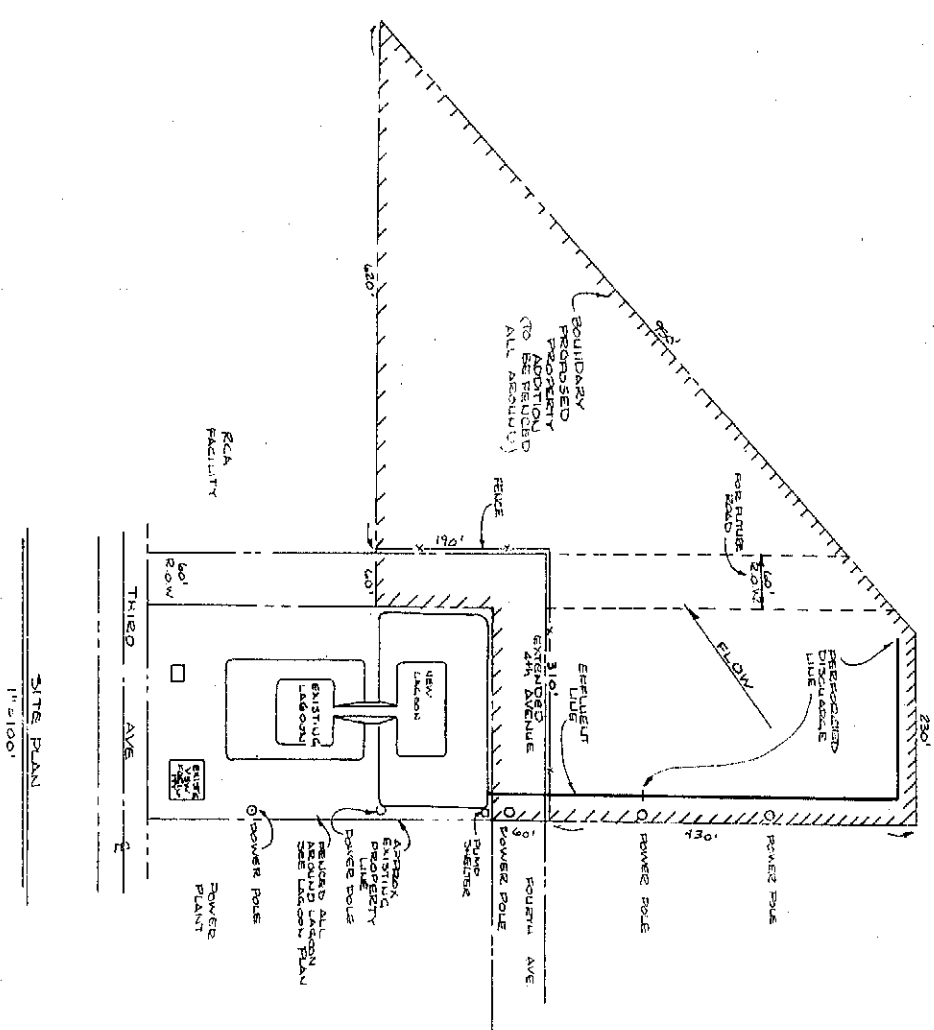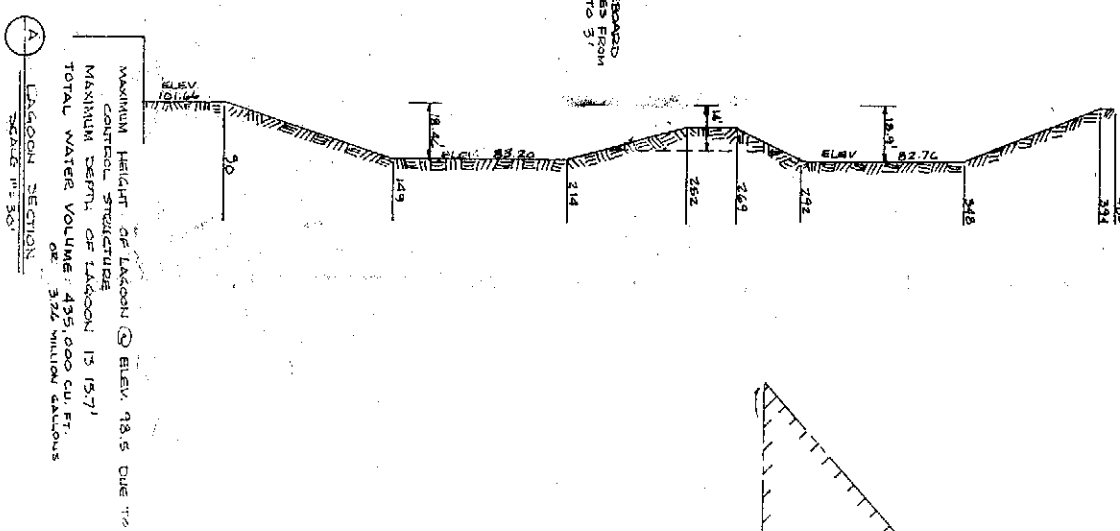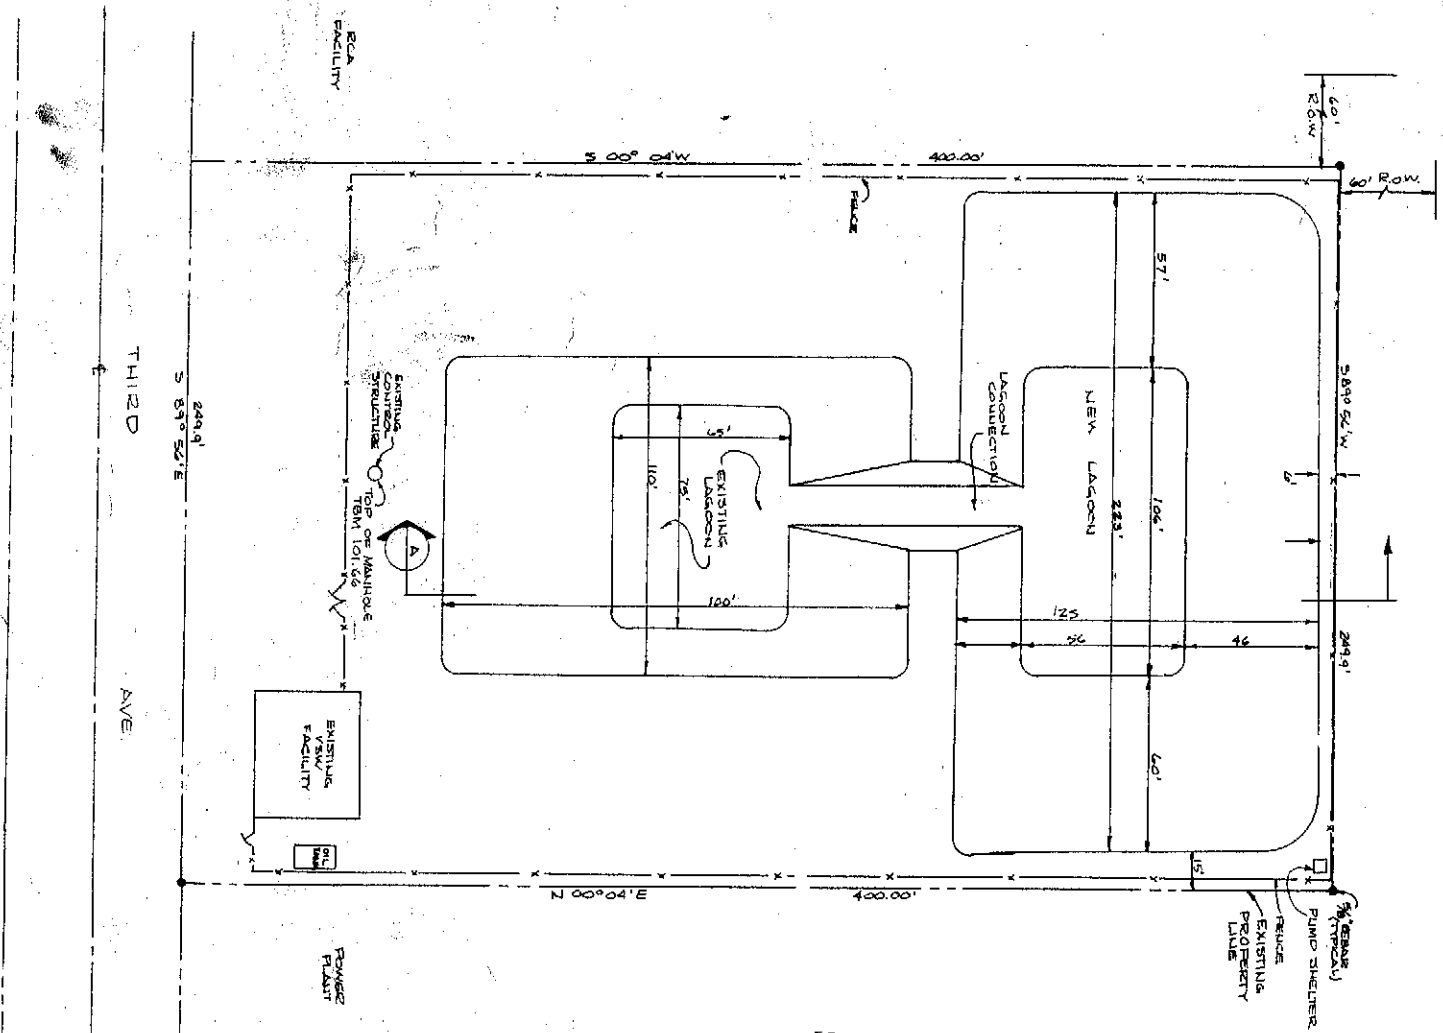

AT THE TIME OF THIS AS BUILT THE BUILDING + CHIMNEY WERE NOT EVEN
HAS NOT BEEN COMPLETED - 7/87

**CITY OF TAMPA
LAGOON EXPANSION**