

2 1978

ALASKA VILLAGE SAFE WATER PROJECT

TANANA , ALASKA

**AS - BUILT
7/15/79**

5

LIST OF DRAWINGS

UNDERGROUND PIPING

U-1	3	WATER LINE	PLAN & PROFILE
U-2	4	WATER SYSTEM	DETAILS
U-3	5	LAGOON EFFLUENT	PLAN & PROFILE
U-4	6	LAGOON EFFLUENT	PLAN & PROFILE
U-5	7	MANHOLE	DETAILS
U-6	8	YARD PIPING	

WASTEWATER TREATMENT PROCESS

WT-1	9	LAGOON	DETAILS
WT-2	10	LAGOON	DETAILS

STRUCTURAL

S-1	11	FOUNDATION	PLAN & DETAILS
S-2	12	BASEMENT WALL PANEL	ASSEMBLY DETAILS
S-3	13	BASEMENT FLOOR SLAB	PLAN & DETAILS
S-4	14	FLOOR FRAMING	PLAN & DETAILS
S-5	15	WALL FRAMING	PLAN & DETAILS
S-6	16	INTERIOR FLOOR	PLANS
S-7	17	ROOF & CEILING	FRAMING PLANS
S-8	18	ROOF SHEATHING	PLAN & DETAILS
S-9	19	SIDING	DETAILS
S-10	20	MISC. SIDING & ROOFING	DETAILS
S-11	21	BASEMENT WALL PANEL	CONST. & DETAILS
S-12	22	BASEMENT WALL PANEL	CONST. & DETAILS
S-13	23	STEEL TANK & MISC.	FABRICATION
S-14	24	MISC. STEEL	FABRICATION
S-15	25	ALUMINUM DUCT FLASHING	
S-16	26	TRUSS	DIAGRAM

PLUMBING

P-1	27	WATER SUPPLY & TREATMENT	
P-2	28	WATER DISTRIBUTION	SYSTEM
P-3	29	DRAINAGE	SYSTEM
P-4	30	LOWER LEVEL PIPING	- PLAN
P-5	31	LOWER LEVEL PIPING	- SECTIONAL
P-6	32	FLOOR PLANS	PLUMBING & PIPING (sk)
P-7	33	PLUMBING SCHEMATICS	(skoglund)

HEATING & VENTILATING

H-1	34	MECHANICAL HEATING	ISOMETRIC & PLAN VIEW
H-2	35	FLOOR PLAN	SHEETMETAL (sk)
H-3	36	BUILDING SECTIONS	(skoglund)
H-4	37	HEATING SYSTEMS	SCHEMATICS(sk)
H-5	38	MECH. EQUIPMENT	SCHEDULES (sk)
H-6	39	HEATING & VENTILATING	ISOMETRIC
H-7	40	MISCELLANEOUS	DETAILS

ELECTRICAL

E-1	41	ELECTRICAL LAYOUT	& DETAILS
E-2	42	ELECTRICAL ONE LINE	DIAGRAMS
E-3	43	ELEMENTARY INTERCONNECTION	DIAGRAMS- VENTILATION SYSTEM
E-4	44	MISC. ELECTRICAL	DIAGRAMS
E-5	45	FIRE ALARM PANEL	& MISC. DETAILS
E-6	46	HEATING & VENTILATION	
E-7	47	CONTROL	DIAGRAMS

NO.	REVISION	DATE	BY
-----	----------	------	----



Arctic Environmental Engineers
Anchorage, Alaska

PROJECT NO. 77-004-11
DESIGNED :
DRAWN :
CHECKED :
DATE :
SCALE :


TANANA VILLAGE SAFE WATER FACILITY

INDEX


I-1

CANADA

NOTE: Property Lines Shown On This Drawing & Others Are Approximation Only Based On Control Monuments Found On Third Avenue & Park Street. A Control Survey Thru Town Was Not Made

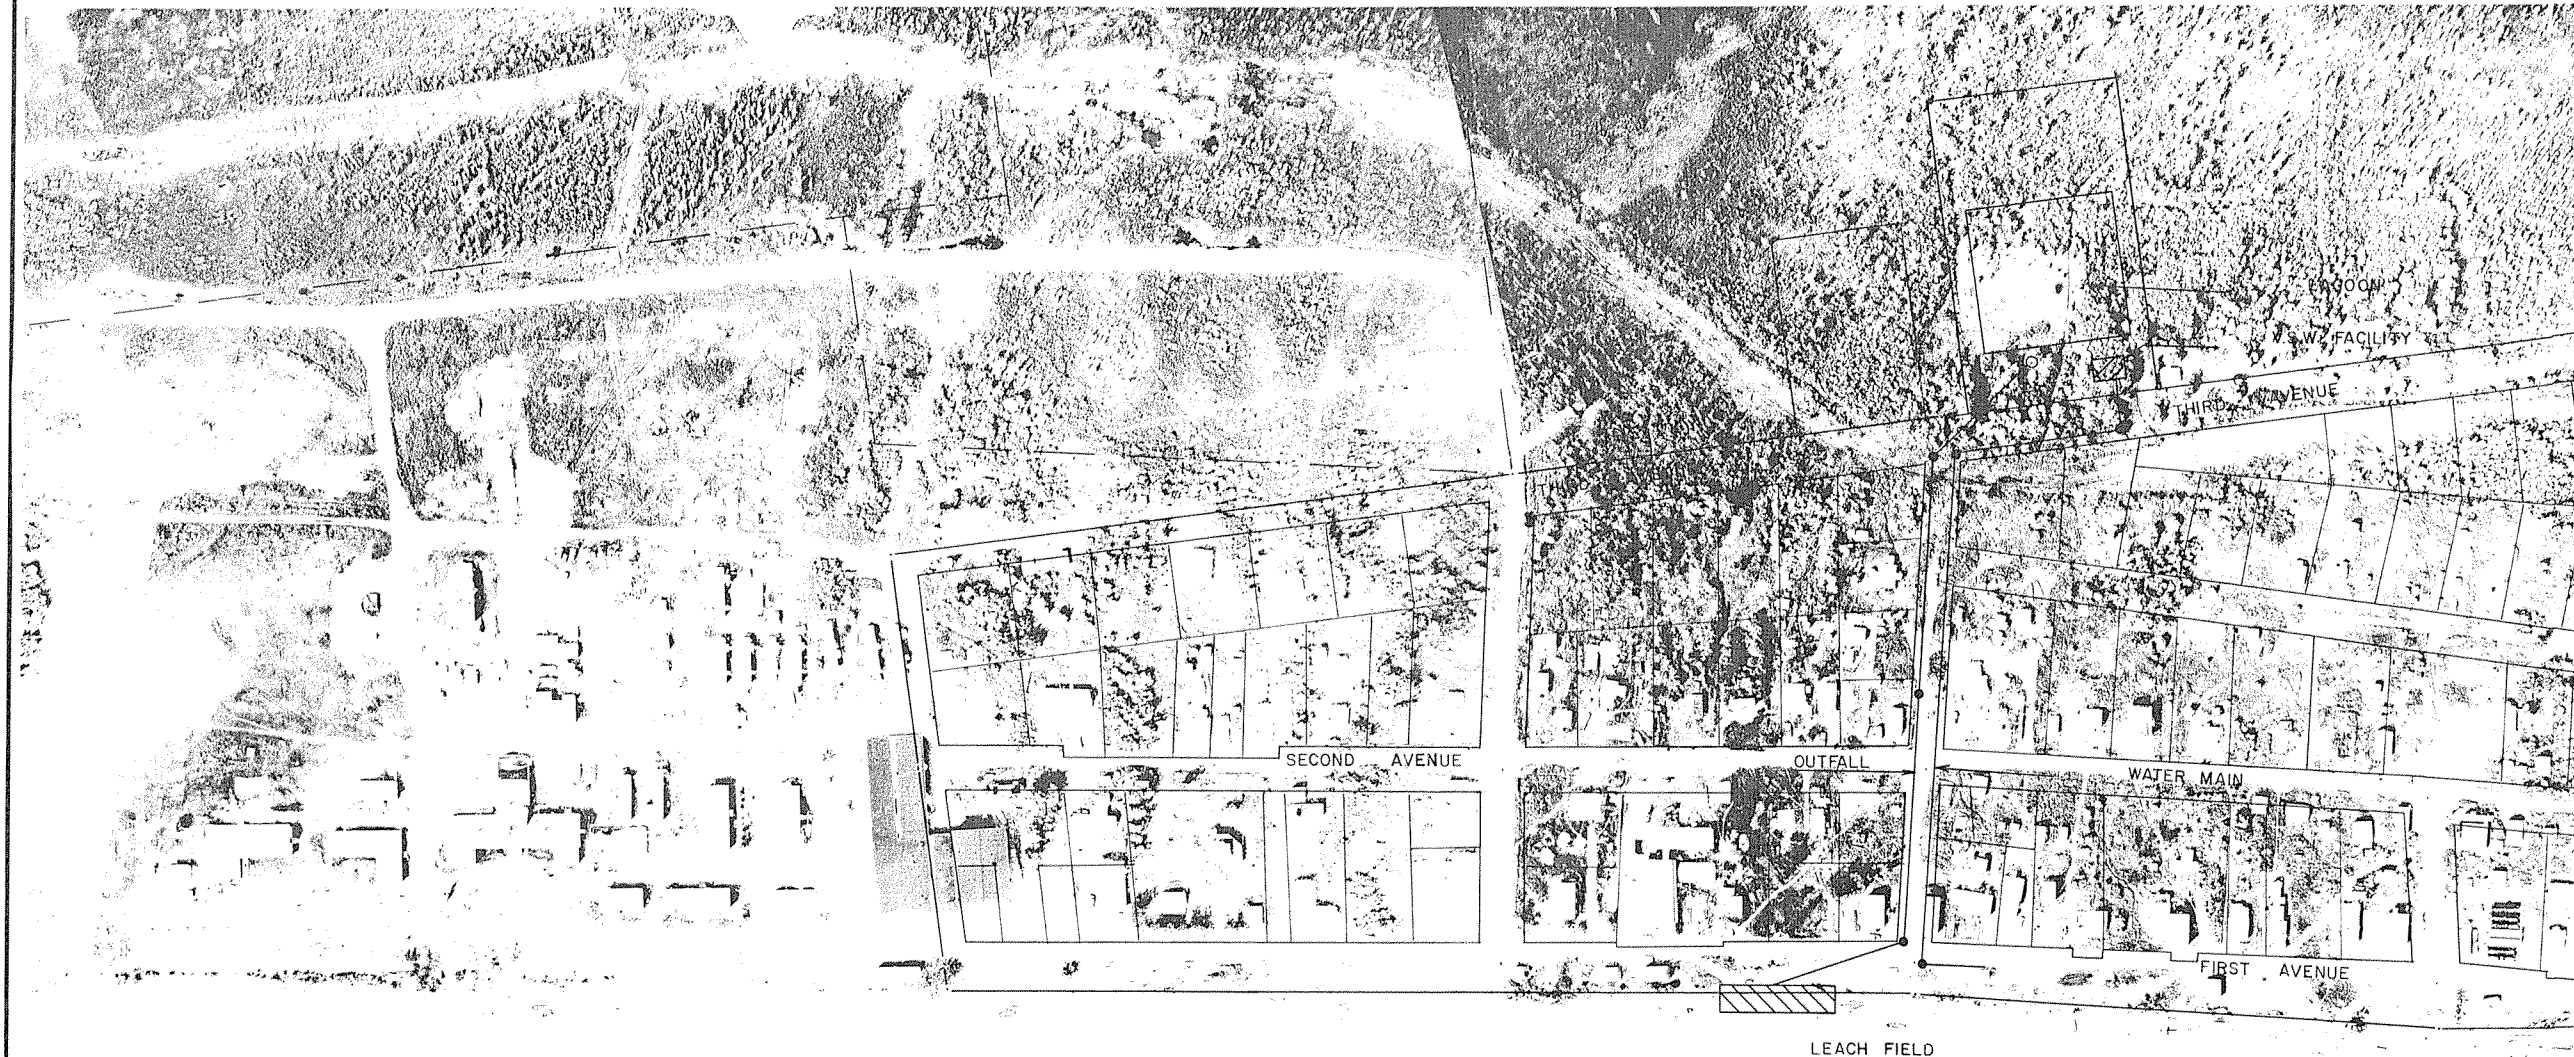

NO.	REVISION	DATE	BY
-----	----------	------	----

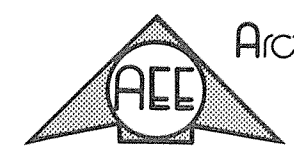

Arctic Environmental Engineers
Anchorage, Alaska



PROJECT NO. 77-364
DESIGNED :
DRAWN :
CHECKED :
DATE :
SCALE :

TANANNA VILLAGE SAFE WATER FACILITY
VICINITY MAP

V-1
SHEET OF 4



Day care Bldg. water line is between 3/4" & 1 1/4" soft copper tubing. it follows the line of least resistance from manhole #3 to the buildings mechanical room in times of a water shortage the valve that supplies water to the bldg. should be shut off but the 2 valves that allow the water to recirculate should be left open. Water lines have froze twice due to poor monitoring of this system during water shortage. per 1-6-86

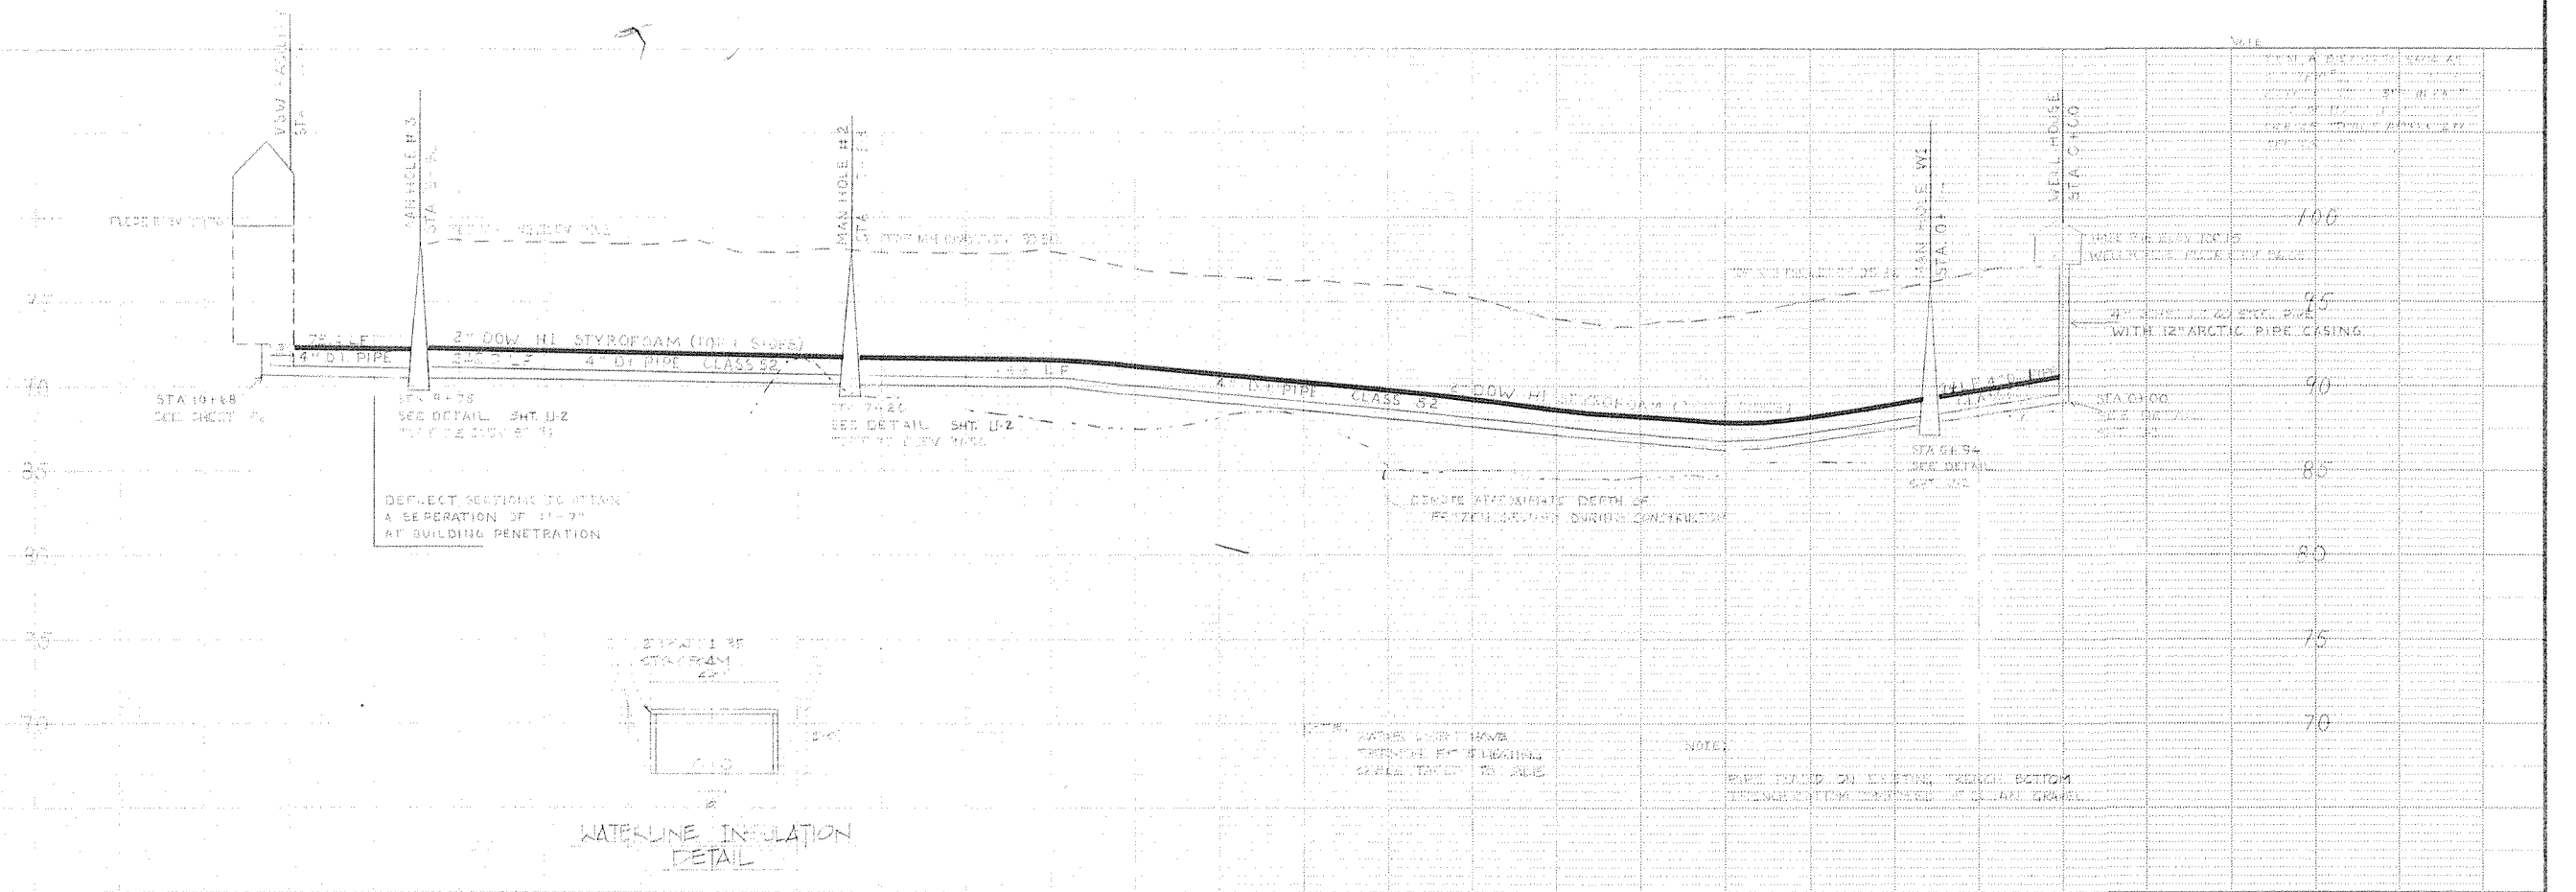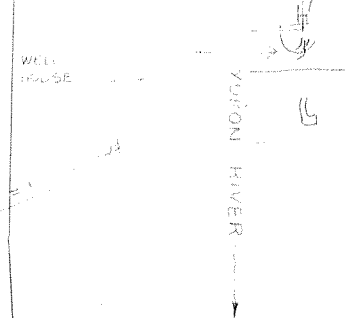

FIELD BOOKS	TBM NO.	LOCATION	ELEV.	DATA	CK'D BY	DATA	CK'D BY	REV.	DATE	DESCRIPTION	BY
DESIGN				BASE		TELE.					
STAKING				TOPO.		ELEC.					
ASBUILT				PROFILE		DESIGN					
				SAN SEWER		QUANTITIES					
				STORM DR.		PRELIM. CHECK					
				WATER		FINAL CHECK					
				GAS		EARTHWORK					
				OTHER FACILITIES							
CONTRACTOR	BASIS OF THIS DATUM										
INSPECTOR											
CONSTRUCTION RECORD	VERTICAL DATUM			PLAN CHECK			REVISIONS				



Arctic Environmental Engineers, Anchorage, Alaska.



VSW WATER LINE

SCALE: HOR. 1"=50' VER. 1"=10'

DRAWN BY: M.E.S. DESIGNED BY: D.S.V.

DATE: 3-1-78 PROJECT NO. 77-049-01

FILE NO. 01 SHEET 3 OF 4

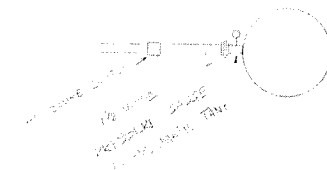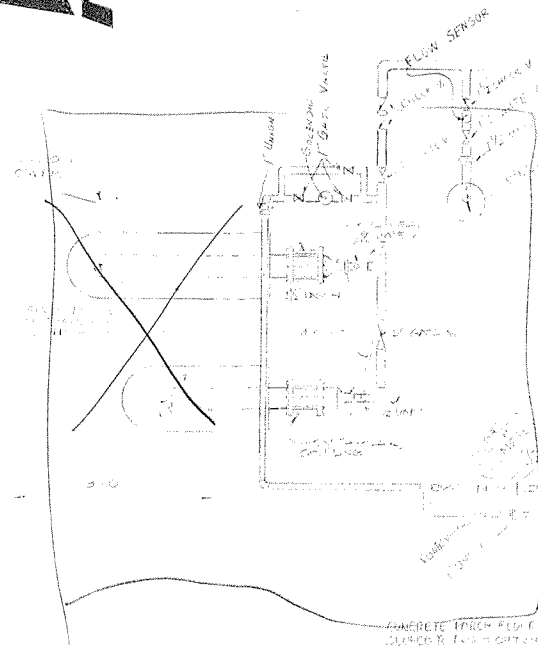


1/2" PIPE
1/2" FLANGE
1/2" NUT

1/2" PIPE
1/2" FLANGE
1/2" NUT


NOTE:

1/2" PIPE IS 1/2" GALVANIZED
ALL OTHER PIPING IS COPPER
WALLS ARE 1/2" THICK W/ 1/2" RADIUS
ALL PIPING IS 1/2" RADIUS

WELL HOUSE PIPING
SCALE: 3/4" = 1'-0"

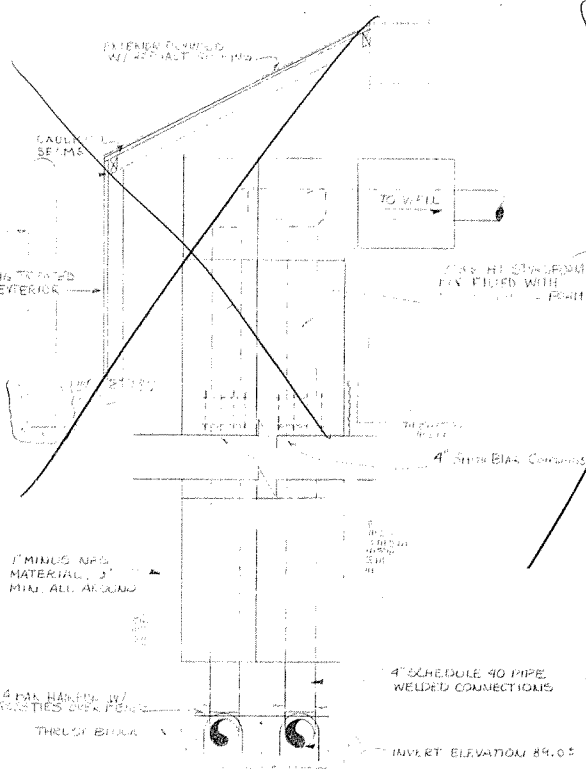


FRONT VIEW

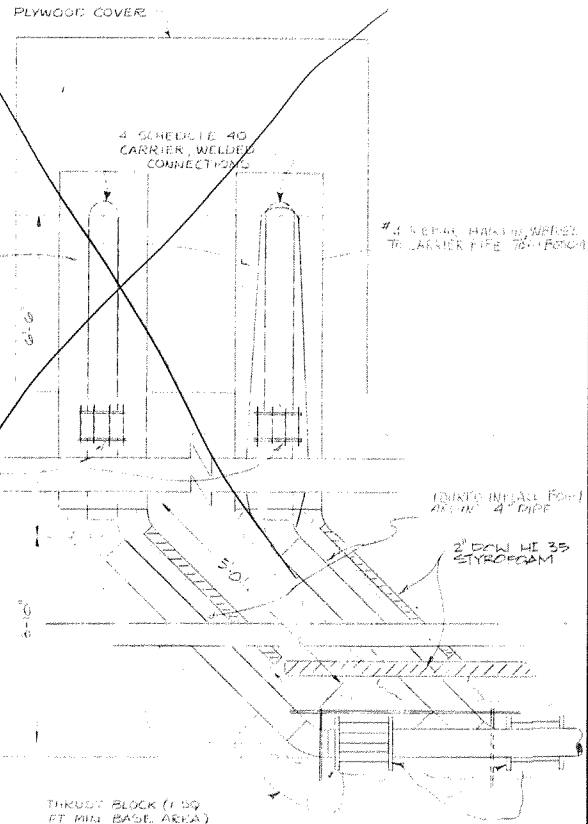


SIDE VIEW

WELL HOUSE WATERLINE ENTRANCE
SCALE: 1" = 1'-0"

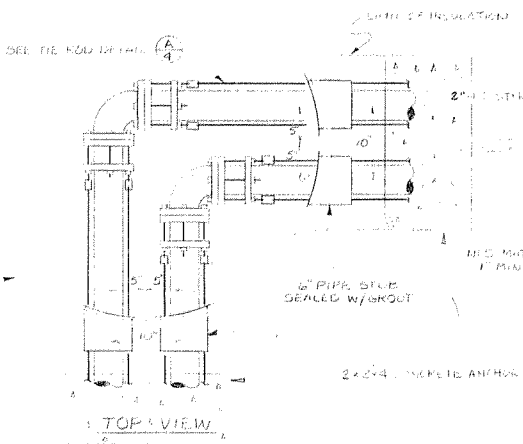


TOP VIEW

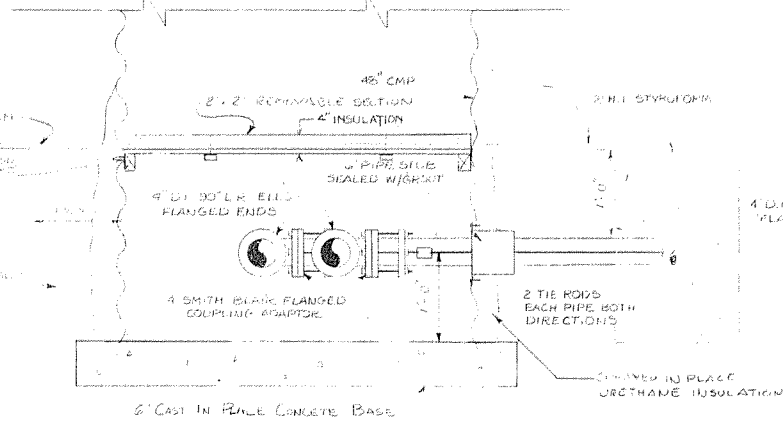

SIDE VIEW

TYPICAL WATERLINE ACCESS MANHOLE
SCALE: 1" = 1'-0"

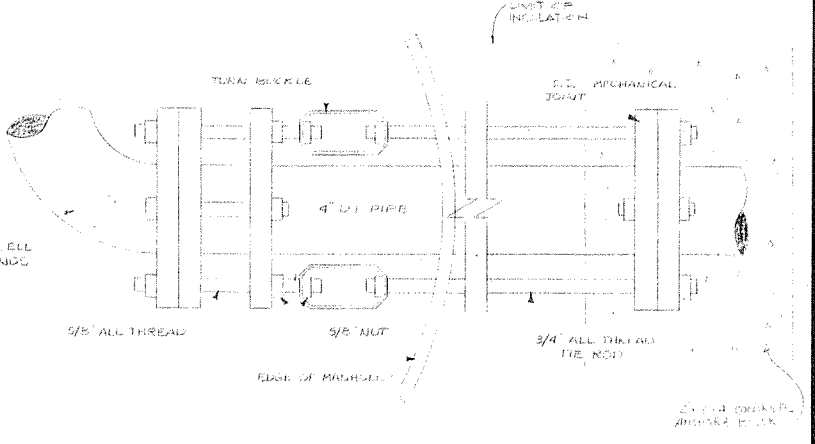

TIE ROD DETAIL
SCALE: 3/4" = 1'-0"

NOTE:
WATER LINES HAVE THERMOMETER
FOR HEATING CABLE TAPED
TO BOTH SIDES

NO.	REVISION	DATE BY
1	AS SHOWN	7/4/78 HZ




Arctic Environmental Engineers
Anchorage, Alaska


PROJECT NO. 77-024 01 SAV
DESIGNED : DSV
DRAWN : HEC
CHECKED : SEC
DATE : MARCH 1978
SCALE : AS SHOWN

TANANA VSW FACILITY
WATER SYSTEM DETAILS

U-2

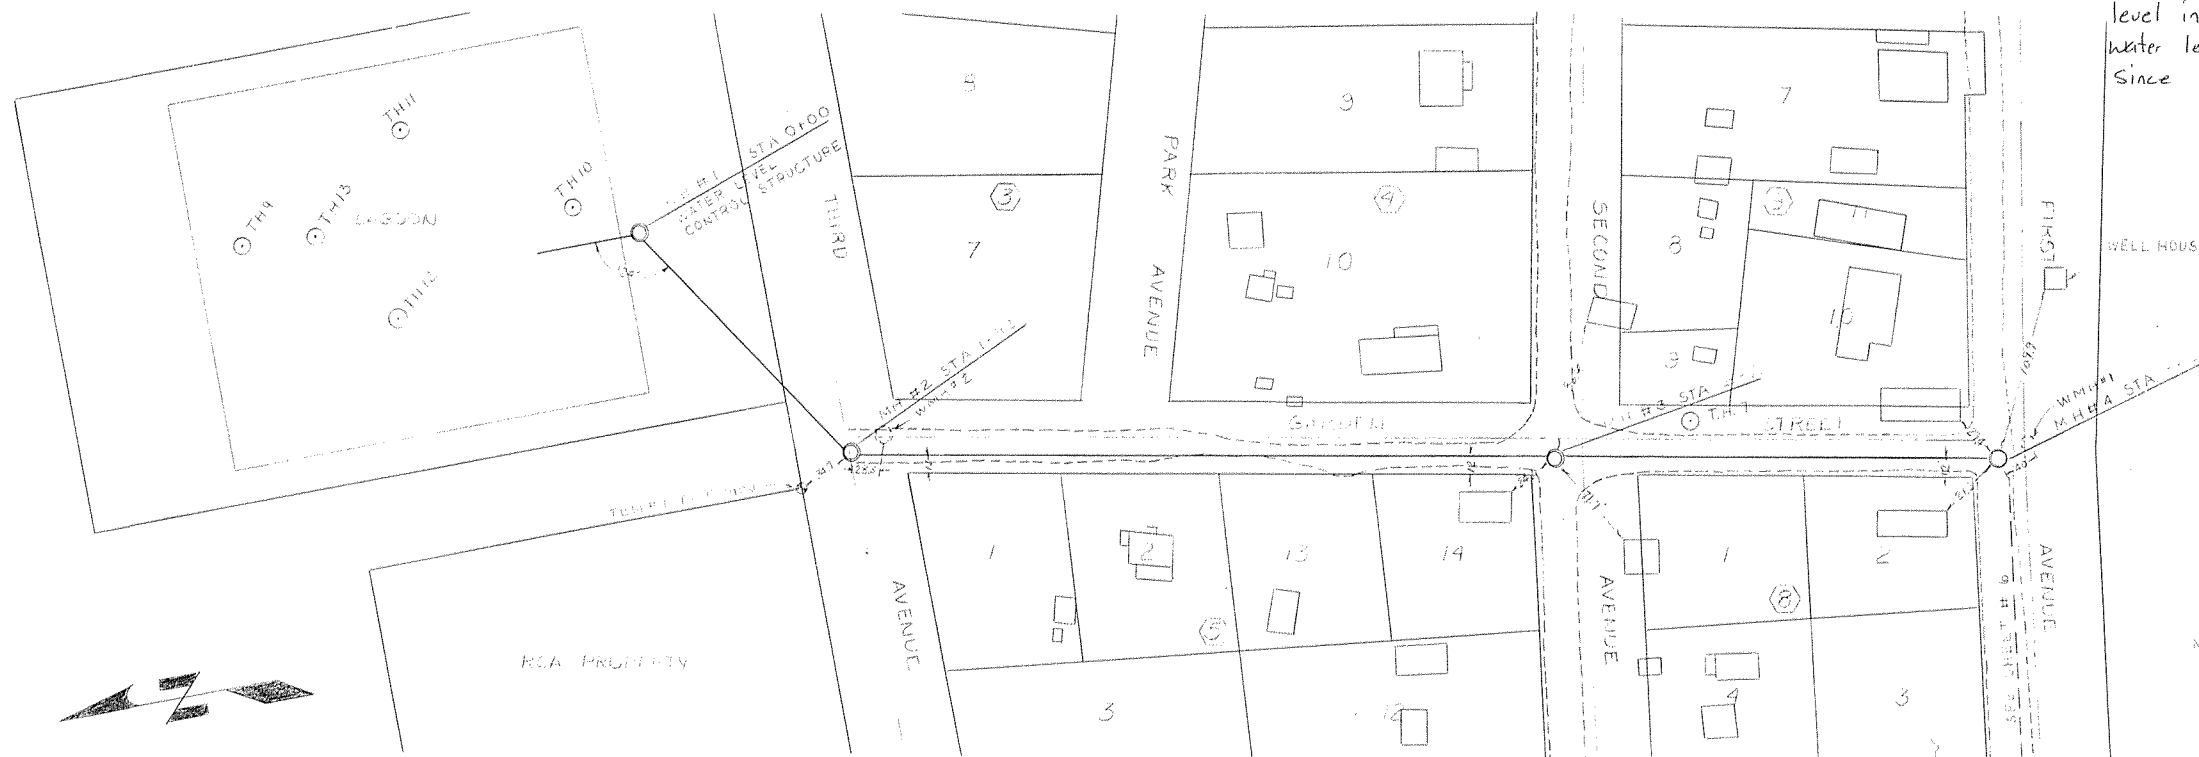

NOTE: TEM #1 MONUMENT @ SE CORNER RCA PROPERTY ASSUMED ELEV 95.4'




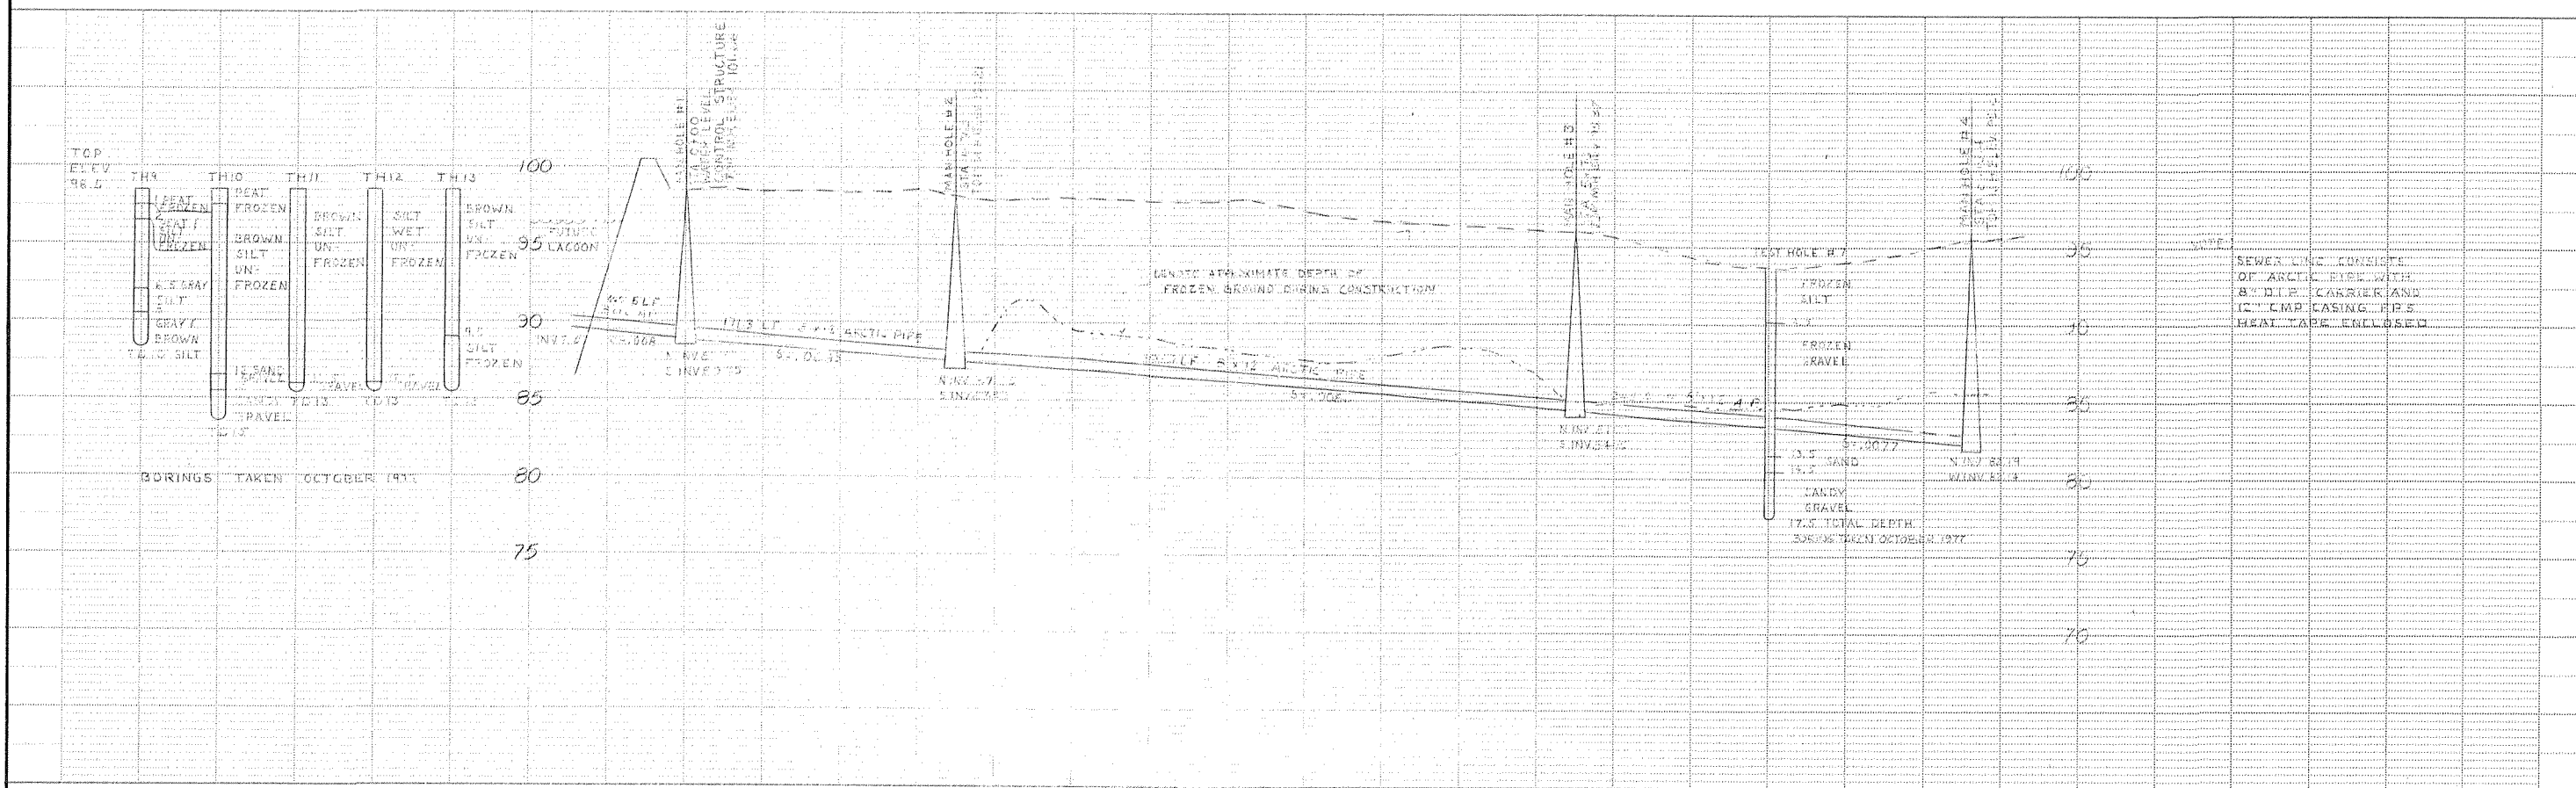


FIELD BOOKS	TBM NO.	LOCATION	ELEV.	DATA	CK'D BY	DATA	CK'D BY	REV.	DATE	DESCRIPTION	BY
DESIGN				BASE		TELE.					
STAKING				TOPO.		ELEC.					
ASBUILT				PROFILE		DESIGN					
				SAN. SEWER		QUANTITIES					
				STORM DR.		PRELIM. CHECK					
				WATER		FINAL CHECK					
				GAS		EARTHWORK					
				OTHER FACILITIES							
CONTRACTOR	BASIS OF THIS DATUM										
INSPECTOR											
CONSTRUCTION RECORD	VERTICAL DATUM			PLAN CHECK			REVISIONS				

Arctic Environmental Engineers, Anchorage, Alaska.

LAGOON EFFLUENT

SCALE: HOR. 1" = 50' VER. 1" = 5'	DRAWN BY: MLE DESIGNED BY: DSV	DATE: 3-1-78 PROJECT NO. 77-024-01	FILE NO. U3	SHEET 5 OF 42
--------------------------------------	-----------------------------------	---------------------------------------	-------------	---------------

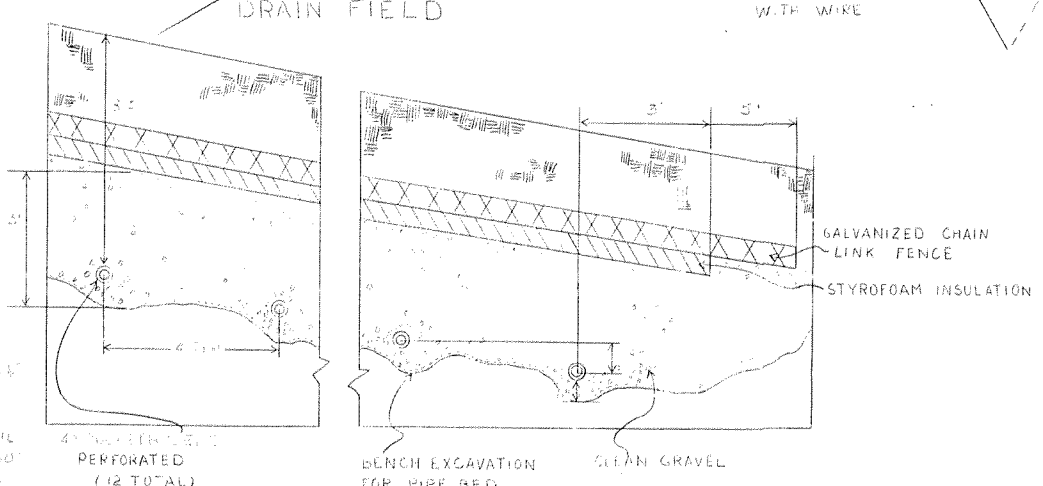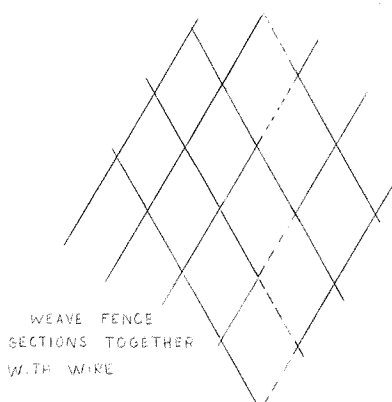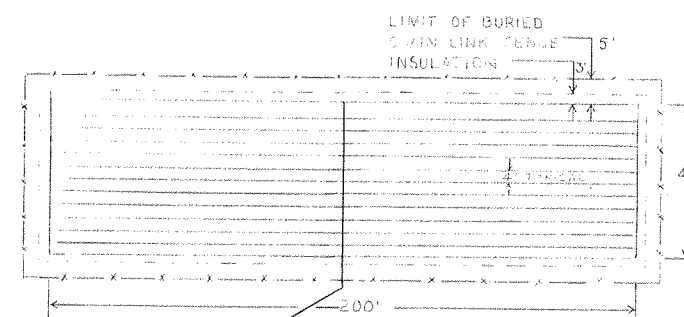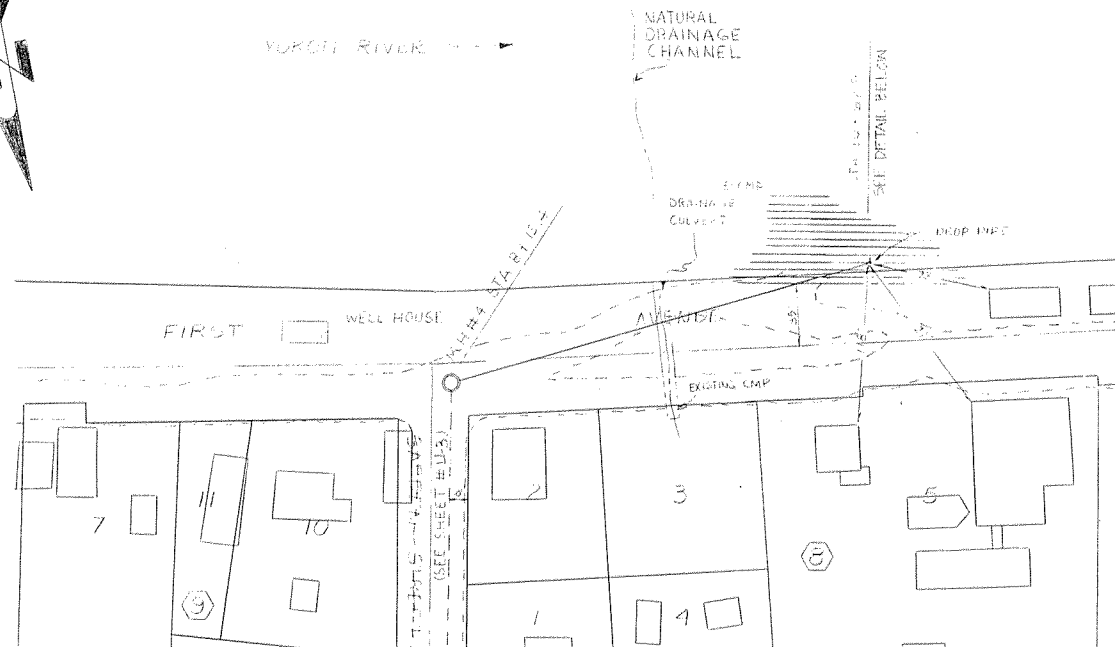


PERFORATION DETAIL
THREE 1/2" HOLES @ 60"
ON BOTTOM @ 5" O.C.

4" POLYETHYLENE PIPE
PERFORATED
(12 TOTAL)


BENCH EXCAVATION
FOR PIPE BED

CLEAN GRAVEL

95
90
85
80
75
70
65

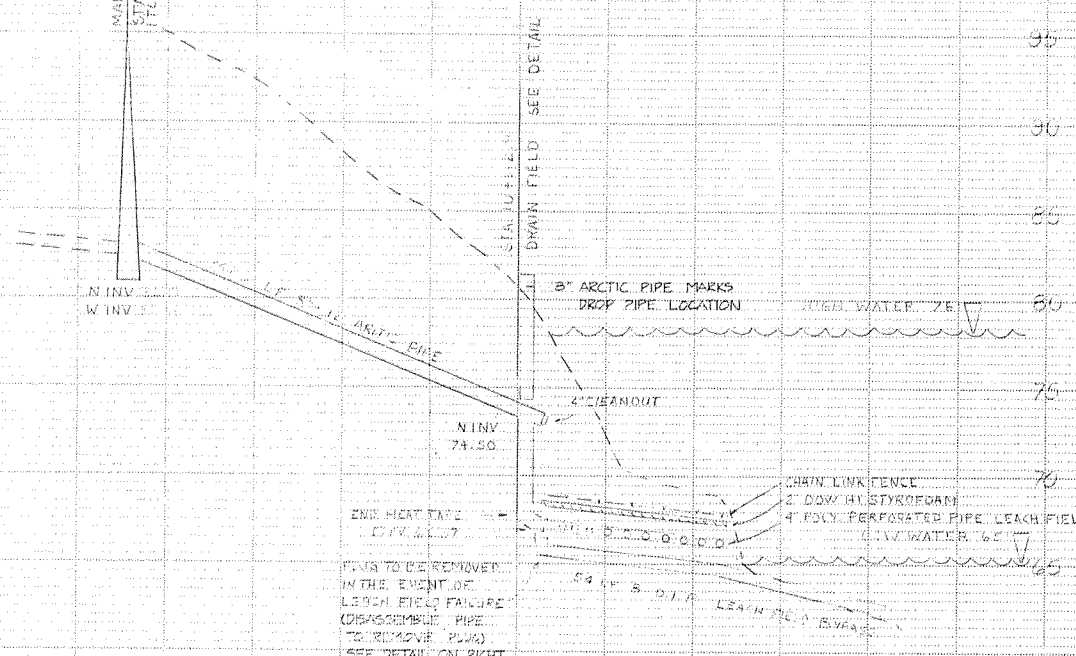


EACH FIELD BYPASS
PLUG DETAIL

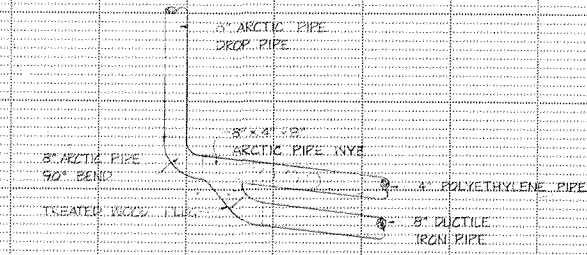

NOTE: TO REMOVE PLUG, DROP PIPE,
90° BEND AND WYE MUST BE
REMOVED. REPLACE AFTER
PLUG REMOVAL.

FIELD BOOKS	TBM NO.	LOCATION	ELEV.	DATA	CK'D BY	DATA	CK'D BY	REV.	DATE	DESCRIPTION	BY
DESIGN				BASE		TELE.					
STAKING				TOPO.		ELEC.					
ASBUILT				PROFILE		DESIGN					
				SAN. SEWER		QUANTITIES					
				STORM DR.		PRELIM. CHECK					
				WATER		FINAL CHECK					
				GAS		EARTHWORK					
				OTHER FACILITIES							
CONTRACTOR	BASIS OF THIS DATUM										
INSPECTOR											
CONSTRUCTION RECORD		VERTICAL DATUM		PLAN CHECK		REVISIONS					


100%
F.S.
L.V.

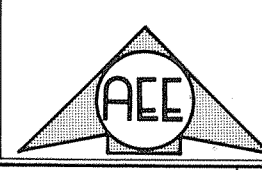



Arctic Environmental Engineers, Anchorage, Alaska.

LAGOON EFFLUENT


SCALE	HOR. 1" = 50'	VER. 1" = 10'	DRAWN BY	H.E.S.	DATE	3-1-75	FILE NO.	U4	SHEET	6	OF 4
DESIGNED BY	U.S.V.	PROJECT NO.	77-024-01								

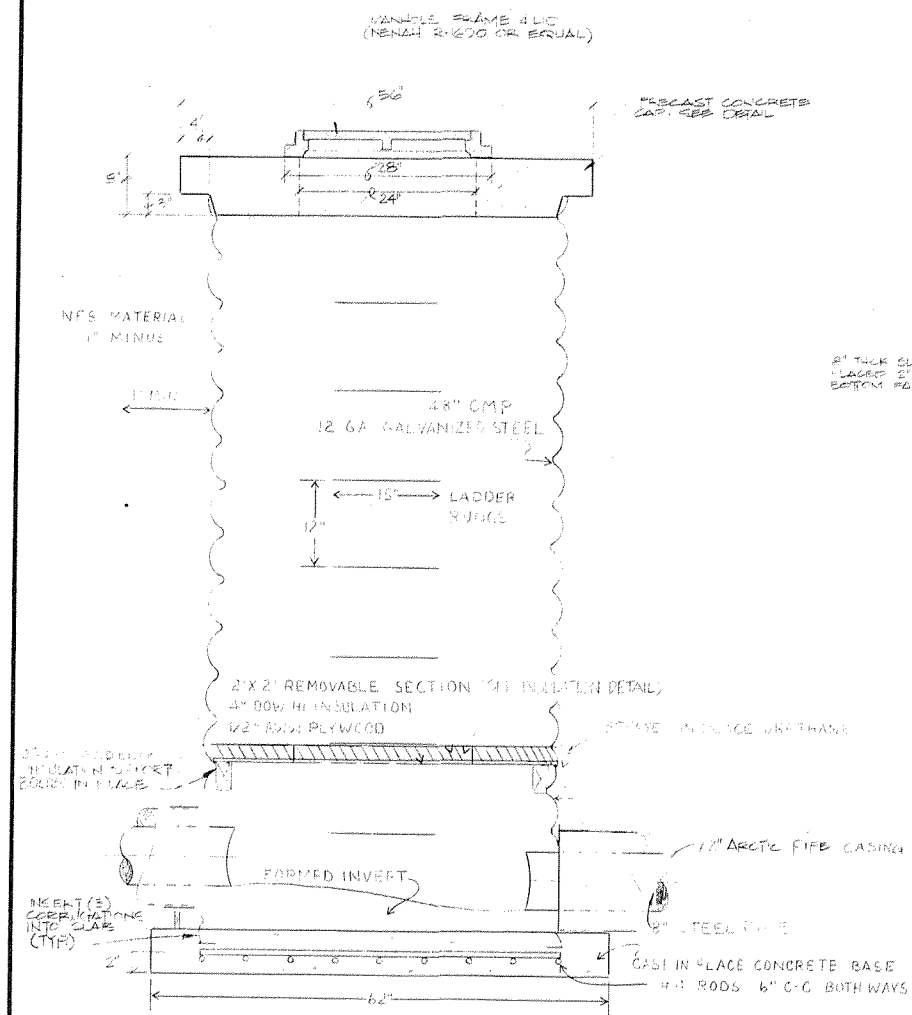


TYPICAL SANITARY MANHOLE
(HEIGHTS VARY)

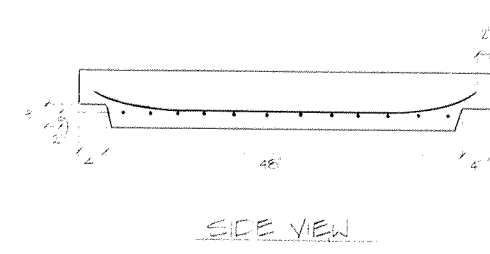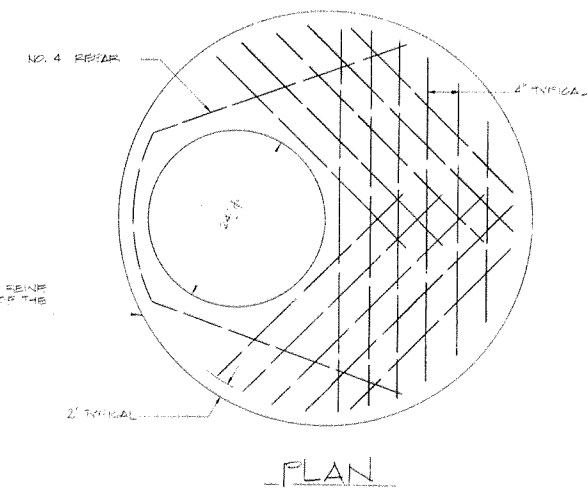


PRECAST MANHOLE TOP
PRECAST ALASKA (PRODUCT No. 611)

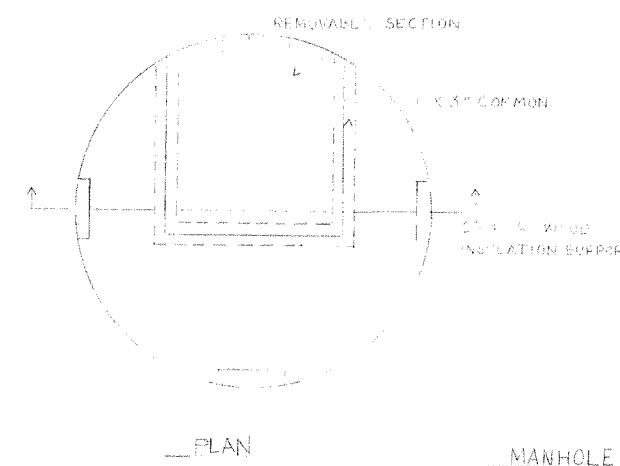

MANHOLE INSULATION DETAILS

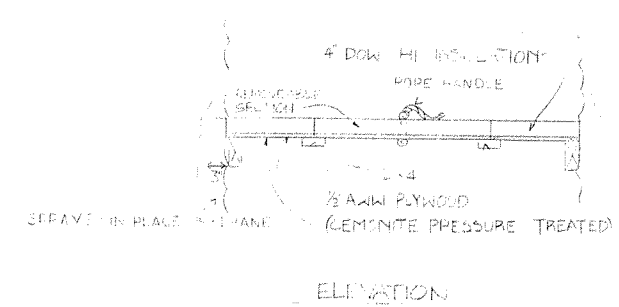

NO.	REVISION	DATE BY

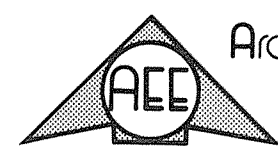


Arctic Environmental Engineers
Anchorage, Alaska

PROJECT NO. 77-024-01
DESIGNED: DSV
DRAWN: MLS
CHECKED: WSVH
DATE: 3-78
SCALE: 1" = 1'


TANANA VSW FACILITY
MANHOLE DETAILS

U5
SHEET 7 OF 42

eration pumps in basement of Landramat did not run during summer of 84 + 85 if lagoon begins to smell they should be turned on periodically
check operating manual
pym 1-6-86

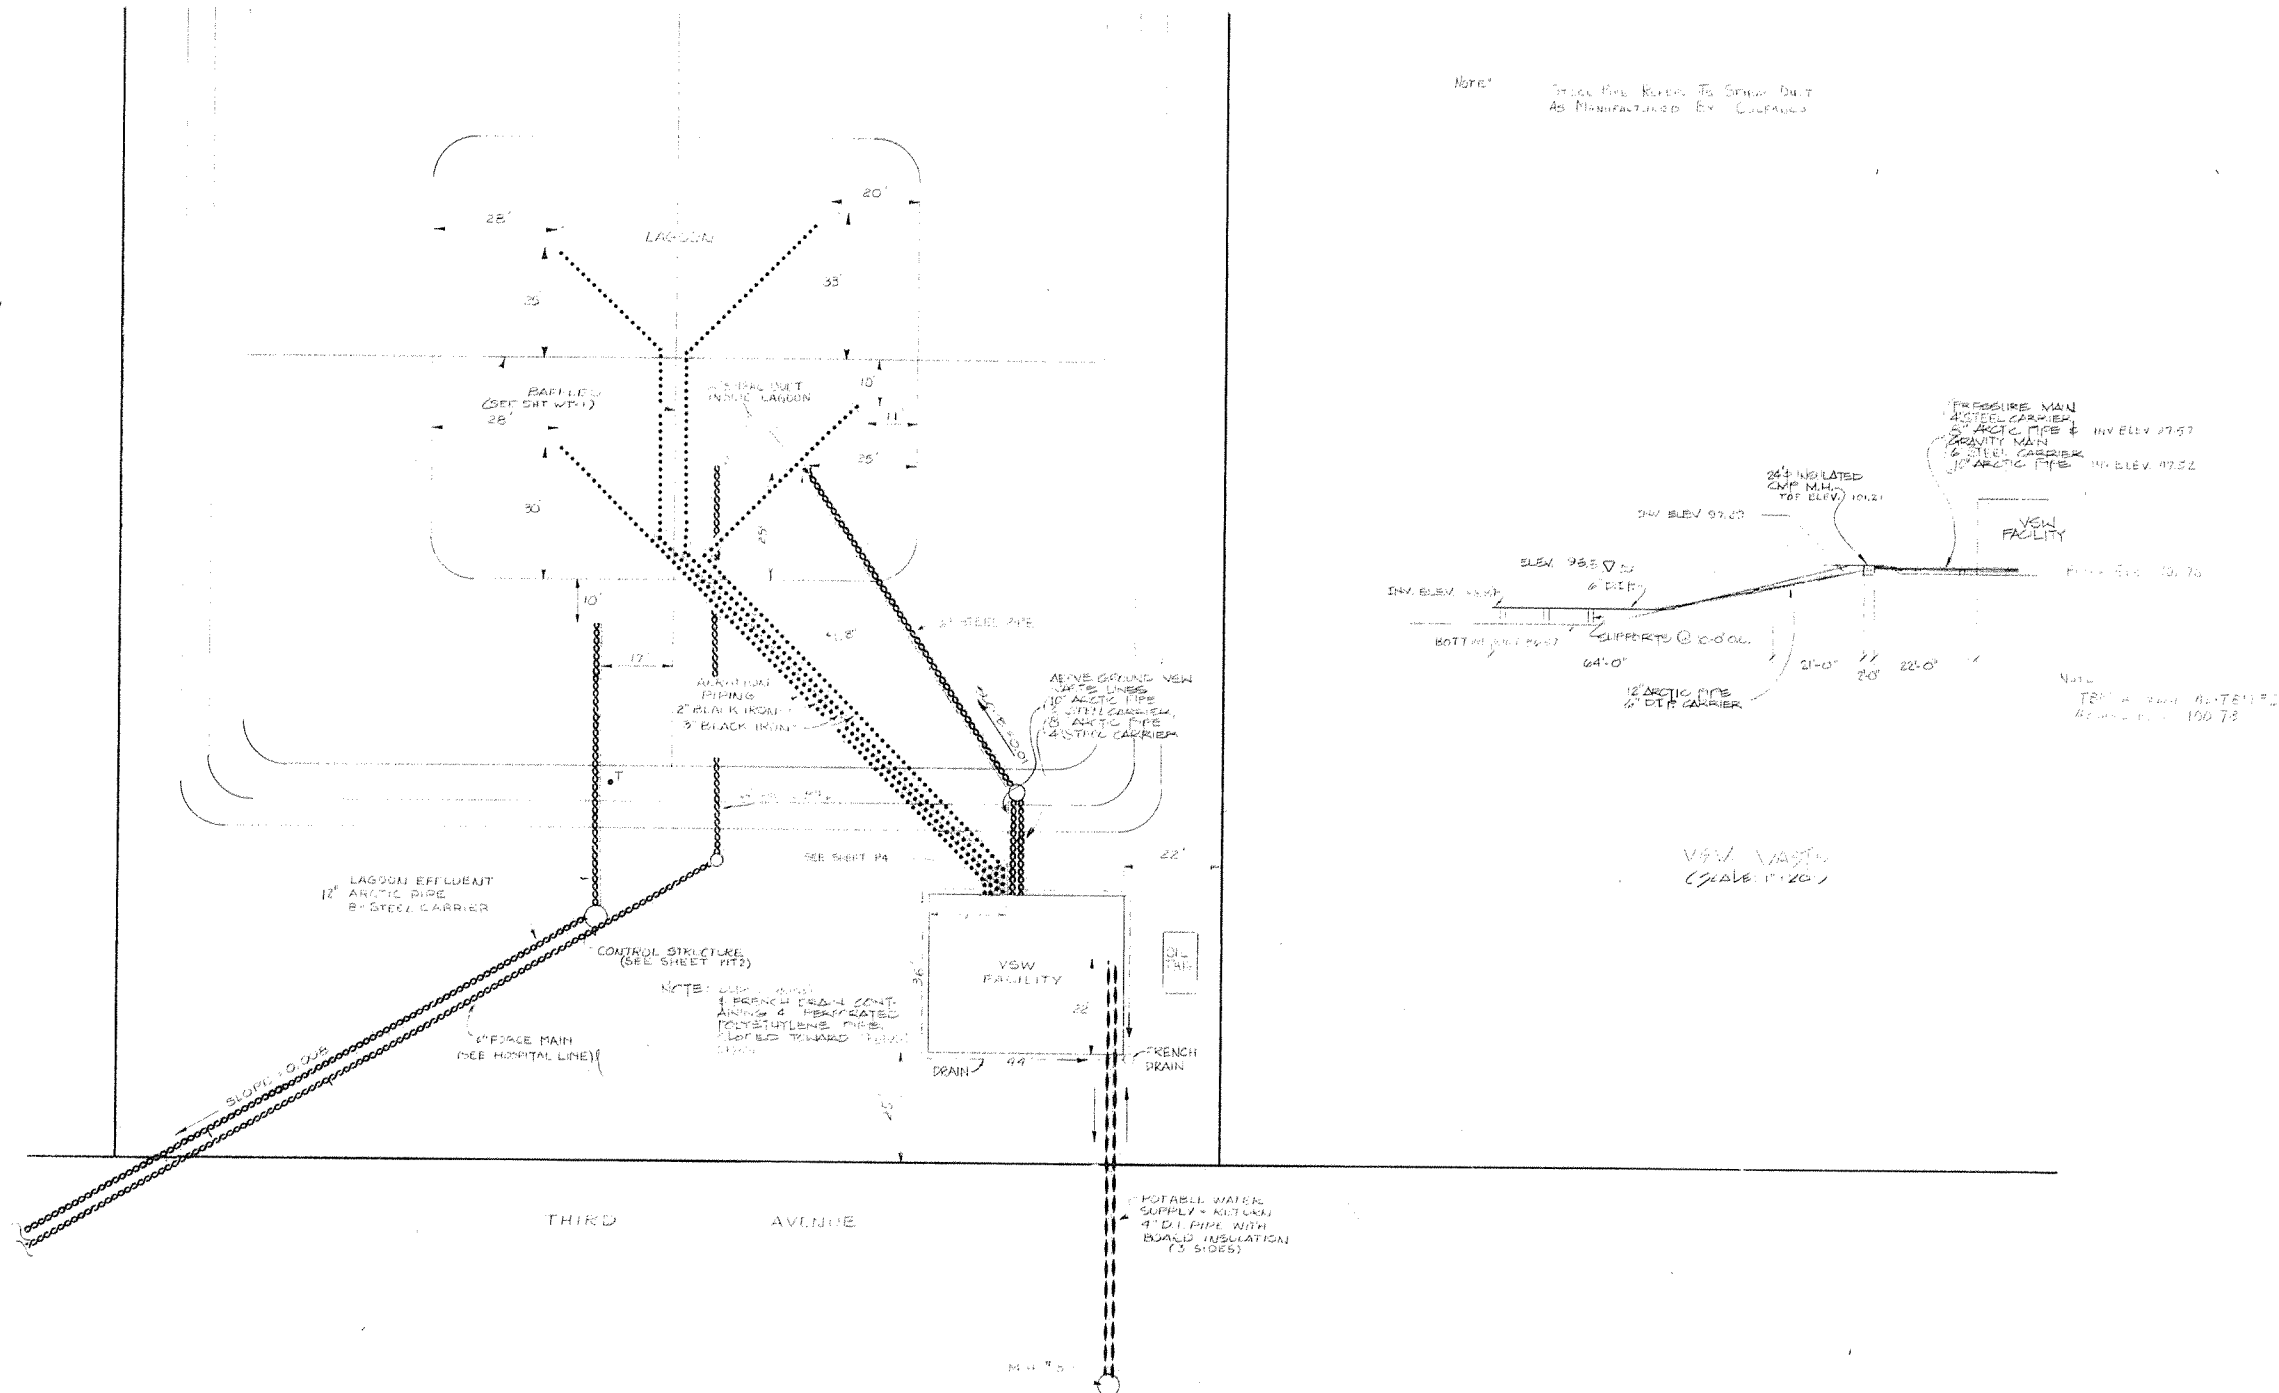

NOTE: These Pipe Run To Street Out As Manufactured By - CULFAULD

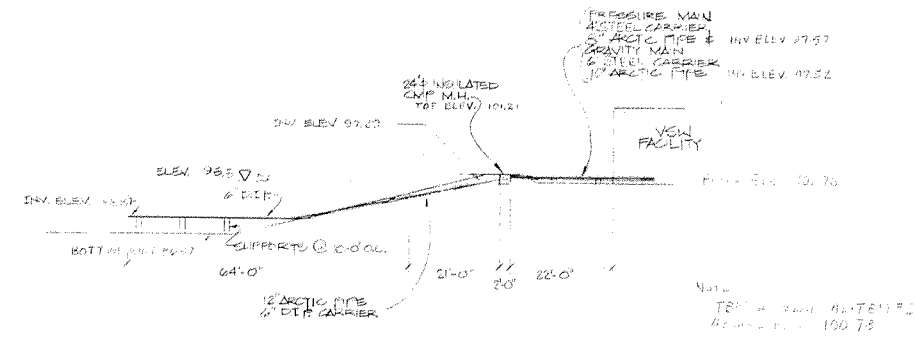

VSW VAS (SCALE 1\"/>

LEGEND
 AERATION PIPING
 - - - - - SEWER LINES
 - - - - - WATER LINES
 - - - - - FRENCH DRAIN

NOTE:
 ARCTIC PIPE HAS THERMOMETER LEADING CABLE IN THROUGH CABLE RACE ATTACHED TO CARRIER. ALL OTHER LINES W/ CABLE TIED TO SIDE OF PIPE.

2	ADD	7-16-78	
1	ADDED HOSPITAL FORCE MAIN	7/14/78 WSV/H	
NO.	REVISION	DATE	BY



Arctic Environmental Engineers
Anchorage, Alaska








PROJECT NO. 77-024-D-514
 DESIGNED : D S Y
 DRAWN : H E C
 CHECKED : W S V H
 DATE : MARCH 1978
 SCALE : 1\"/>

TANANA VSW FACILITY

YARD PIPING

U-6

SHEET 8 OF 42

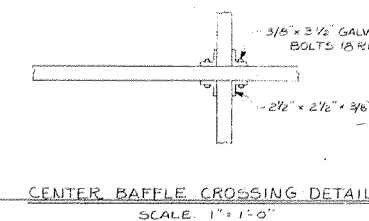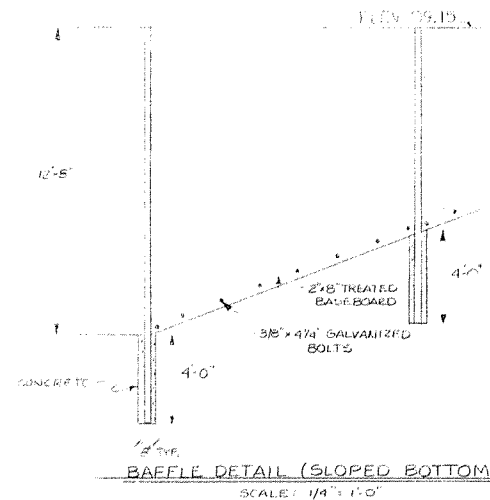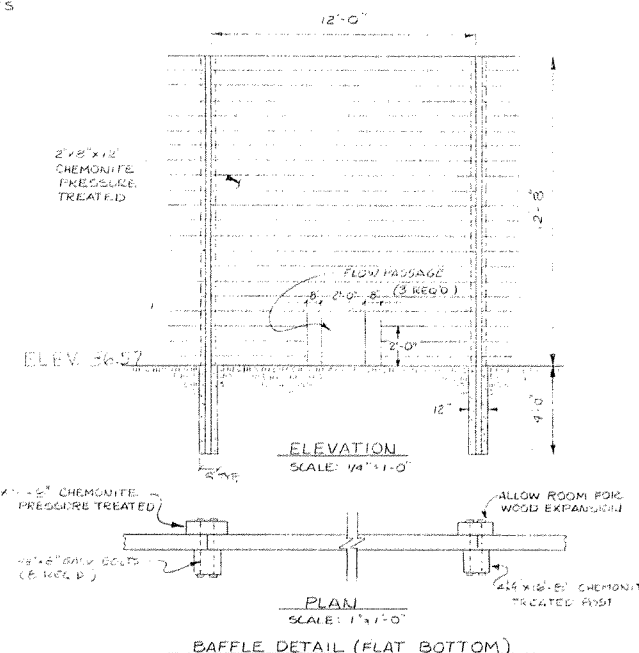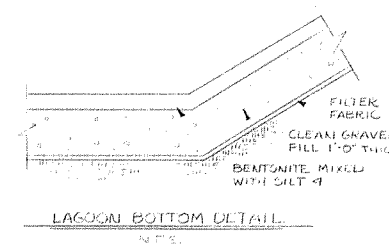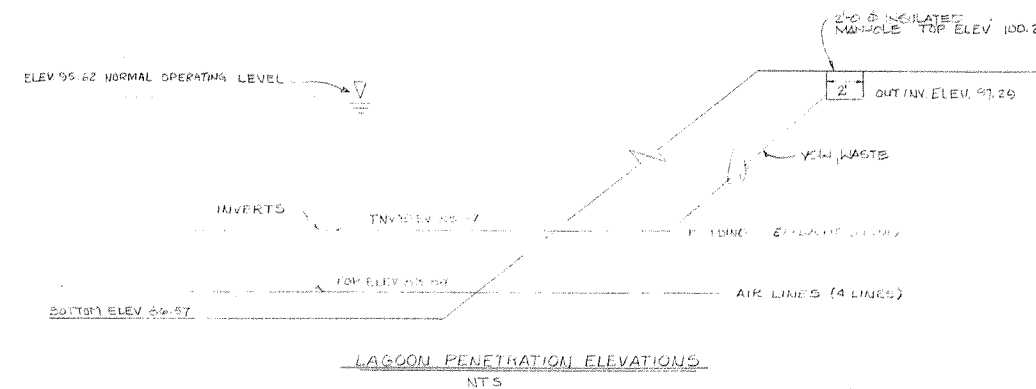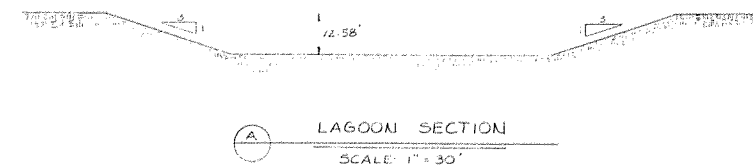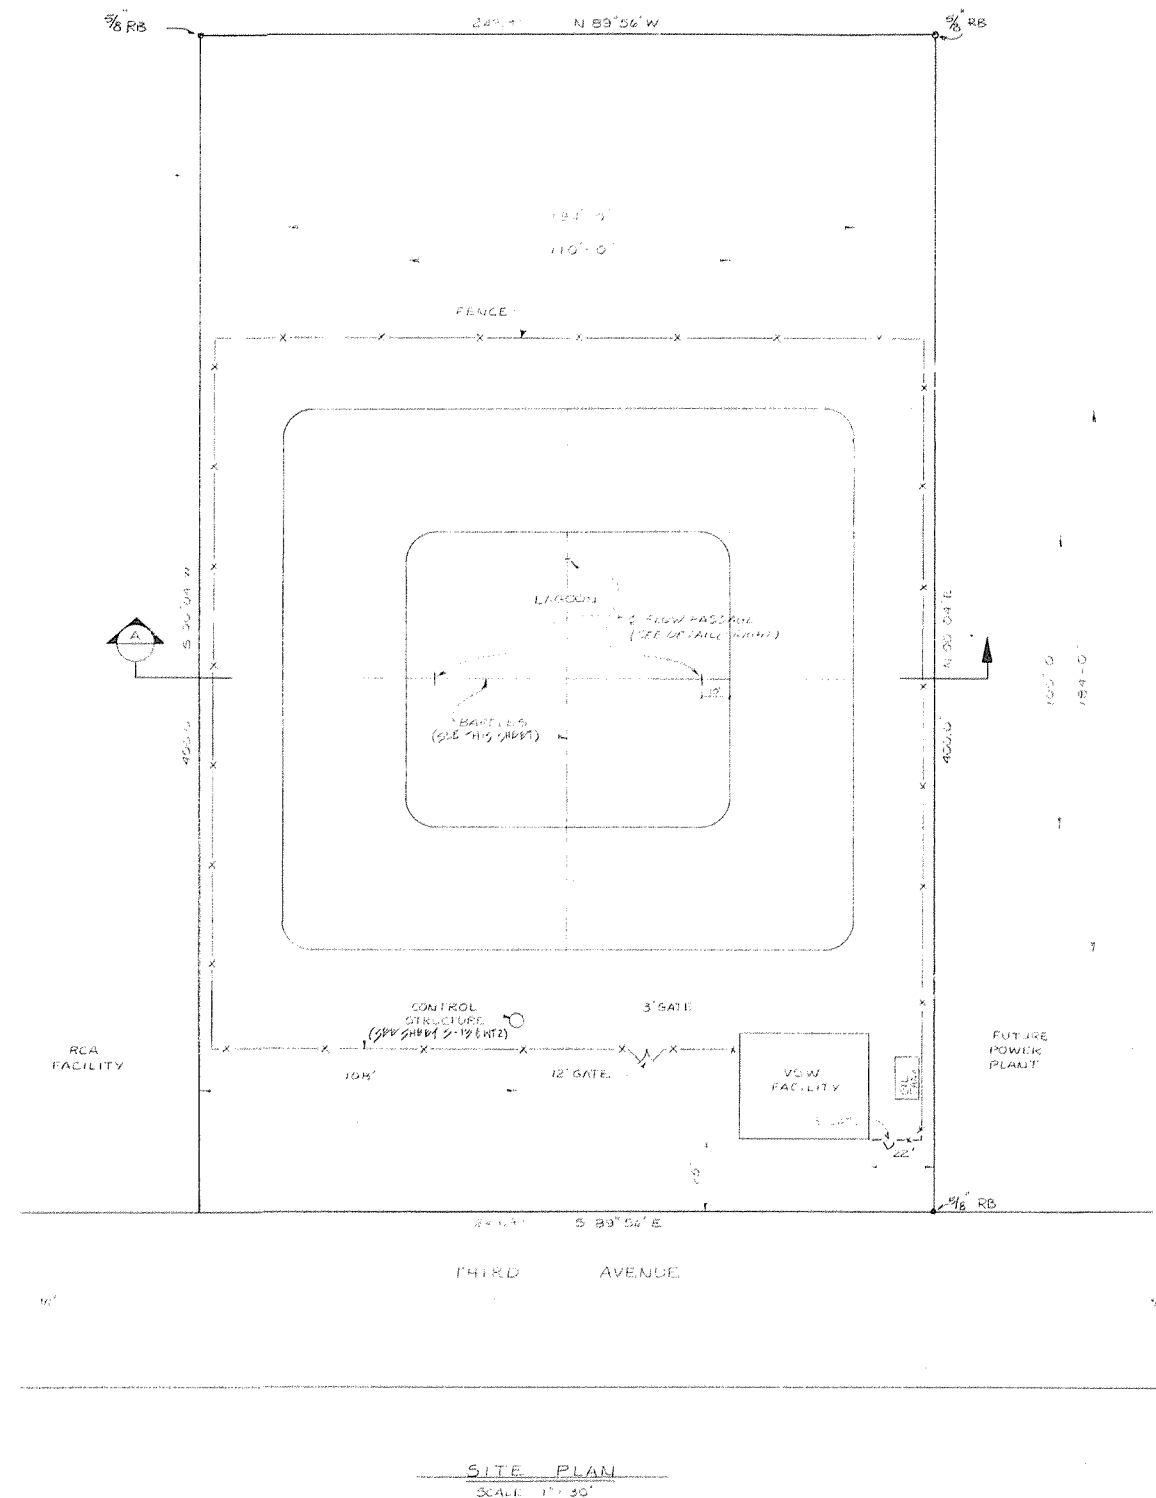

NO.	REVISION	DATE	BY
1	AS BUILT	7-15-73	MP









Arctic Environmental Engineers
Anchorage, Alaska

PROJECT NO. 71-024-01 SAV
DESIGNED : D.S.Y.
DRAWN : H.F.C.
CHECKED : W.S.V.H.
DATE : MARCH 1975
SCALE : AS NOTED

TANANA VSW FACILITY
LAGOON

WT-1

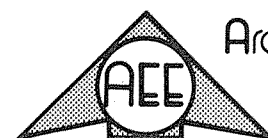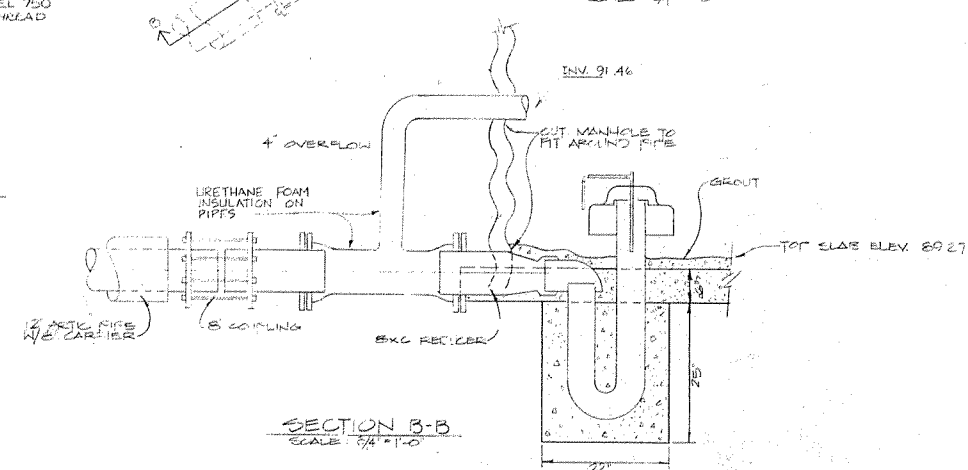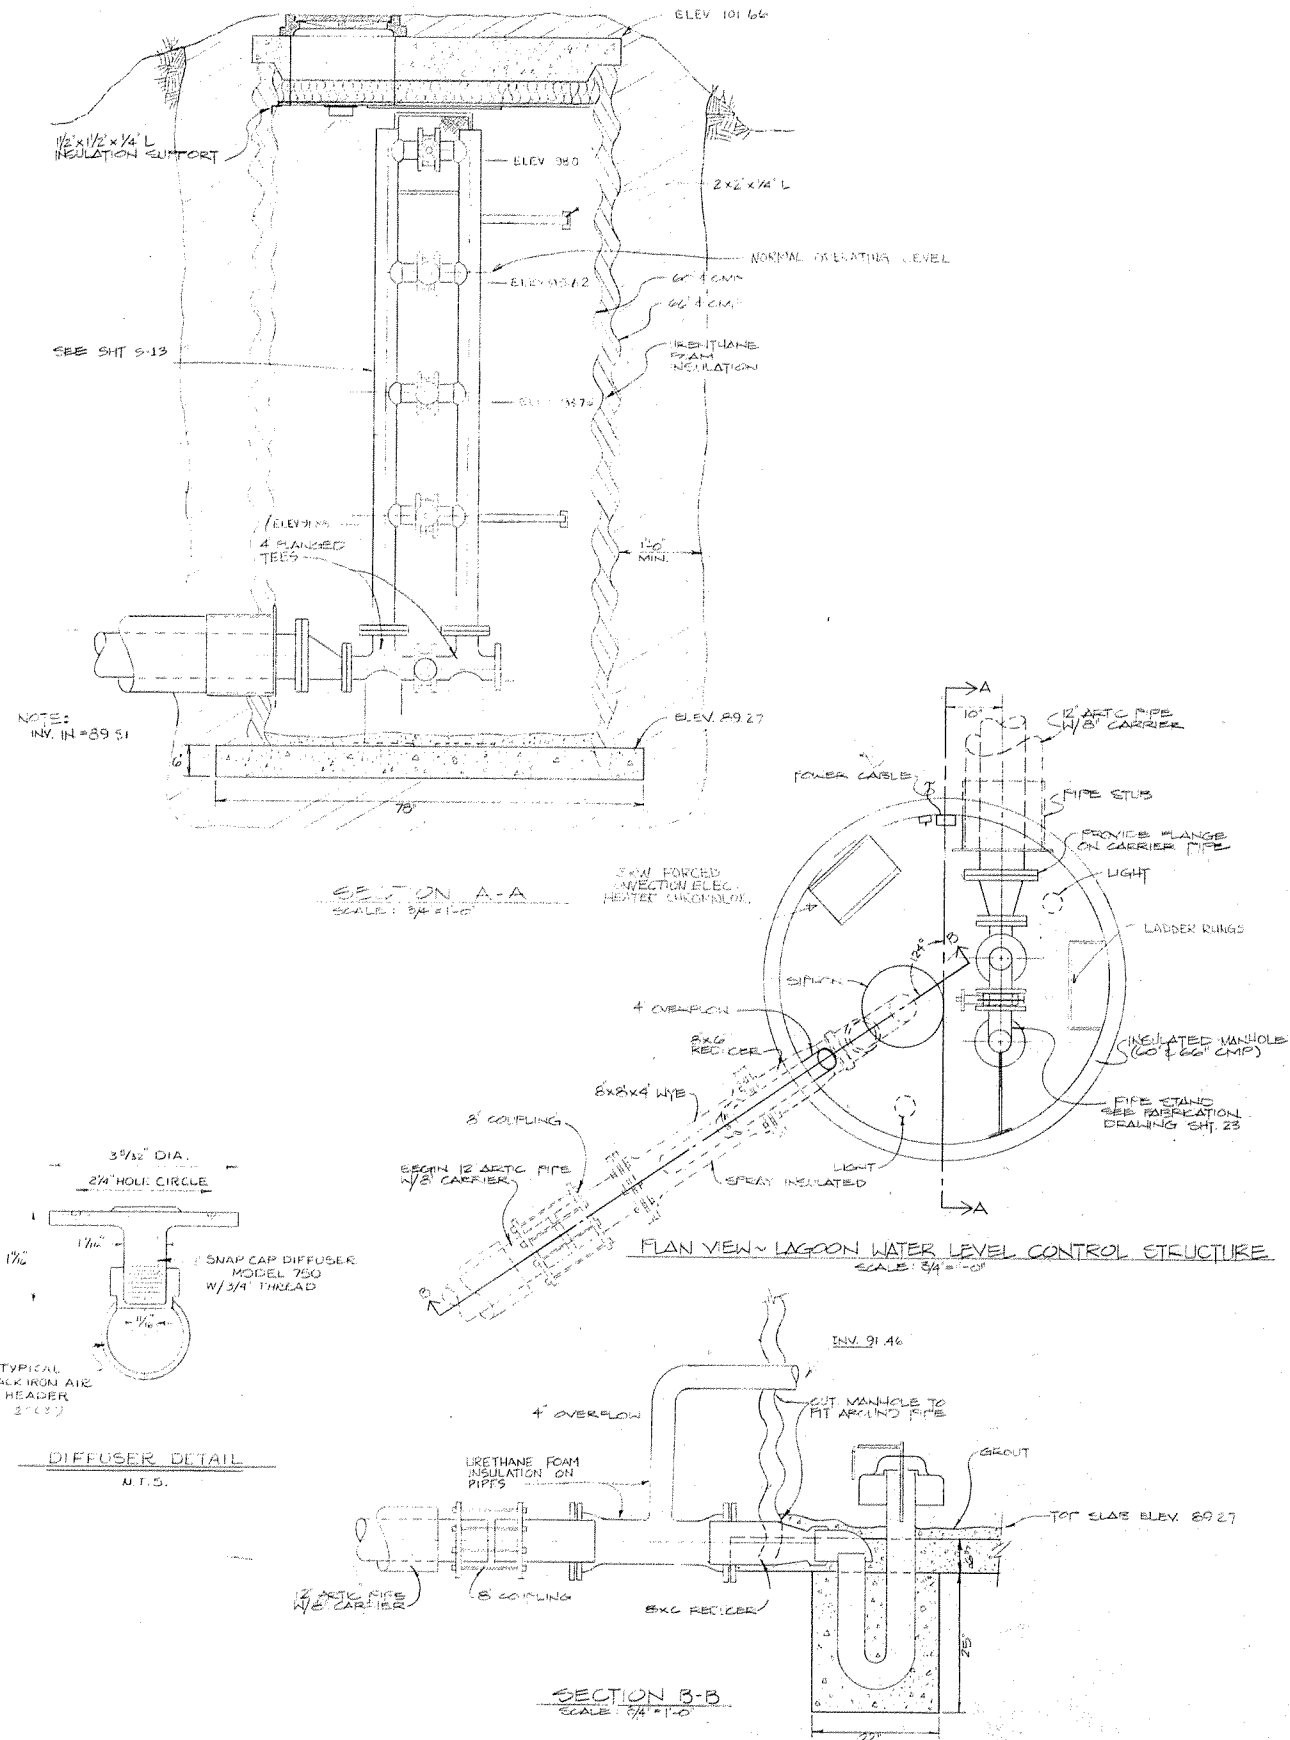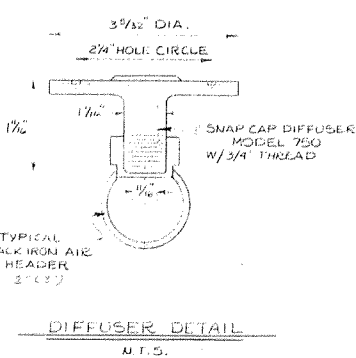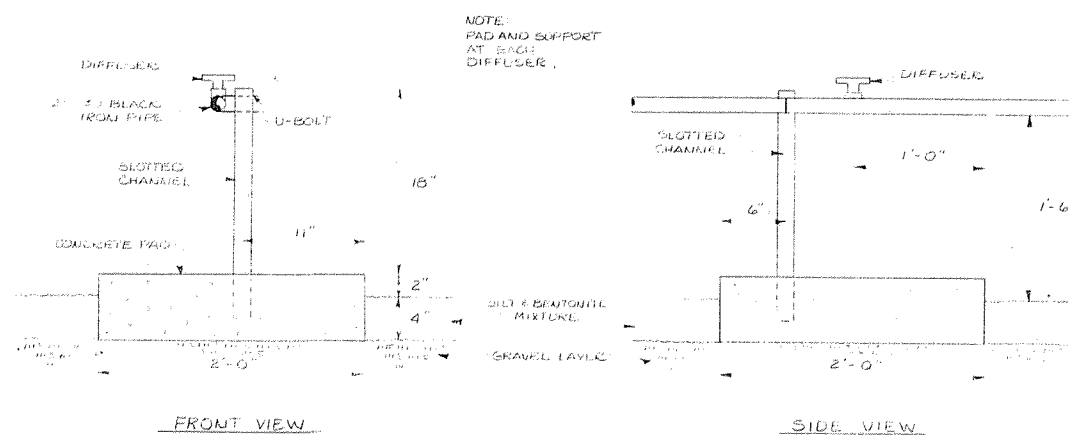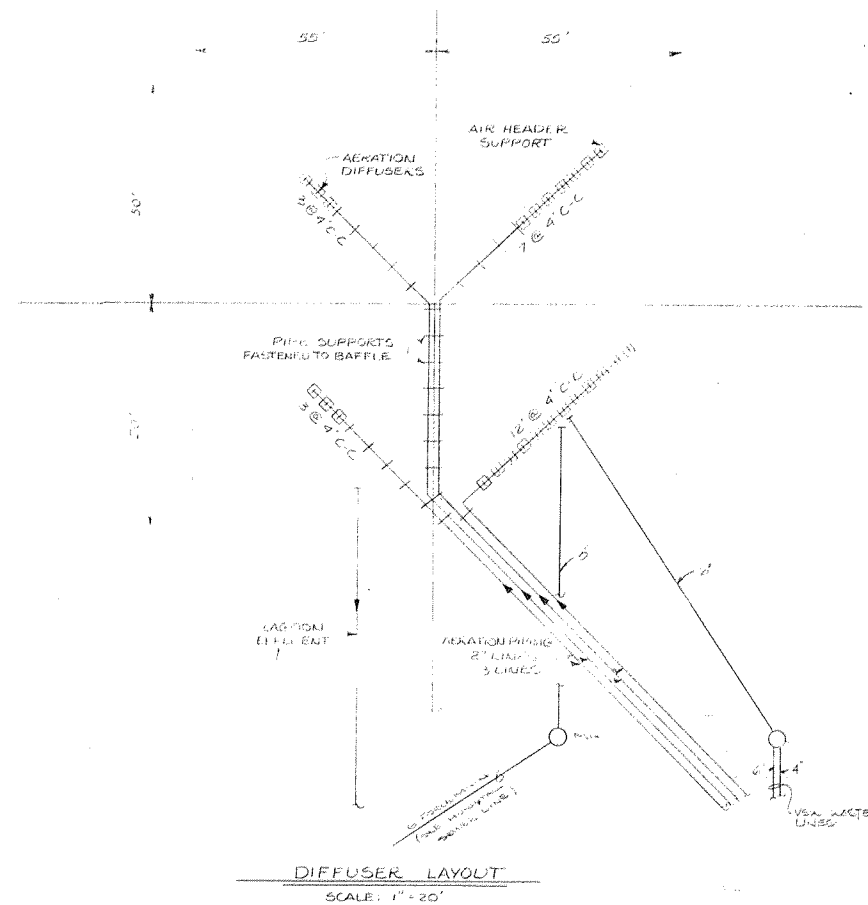

Arctic Environmental Engineers
Anchorage, Alaska

PROJECT NO. 77-029-Q1 SAV
DESIGNED : D.S.Y.
DRAWN : H.E.C.
CHECKED : W.S.V.H.
DATE : MARCH 1978
SCALE : AS SHOWN








TANANA VSW FACILITY

LAGOON DETAILS

WT-2

SHEET 10 OF 42

NOTE: ALL BUILDING ELEVATIONS
ARE BASED ON ASSUMED
100.00 AT BASEMENT
FLOOR.

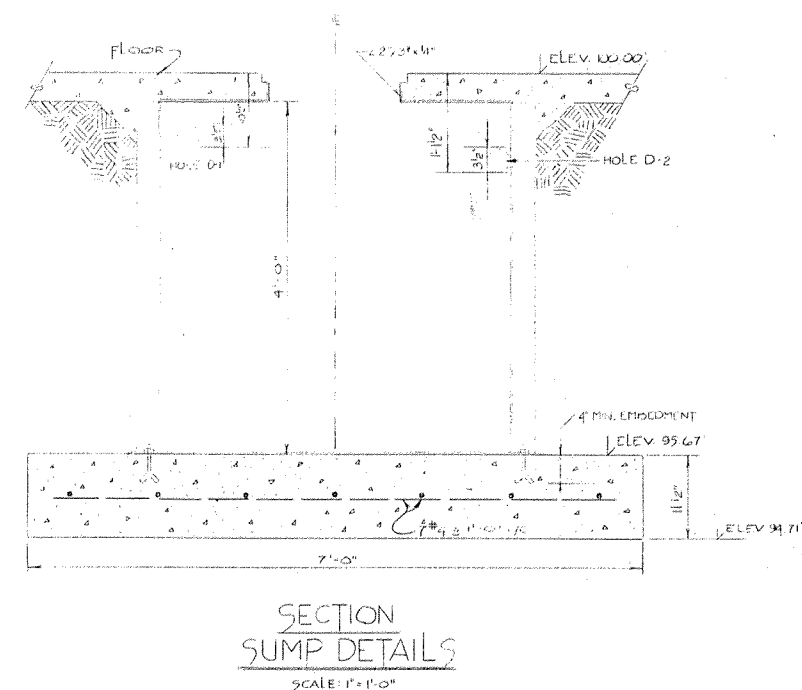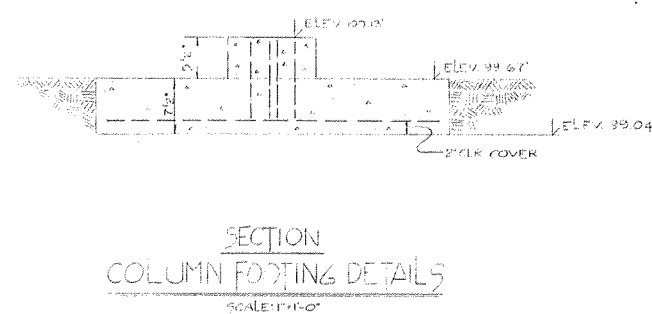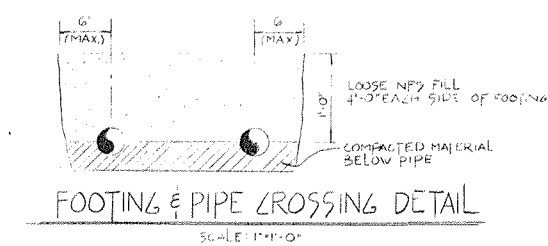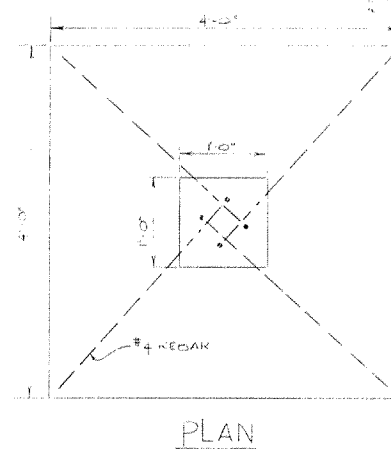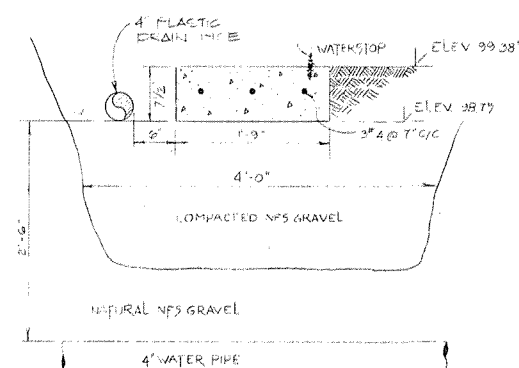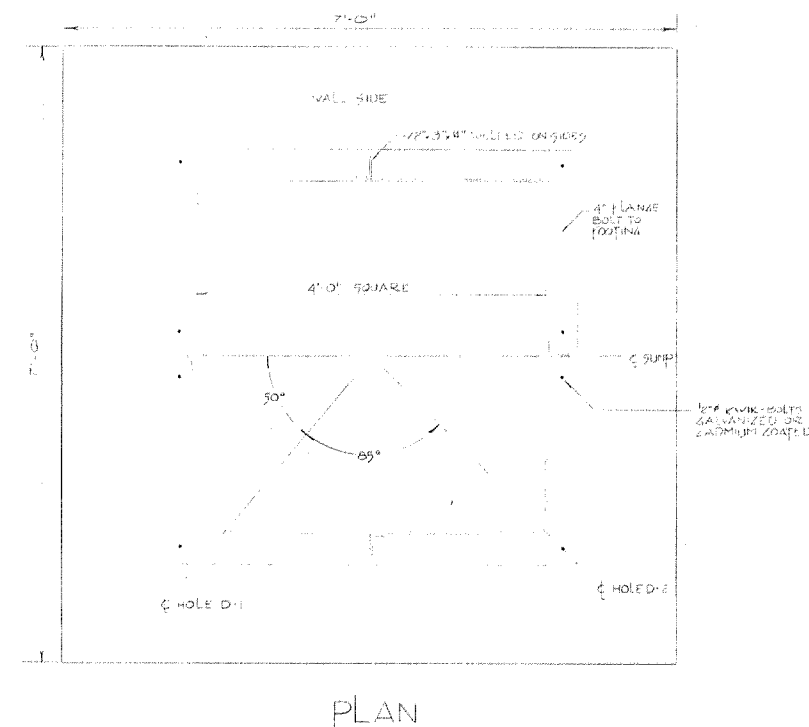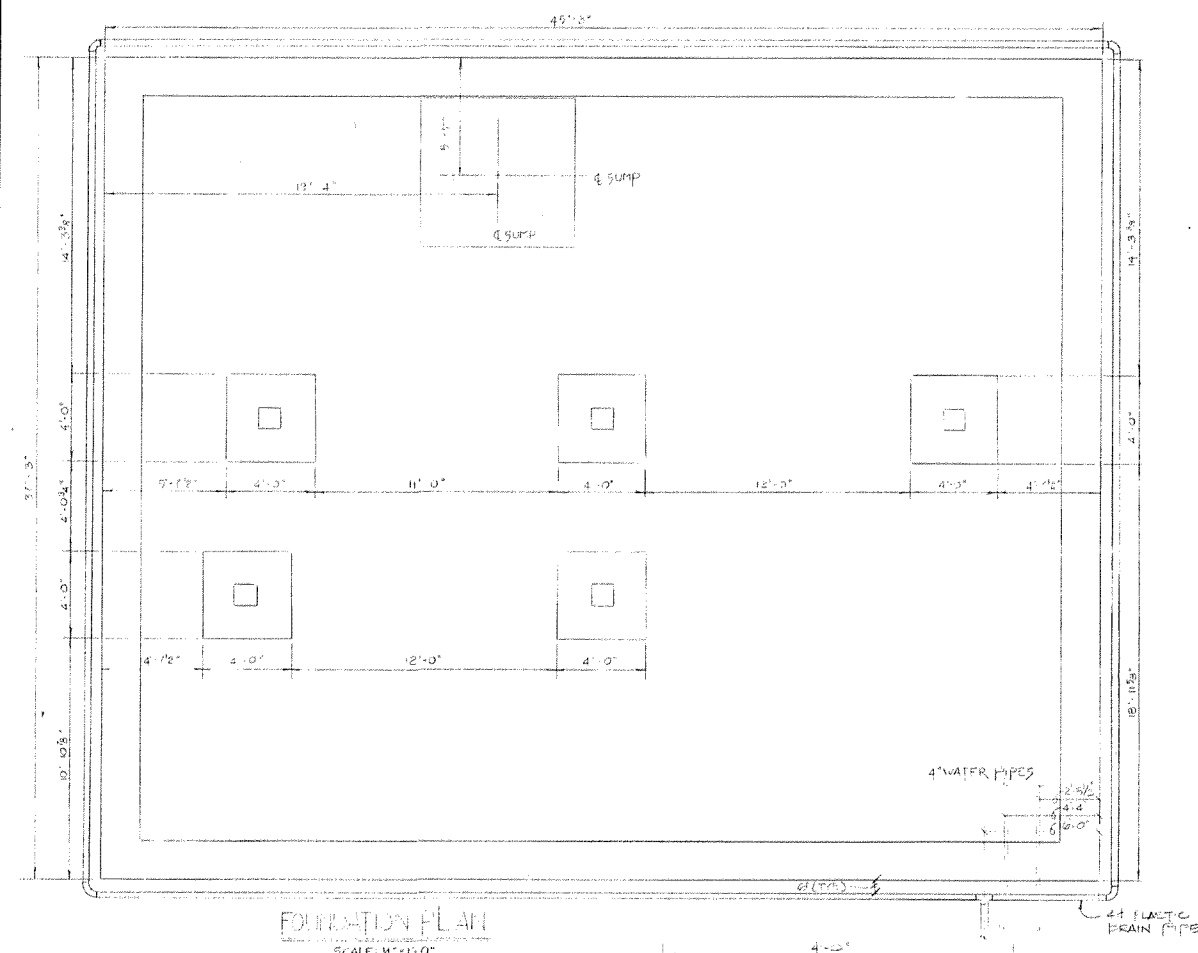





Arctic Environmental Engineers
Anchorage, Alaska

PROJECT NO. 66-024
DESIGNED : OPW
DRAWN : PEZ
CHECKED : W.S.V.H.
DATE : MARCH 1978
SCALE : AS NOTED

TANANA VILLAGE SAFE WATER FACILITY
FOUNDATION PLAN & DETAILS

S-

SHEET 11 OF 42

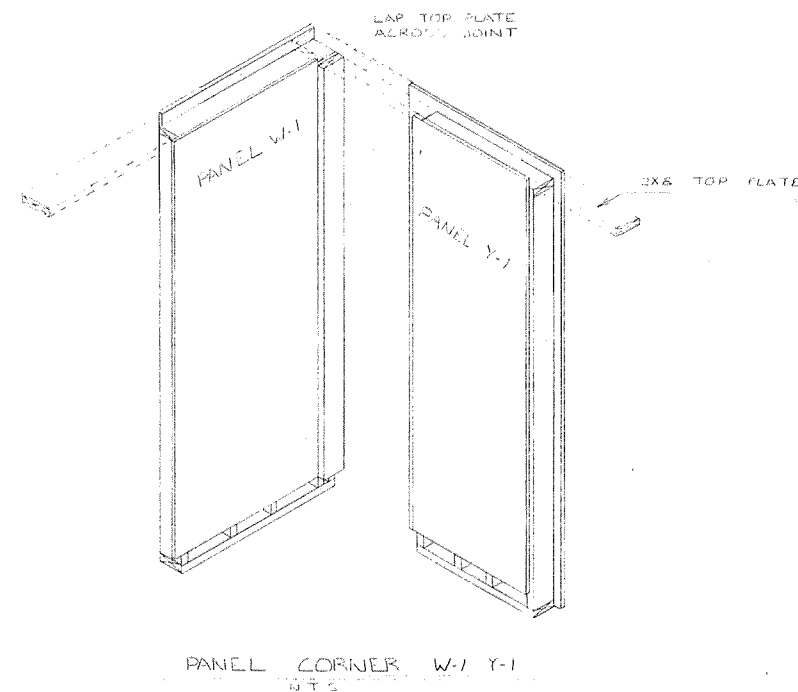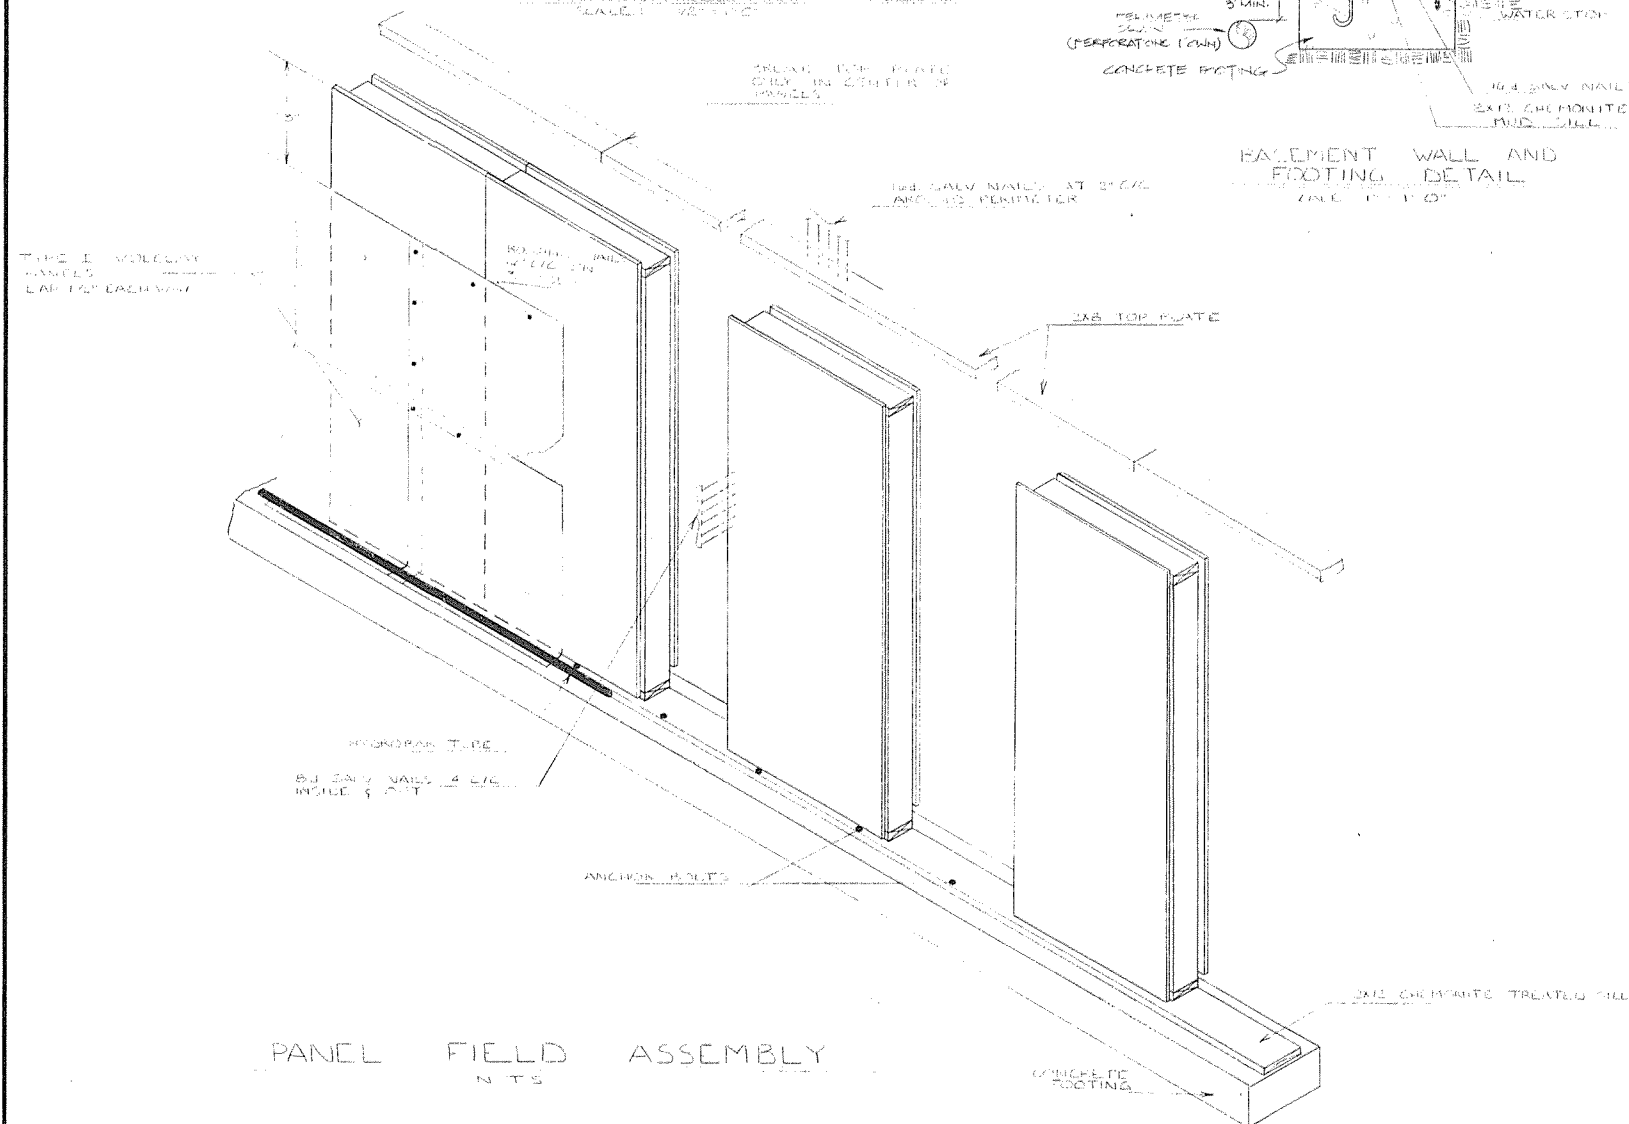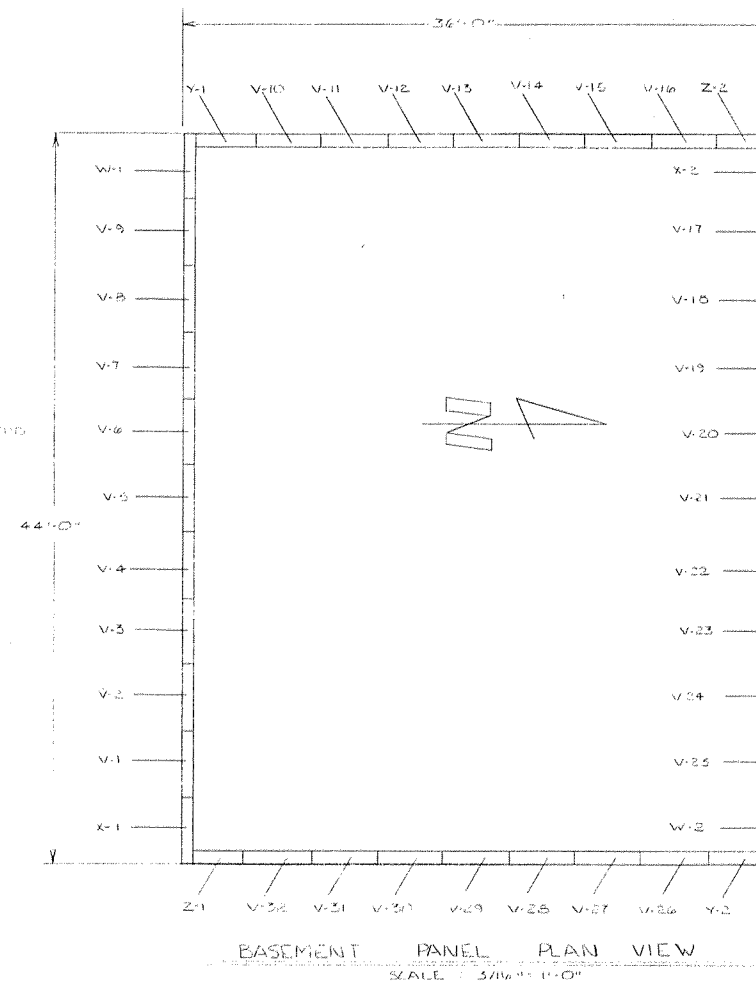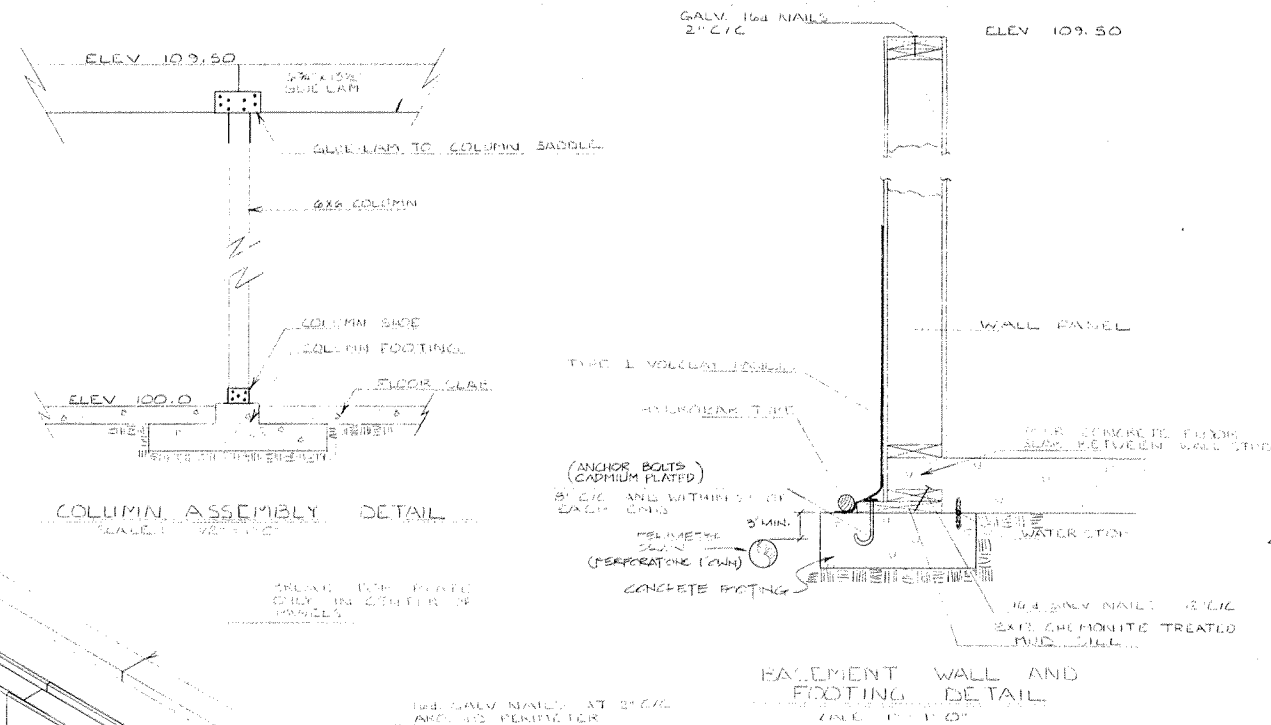

1	ASBUILT	7-15-79	Y1
NO.	REVISION	DATE	BY



Arctic Environmental Engineers
Anchorage, Alaska








PROJECT NO. TT-024-01 SAV
DESIGNED: DPW
DRAWN: DER
CHECKED: W.S.V.H.
DATE: MARCH 78
SCALE: AS NOTED

TANANA VILLAGE SAFE WATER FACILITY

BASEMENT WALL PANEL
ASSEMBLY DETAILS

S-2

SHEET 12 OF 42

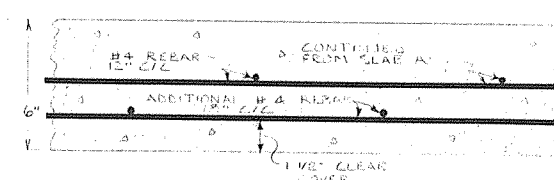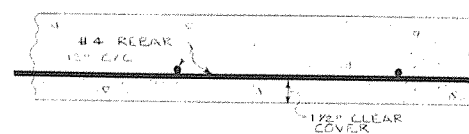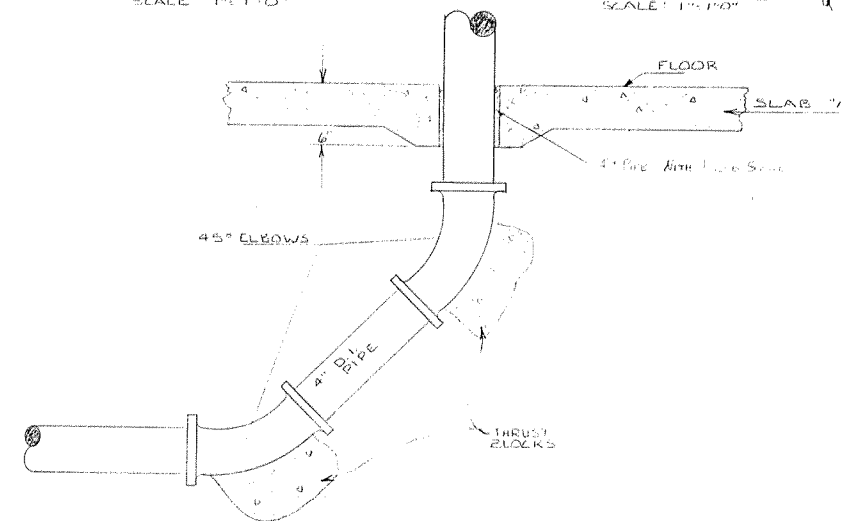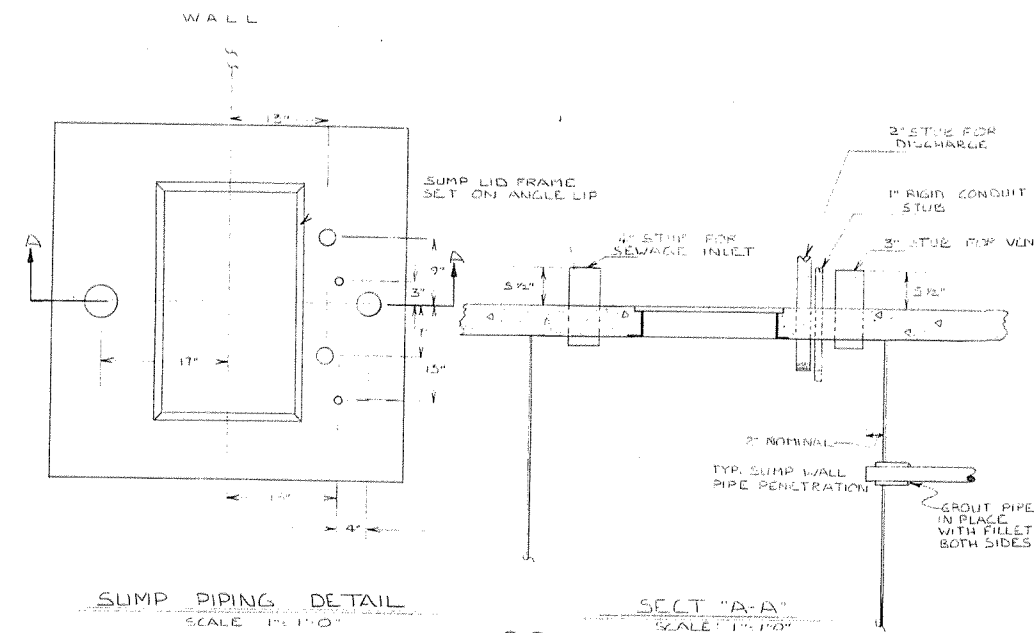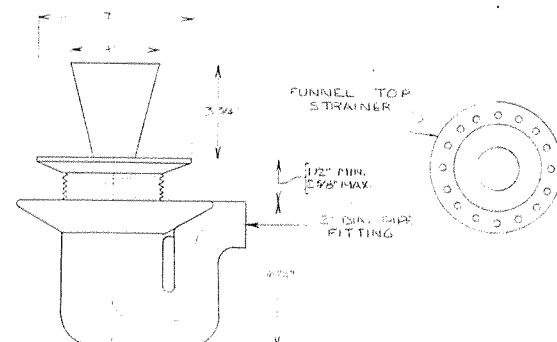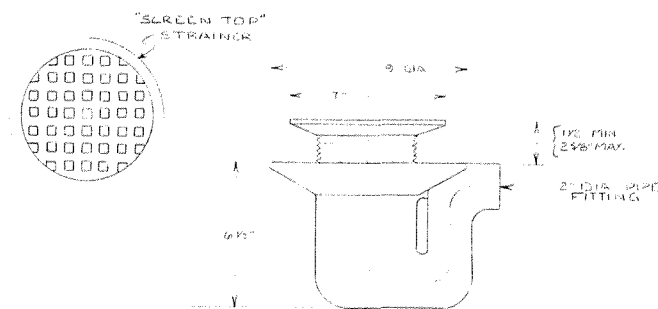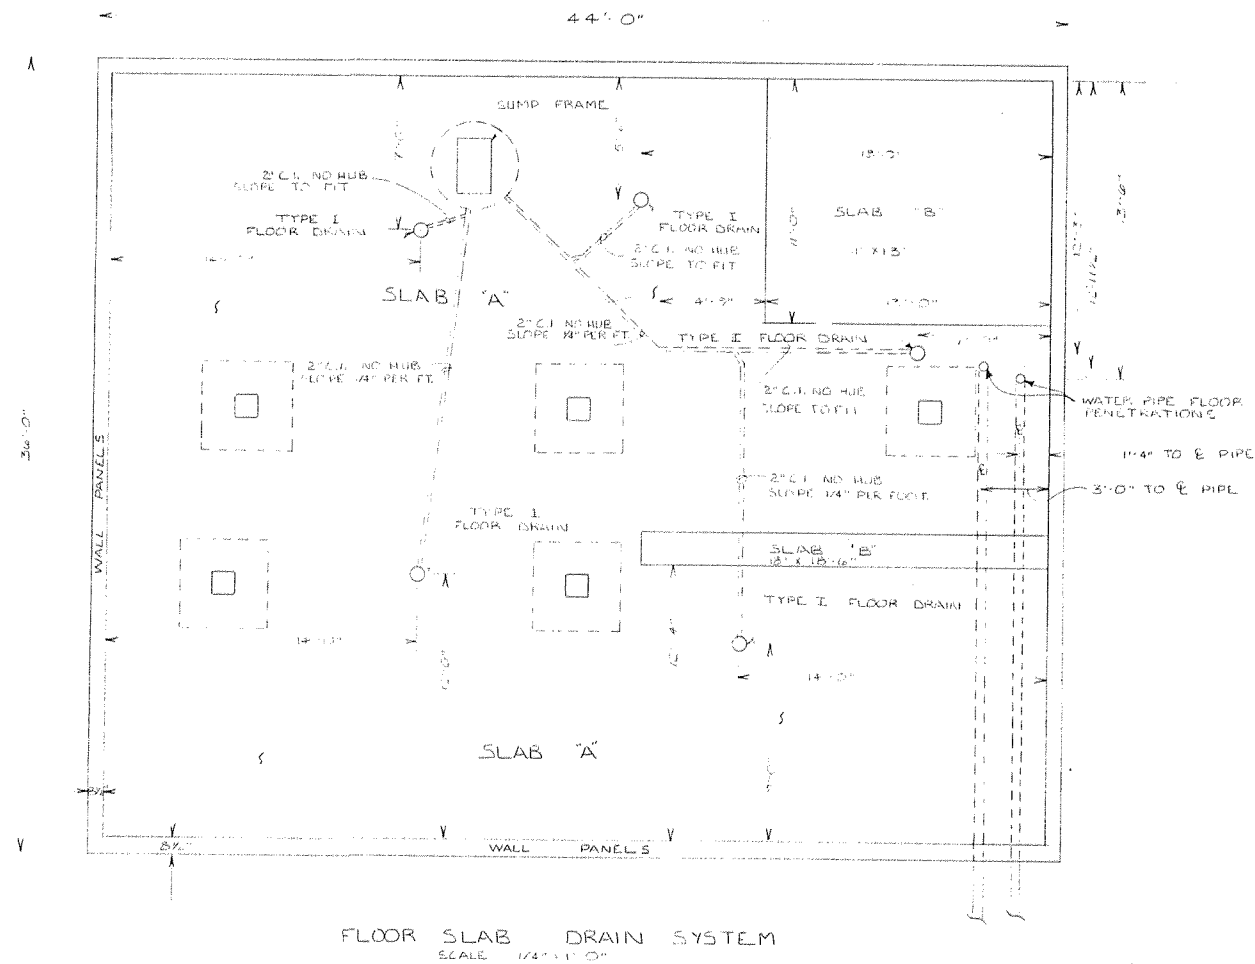

NO.	REVISION	DATE	BY
1	AS SHOWN	1-15-77	MP







Arctic Environmental Engineers
Anchorage, Alaska

PROJECT NO. 77-024-DI-SAY
DESIGNED: DEW
DRAWN: DER
CHECKED: WSVH
DATE: MARCH 1978
SCALE: AS SHOWN



TANANA VILLAGE SAFE WATER FACILITY
BASEMENT FLOOR SLAB
PLAN & DETAILS

S-3

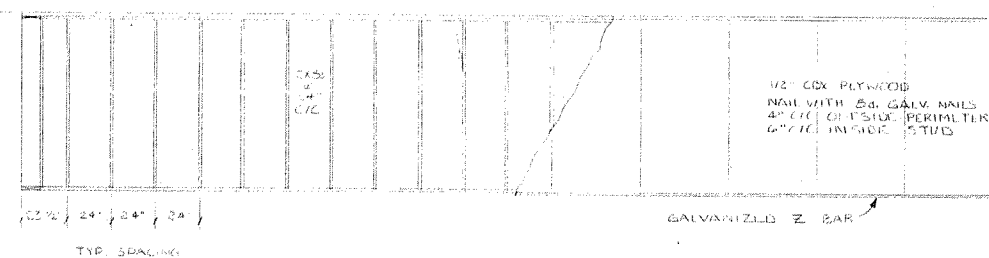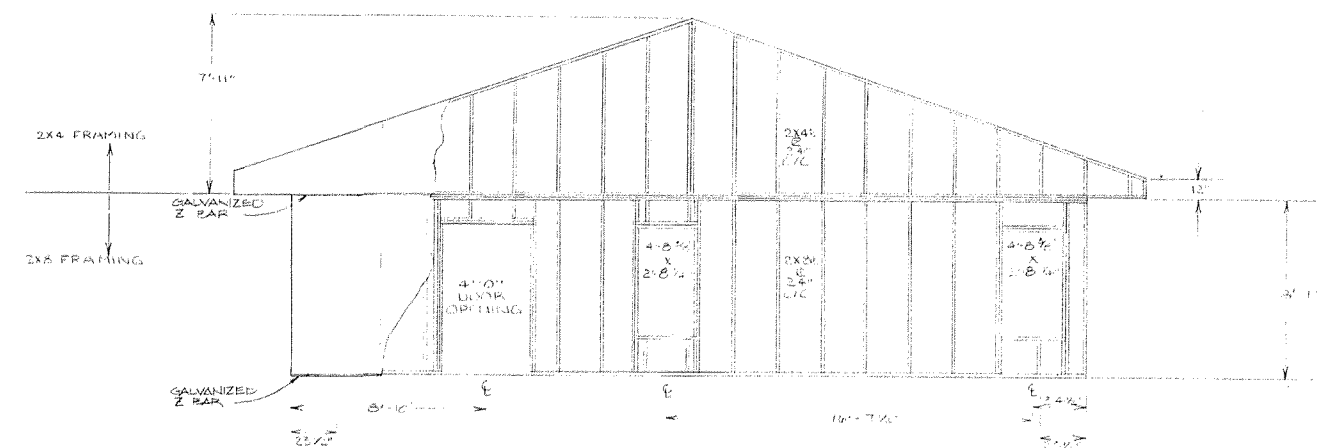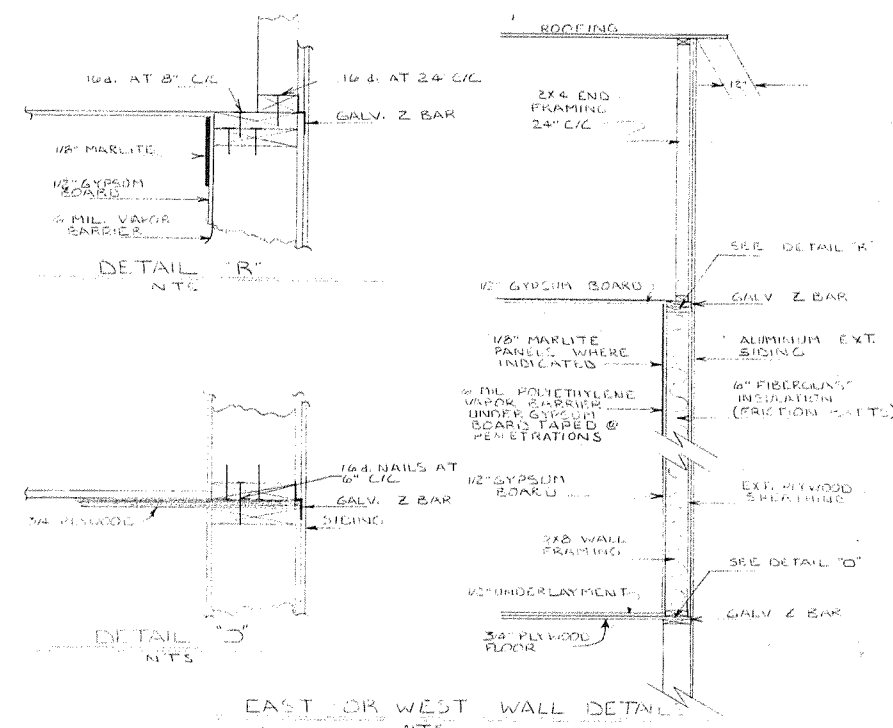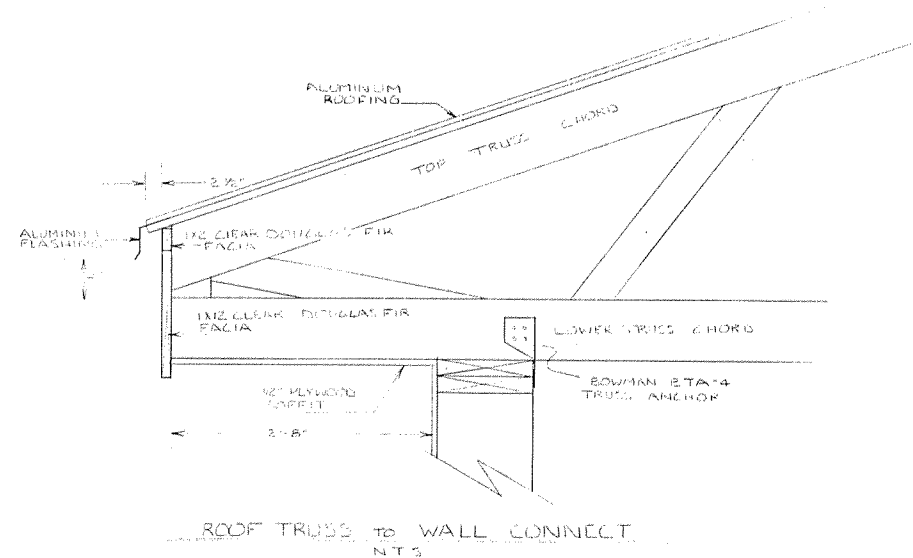



NOTE: PLACE FLOOR JOIST OVER 1/2\"/>

NORTH WALL
SCALE: 1/4\"/>

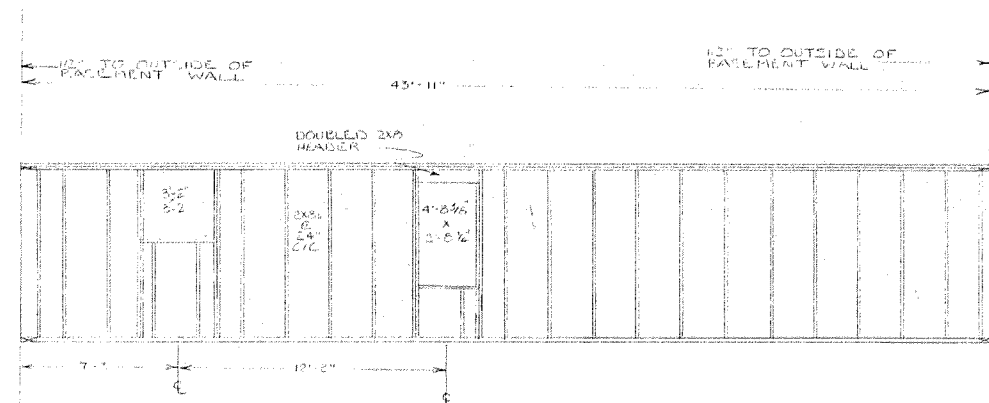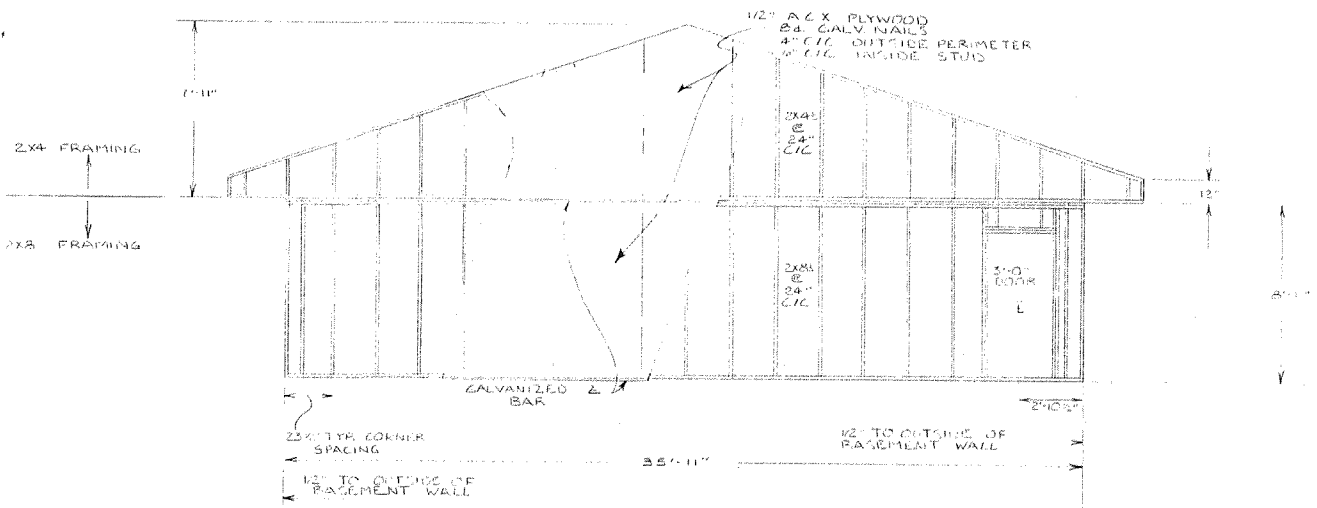

SOUTH WALL
SCALE: 1/4\"/>

NO.	REVISION	DATE	BY
1	AS SHOWN	11-15-77	HP

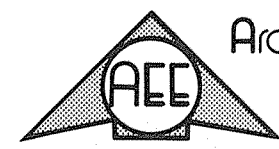
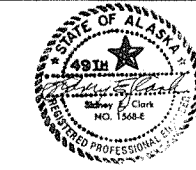


Arctic Environmental Engineers
Anchorage, Alaska

PROJECT NO. 71-074-01 SAV
DESIGNED: ISPW
DRAWN: GER
CHECKED: WSVH
DATE: MARCH 78
SCALE: AS SHOWN

TANANA VILLAGE SAFE WATER FACILITY
WALL FRAMING ELEVATIONS
AND DETAILS

S-5

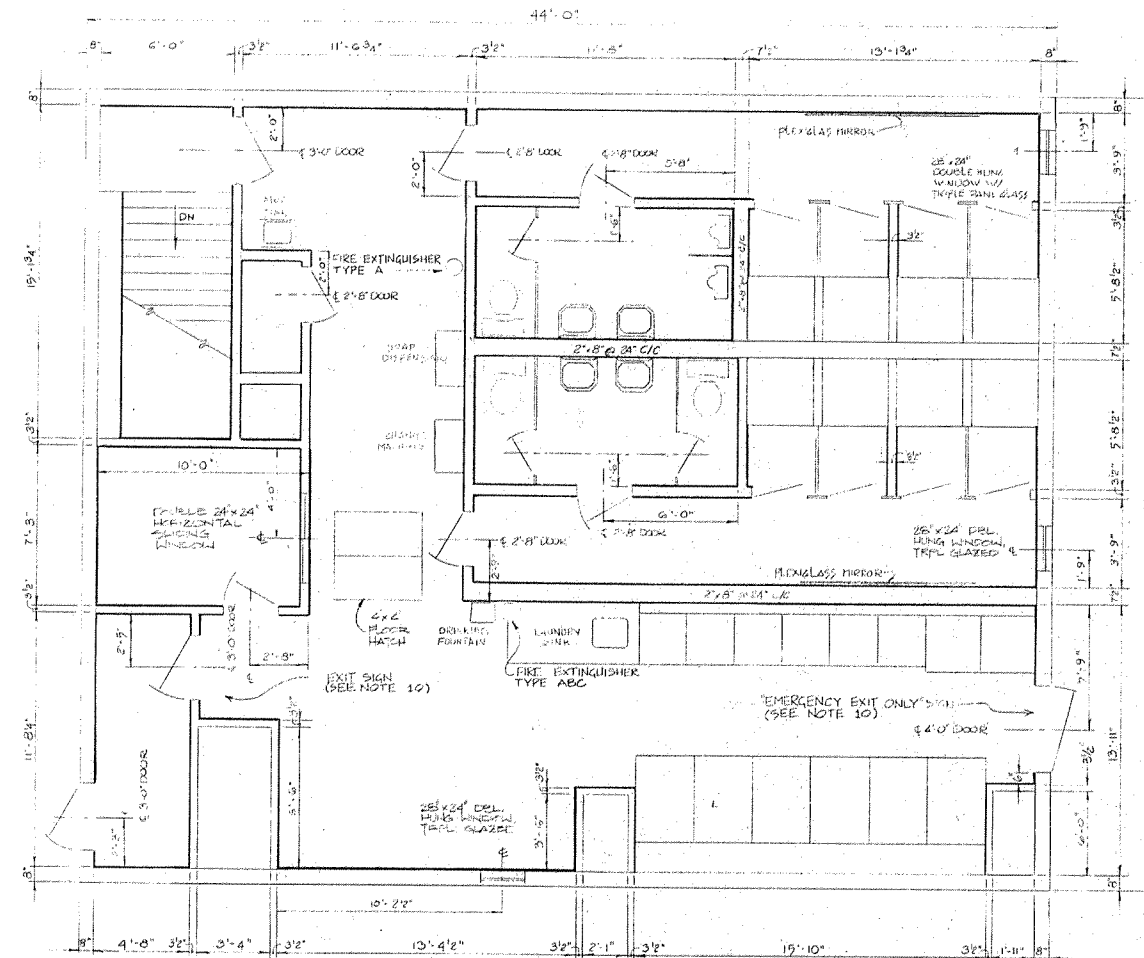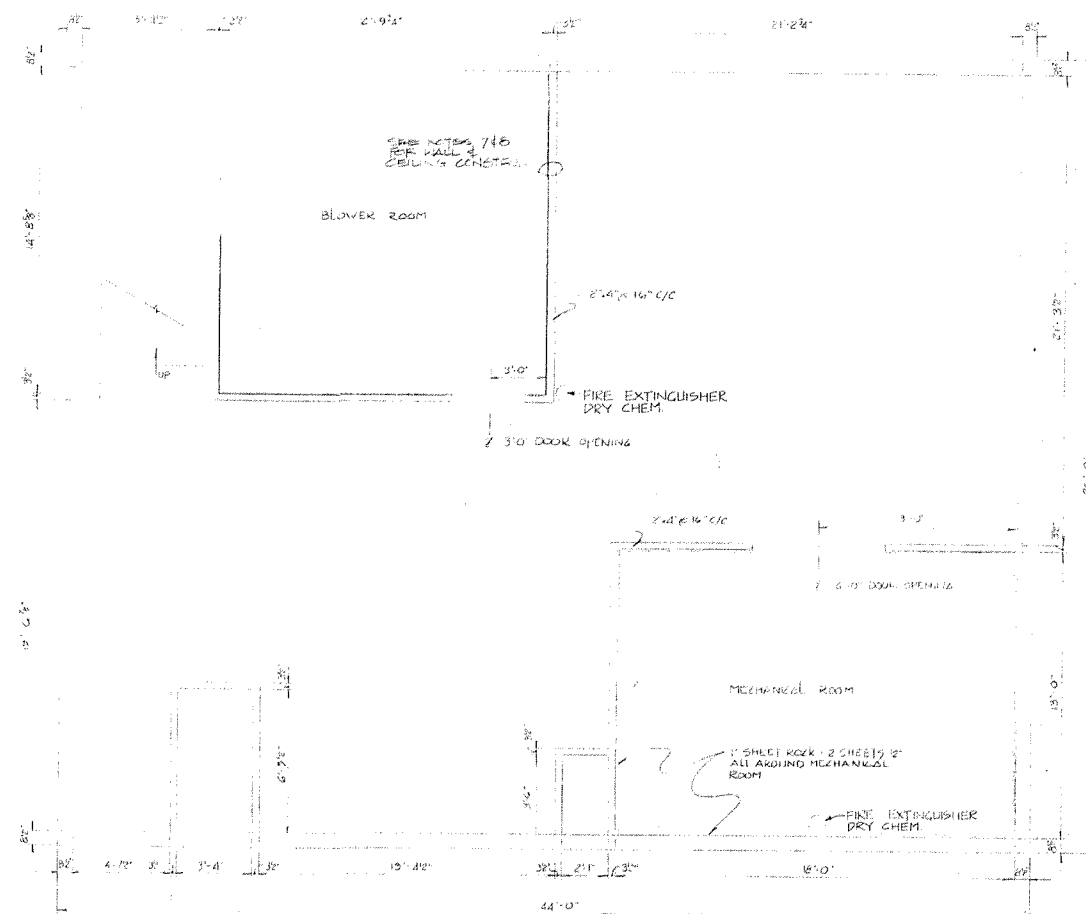

FLOOR PLAN - BASEMENT

FLOOR PLAN-MAIN FLOOR

- NOTE:
1. ALL INTERIOR WALLS FRAMED SINGLE GILL & PLATE, 2"x4"x10' C/O EXCEPT MECHANICAL ROOM BEARING WALL & AS NOTED (SEE FLOOR FRAMING PLAN FOR MECHANICAL ROOM BEARING WALL DETAILS).
2. ALL WALLS 1/2" GYPSUM BOARD.
3. HEAVY LINE INDICATES 8" MARLITE APPLIED OVER GYPSUM BOARD.
4. MECHANICAL ROOM CEILING WALLS 2 LAYERS 1/2" GYPSUM BOARD.
5. FIRST FLOOR RECEIVED 1/2" PRESS BOARD UNDER LAYMENT & LINOLEUM TILE (NO WAS SOLARUM).
6. INTERIOR DIMENSIONS FROM PLATE TO PLATE OUTSIDE DIMENSION LINE INDICATES OUTSIDE OF BASEMENT PANELS.
7. BLOWER RM. CEILING 2 LAYERS 1/2" GYPSUM BOARD CEILING TO REGIMENT FURNING CHANNEL SUFFICIENT @ 16" C/O. USE 6" INSULATION ABOVE FURNING CHANNEL.
8. BLOWER RM. WALLS - NOTE 1 LAYER 1 - 1/2" GYPSUM BOARD UNDER ON REGIMENT FURNING CHANNELS @ 24" C/O. OUTSIDE 1 LAYER 1/4" GYPSUM BOARD CEILING BOARD & 1 LAYER 1/2" GYPSUM BOARD.
9. FIRE EXTINGUISHERS AS SHOWN
10. "EXIT" SIGN - SETON 745M. "EMERGENCY EXIT ONLY" - SETON 762



Arctic Environmental Engineers
Anchorage, Alaska

PROJECT NO. 77-024 01 SAV
DESIGNED : DPW
DRAWN : PEZ
CHECKED : WGVH
DATE : MARCH '78
SCALE : 1/4"=1'-0"

TANANA V.S.W. FACILITY
FLOOR LAYOUT & WALL PLACEMENT

SHEET 16 OF 42

**ALASKA VILLAGE SAFE
WATER PROJECT**

TANANA HOSPITAL SEWER LINE



**AS-BUILT
7/15/79**




Arctic Environmental Engineers
Anchorage, Alaska

LEGEND
--- FORCE MAIN
--- GRAVITY SEWER

Original force main abandoned on Oct 1984
Stations 7+25 to 8+50 of gravity flow line
back westward from where new line connect could
still be being used to provide sewage hookups for
mobile homes on north side of the street

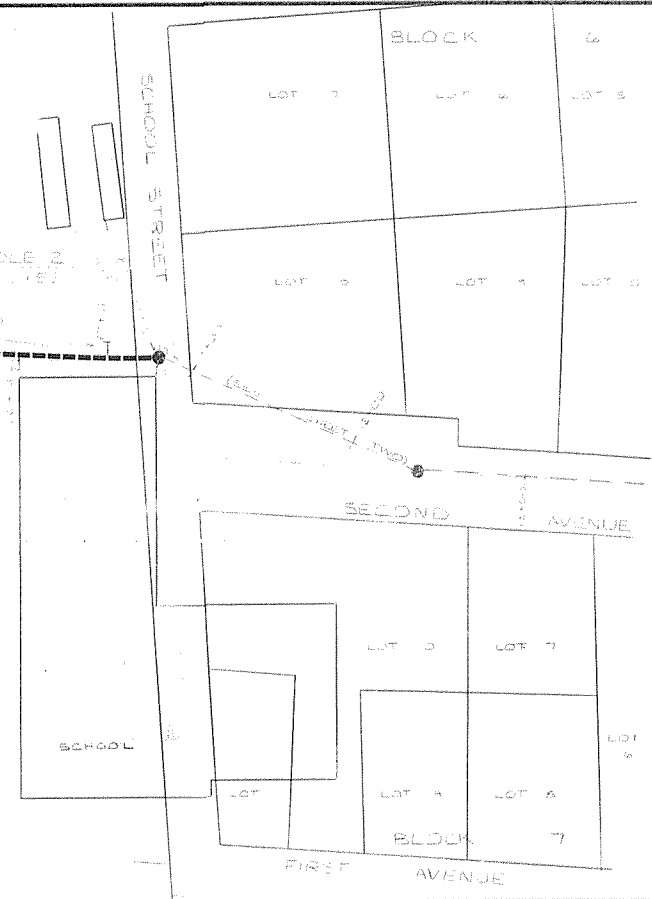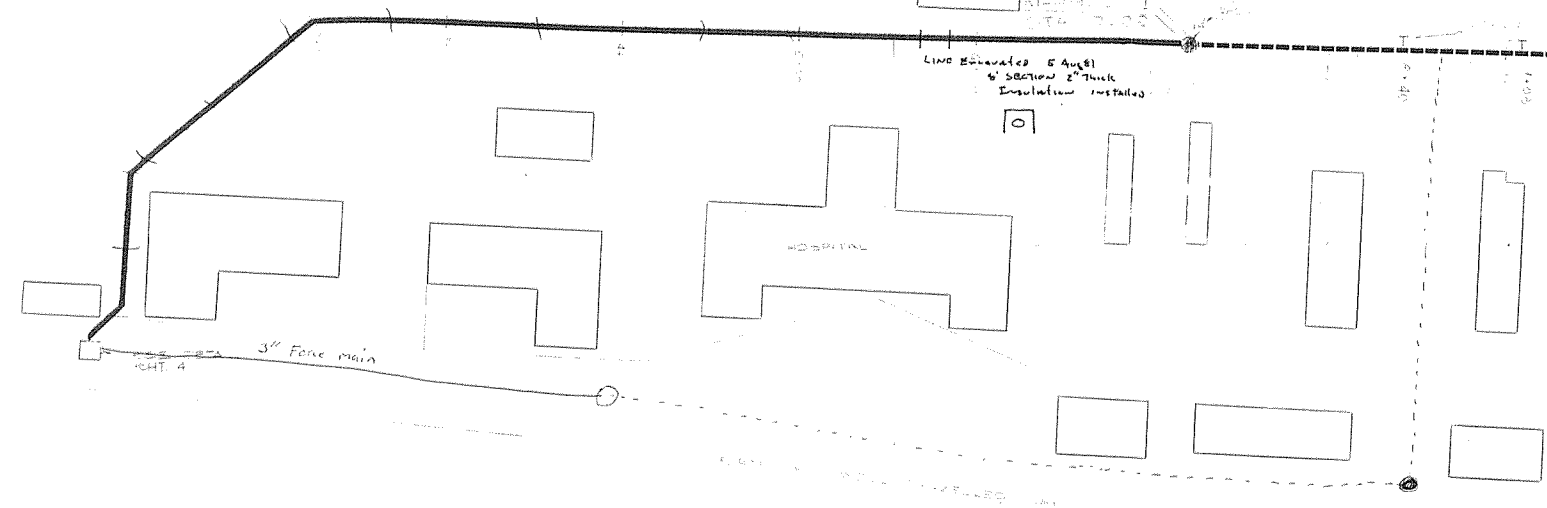

EXISTING
DUMP STATION
STA. 0+25
45' BELOW
45' BELOW
E STA. 0+00

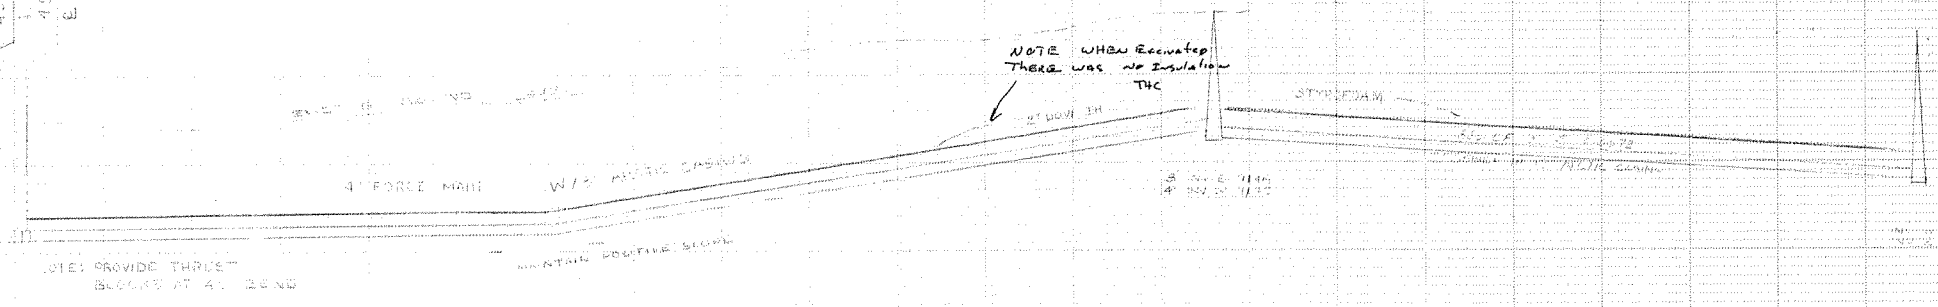

FIELD BOOKS	TBM NO.	LOCATION	ELEV.	DATA	CK'D BY	DATA	CK'D BY	REV.	DATE	DESCRIPTION	BY
DESIGN				BASE		TELE.		1	8-9-78	Change M.H. Invert	W.S.H.
STAKING				TOPO.		ELEG.		2	10-2-78	As-built	W.S.H.
ASBUILT				PROFILE		DESIGN					
				SAN SEWER		QUANTITIES					
				STORM DR.		PRELIM. CHECK					
CONTRACTOR				WATER		FINAL CHECK					
INSPECTOR				GAS		EARTHWORK					
				OTHER FACILITIES							
CONSTRUCTION RECORD		VERTICAL DATUM		PLAN CHECK		REVISIONS					



Arctic Environmental Engineers, Anchorage, Alaska.


TWN-NA V&V HOSPITAL SEWER SYSTEM

SCALE HOR. 1"=50' VER. 1"=5'

DRAWN BY: W.S.H. DESIGNED BY: W.S.H.

DATE: 7 FEBRUARY 1978 PROJECT NO: 77-004-0200

FILE NO: 4E-1 SHEET 1 OF 1

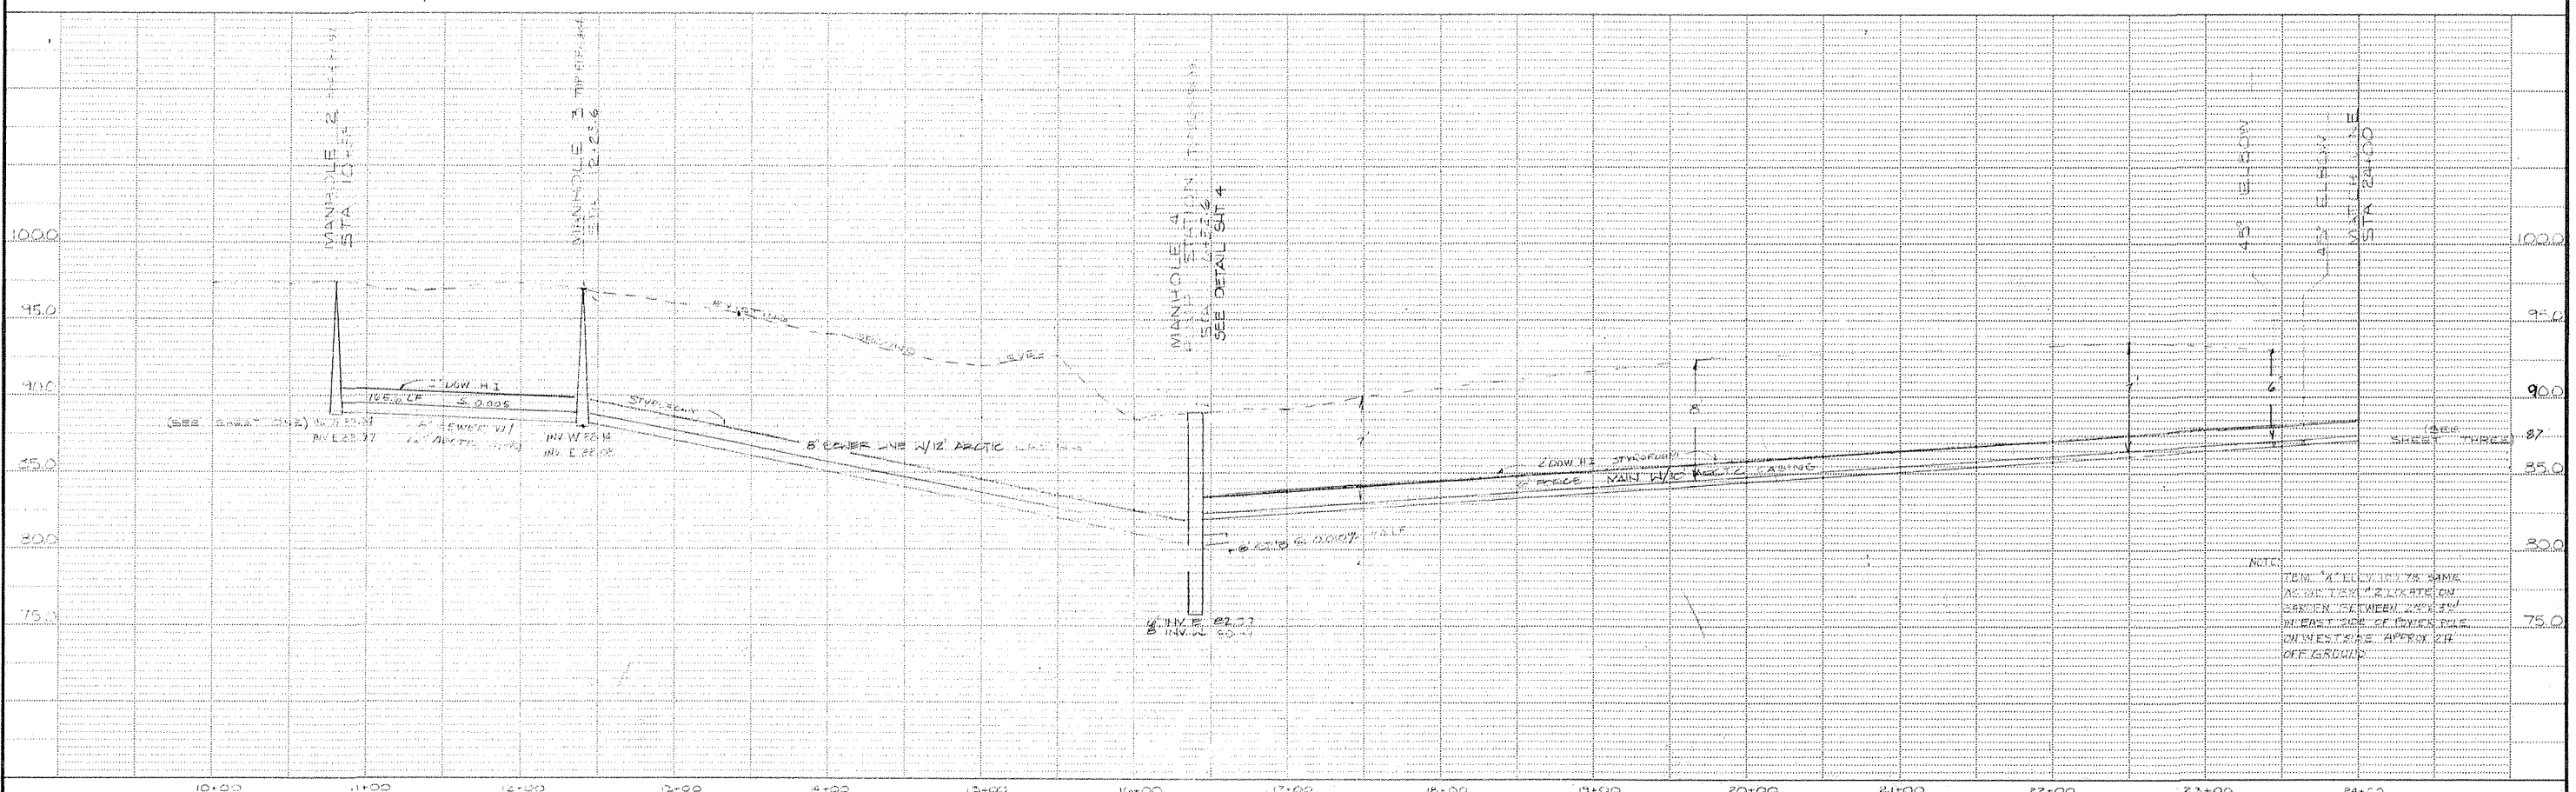

FIELD BOOKS	TBM NO.	LOCATION	ELEV.	DATA	CK'D BY	DATA	CK'D BY	REV.	DATE	DESCRIPTION	BY
DESIGN				BASE		TELE.					
STAKING				TOPO.		ELEC.					
ASBUILT				PROFILE		DESIGN					
				SAN. SEWER		QUANTITIES					
				STORM DR.		PRELIM. CHECK					
				WATER		FINAL CHECK					
				GAS		EARTHWORK					
CONTRACTOR	BASIS OF THIS DATUM			OTHER FACILITIES							
INSPECTOR											
CONSTRUCTION RECORD											
VERTICAL DATUM											
PLAN CHECK											
REVISIONS											

Arctic Environmental Engineers, Anchorage, Alaska.

TANANA VSW HOSPITAL SEWER SYSTEM

SCALE: HOR. 1"=50' VER. 1"=5'

DRAWN BY: DCS



DESIGNED BY: WSVH

DATE: 7 FEBRUARY 1978


PROJECT NO. 77-024-0128N

FILE NO. HS-2

SHEET 2 OF 7

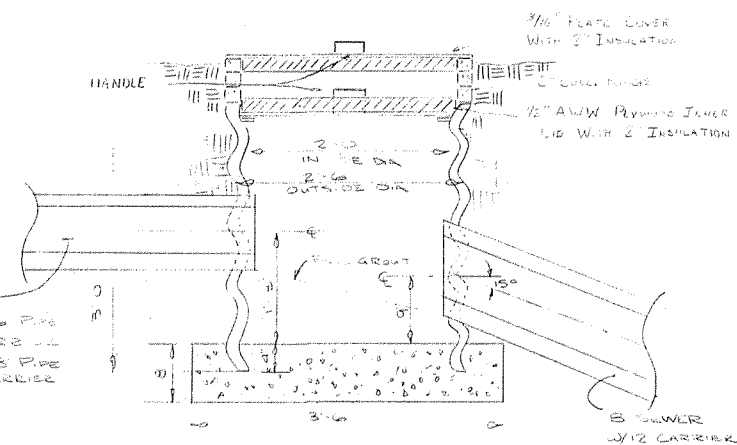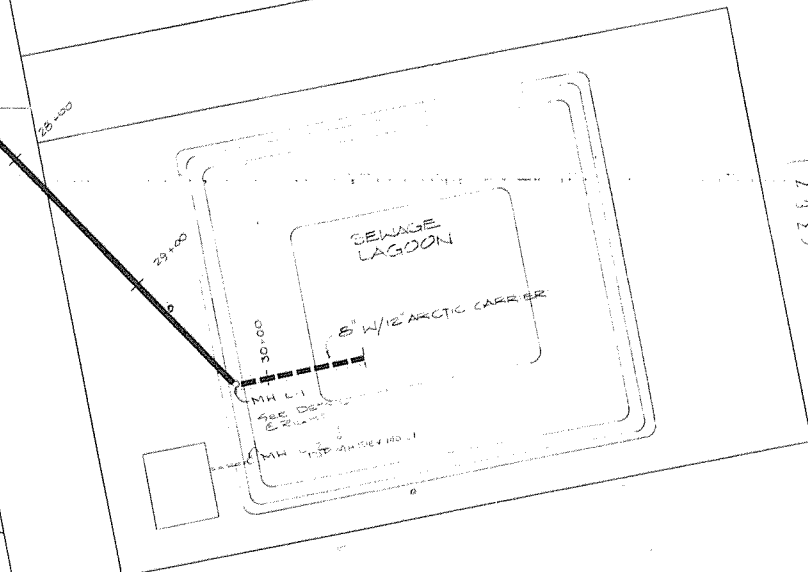

LAGOON MH DETAIL
SCALE 1"=1'-0"

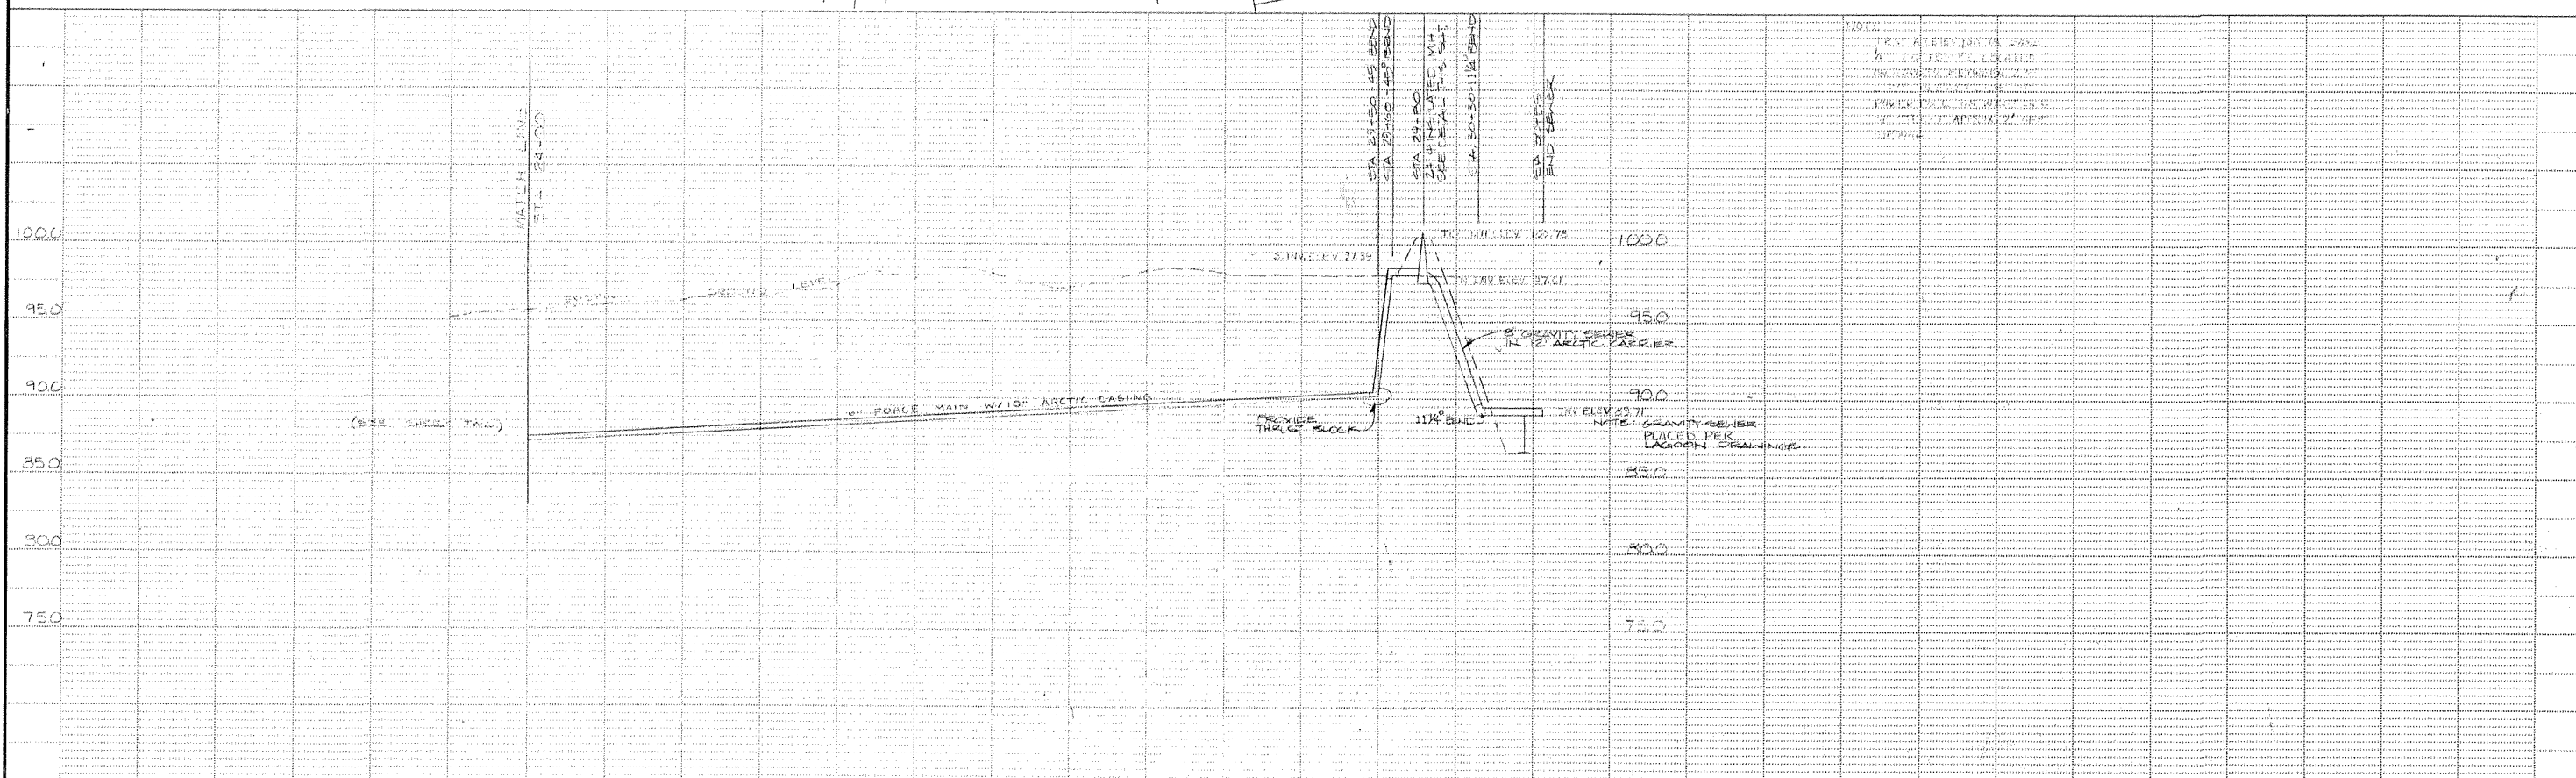

FIELD BOOKS	TBM NO.	LOCATION	ELEV.	DATA	CK'D BY	DATA	CK'D BY	REV.	DATE	DESCRIPTION	BY
DESIGN				BASE		TELE.					
STAKING				TOPO.		ELEC.					
ASBUILT				PROFILE		DESIGN					
				SAN. SEWER		QUANTITIES					
				STORM DR.		PRELIM. CHECK					
				WATER		FINAL CHECK					
				GAS		EARTHWORK					
				OTHER FACILITIES							
CONTRACTOR	BASIS OF THIS DATUM										
INSPECTOR											
CONSTRUCTION RECORD	VERTICAL DATUM			PLAN CHECK			REVISIONS				

STATE OF ALASKA
49TH
Willen Van Hamert
No. CE 4500
REGISTERED PROFESSIONAL ENGINEER

Arctic Environmental Engineers, Anchorage, Alaska.

TANANA VSW HOSPITAL SEWER SYSTEM


SHT HS-3

SCALE HOR. 1"=50'
VER. 1"=5'


DRAWN BY DCS
DESIGNED BY WSVH

DATE 7 FEBRUARY 1978
PROJECT NO 77-024-01


FILE NO. HS-3
SHEET 3 OF 7

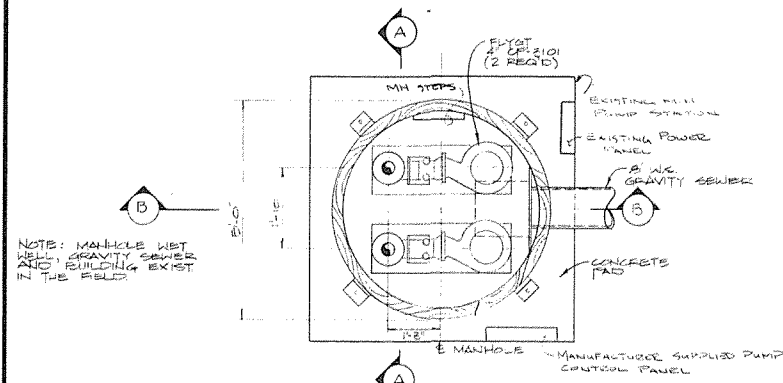


LOWER LEVEL PLAN VIEW
SCALE: 1/2"=1'-0"

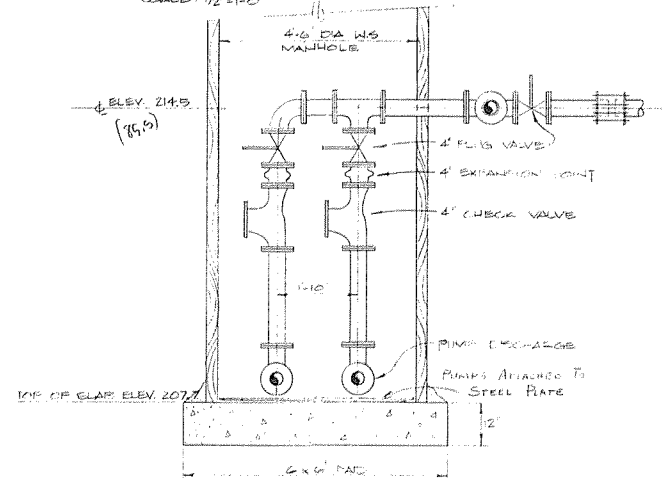


SECTION A-A
SCALE: 1/2"=1'-0"

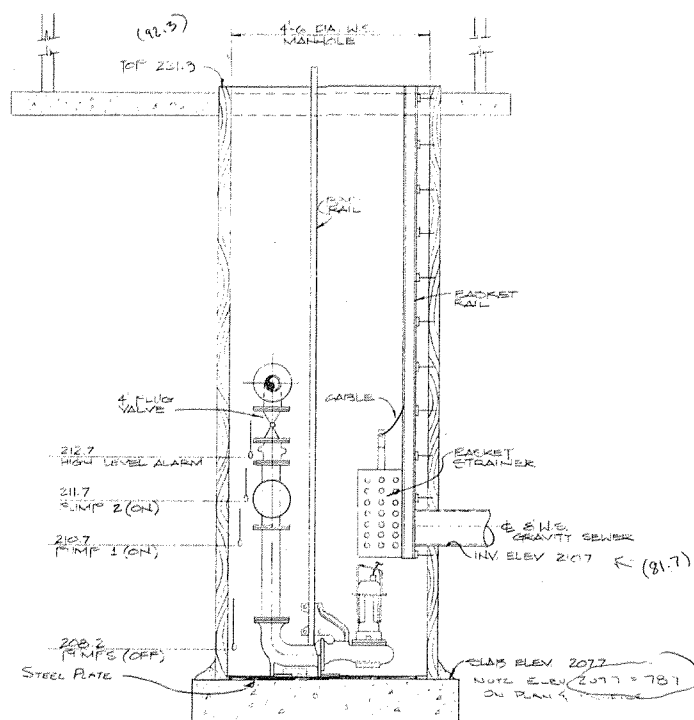


SECTION B-B
SCALE: 1/2"=1'-0"

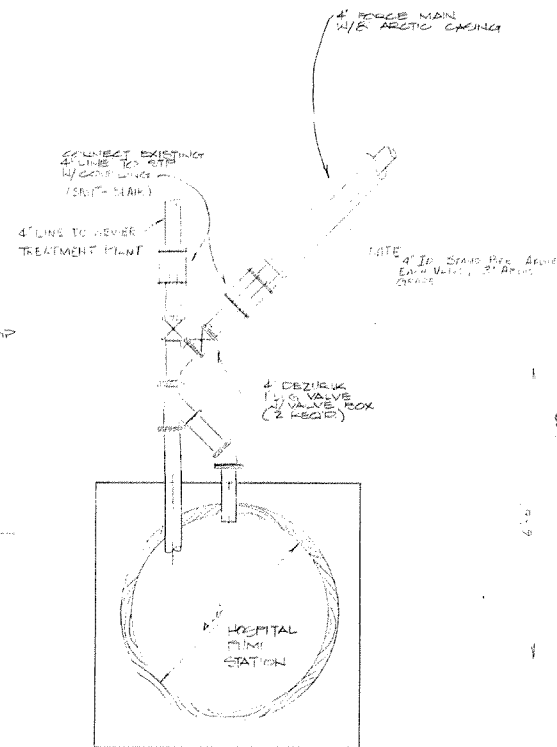


BY-PASS PIPING DETAIL
SCALE: 1/2"=1'-0"

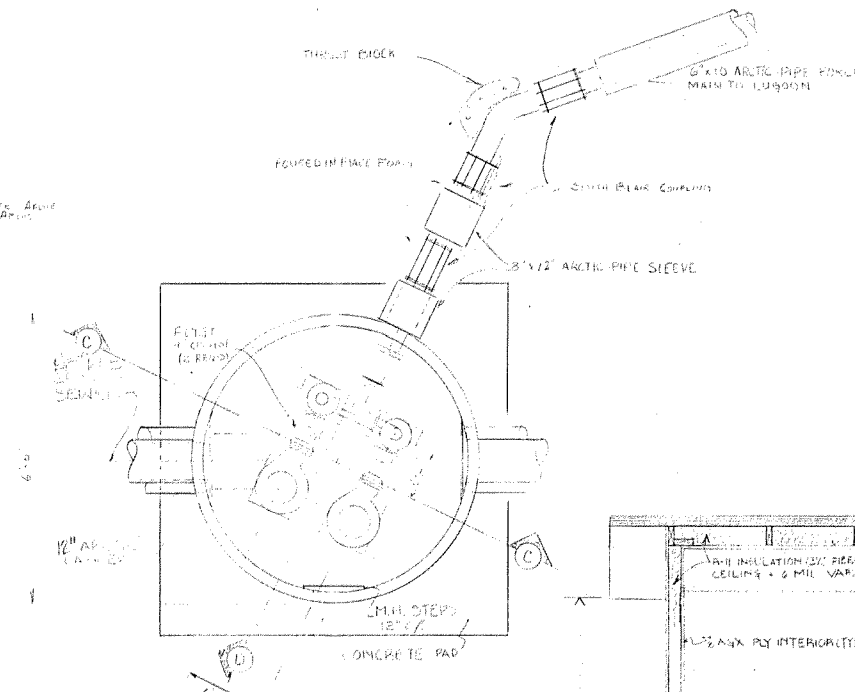

PUMP STATION NO. 2 - PLAN
SCALE: 1/2"=1'-0"

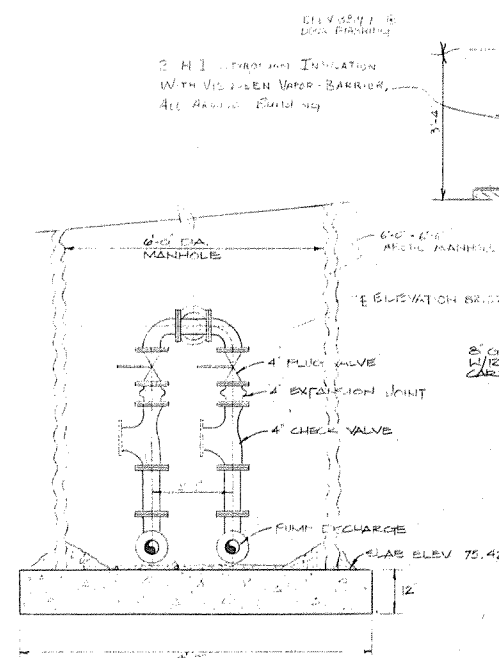

SECTION C-C
SCALE: 1/2"=1'-0"

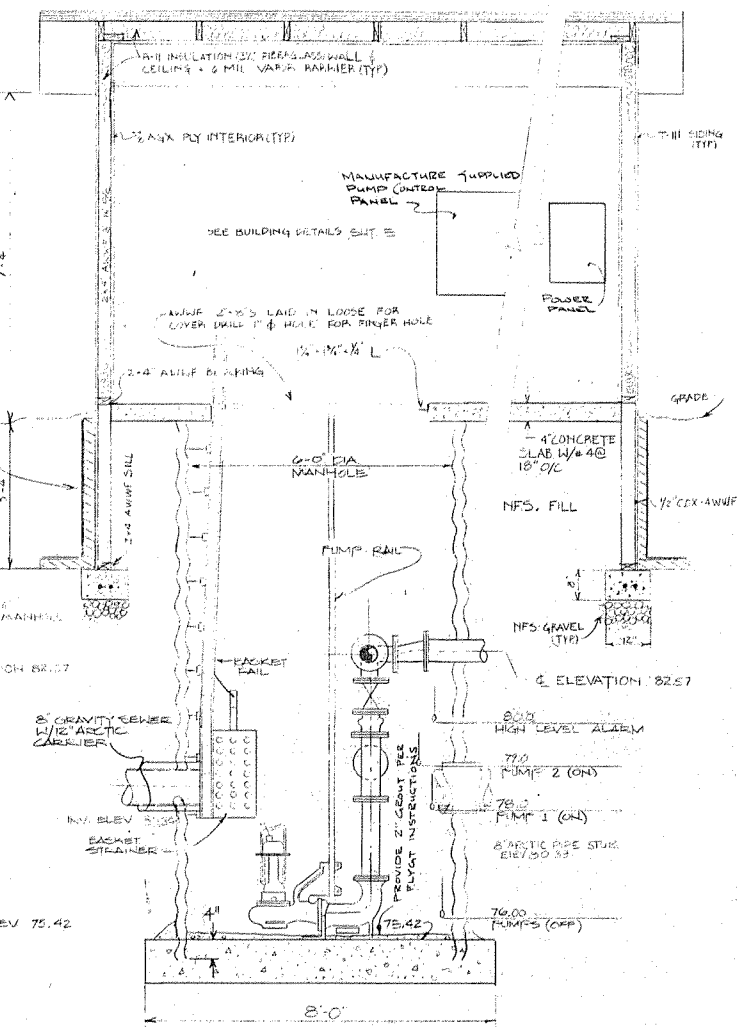

SECTION D-D
SCALE: 1/2"=1'-0"

2	AS BUILT	7-15-78
1	ADD CROUT	8-9-78
NO.	REVISION	DATE BY



Arctic Environmental Engineers
Anchorage, Alaska





PROJECT NO. 77-024-01
DESIGNED: WSVH
DRAWN: LDM
CHECKED: WSVH
DATE: 7-5-78
SCALE: AS NOTED

PUMP STATION DETAILS


TANANA VIEW HOSPITAL SEWER SYSTEM

PS. 1

SHEET 4 OF 7

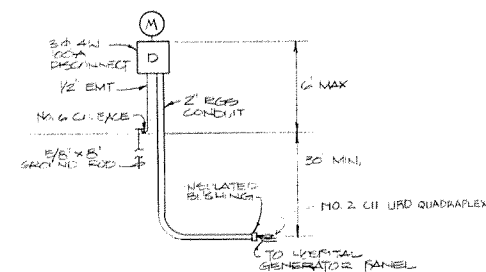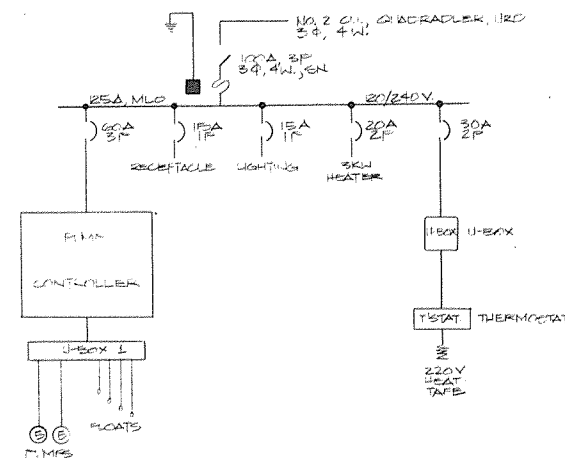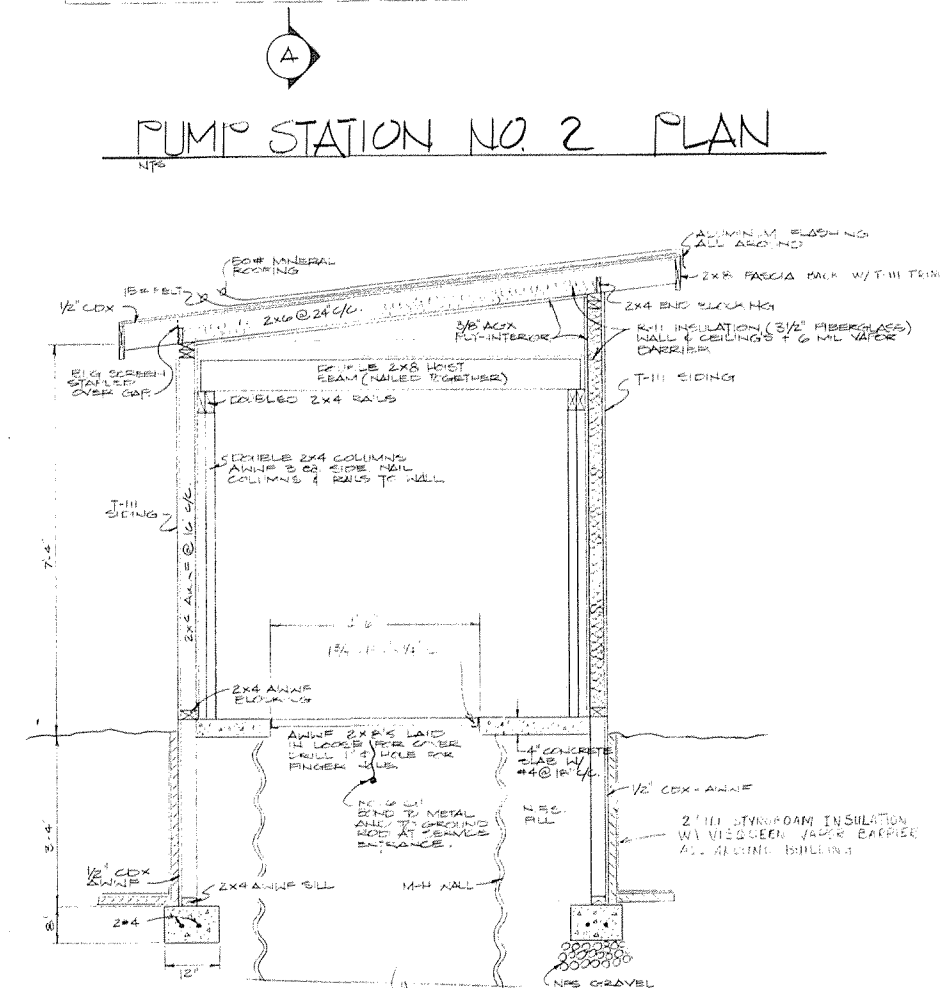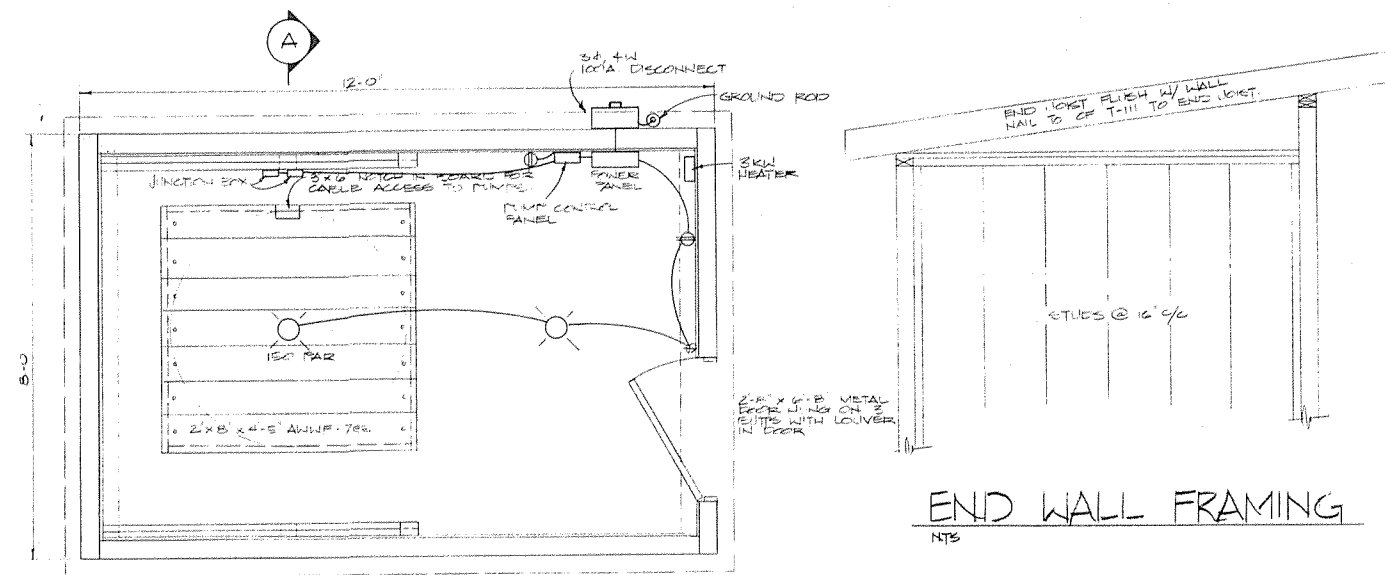

1 As Built		7-15-79 MP	
NO.	REVISION	DATE	BY

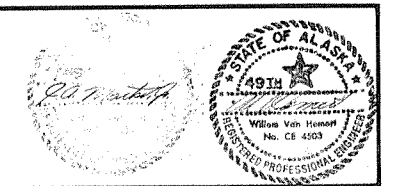

Arctic Environmental Engineers
Anchorage, Alaska




PROJECT NO.
DESIGNED :
DRAWN : J.D.M.
CHECKED :
DATE : 7/24/76
SCALE : AS NOTED

PUMP HOUSE
ELECTRICAL


TANANA VSW HOSPITAL SEWER SYSTEM

PS-2


SHEET 5 OF 7

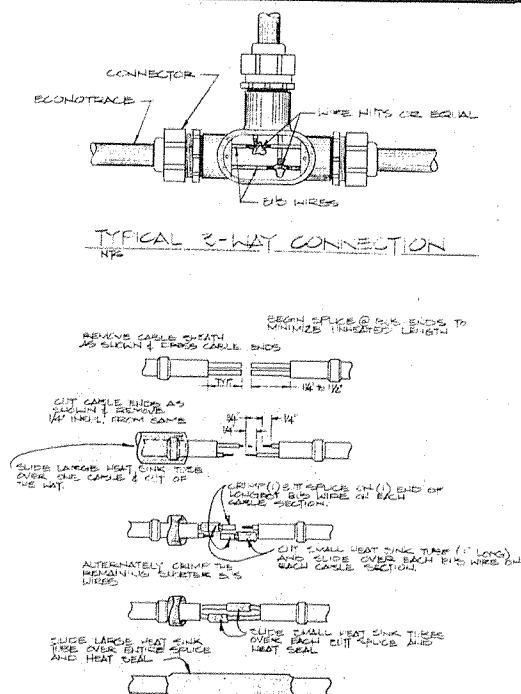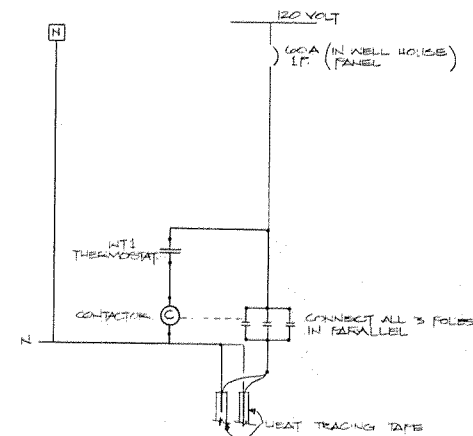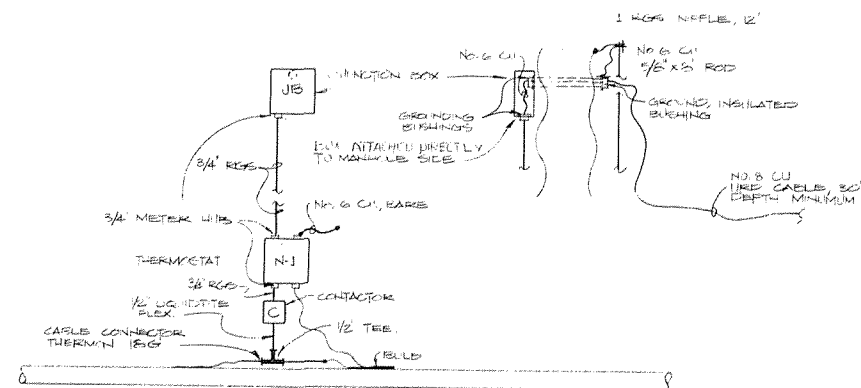


- LEGEND
- ① THERMOCHUCK™ NEMA 4
TUESMON N-1: No. 4-350250
- ② CONTACTOR, 3 POLE, 30A, NEMA 4X
SQD SWIN-22
- JB □ JUNCTION BOX, DVC, NEMA 4
CARLON E 987R
- ⊥ GROUND ROD, 5/8" x 8'
- ③ METER

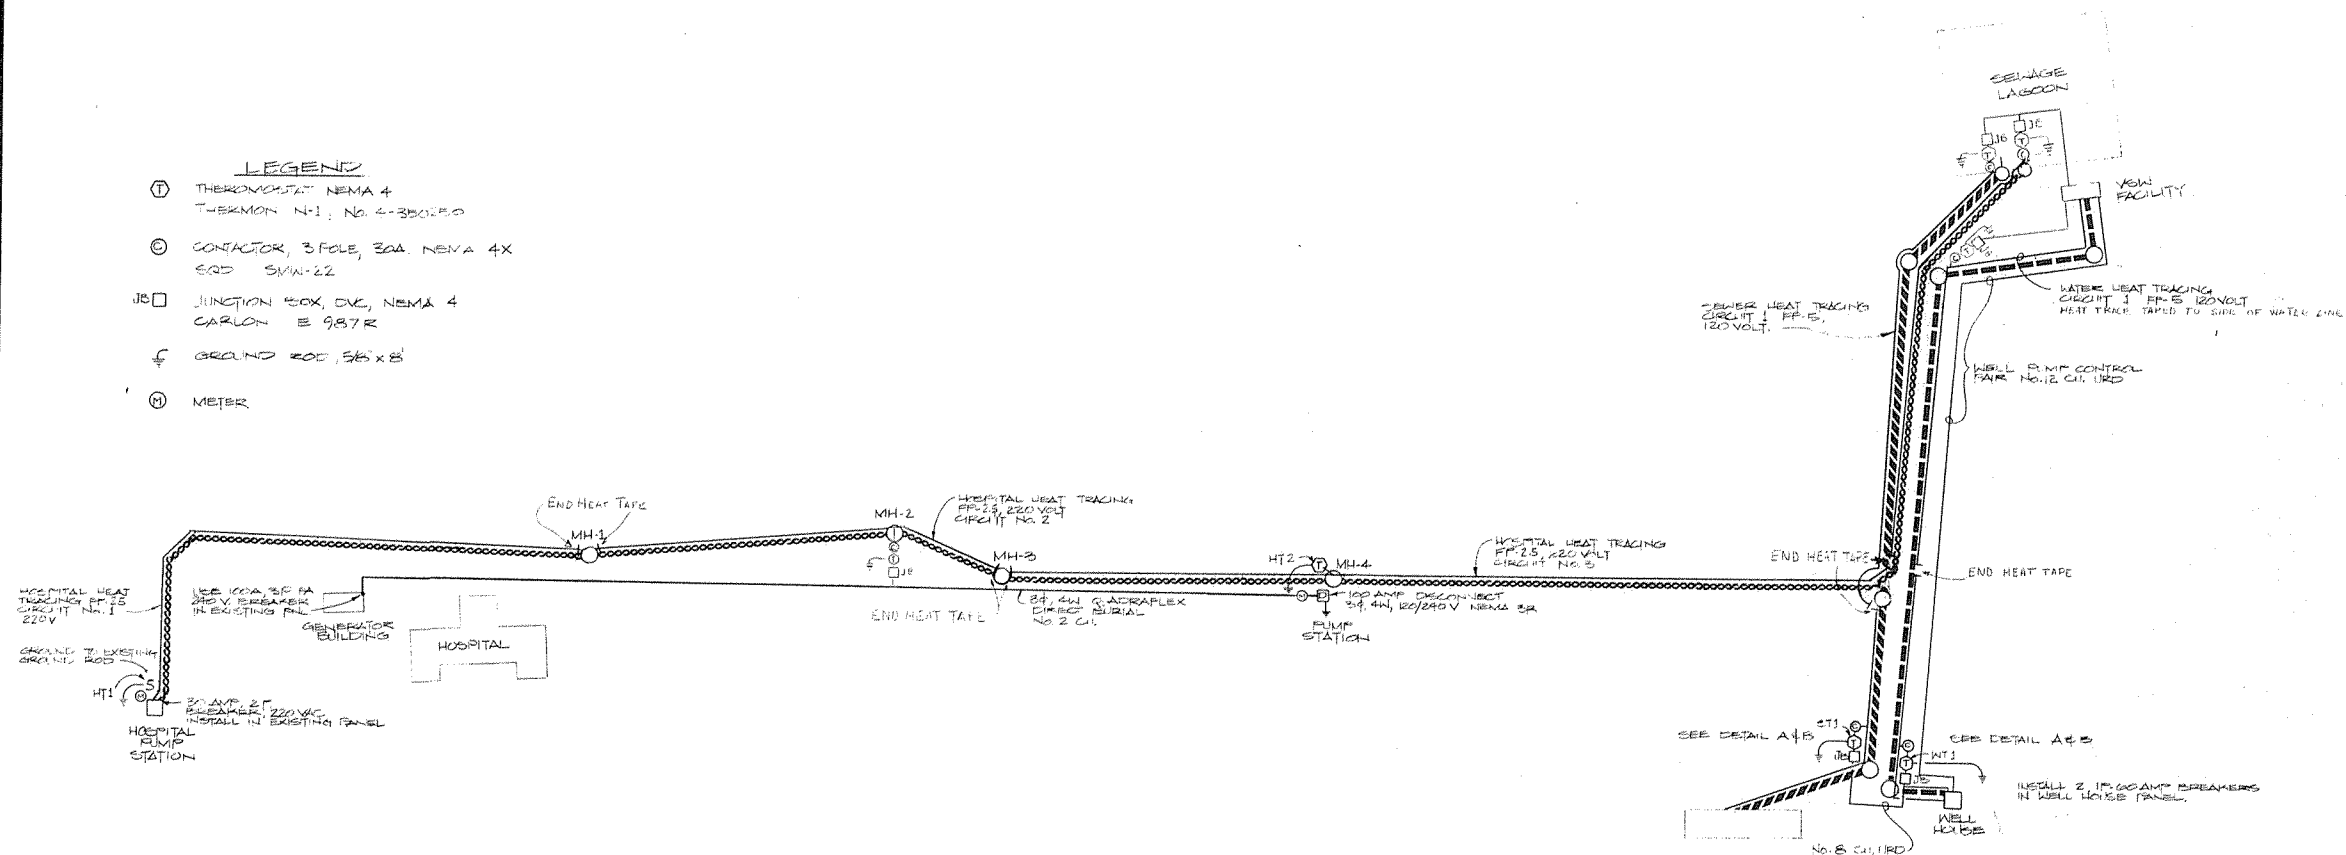


1		ASSEMBLY		7-15-79 MP	
NO.	REVISION			DATE	BY

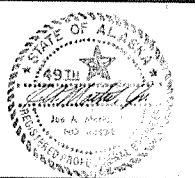


ALL MATERIAL TO BE ALUMINUM TYPE 6061, 5083, OR 5052

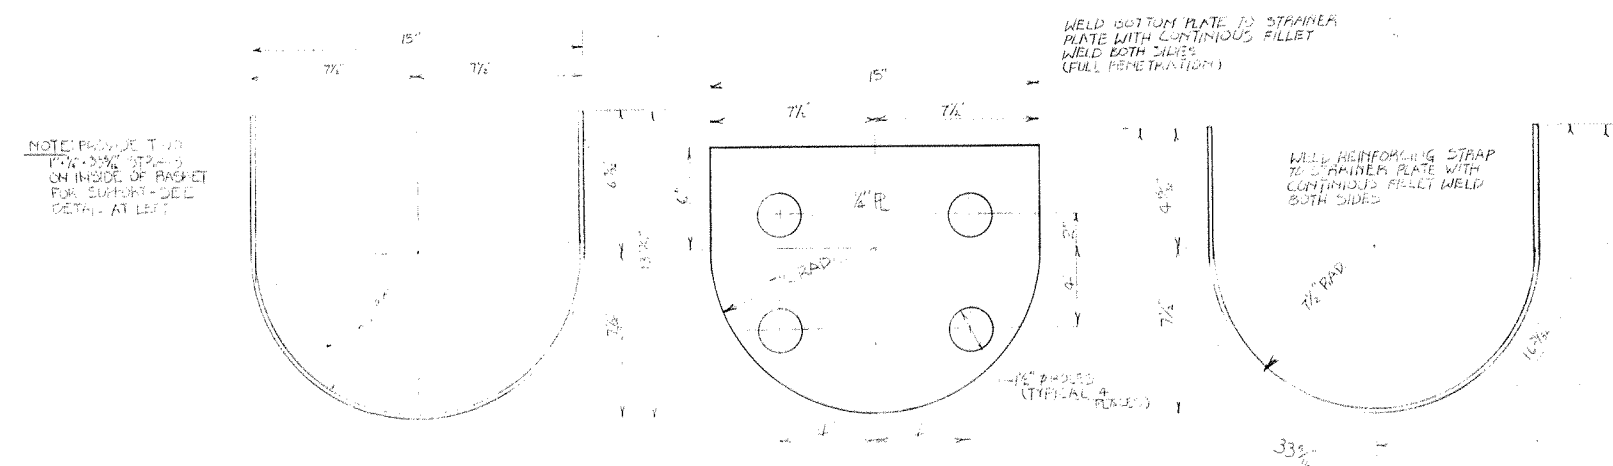


BOTTOM PLATE DETAIL

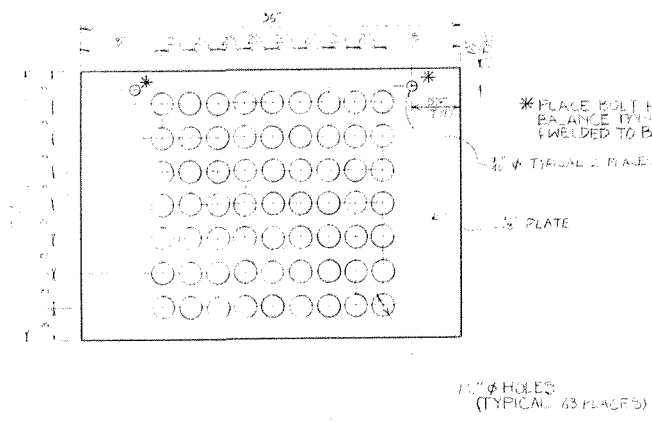


STRAINER PLATE DETAIL

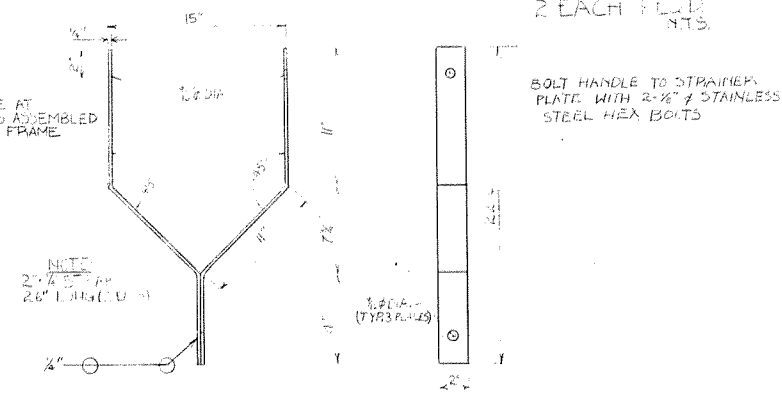

HANDLE DETAIL

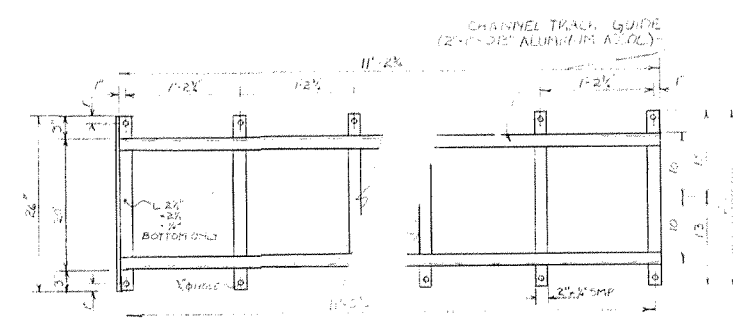

RAIL DETAIL

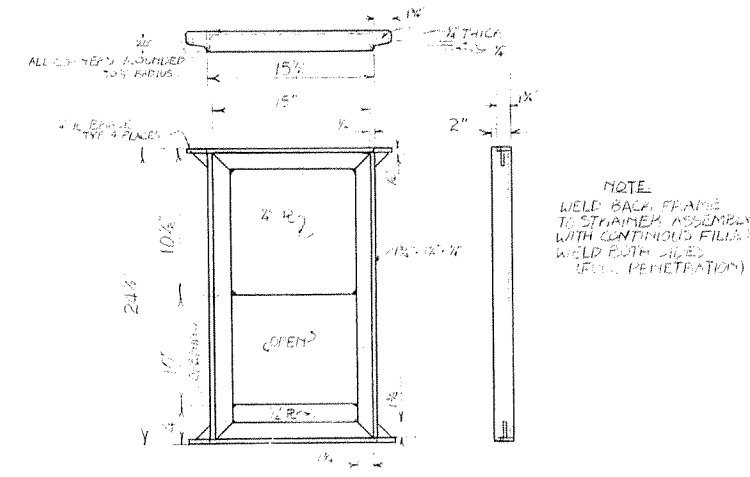


BACK FRAME DETAIL

THE ENTIRE ASSEMBLY SHALL BE COATED (AS SEPARATE PIECES) WITH THE FOLLOWING COATING SYSTEM:

- CLEAN ALL SURFACES WITH SOLVENT
- PAINTED BY COMPLETE STEAM CLEANING
- DRY IN A DUST-FREE AREA
- PRIME CLEANED SURFACE USING ONE OF THE FOLLOWING:
 - A) TNE MEC-THEME-GRIP 03 DRY MILS
 - B) TNE MEC-321210 VINOLINE W-P 03 DRY MILS
- STOP COATED WITHIN TWENTY-FOUR HOURS WITH ONE OF THE FOLLOWING:
 - A) TNE MEC-413 TNEME TAR 16 DRY MILS (2 COATS 8 DRY MILS/COAT)
 - B) UNITED-ELASTUFF 504 OR 701 16 DRY MILS (ONE COAT)


FIELD INSTALLATION

- ON WOOD STAVE MANHOLE SHIM EACH RAIL AS REQUIRED AND FASTENED WITH 3/8" x 3" GALVANIZED LAG BOLTS
- ON CMP MANHOLE PROVIDE 1/2" GALVANIZED PIPE AND CUT TO FIT TO PROVIDE UNIFORM SHIM ON RAILS - USE 3/8" x 6" GALVANIZED BOLTS WITH NUTS AND WASHERS

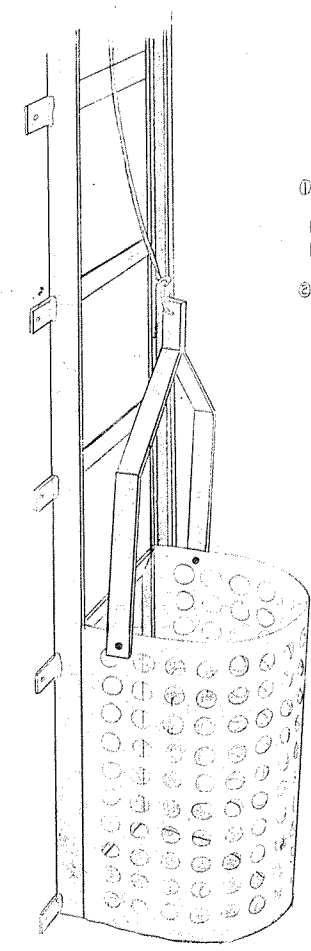

PERSPECTIVE

NO.	REVISION	DATE	BY
-----	----------	------	----

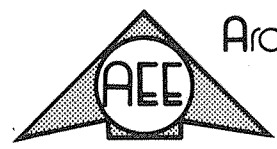


Arctic Environmental Engineers
Anchorage, Alaska

PROJECT NO. 77-024-03
DESIGNED : WSVH
DRAWN : B.L.
CHECKED : WSVH
DATE : DEC 13, 1978
SCALE : AS SHOWN


BASKET STRAINER DETAIL

TANANA VSW PROJECT
HOSPITAL SEWER SYSTEM


BS-1

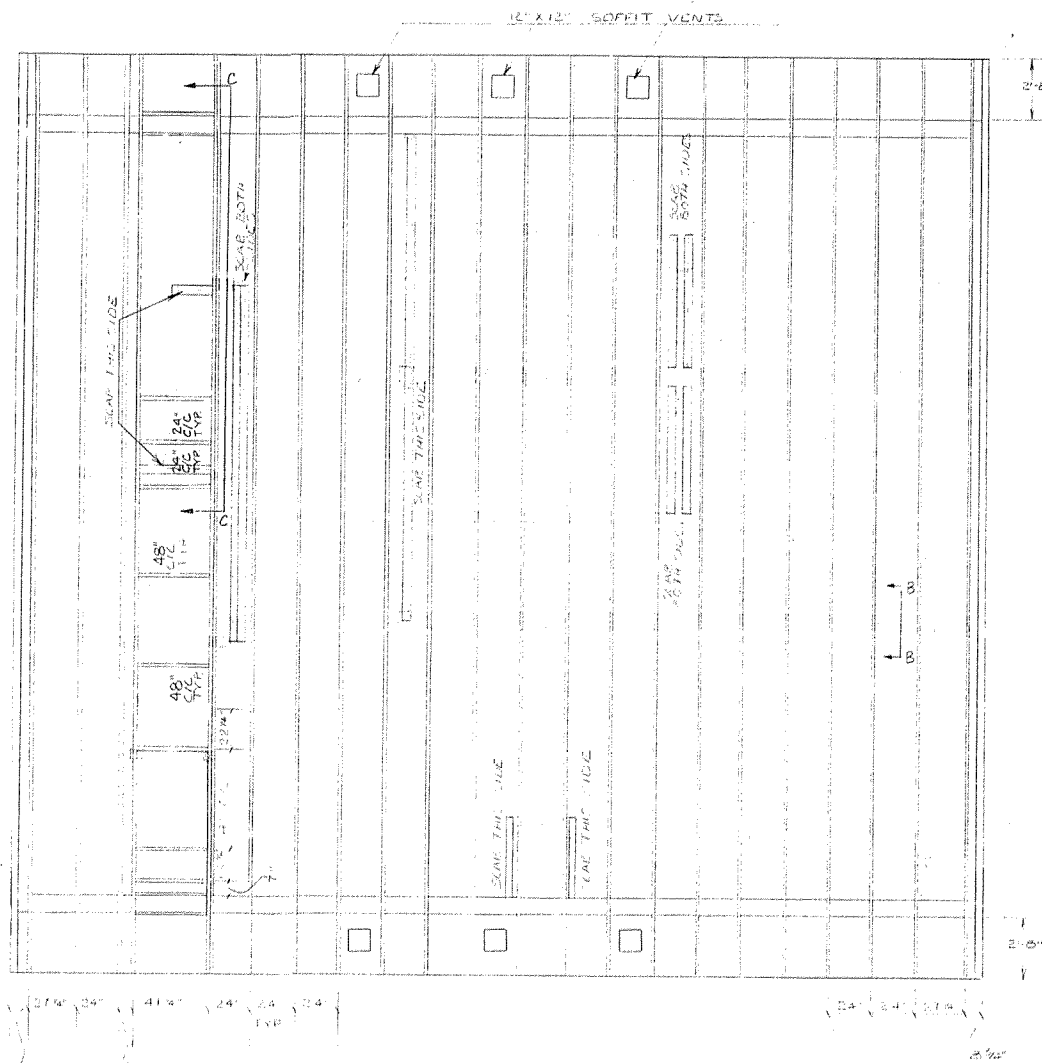


CEILING FRAMING PLAN
SCALE: 1/4" = 1'-0"

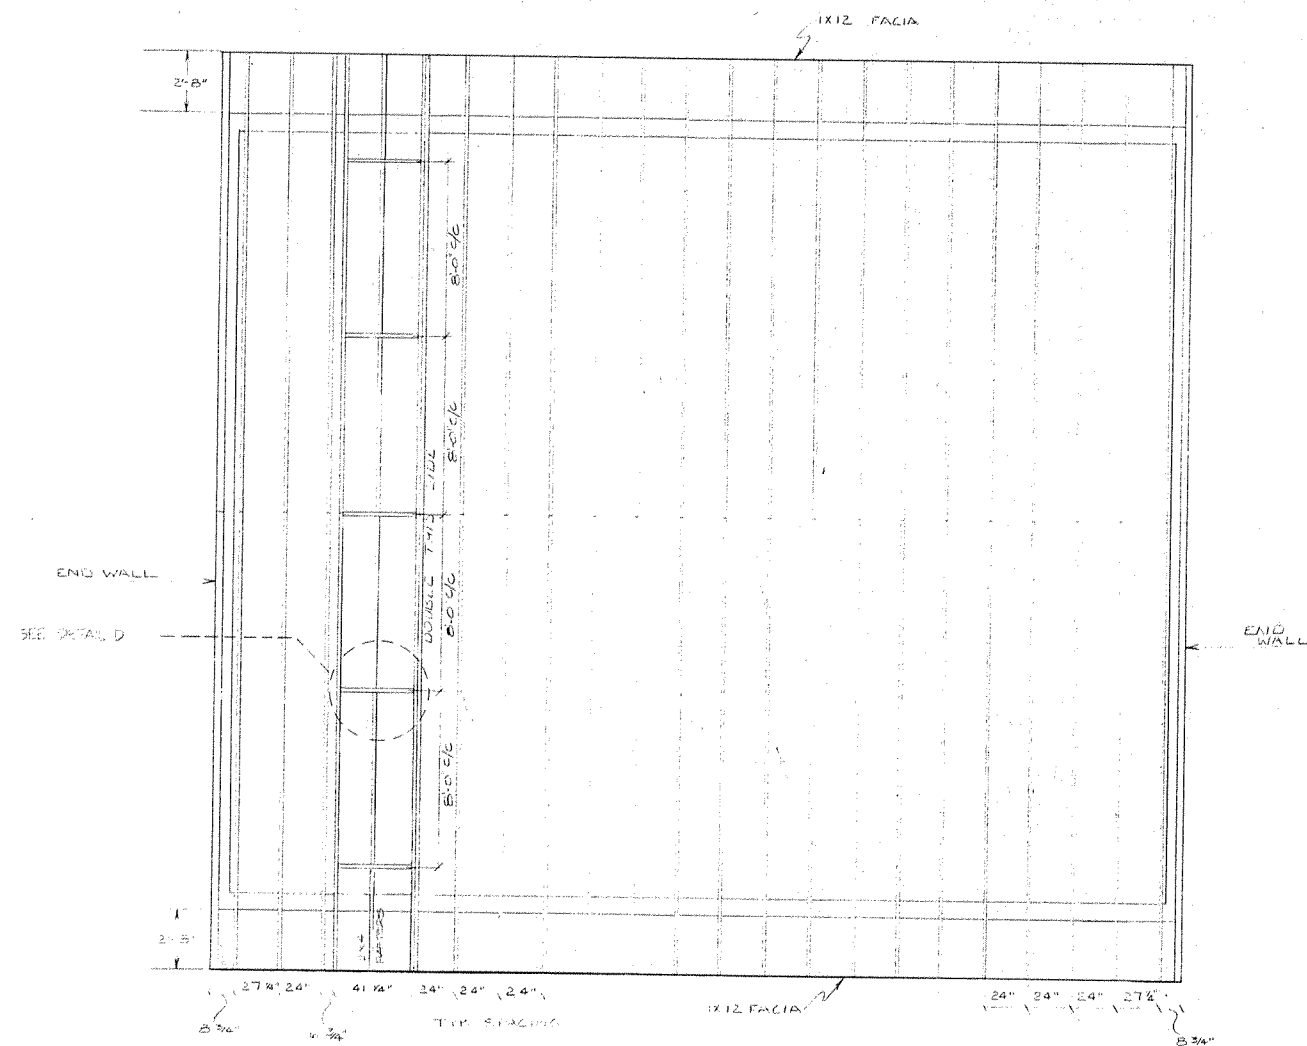


ROOF FRAMING PLAN
SCALE: 1/4" = 1'-0"

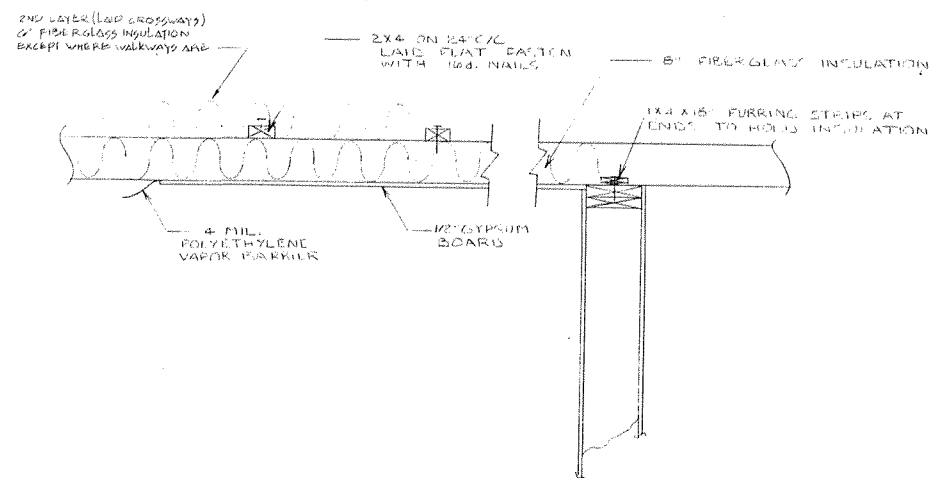

INTAKE DUCT SUPPORT DETAIL
SCALE: 1" = 1'-0"

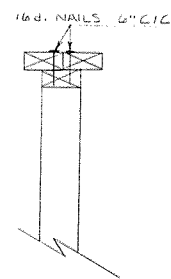


INTERIOR WALL SCAB FOR
CEILING FRAMING (TYP)
N.T.S.

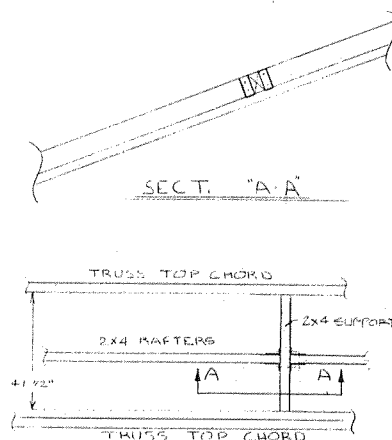

SPECIAL ROOF FRAMING (DETAIL D)
N.T.S.

1	ASBUILT	7-15-79	W
NO.	REVISION	DATE	BY

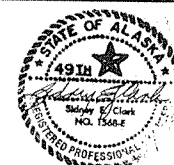

Arctic Environmental Engineers
Anchorage, Alaska

PROJECT NO. 77-024-01 SAV
DESIGNED: DPW
DRAWN: DER
CHECKED: WOVH
DATE: MARCH 78
SCALE: AS SHOWN


TANANA VILLAGE SAFE WATER FACILITY

ROOF / CEILING
FRAMING PLAN


S-7




ALUMINUM SHEATHING PLAN
NTS

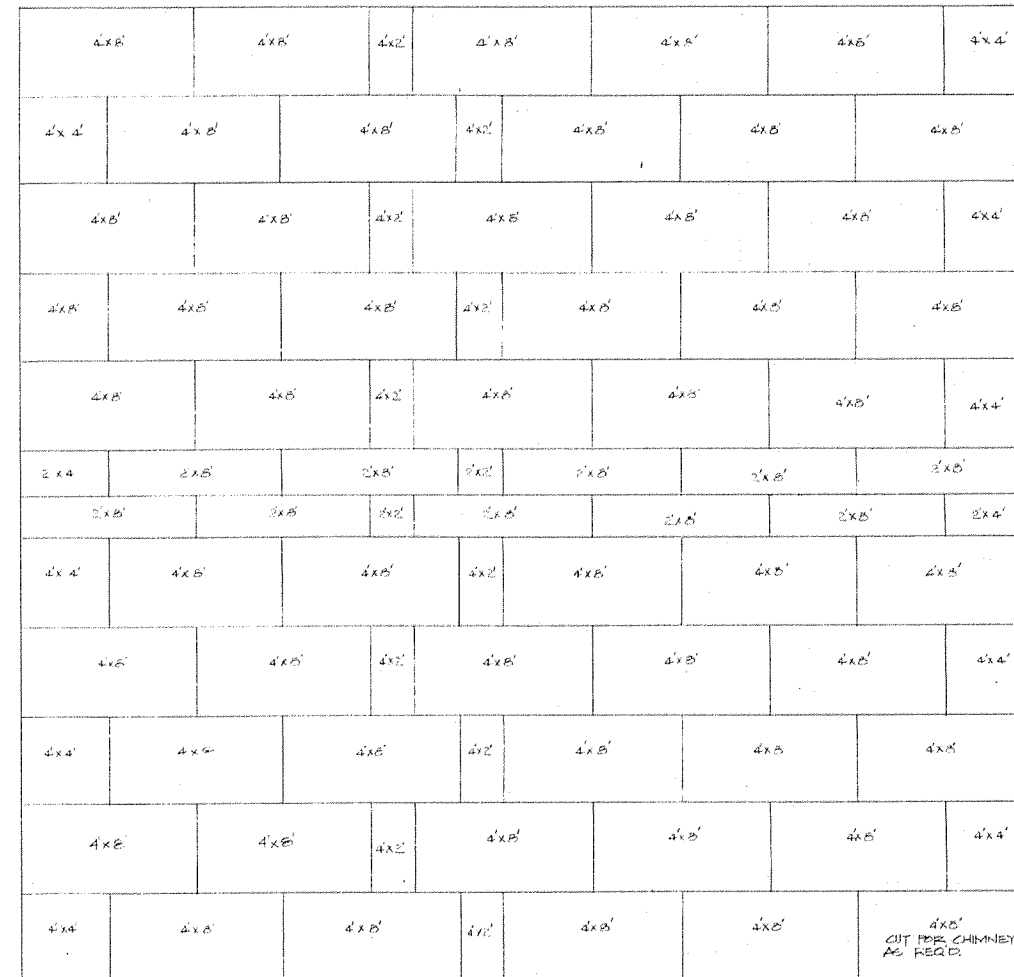

ROOF SHEATHING PLAN
SCALE 1/2" = 1'-0"

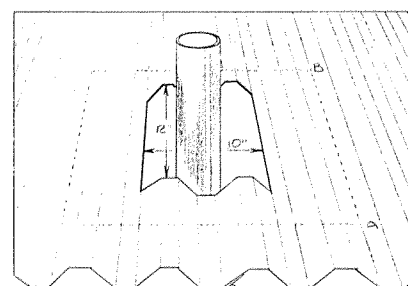


CAULK ALL DRAIN CHANNELS RUNNING THROUGH FLASHED OPENINGS

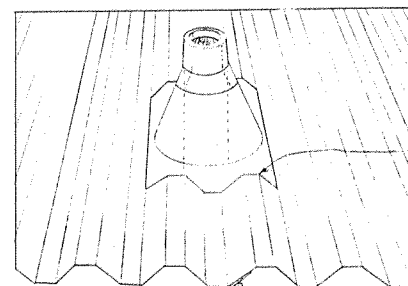

GAP AT PEAKS FILLED WITH RUBBER AND SEALED WITH ATCO PLASTIC FIBRE SEAL


VANGARD PANEL ROOF JACK INSTALLATION
NTS

NOTE: CAULKING BEAD APPLIED ONLY WHERE OPENINGS ARE CUT THROUGH ROOFING

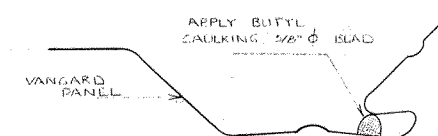

DRAIN CHANNEL CAULKING DETAIL
NTS

1	AS BUILT	7-16-79	M
NO.	REVISION	DATE	BY

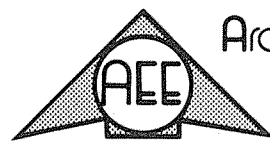

Arctic Environmental Engineers
Anchorage, Alaska







PROJECT NO. 77-024 01 SAV
DESIGNED: LRPW
DRAWN: DER
CHECKED: WSVH
DATE: MARCH 78
SCALE: AS NOTED

TANANA VILLAGE SAFE WATER FACILITY


ROOF SHEATHING PLAN
AND DETAILS

S-8

SHEET 18 OF 42

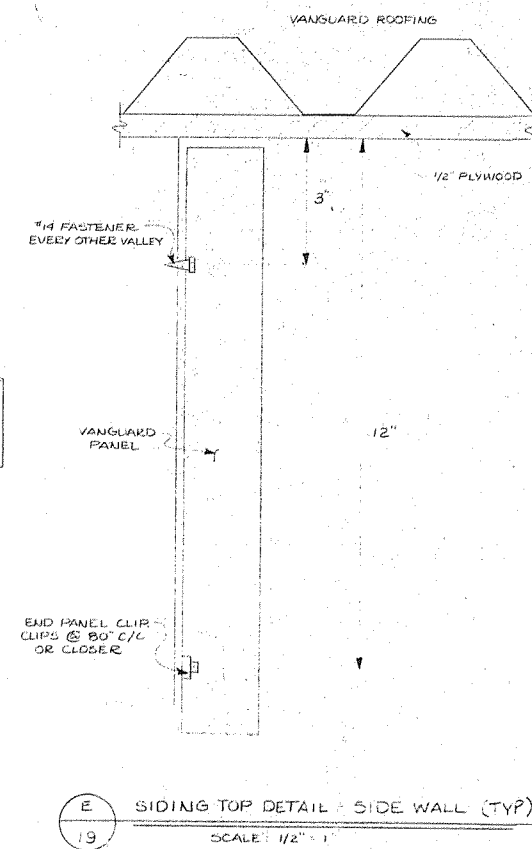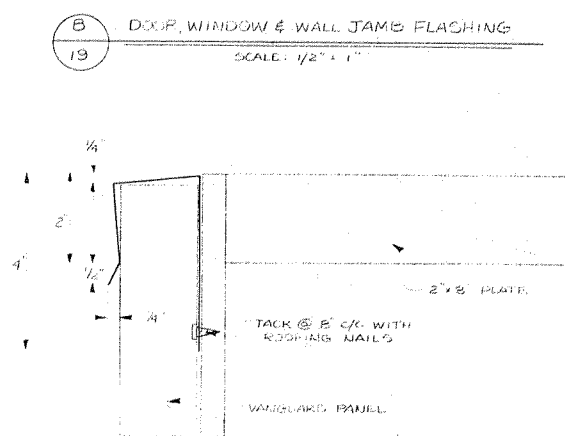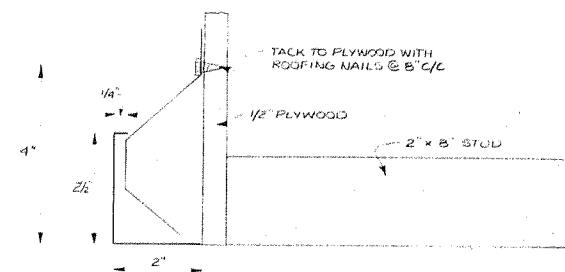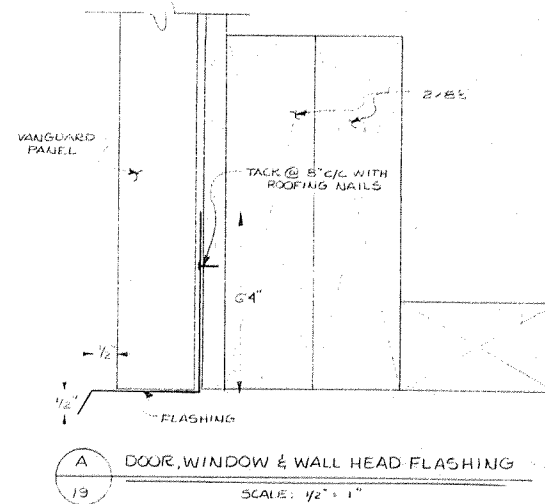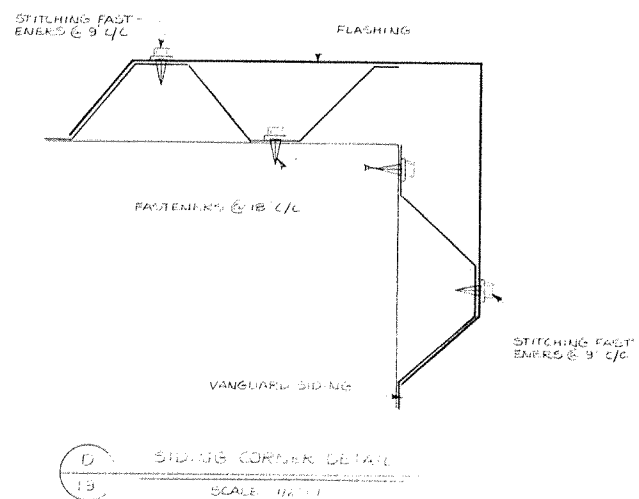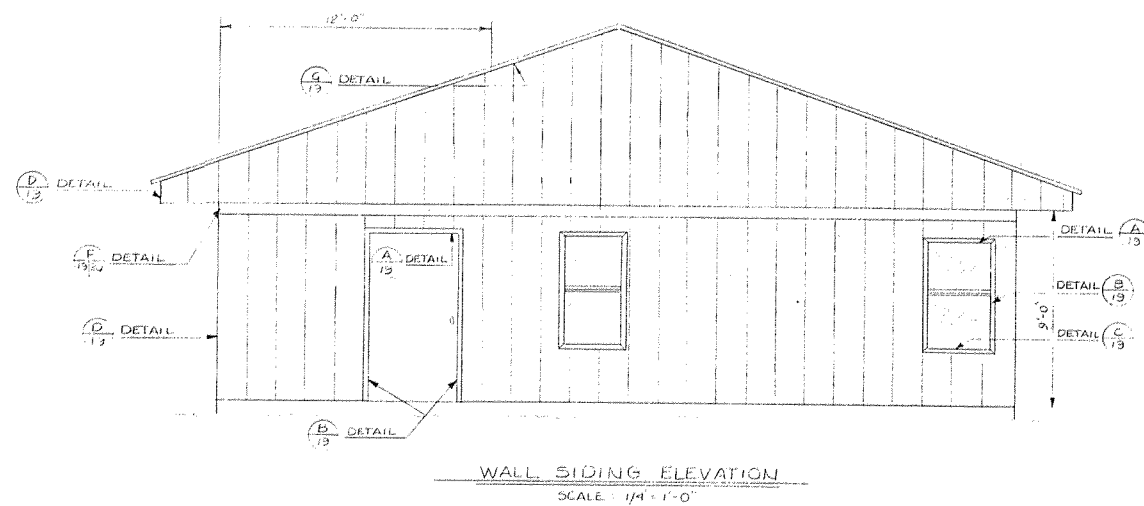

1	ASBUILT	7-15-79	MP
NO.	REVISION	DATE	BY

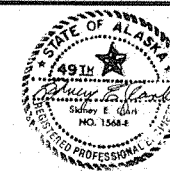






Arctic Environmental Engineers
Anchorage, Alaska

PROJECT NO. 11-0-101-54V
DESIGNED: J. P. W.
DRAWN: H. E. C.
CHECKED: W. S. R.
DATE: MARCH 1978
SCALE: AS NOTED

TANANA VSW FACILITY
SIDING DETAILS

S-9

SHEET 19 OF 42

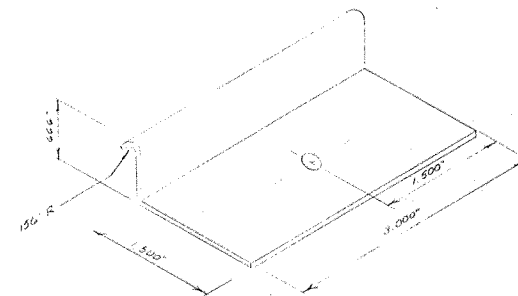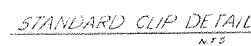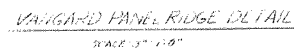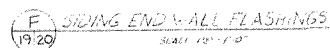
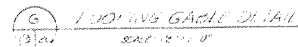


SHEET 20 OF 42





PROJECT NO. 77-024-01 SAV
DESIGNED : DPW
DRAWN : REZ.
CHECKED : WSVH
DATE : MARCH 1978
SCALE : AS NOTED


TANANA V.S.W. FACILITY
MISC. SIDING & ROOF DETAILS

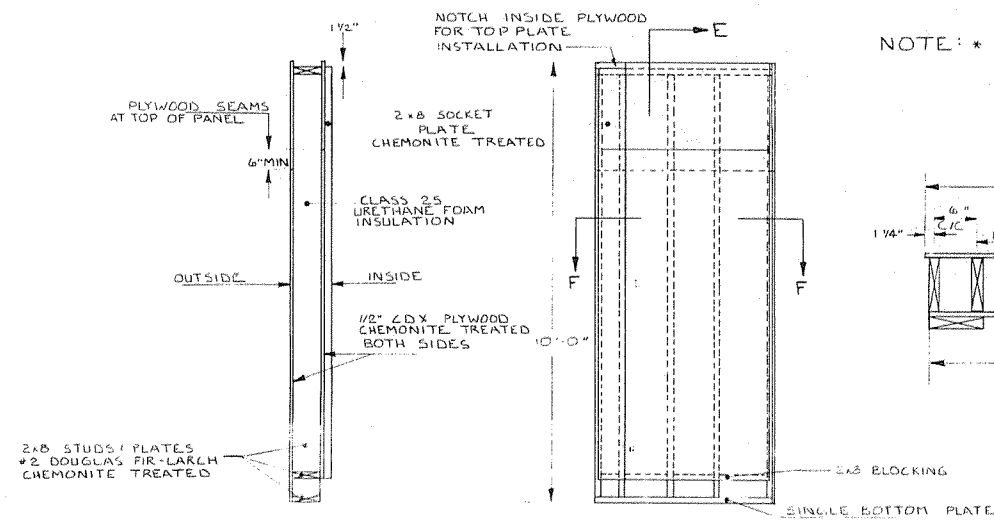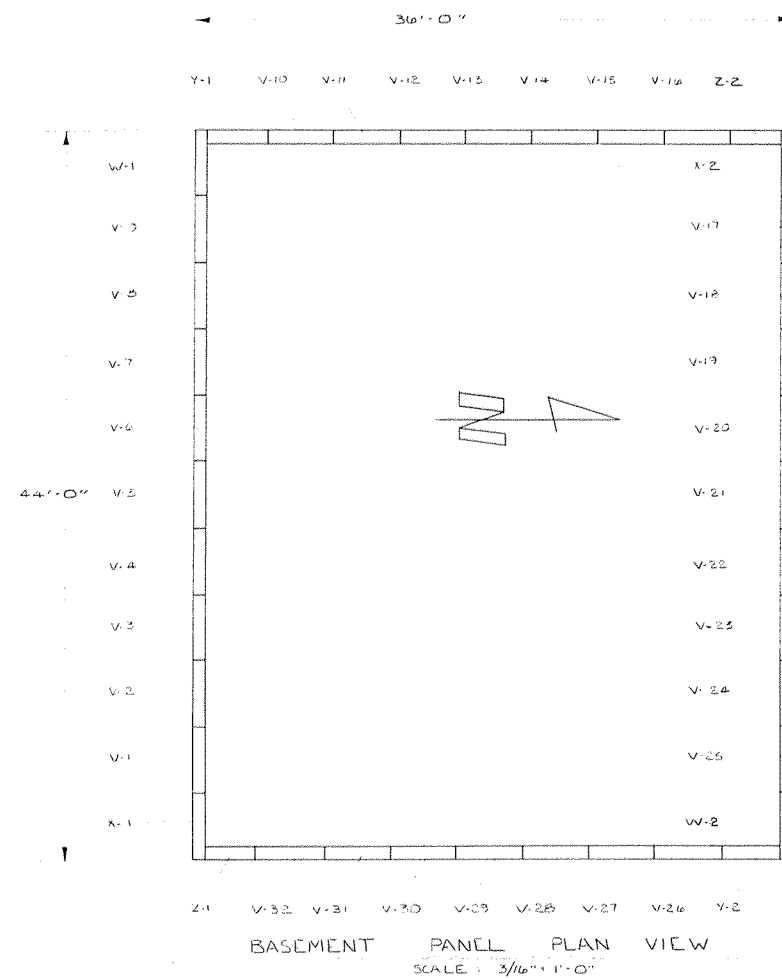

NOTE: * INDICATES DIMENSION TOLERANCES OF $\pm 1/32"$

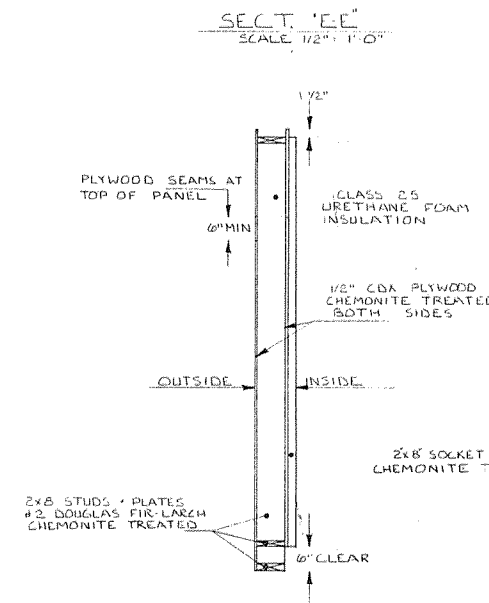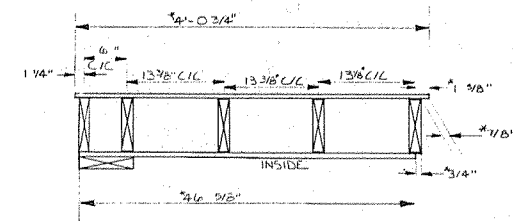


NOTE: * INDICATES DIMENSION TOLERANCES OF $\pm 1/32"$

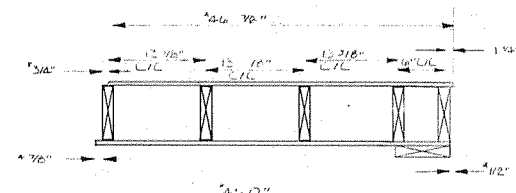


SECTION D-D
SCALE: 1/2" = 1'-0"

PANEL "W" 1/2
INSIDE ELEV SCALE: 1/2" = 1'-0"

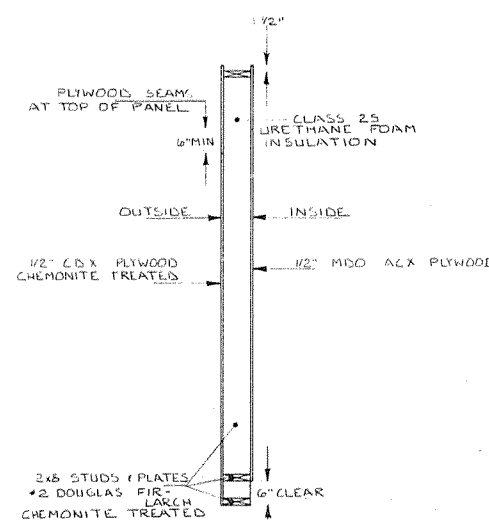

NOTE: INDICATES DIMENSION TOLERANCES OF $\pm 1/32"$

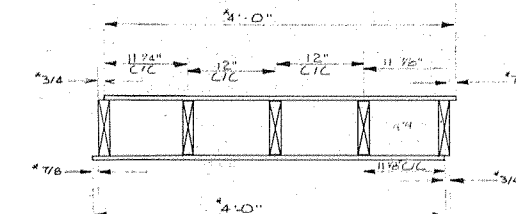


SECTION B-B
SCALE: 1" = 1'-0"

NOTE: SEE SPECIAL DETAILS FOR PANELS V-19 / V-20

PANEL "V" 1 THRU 32
INSIDE ELEV SCALE: 1/2" = 1'-0"

NOTE: ALL NAILS, BOLTS, AND METAL ACCESSORIES IN CONTACT WITH CHEMONITE TREATED PLYWOOD OR LUMBER MUST BE EITHER GALVANIZED OR CADMIUM PLATED OR OF 300 SERIES STAINLESS STEEL.

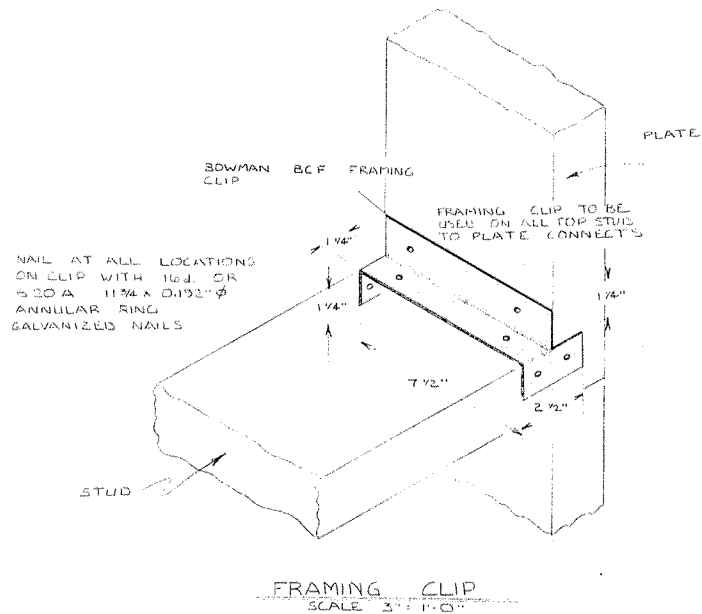

1	ASBUILT	7-15-79	14
NO.	REVISION	DATE	BY







Arctic Environmental Engineers
Anchorage, Alaska

PROJECT NO. 77-024-01 SAV
DESIGNED: DPW
DRAWN: DER
CHECKED: WSVH
DATE: 16 MARCH, 1978
SCALE: AS NOTED


TANANA VILLAGE SAFE WATER FACILITY
BASEMENT WALL PANEL CONSTRUCTION
DETAILS

S-11

- NOTE: 1. PANELS TO BE BONDED TO STUDS AND PLATES WITH "3-C" BRAND WALL BOND ADHESIVE AND STAPLED WITH 14 GA. OR HEAVIER X 1 1/2" STAPLES AT 2" C/C
2. ALL METAL FASTENERS AND CONNECTIONS TO BE GALVANIZED, CADMIUM PLATED, OR OF TYPE 304 STAINLESS
3. CHEMONITE TREATED LUMBER & PLYWOOD SHALL BE MARKED "AWPB, FDN" AS ACCEPTABLE FOR AWWA

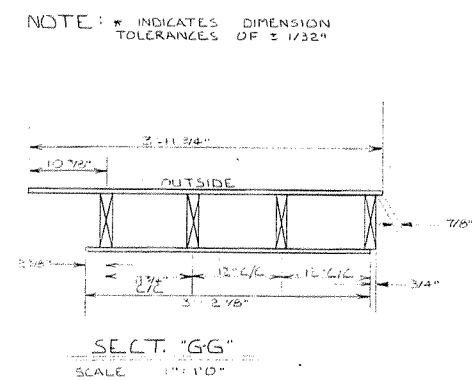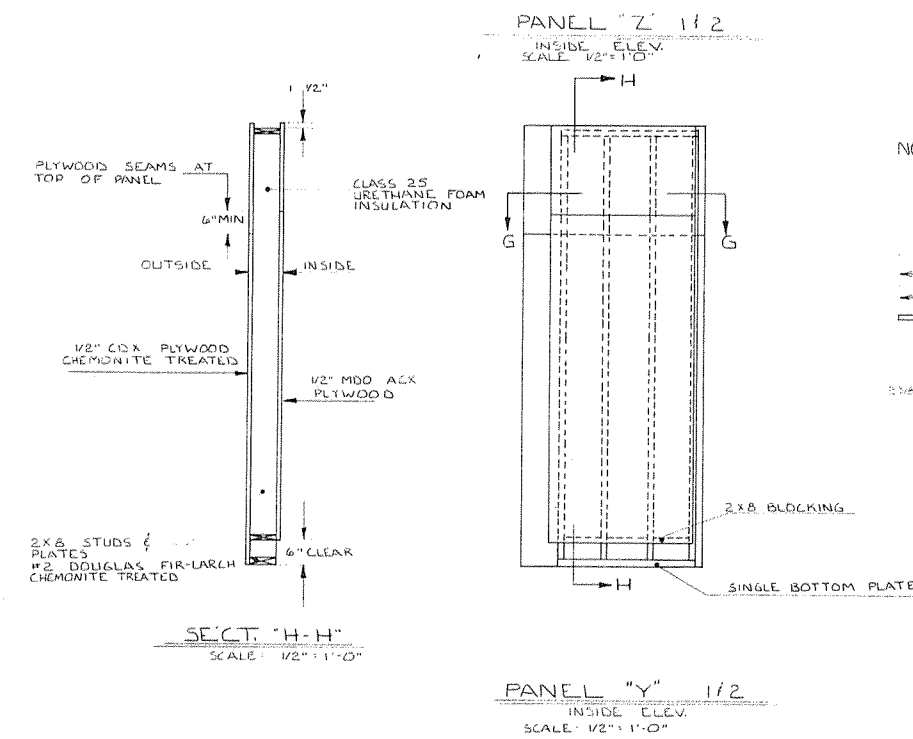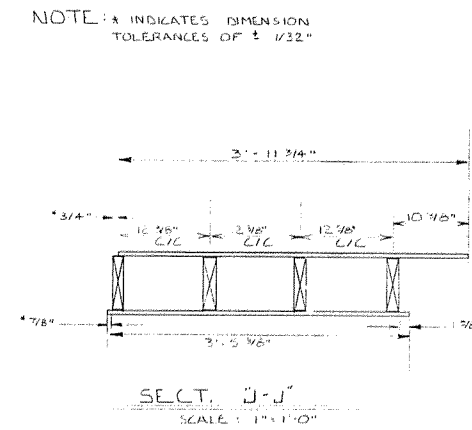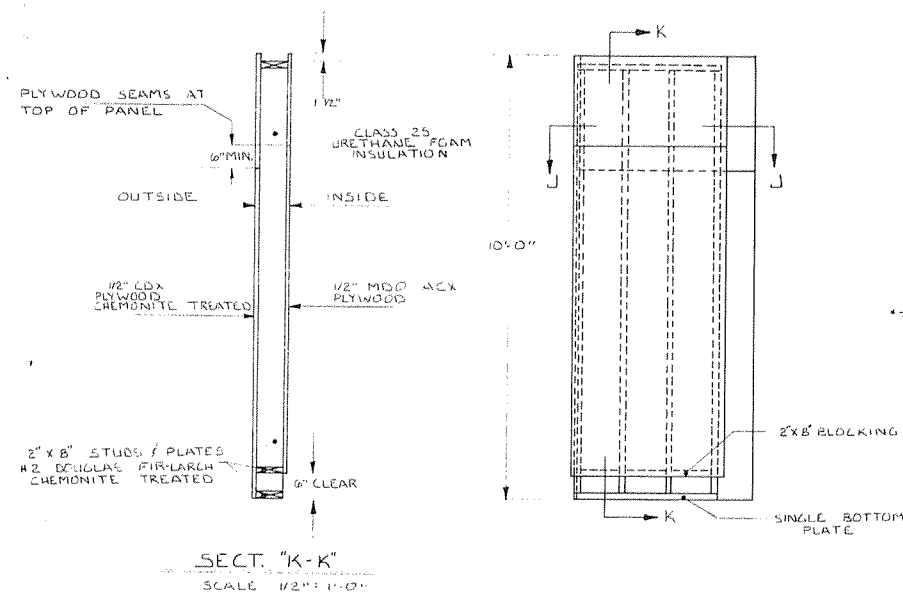

NOTE: DIMENSIONS AND MATERIALS FOR V-19, V-20 ARE TO REMAIN THE SAME AS FOR V-1 THRU 32 EXCEPT AS NOTED BELOW

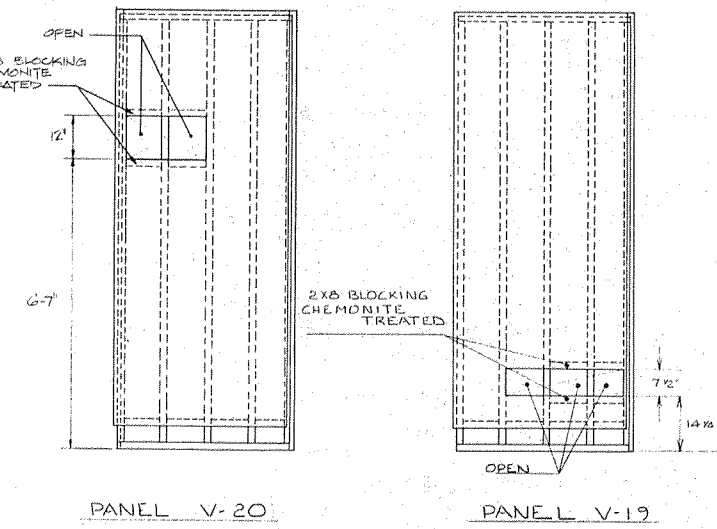

SPECIAL CONSTRUCTION PANELS

SCALE: 1/2" = 1'-0"

NO.	REVISION	DATE	BY
1	ASBUILT	7-5-79	M

STATE OF ALASKA
49th
SIGNED & CLERK
NO. 1568-E
REGISTERED PROFESSIONAL




Arctic Environmental Engineers
Anchorage, Alaska

PROJECT NO. 77-024-01 SAV
DESIGNED: DPW
DRAWN: DER
CHECKED: WSVH
DATE: 16 MARCH 1978
SCALE: AS NOTED



TANANA VILLAGE SAFE WATER FACILITY
BASEMENT WALL PANEL CONSTRUCTION
DETAILS

S-12

SHEET 22 OF 42

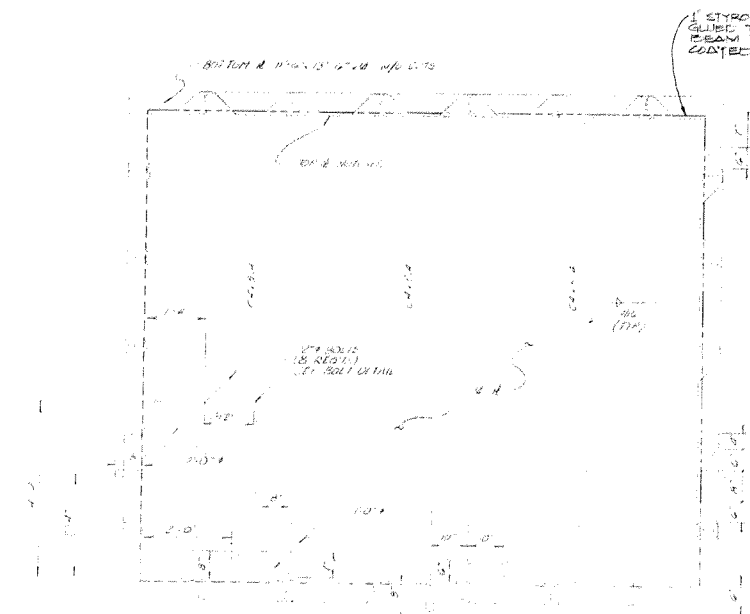


NOTE:
1. ALL 2" R. WEBS TO BE FULL
PENETRATION WELDS.
2. WELD ELECTRODES TO BE
E-16 SERIES WELDING RODS
3. PROVIDE CATHODIC PROTECTION
ANODES INSIDE TANK

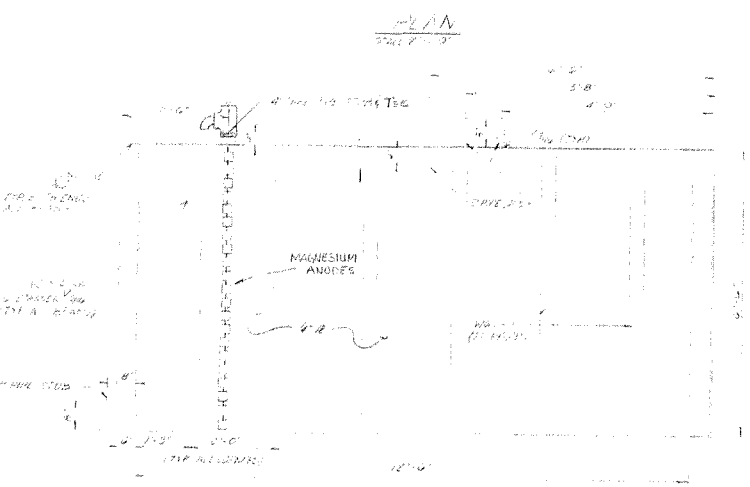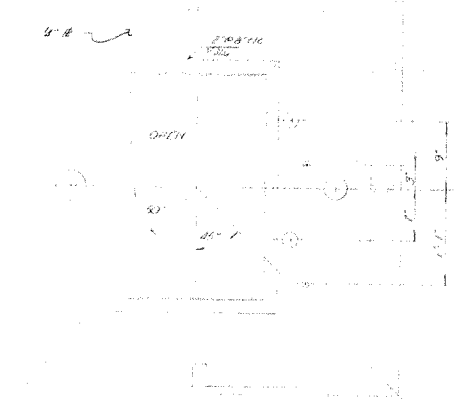


WATER TANK
SCALE 1"=1'-0" (1 REQ'D.)

SUMP
SCALE 1"=1'-0" (1 REQ'D.)


ELEVATION
SCALE 1"=1'-0" (1 REQ'D.)

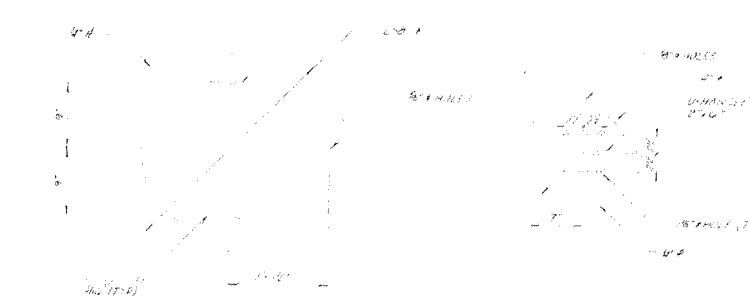


COVER PLATE DETAILS
SCALE 1"=1'-0" (1 REQ'D.)

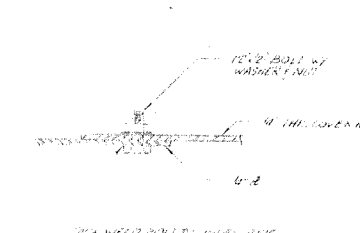


BOLT DETAIL
SCALE 1"=1'-0" (1 REQ'D.)

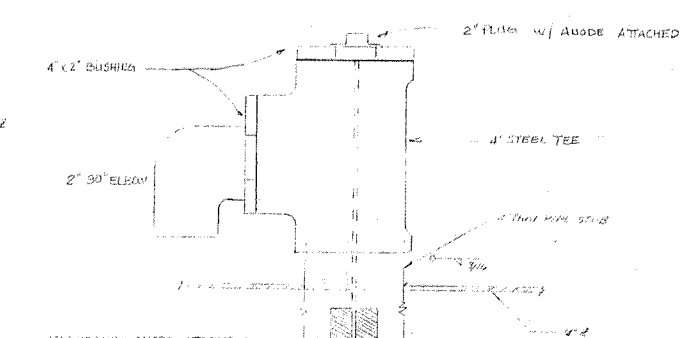


BENT PIPE DETAIL
SCALE 1"=1'-0" (1 REQ'D.)

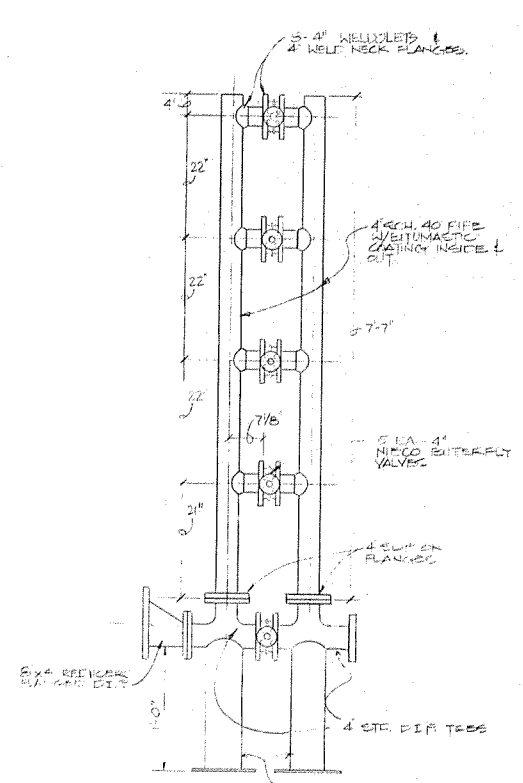

STANDPIPE DETAIL
SCALE 1"=1'-0" (1 REQ'D.)


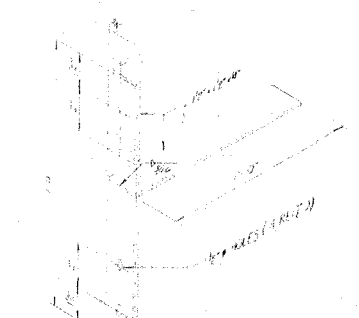


SUPPORT DETAIL
SCALE 1"=1'-0" (1 REQ'D.)

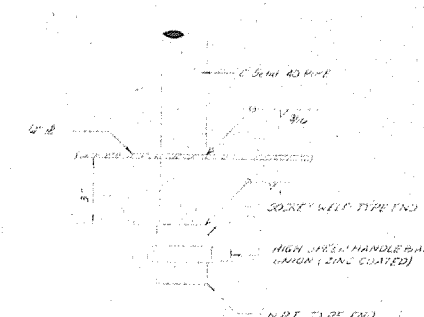

DETAIL "1"
SCALE 1"=1'-0" (1 REQ'D.)

01	ASBUILT	7-15-79	M
NO.	REVISION	DATE	BY

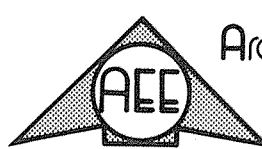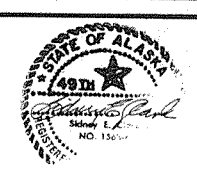


Arctic Environmental Engineers
Anchorage, Alaska


PROJECT NO. 77-024-01 SAV
DESIGNED: DPW
DRAWN: REL
CHECKED: WGVH
DATE: MARCH 1978
SCALE: AS NOTED

TANANA V.S.W. FACILITY
STEEL TANK & MISL. FABRICATIONS


S-13

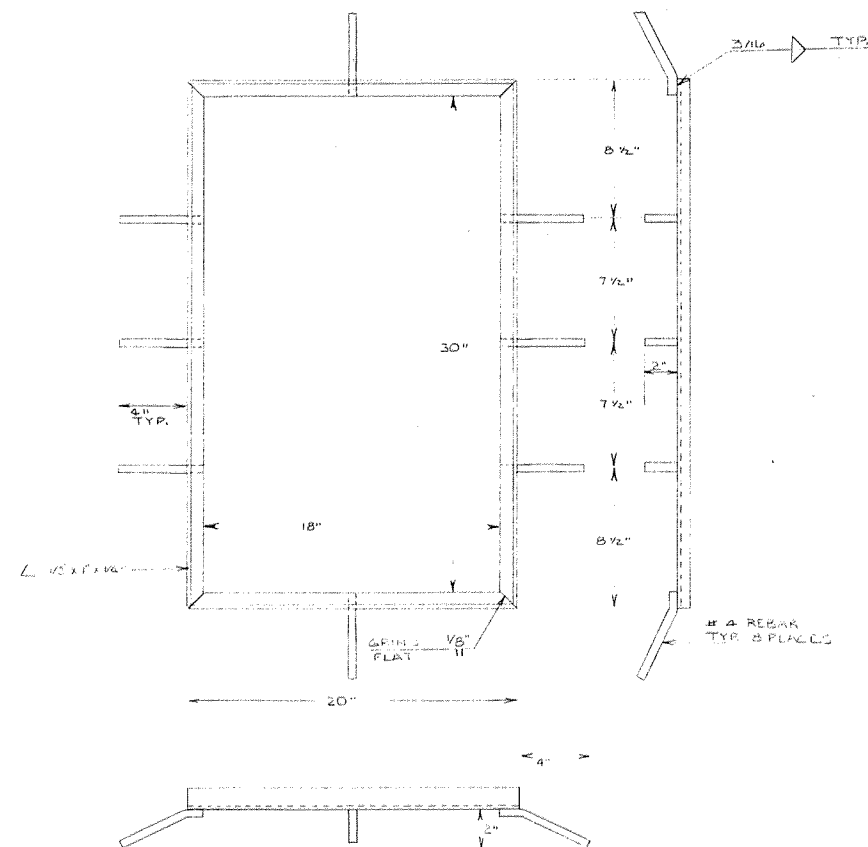


SUMP LID FRAME
SCALE: 3/16" = 1"

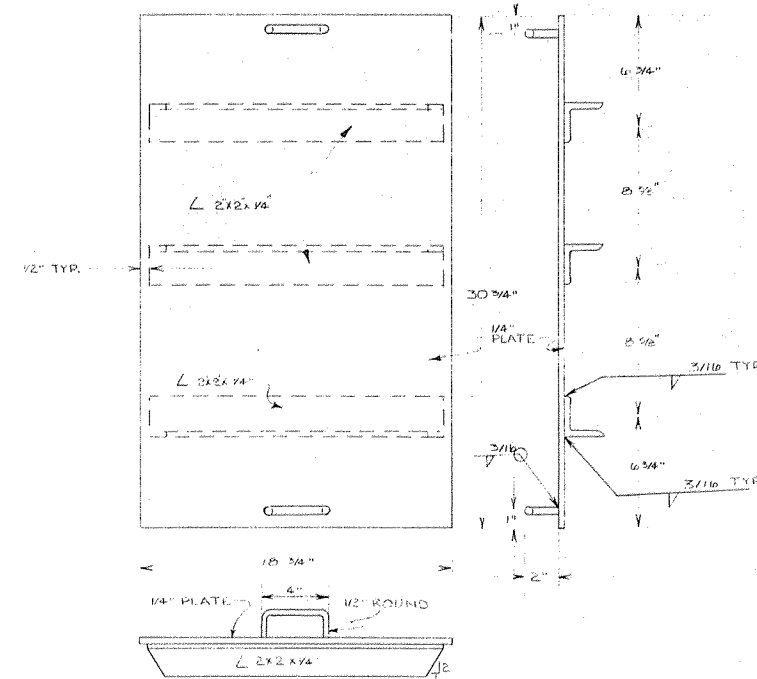

SUMP LID
SCALE: 3/16" = 1"

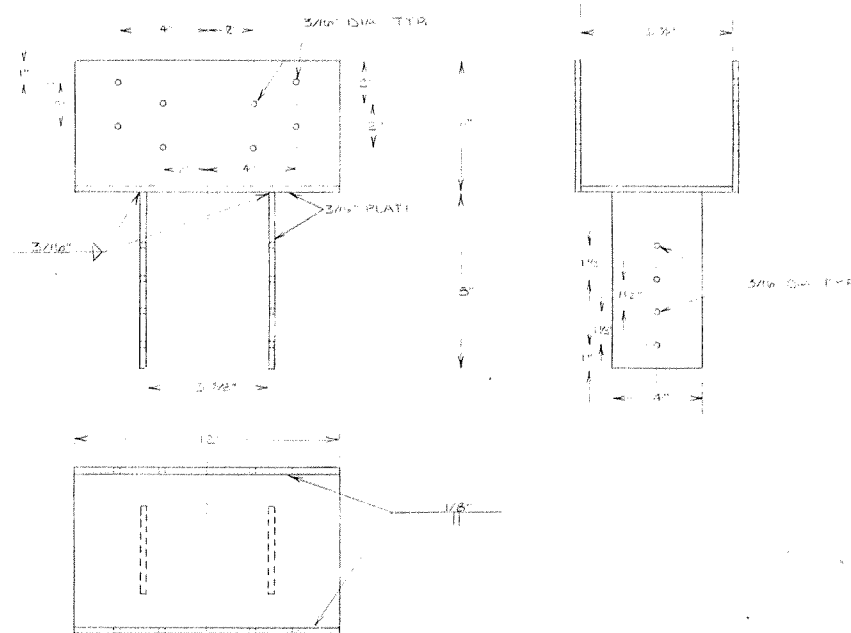

GLUE-LAM TO COLUMN SADDLE
SCALE: 1/4" = 1"

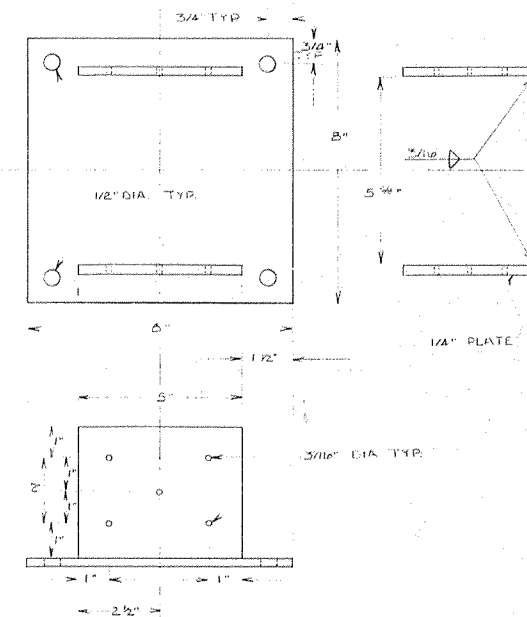

COLUMN SHOE
SCALE: 3/16" = 1"

NO.	REVISION	DATE	BY
1	AS SHOWN	7-15-75	WJ



Arctic Environmental Engineers
Anchorage, Alaska



PROJECT NO. 77-024-01 SAV
DESIGNED : DPW
DRAWN : OERL
CHECKED : WSVH
DATE : MARCH 1978
SCALE : AS NOTED

TANANA V.S.V. FACILITY
MISCELLANEOUS STEEL FABRICATIONS

S-14

SHEET 24 OF 42

CONNECTION	MAX. STRESS (LBS.)
1	NEGLECTIBLE
2	350
3	3,200
4	3,200
5	1,800
6	600
7	1,000
8	3,400
CHORD SPLICES @ PANEL POINTS	4,400

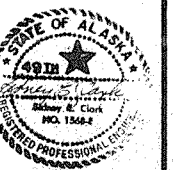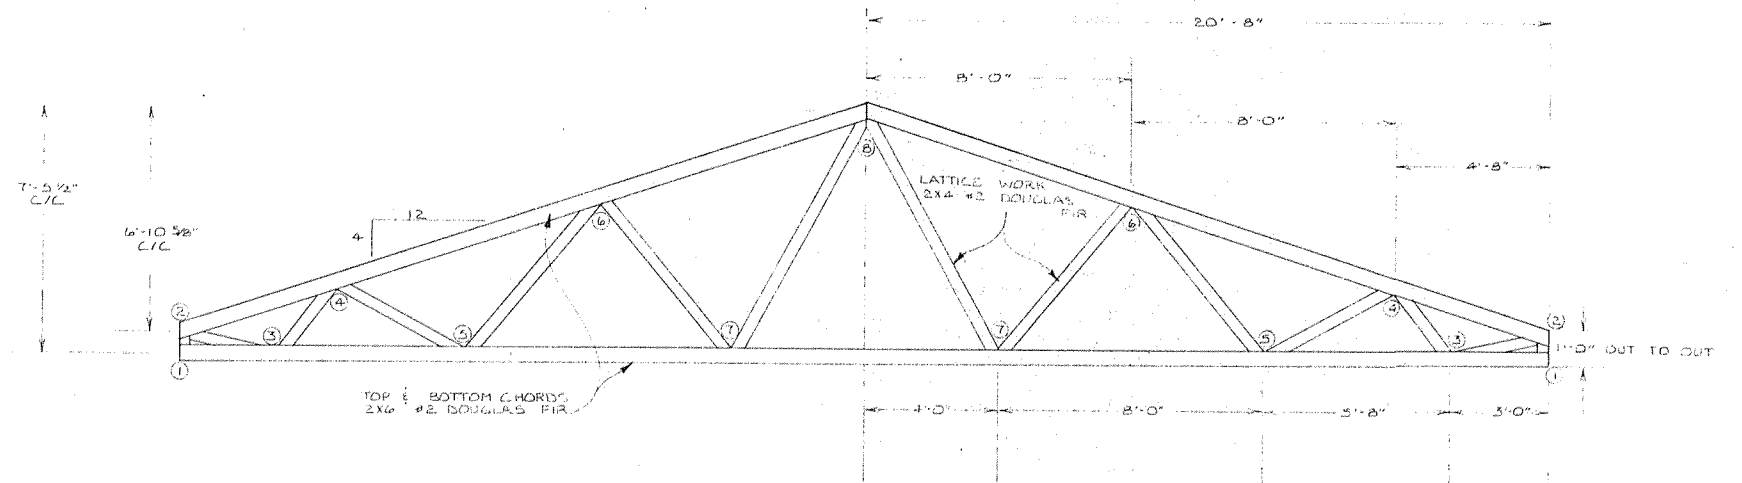

GAUGE

2" ADAPTER
(C x F)


2" COPPER TUBE

TEE

2"

TYPICAL GAUGE CONNECTION
N.T.S.

NOTE: This drawing is for schematic purposes only.
For complete system schematic, see 8 /
by 11 sketches in O&M manual.

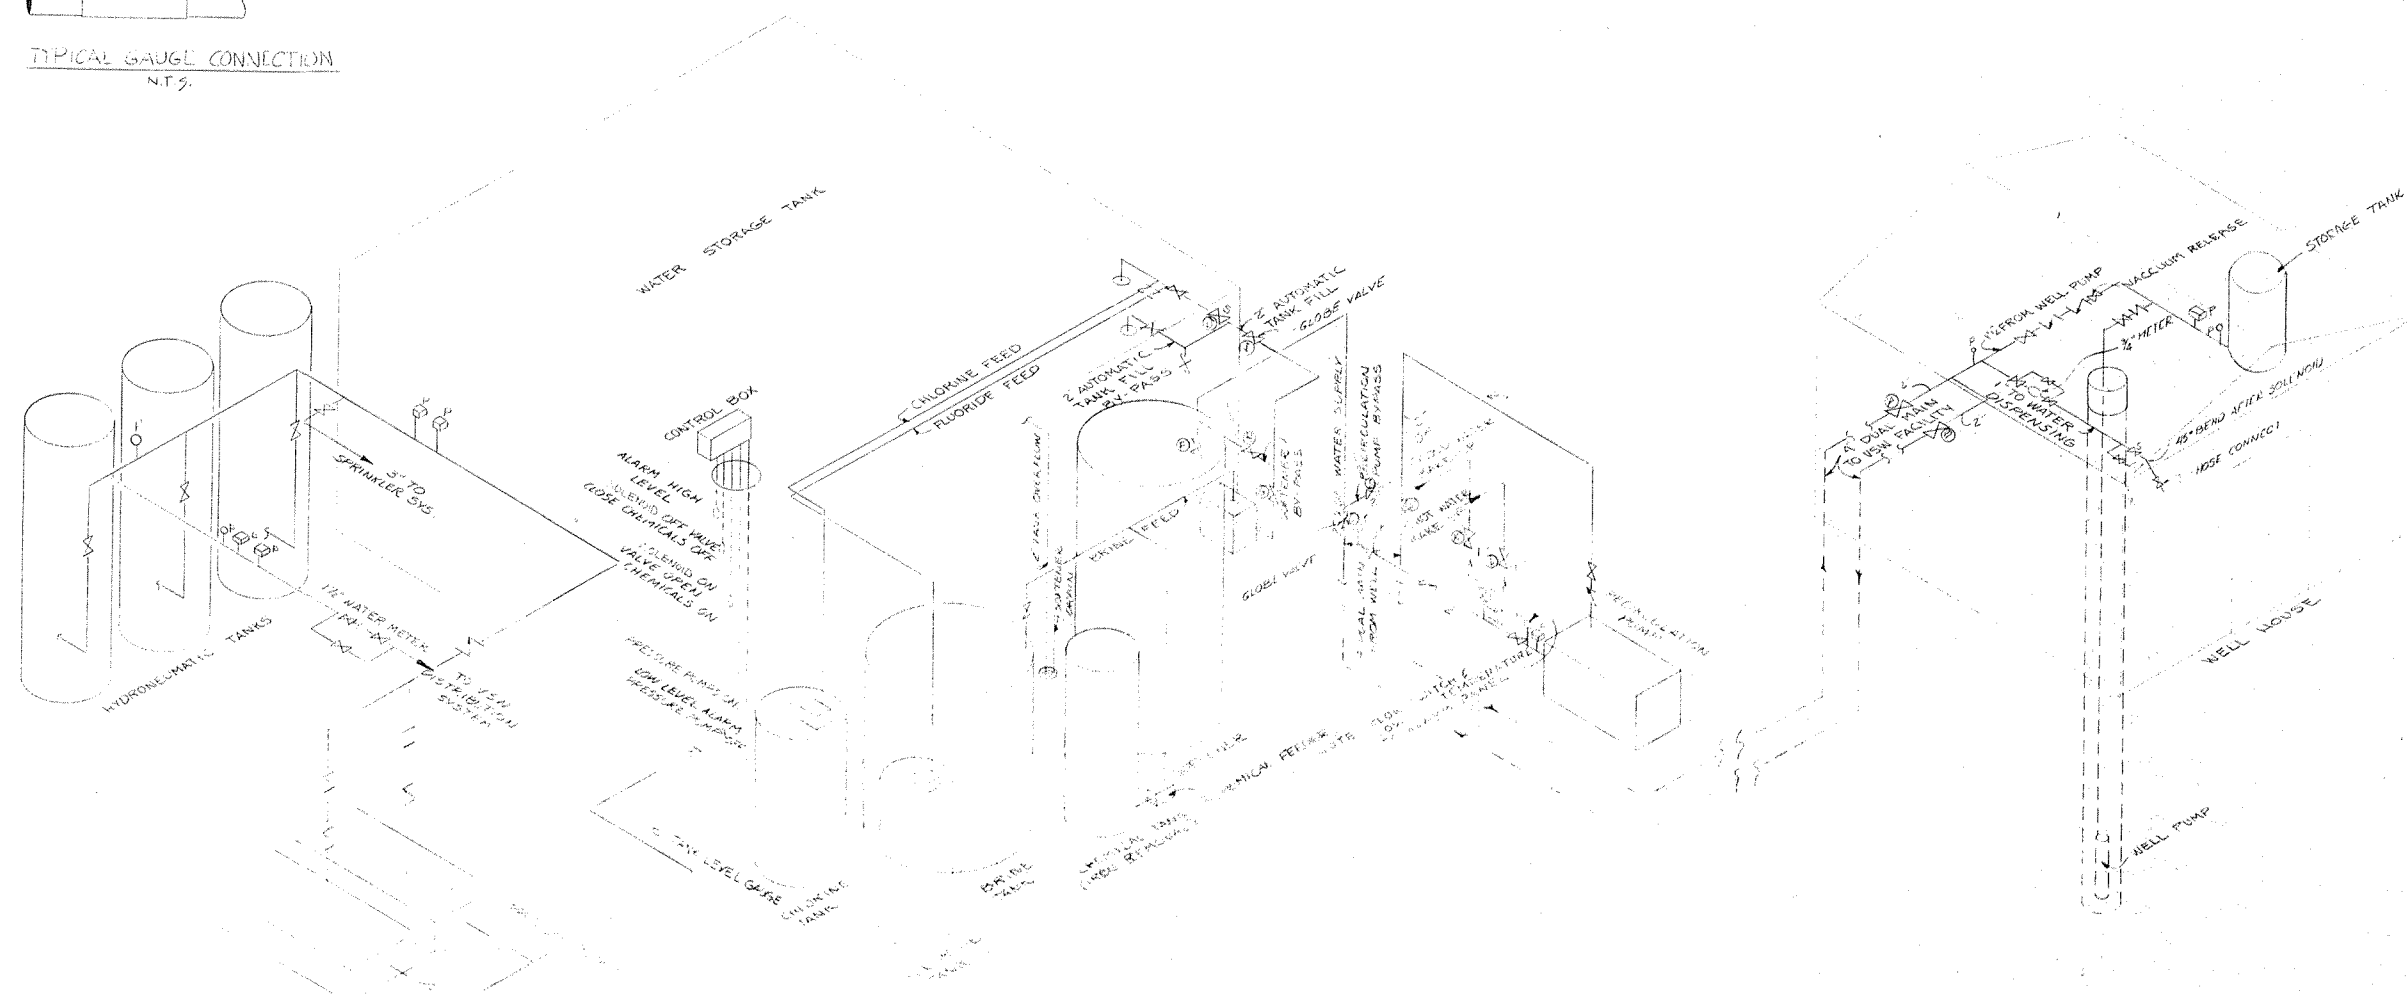

SOLENOID VALVE

FLOW SWITCH

PRESSURE SWITCH

PRESSURE GAUGE

TEMP GAUGE

CHECK VALVE

GATE VALVE - UNLESS OTHERWISE NOTED

SUMMER OPERATION

- A. Well Pump Operation
- The well pump operated by pressure switch
- B. Transfer to VSW Facility

Normally both 4-inch lines are left open to provide water to the VSW Facility (Valves A,B,C, D and Valve E closed)

Note: If the normal incoming line to the VSW Facility is non-functional Valves B & C are closed and A, D & E are open.

- C. Treatment
1. Flow goes directly thru the softener from pressure developed by the well pump. Valves F and G are open and Valve H is closed. The reverse setting is utilized if the softener is to be bypassed.
 2. Chlorine and fluoride are fed directly into the incoming line to the storage tank. The chemical feed pumps are controlled by the same floats as the well pump, and also a flow switch in the incoming line which must be activated before the pumps will turn on.

- P. Storage Tank Fills Line

After passing through the diffuser the water is fed to the water storage tank. The rate into the storage tank must be adjusted with the globe valve to match the pumping capacity of the well pump. This is especially important when either Valves K or J are open to maintain pressure in the distribution system. Measure flow using bucket test at base of K.

A. Holapok valve is placed on the ascending line to the
 storage tanks and is controlled by the floats. (Page 3)

- E. Pressat, *Autant*

Pressure to the distribution systems is controlled by dual
alteringly regulated pumps. Pressure is maintained by
three independent tanks with 100 psig rated tanks.

2. Pressure in the down mains from the well house is maintained by a hydropneumatic tank in the well house. The make-up line is provided with a solenoid valve which closes whenever the solenoid valve is open. This is to minimize water being treated twice.

WINTER OPERATION


- A. Well Pump Operation
- Well pump only operated by pressure switch in well house.

8. Transfer to VSM Facility & Recirculation

1. Flow circulates from well thru Valve B & C, with some going to the storage tank and the rest thru the recirculation pump, Valve D and A.
2. The recirculation pump is manually operated with a flow switch cut-off to protect against running dry.

Note: Hot water can be run through the mains by closing Valves C, E & K and opening D, I, A and the hose connect at the well house.

- C. Treatment - same as summer operation
- D. Storage Tank Fill Line - Same as summer operation
- E. Pressure System - Same as summer operation

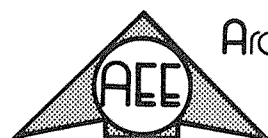

Arctic Environmental Engineers
Anchorage, Alaska

PROJECT NO. 71-024 (1) SAY
DESIGNED : W.S.V.S.
DRAWN : HEC
CHECKED : SEC
DATE : MARCH 1978
SCALE : N.T.S.


TANANA VSW FACILITY
WATER SUPPLY AND TREATMENT

P.

SHEET 27 OF 42




NOTE: ALL DRAIN PIPING IS
NO HUB CAST IRON

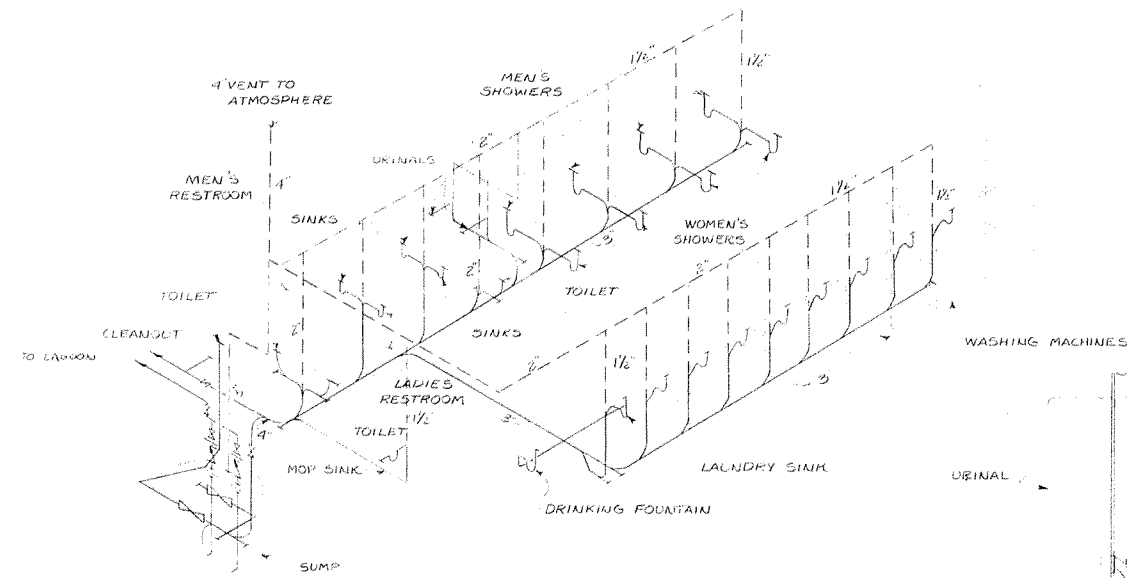


LEGEND:
— DRAIN LINE
--- VENT LINE


DRAIN SYSTEM DIAGRAM
N.T.S.

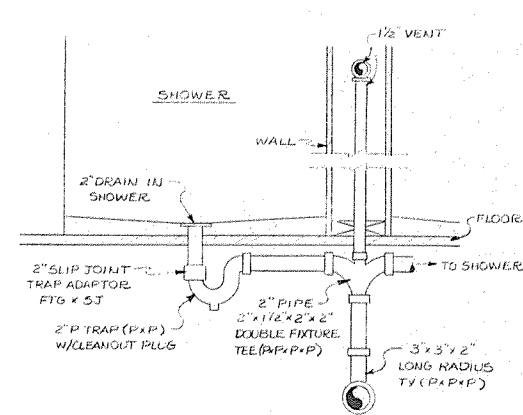


TYPICAL SHOWER DRAIN
SCALE: 1" = 1'-0"

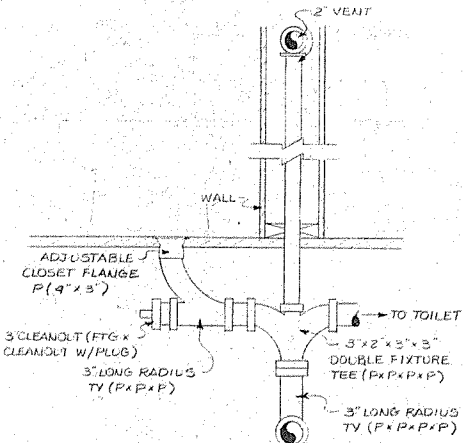


TYPICAL TOILET DRAIN
SCALE: 1" = 1'-0"

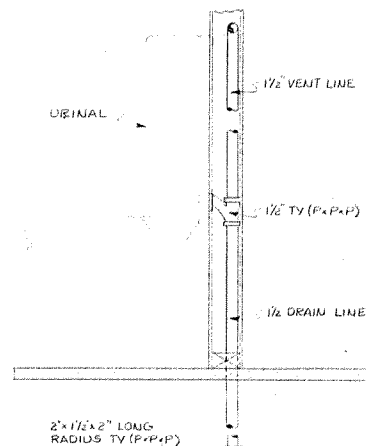


TYPICAL URINAL DRAIN
SCALE: 1" = 1'-0"

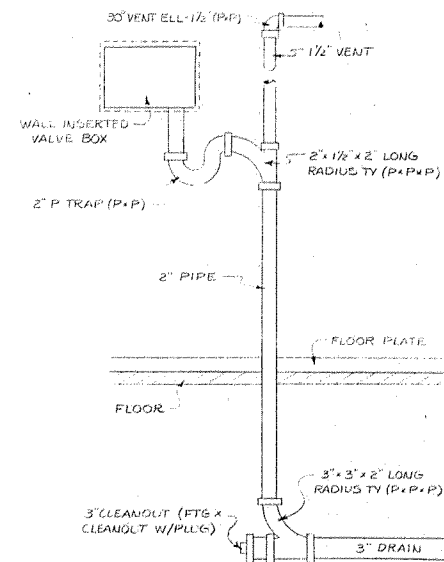


TYPICAL WASHING MACHINE DRAIN
SCALE: 1" = 1'-0"

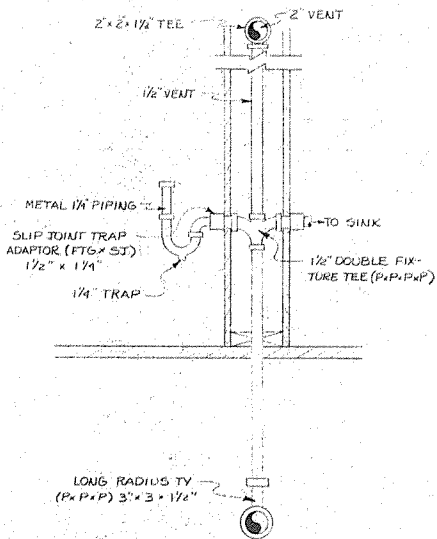

TYPICAL SINK DRAIN
SCALE: 1" = 1'-0"

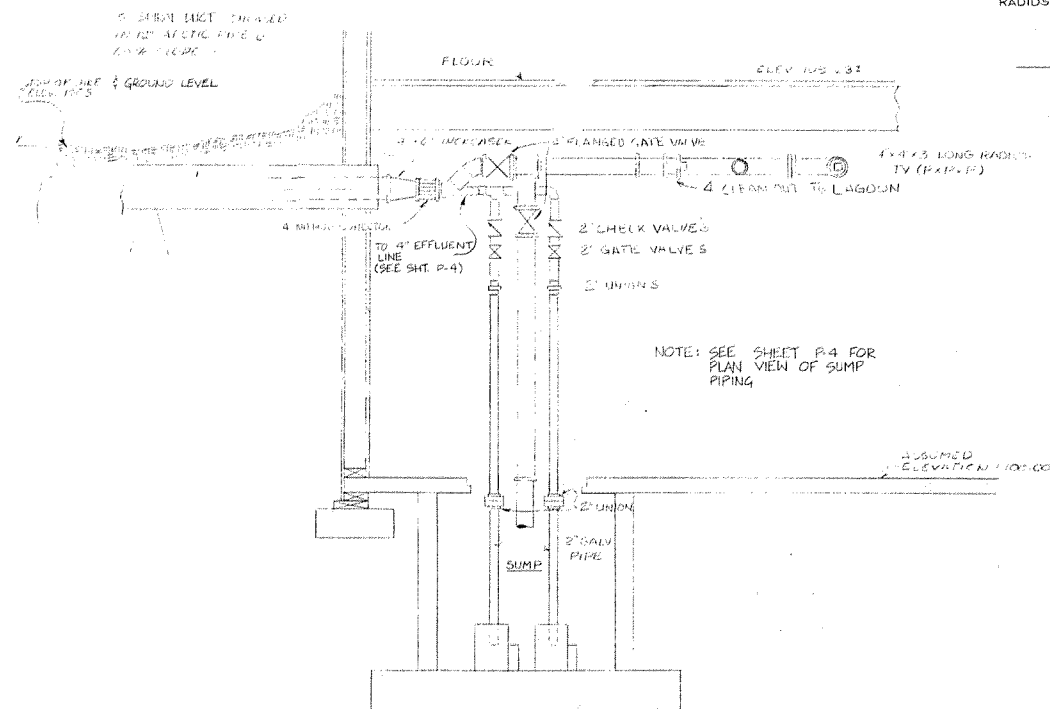


SECTION B
BUILDING DRAIN EFFLUENT
SCALE: 1" = 1'-0"

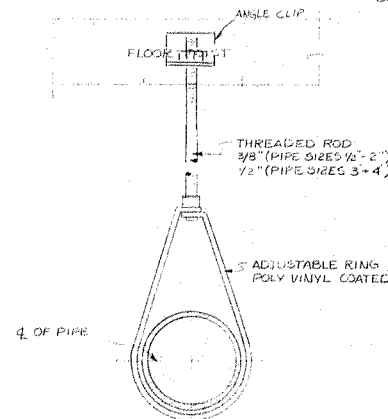

TYPICAL PIPE SUPPORT DETAIL
N.T.S.

2	SEE SKOGLUND DWG 7-279 M		
1	ASBUILT	7-15-71 M	
NO.	REVISION	DATE	BY

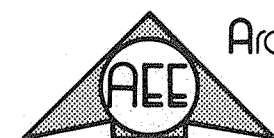

Arctic Environmental Engineers
Anchorage, Alaska

PROJECT NO. 77-024-01 SAV
DESIGNED: WSVH
DRAWN: HEC
CHECKED: SEC
DATE: MARCH 1978
SCALE: AS NOTED



TANANA VSW FACILITY
DRAINAGE SYSTEM

P-3

SHEET 29 OF 42



17'-10"
16'-7"
15'-8"
14'-5"
13'-11"
13'-5"

NOTES: (1) GENERAL ARRANGEMENT DRAWING ONLY
(2) METERS ARE ATTACHED TO WALL

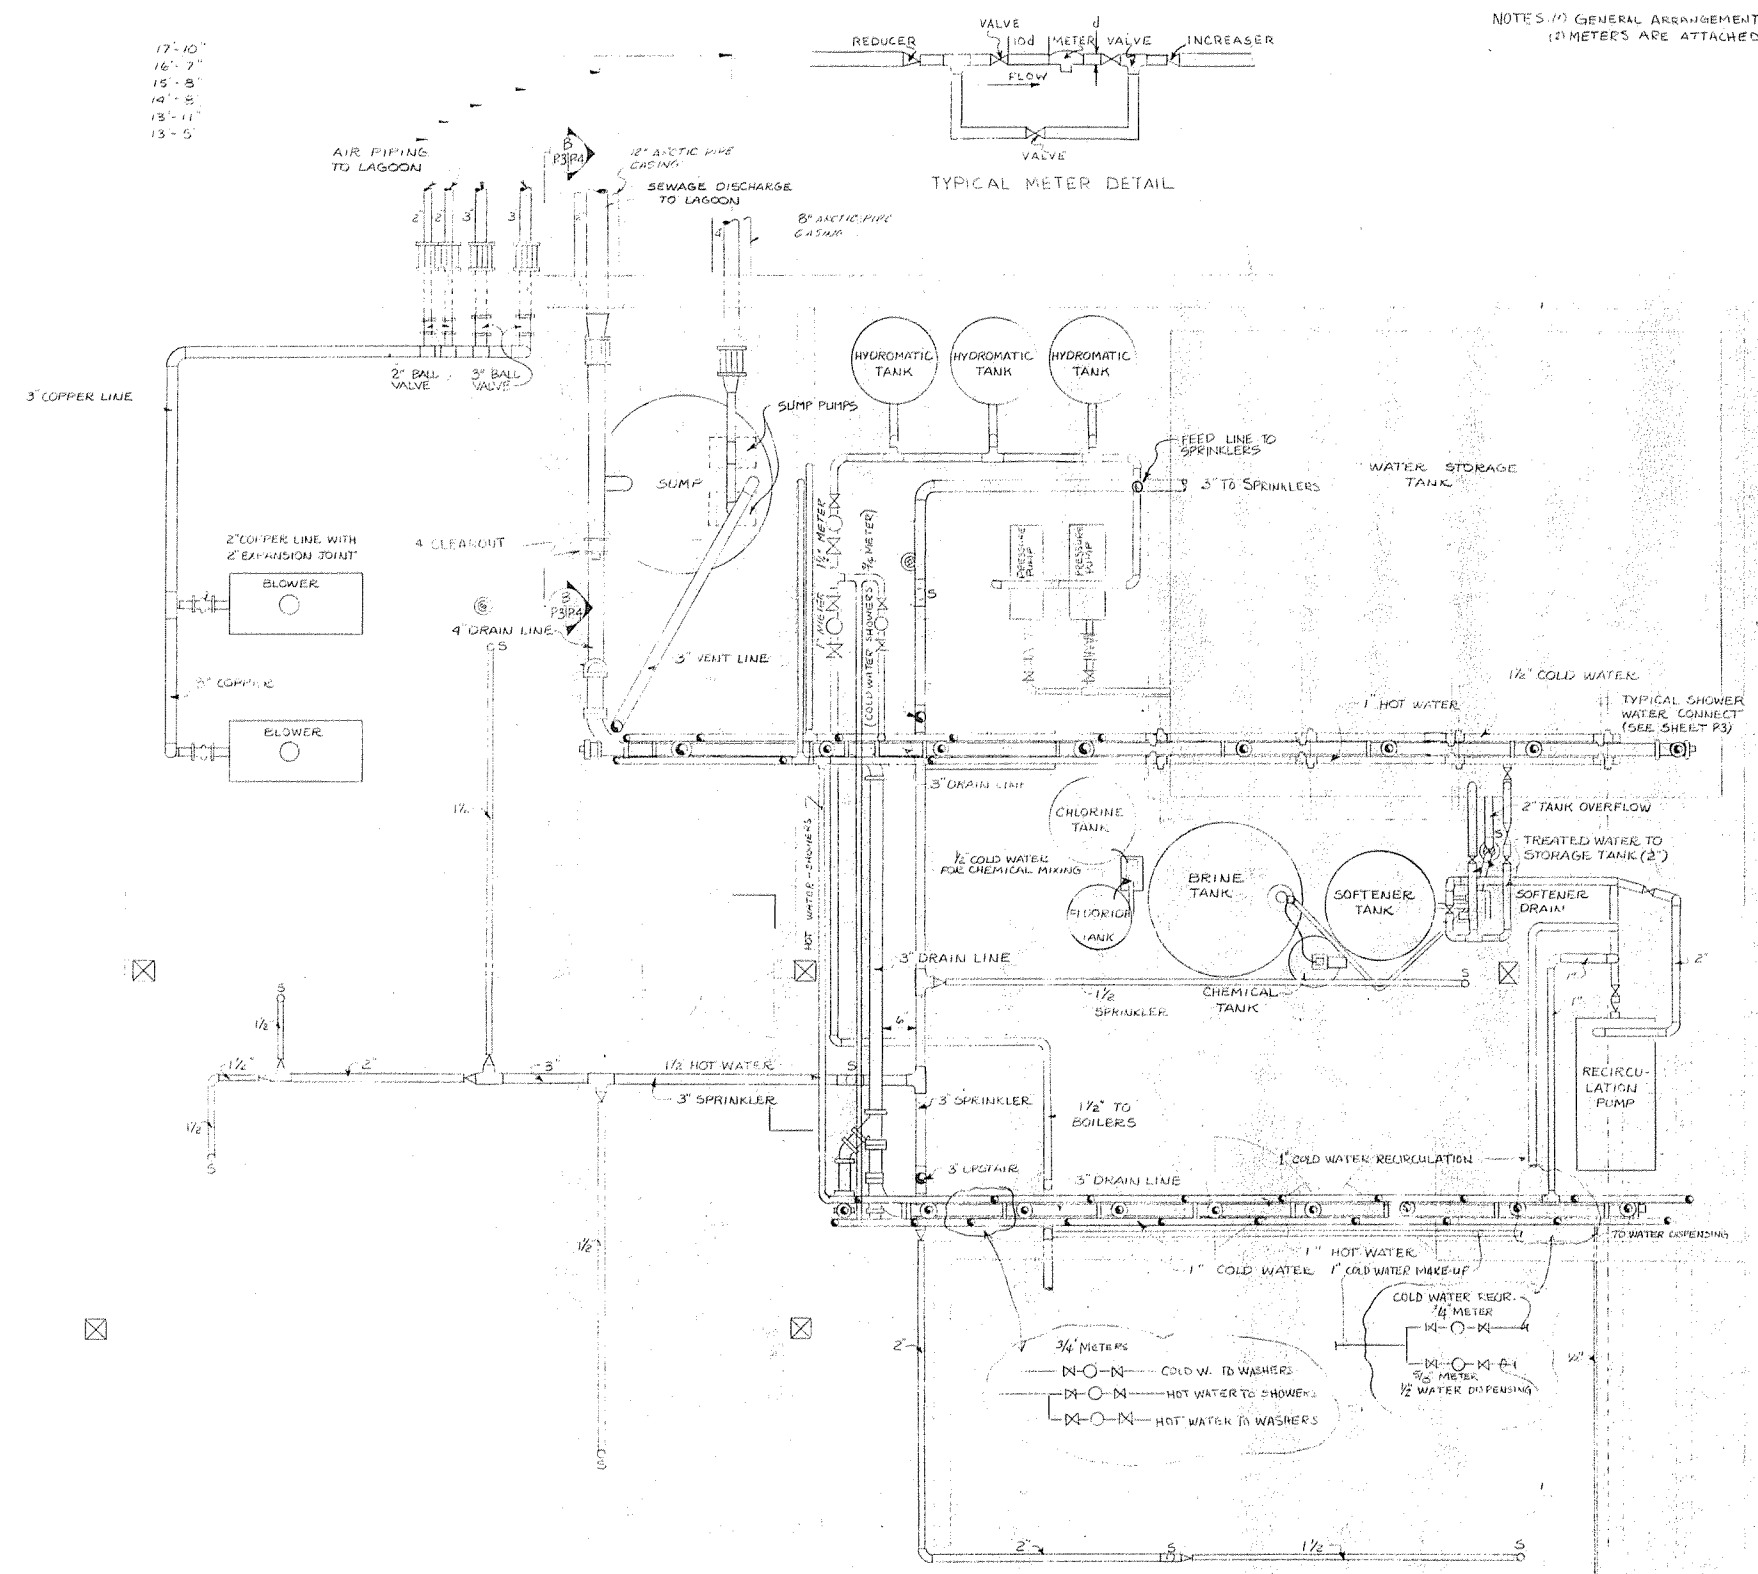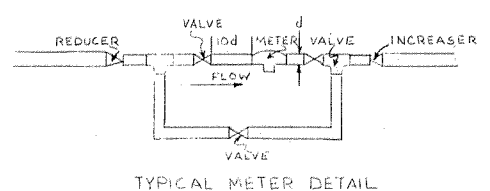

LEGEND
MS SOLENOID VALVE
OS SPRINKLER

2	AS BUILT	7-15-79	MM
1	SEE SKODOLAND Dwg	7-15-79	MM
NO.	REVISION	DATE	BY

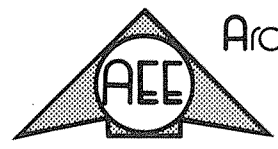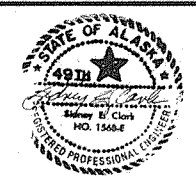



Arctic Environmental Engineers
Anchorage, Alaska

PROJECT NO. 77-024-01 SAV
DESIGNED: WSVH
DRAWN: HEC
CHECKED: SEC
DATE: MARCH 1978
SCALE: 1/2" = 1'-0"

TANANA VSW FACILITY
LOWER LEVEL PIPING


P-4

NOTE: GENERAL ARRANGEMENT DRAWING ONLY

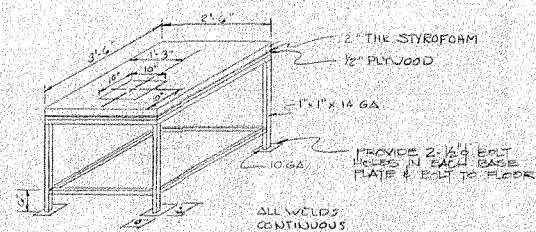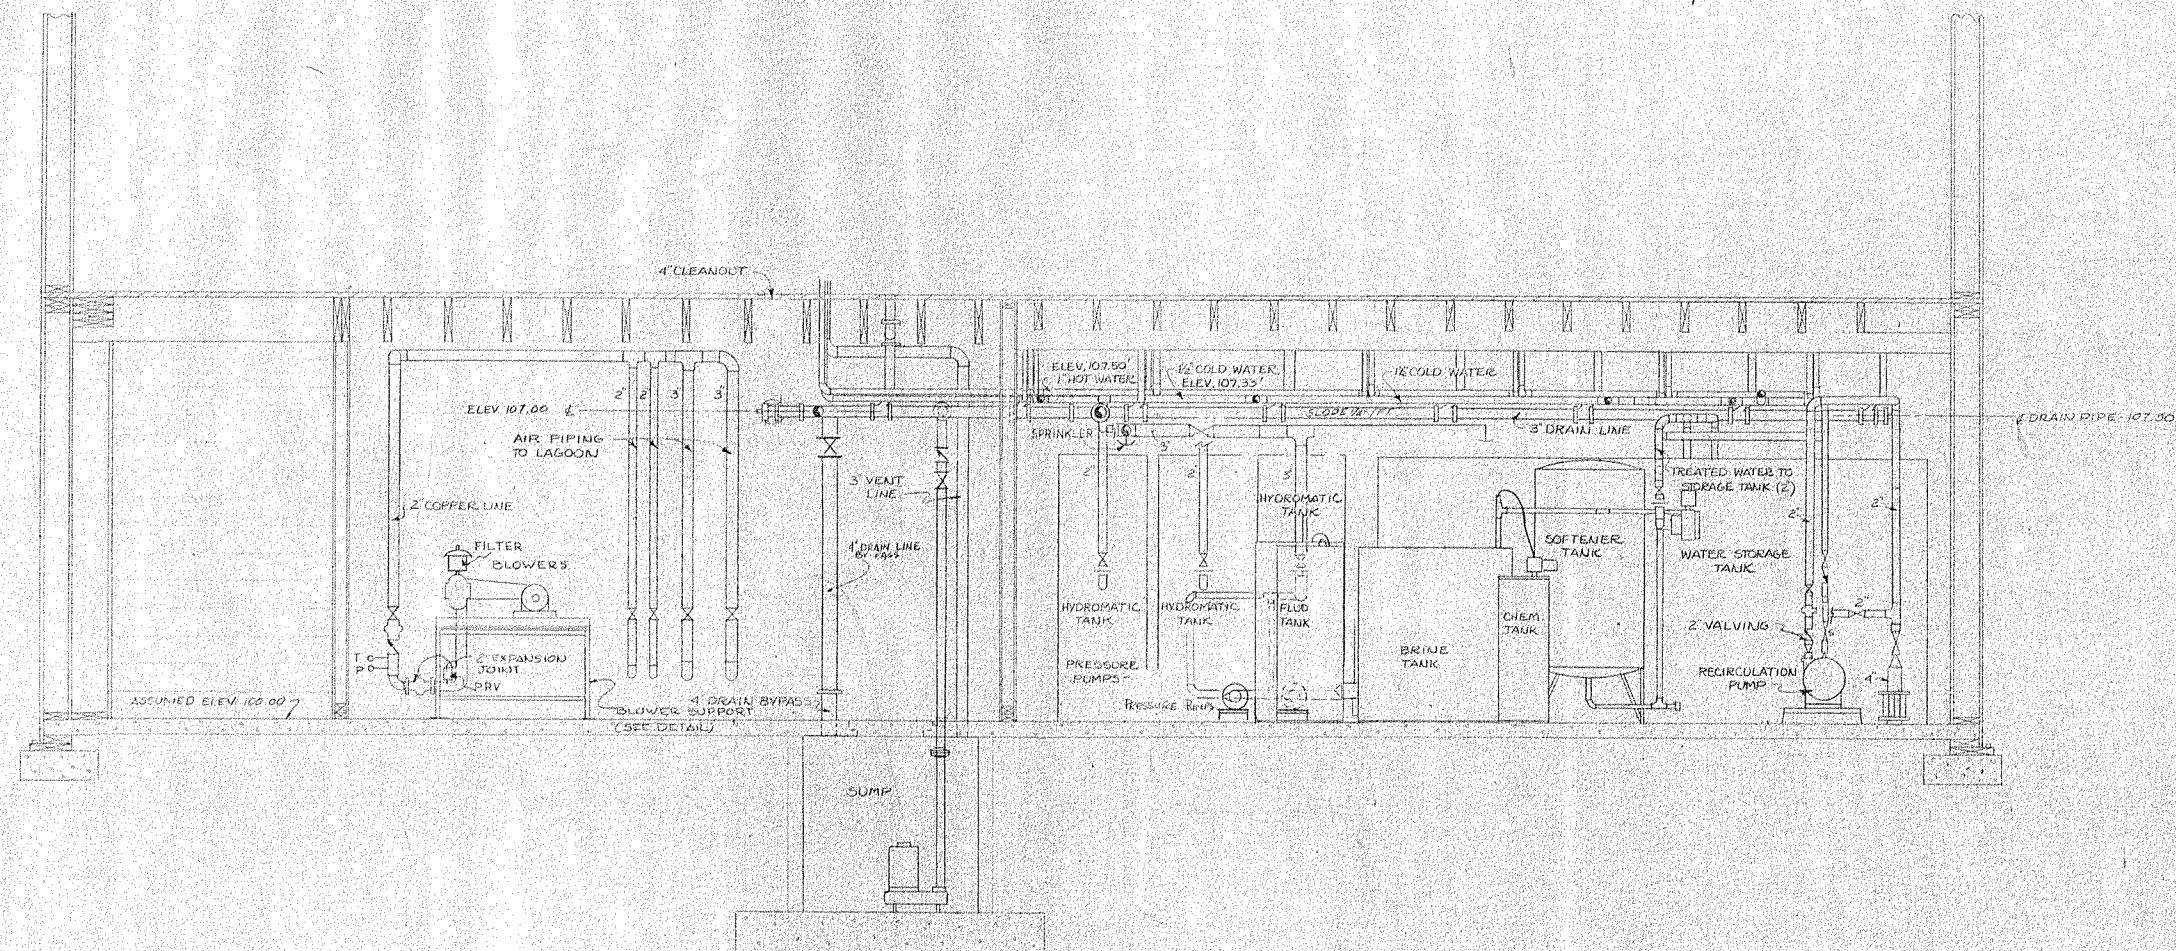

ASBUILT		7-15-79 M	
SEE SKOGLUND DWG'S		7-15-79 M	
NO.	REVISION	DATE	BY

NO.	REVISION	DATE	BY
-----	----------	------	----

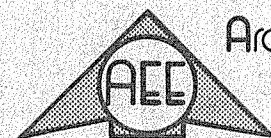


Arctic Environmental Engineers
Anchorage, Alaska

PROJECT NO. 77-024-01 5AM
DESIGNED : WSVH
DRAWN : HEC
CHECKED : SEC
DATE : MARCH 1978
SCALE : 1/2" = 1'-0"

TANANA VSW FACILITY
LOWER LEVEL PIPING SECTION


P-5

SHEET 31 OF 42

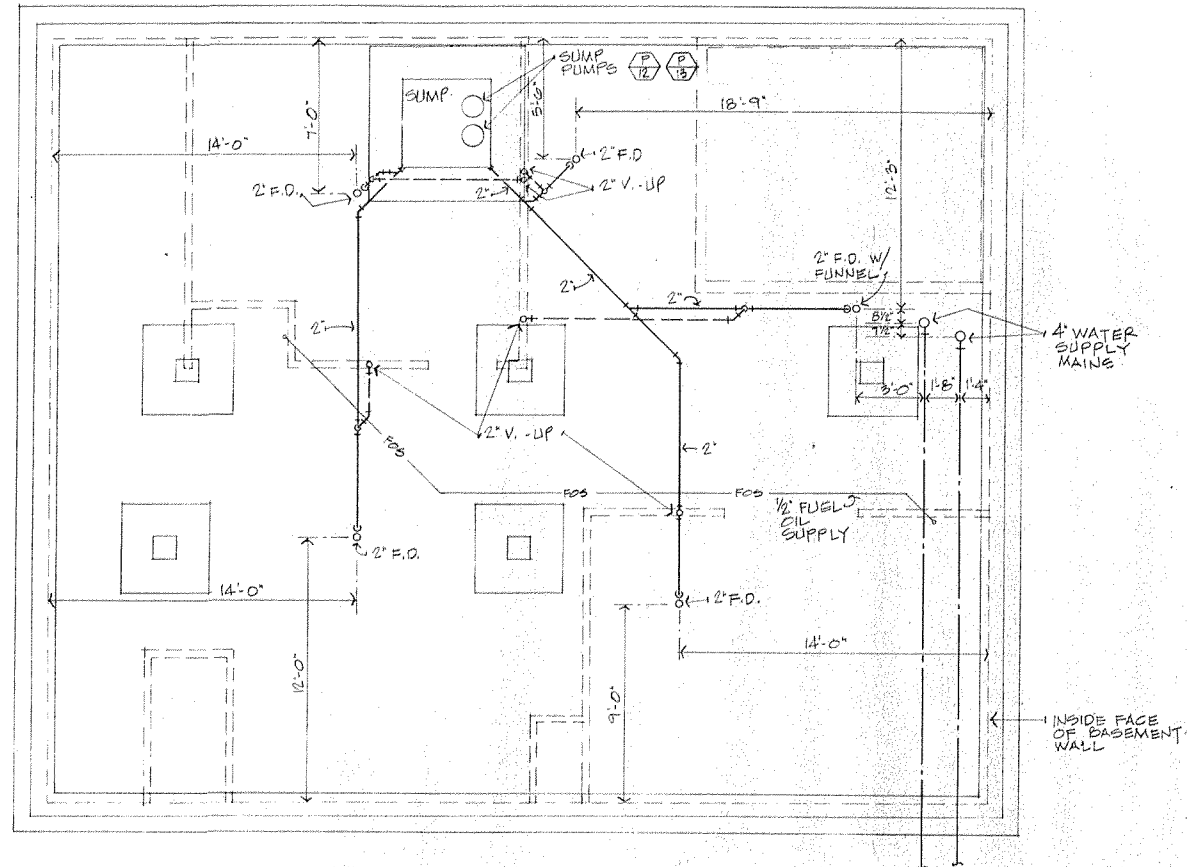

UNDERGROUND PLAN


SCALE: 1/4" = 1'-0"

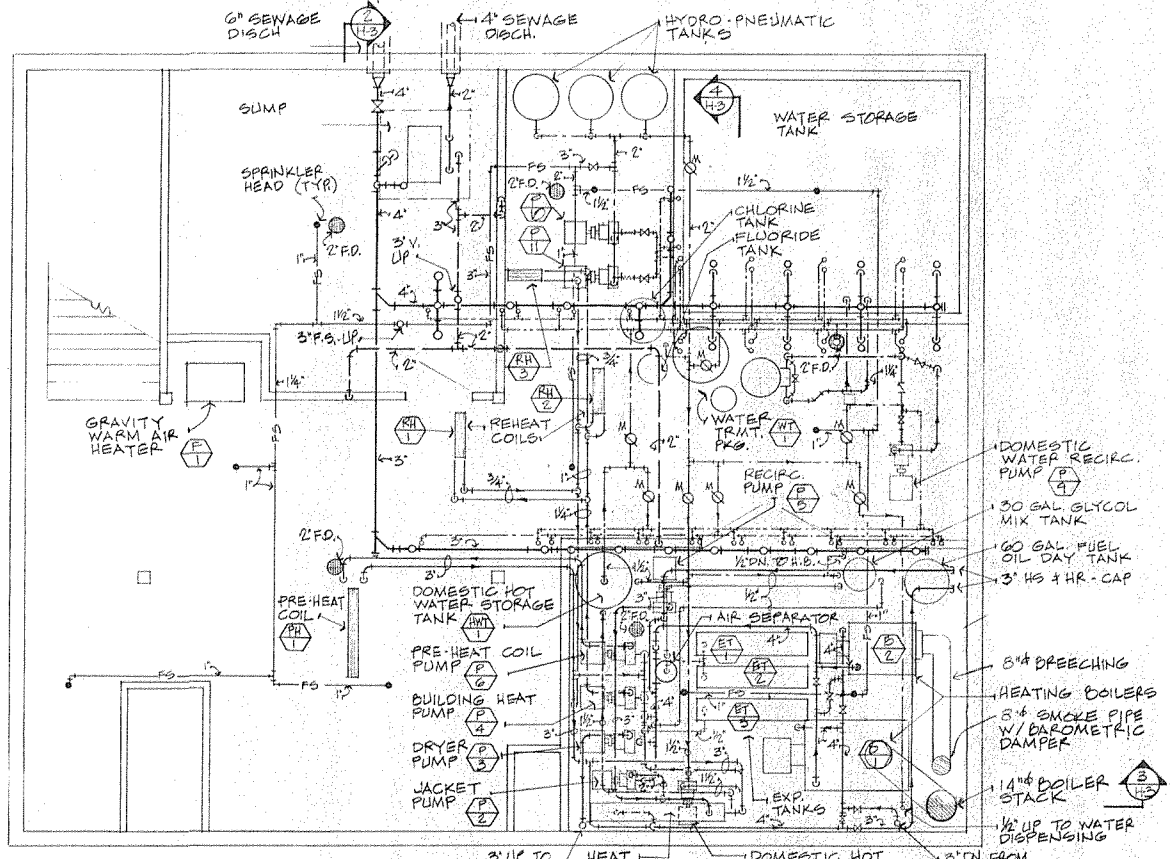

BASEMENT FLOOR PLAN

SCALE: 1/4" = 1'-0"

NOTE
REFER TO SCHEMATICS
ON SHEETS M-4 & M-5 FOR
PIPE SIZES, VALVES AND
ACCESSORIES.

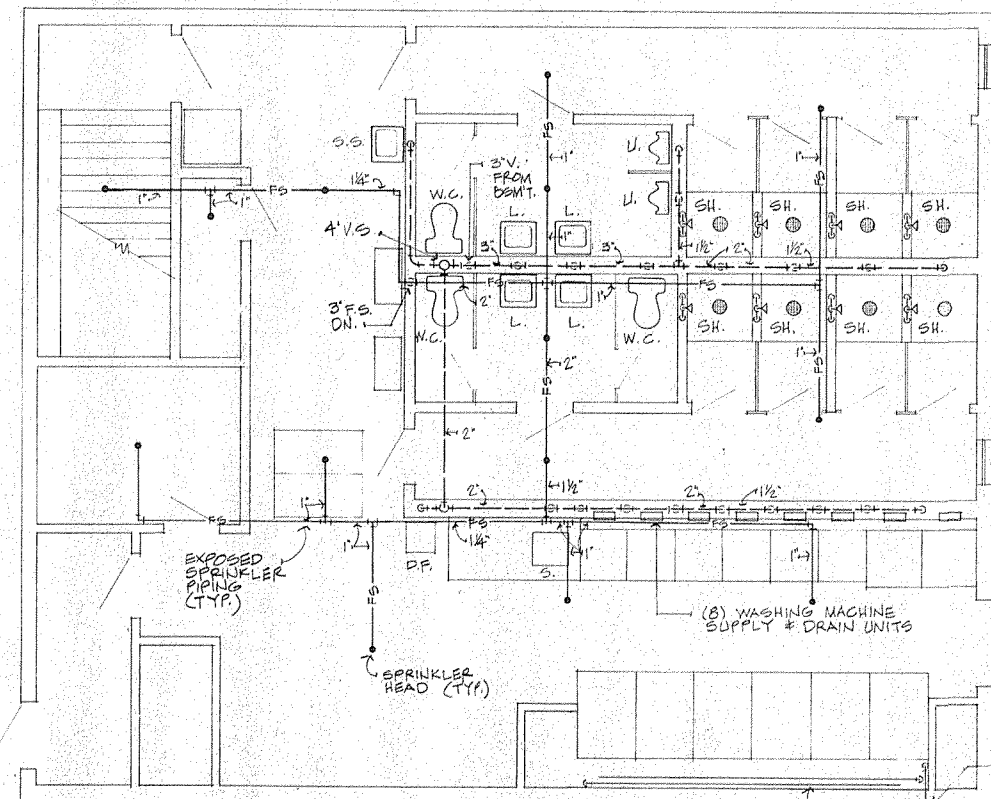

MAIN FLOOR PLAN

SCALE: 1/4" = 1'-0"



CONTRACTORS SHOP DRAWING
TANANA V.S.W. FACILITY
FOR
ARCTIC ENVIRONMENTAL ENGINEERS

FLOOR PLANS
PLUMBING & PIPING

JOB NO:
78286
DRAWN:
LB

CHECKED:

DATE:
7/26/78



SHEET:

P-6

ASBUNT 7-15-79 M


32 - 40

Skoglund Company
Mechanical Engineers & Contractors
Anchorage Alaska

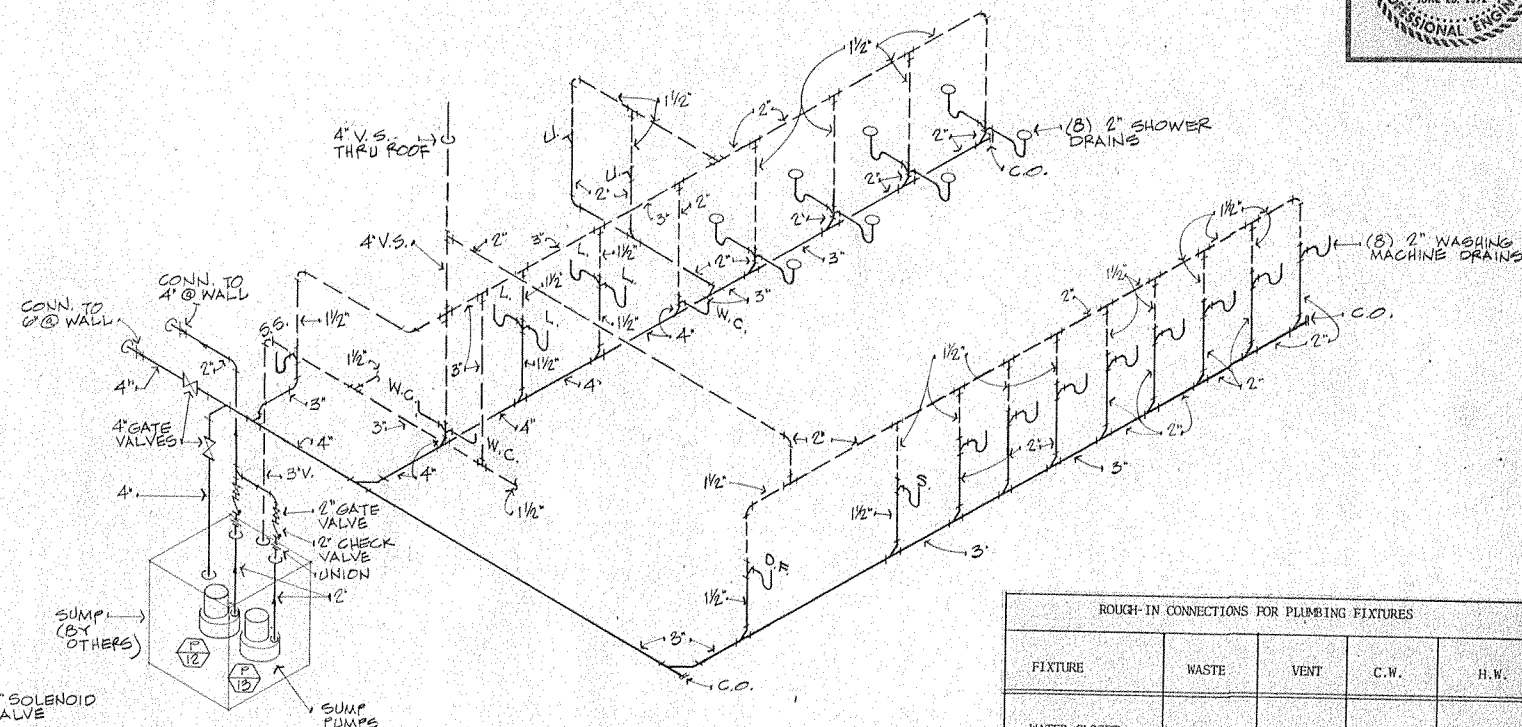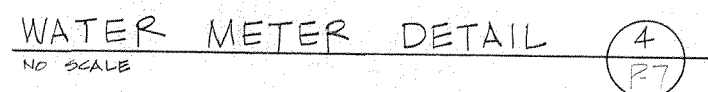


WASTE & VENT SCHEMATIC (1)
NO SCALE (P.7)

NOTE:
INSTALL CAPPED PIPE AIR CHAMBERS
AT ALL FIXTURE CONNECTIONS.
CHAMBERS SHALL BE FIXTURE CONN.
PIPE SIZE X 16" LONG.


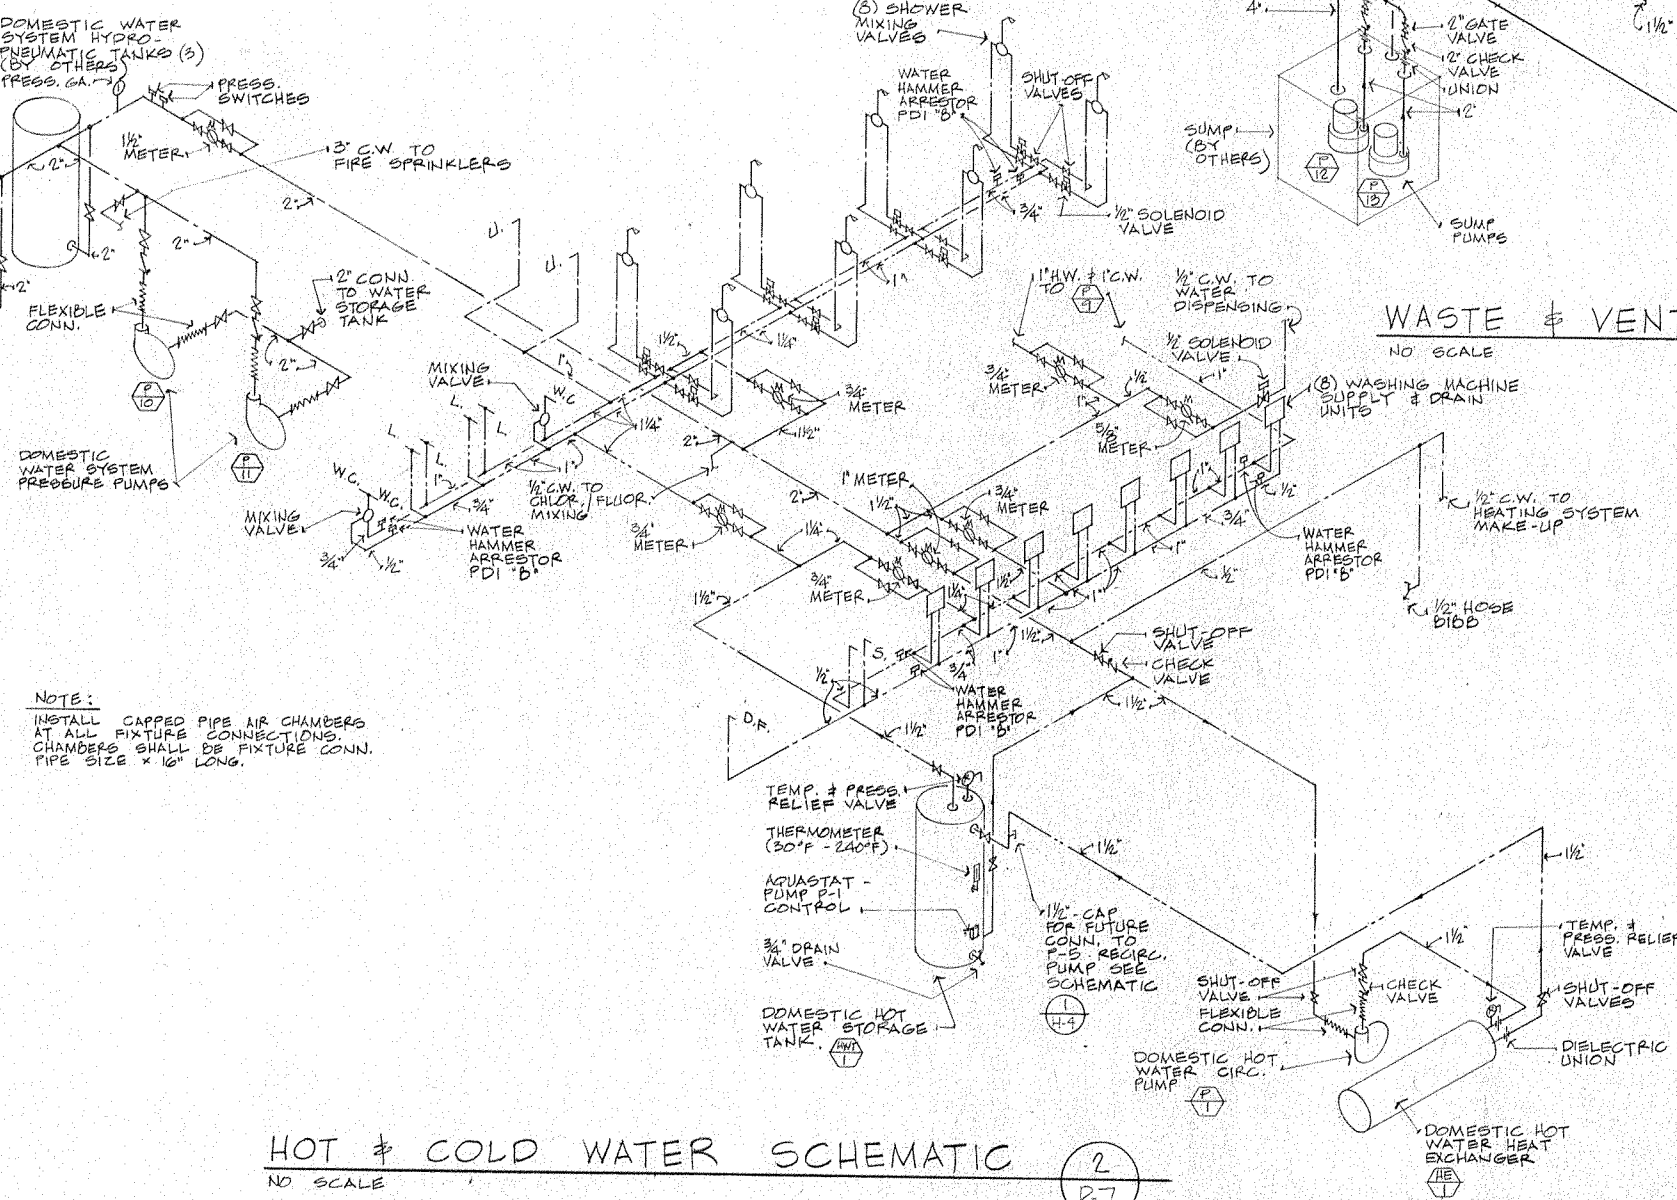


HOT & COLD WATER SCHEMATIC (2)
NO SCALE (P.7)

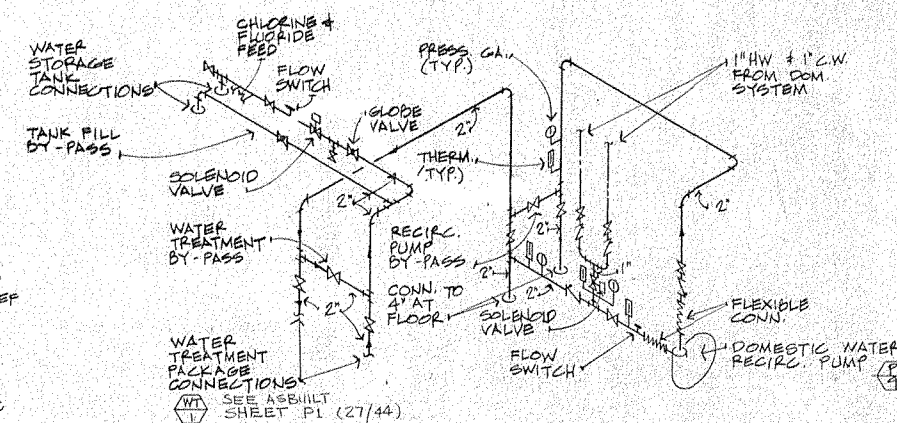



WATER SUPPLY SCHEMATIC

200

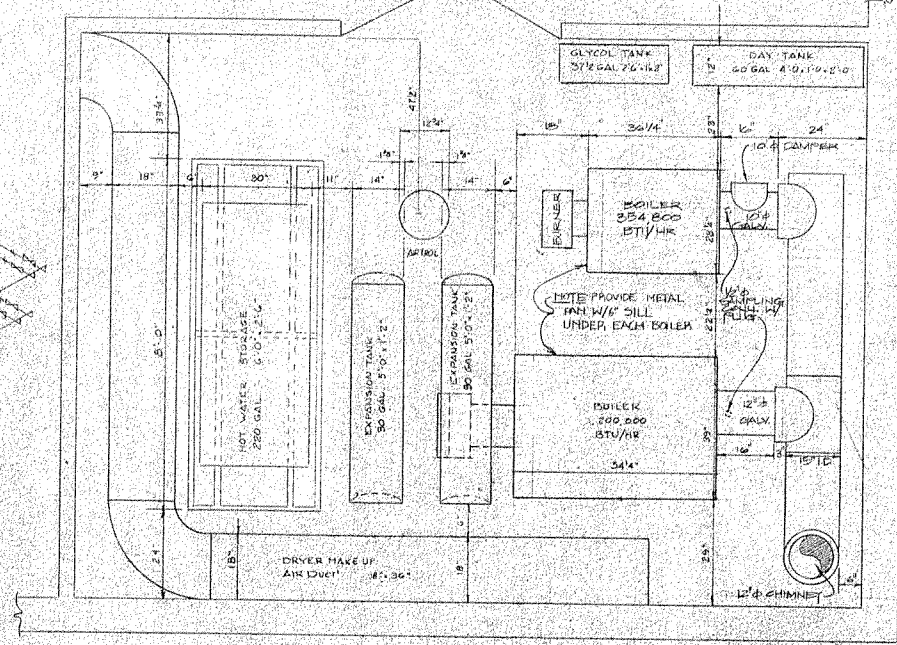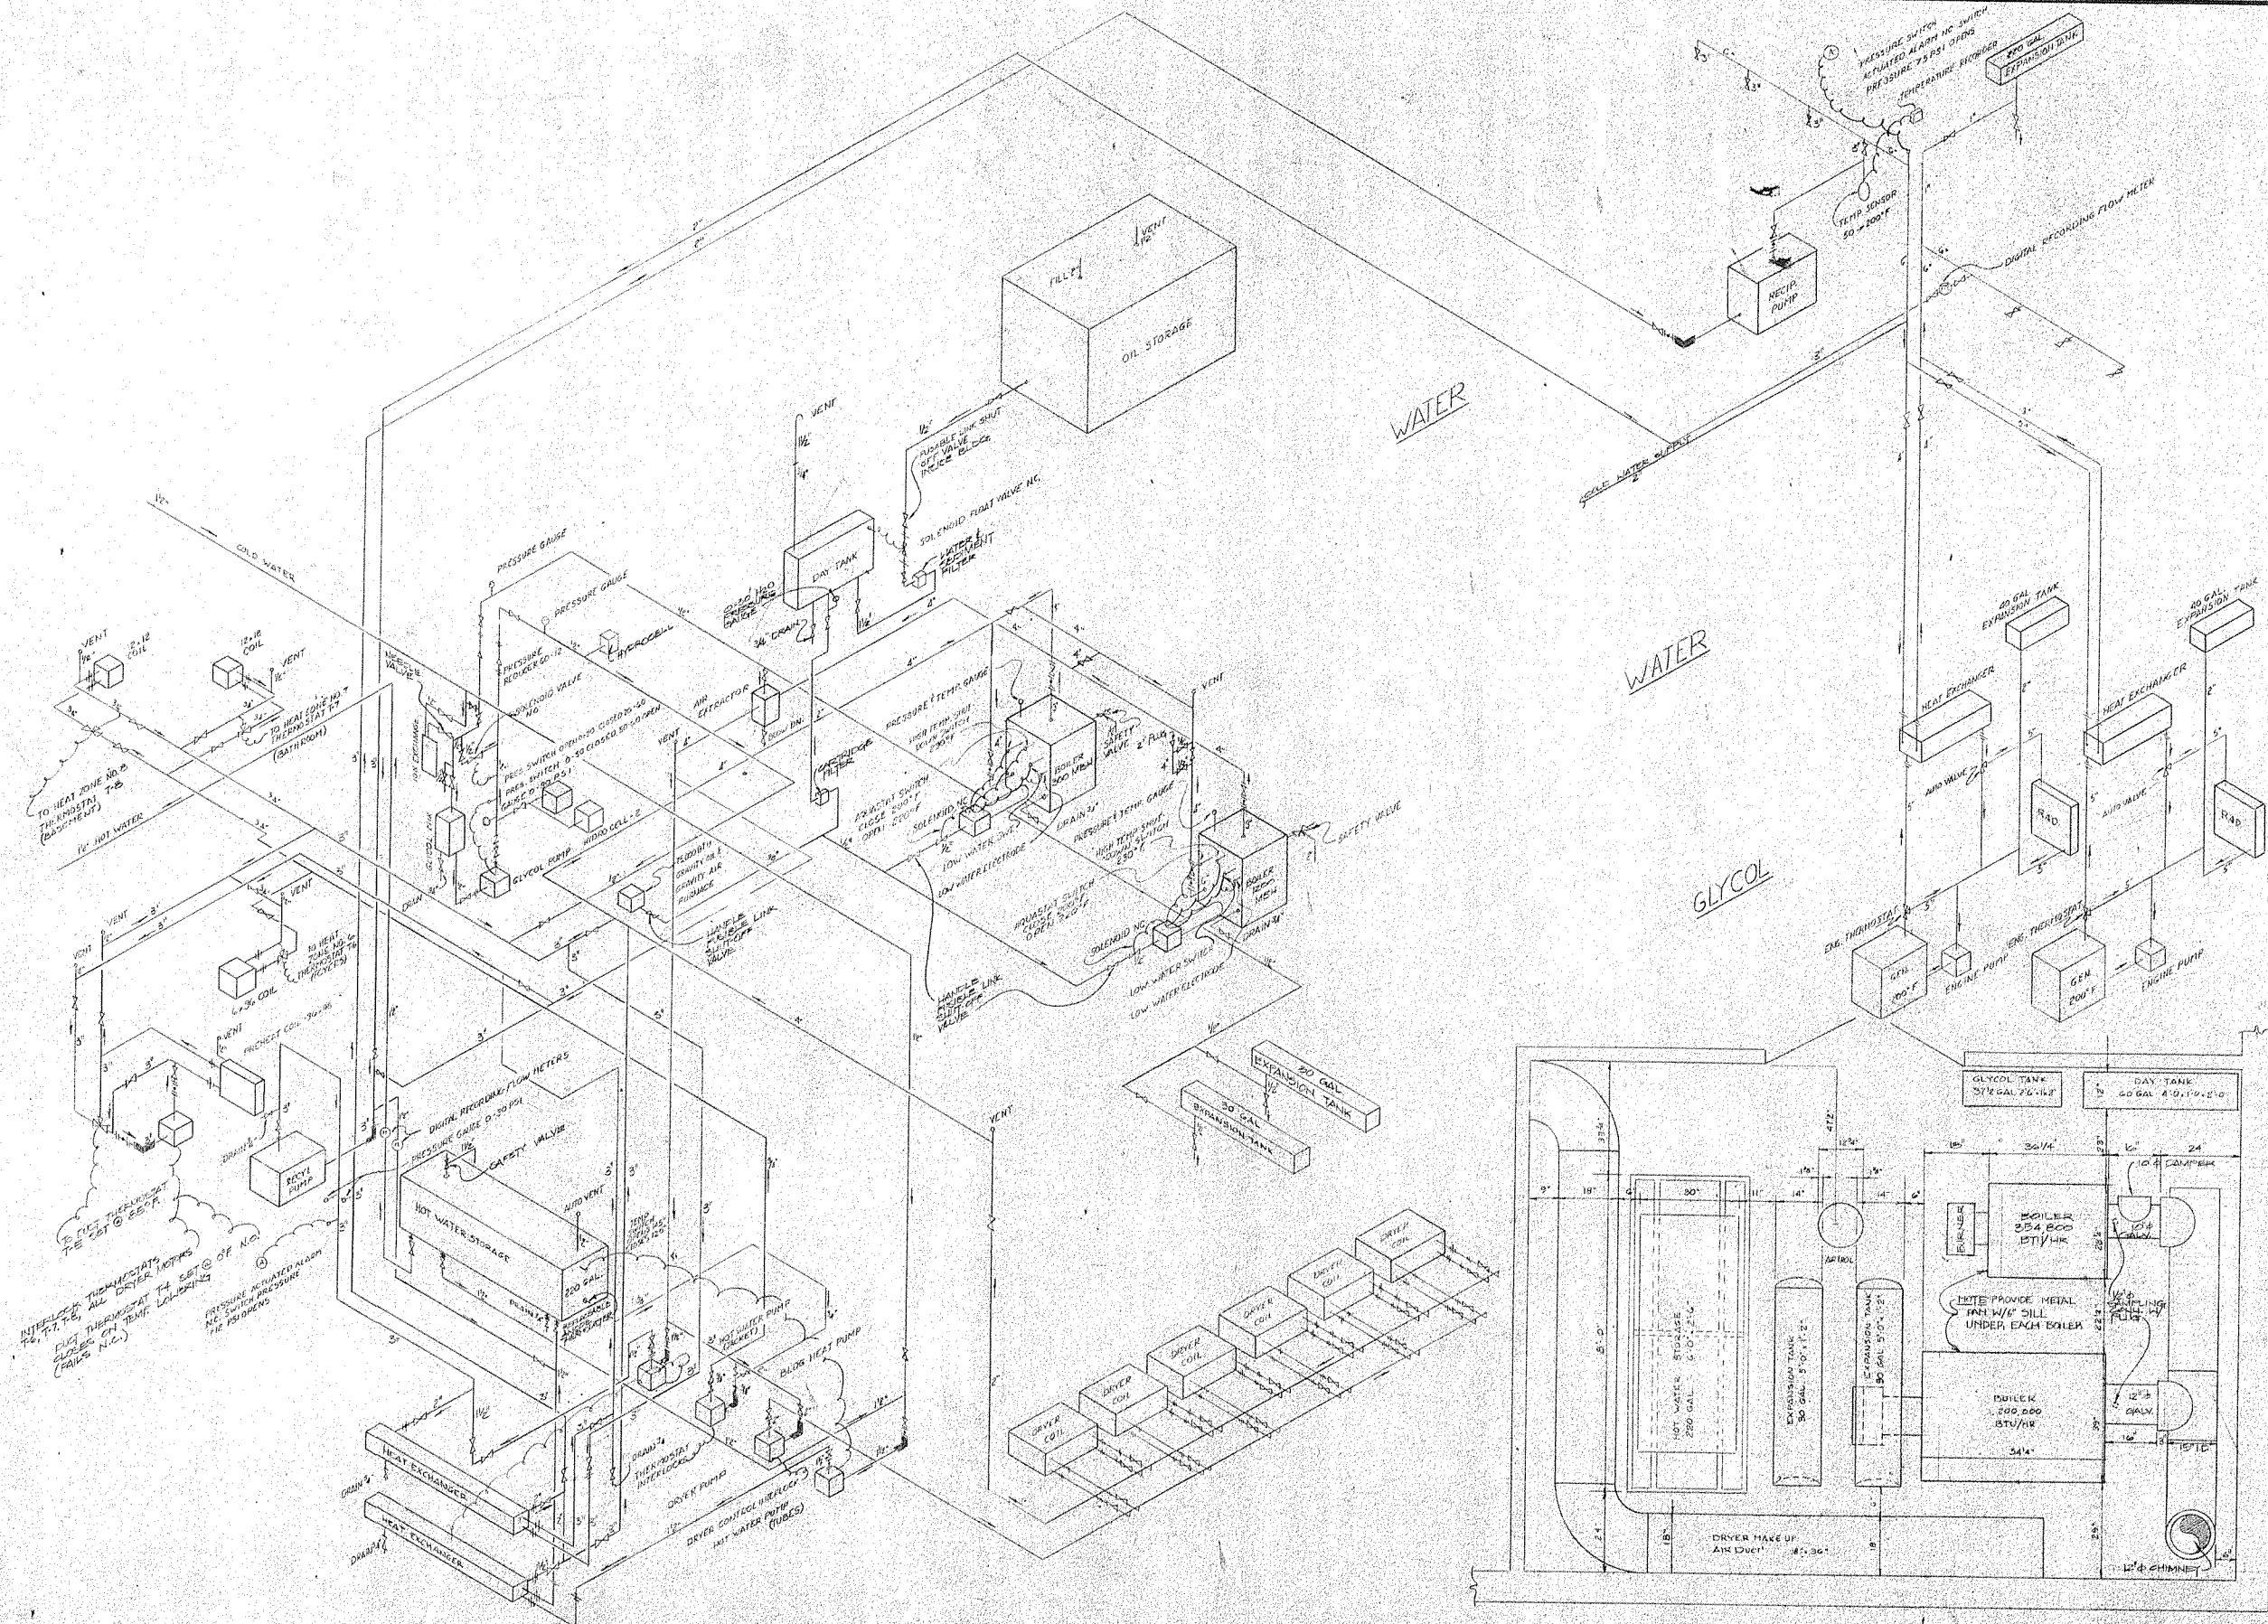

2 ASPIRANT		7-15-79 M.
1 SEE SKOGLUND D.W.'S 7-15-79 M.		
NO.	REVISION	DATE BY

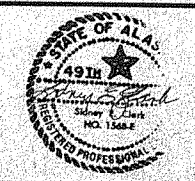


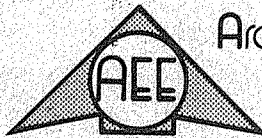

Arctic Environmental Engineers
Anchorage, Alaska

PROJECT NO. 77-024-01 6AV
DESIGNED : ALS
DRAWN : REZ
CHECKED : WSVH
DATE : MARCH 1978
SCALE : NTS

TANANA V. S. V. FACILITY
MECH. HEATING ISO. & PLAN VIEW

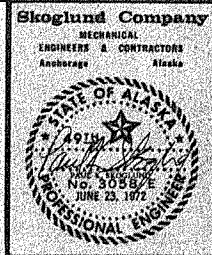


Skoglund Company
Mechanical Engineers & Contractors
Anchorage, Alaska


CONTRACTORS SHOP DRAWING
TANANA V.S.W. FACILITY
FOR
ARCTIC ENVIRONMENTAL ENGINEERS

FLOOR PLANS
SHEETMETAL


JOB NO: 78286
DRAWN: L.S.
CHECKED:
DATE: 7/28/78
SHEET: 35
H-2
OF 46

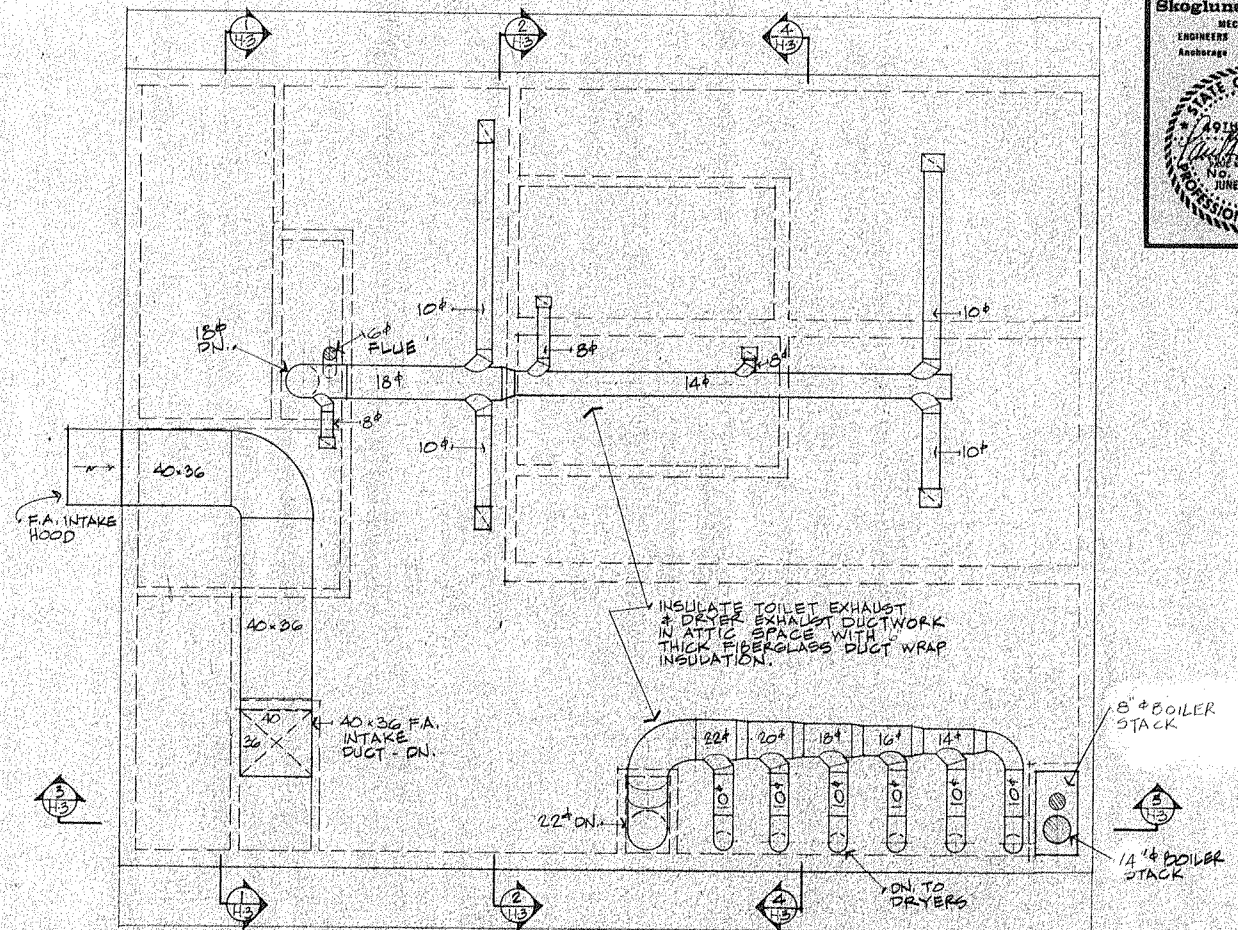


ATTIC PLAN
SCALE: 1/4" = 1'-0"

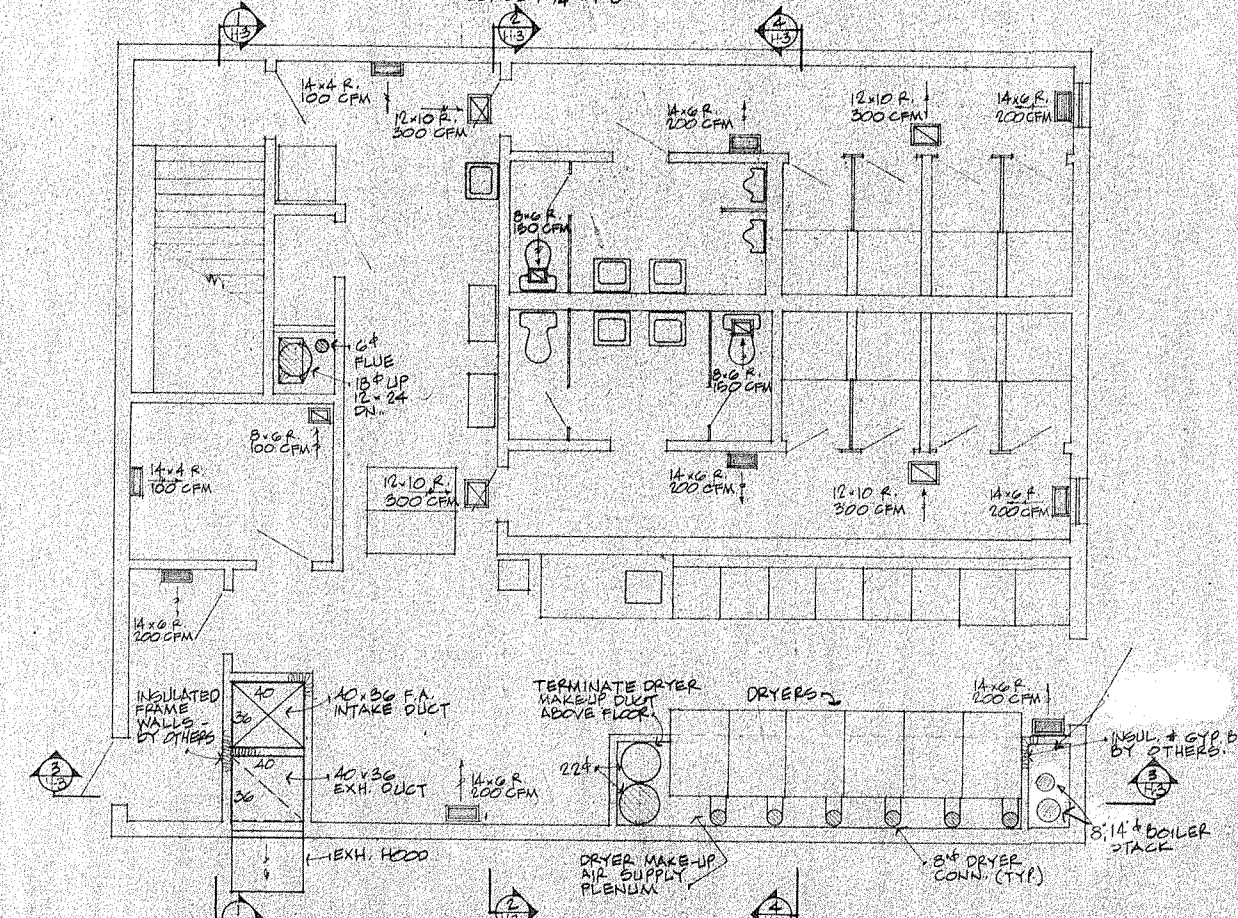

MAIN FLOOR PLAN
SCALE: 1/4" = 1'-0"

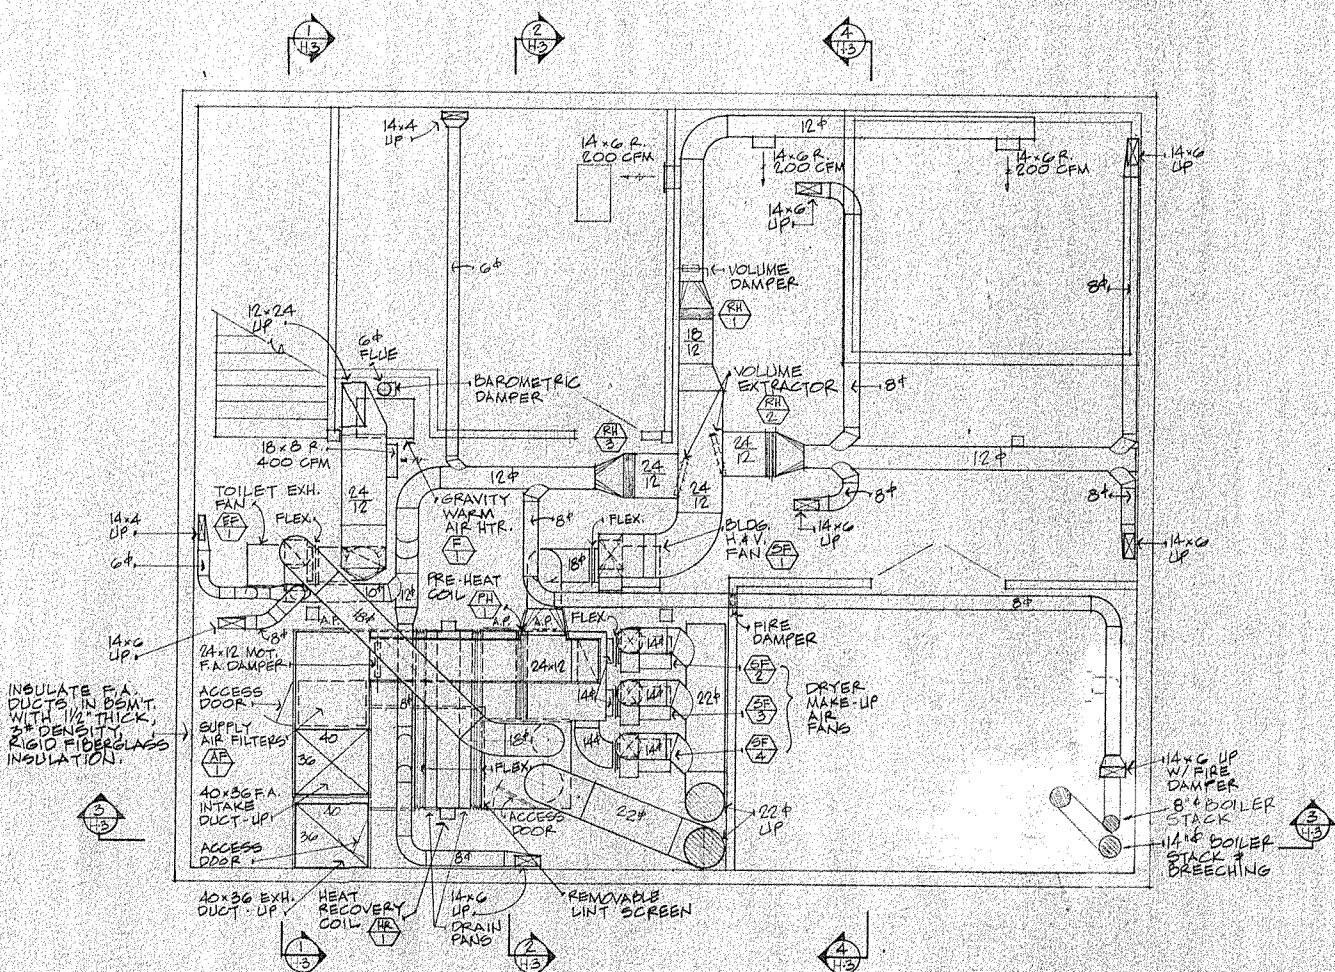

BASEMENT FLOOR PLAN
SCALE: 1/4" = 1'-0"

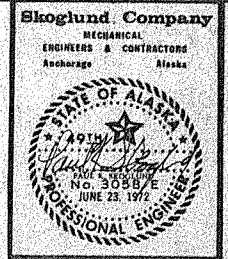


Skoglund Company
Mechanical Engineers & Contractors
Anchorage, Alaska

CONTRACTORS SHOP DRAWING
TANANA V.S.W. FACILITY
ARCTIC ENVIRONMENTAL ENGINEERS

BUILDING SECTIONS


JOB NO. 78286
DRAWN: LS
CHECKED:
DATE: 7/25/78
SHEET: 36
H-3

ASBUILT 7-15-11 M OF 46

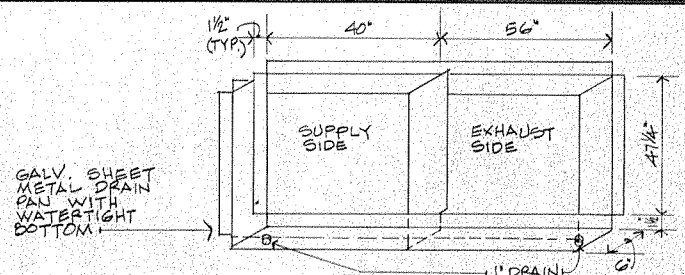


HEAT RECOVERY COIL
DRAIN PAN DETAIL
NO SCALE

5
H-3

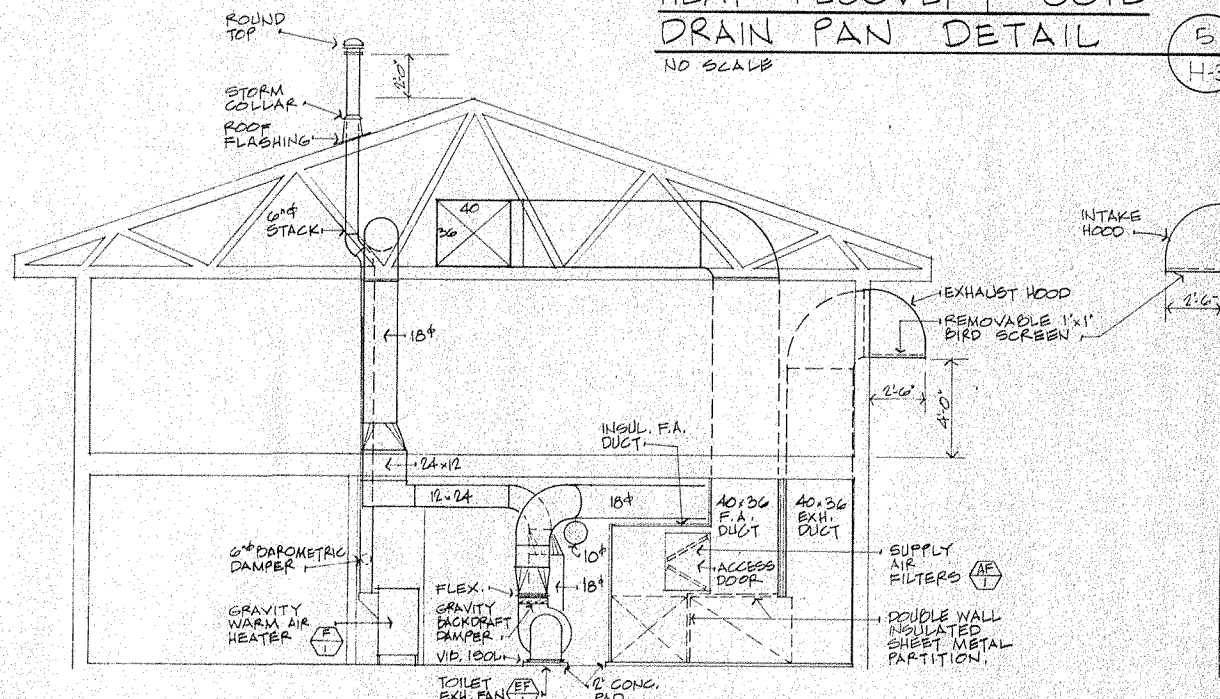


SECTION 1
SCALE: 1/4\"/>

1
H-3

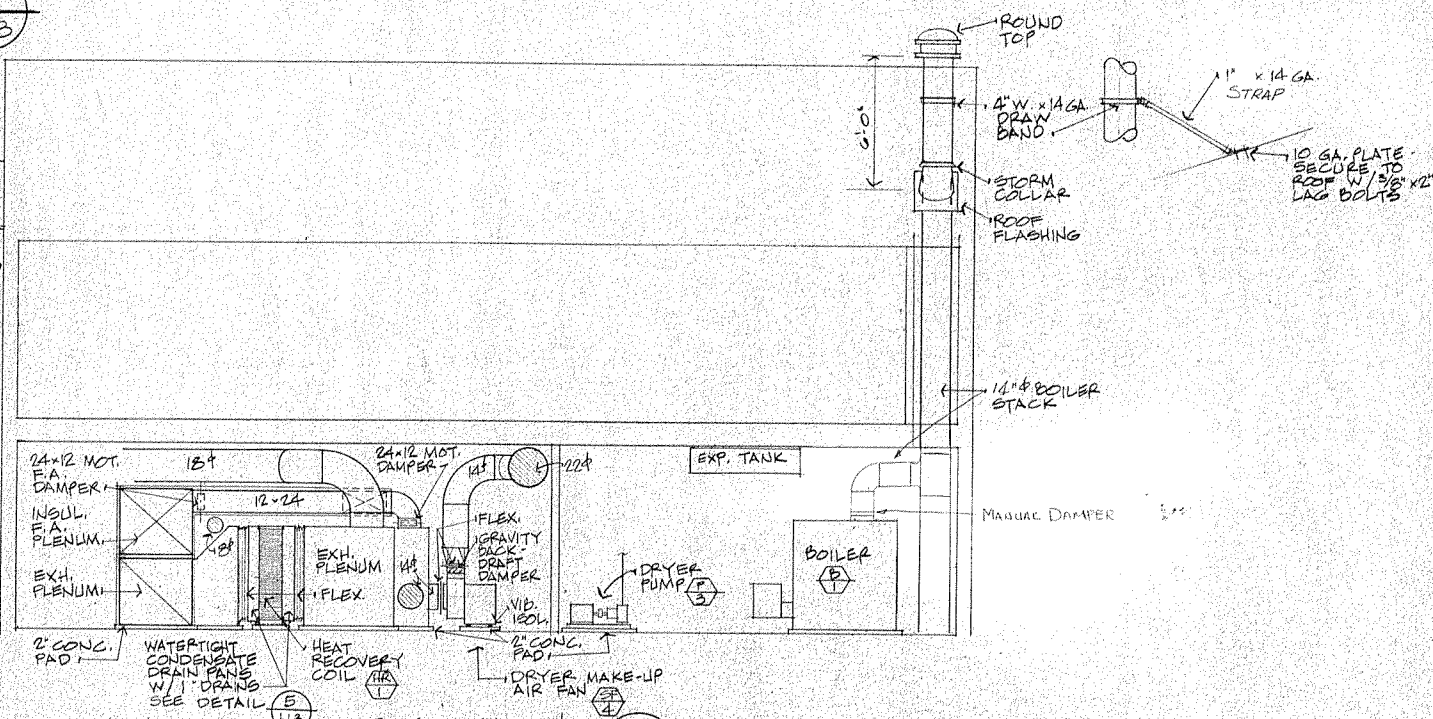


SECTION 3
SCALE: 1/4\"/>

3
H-3

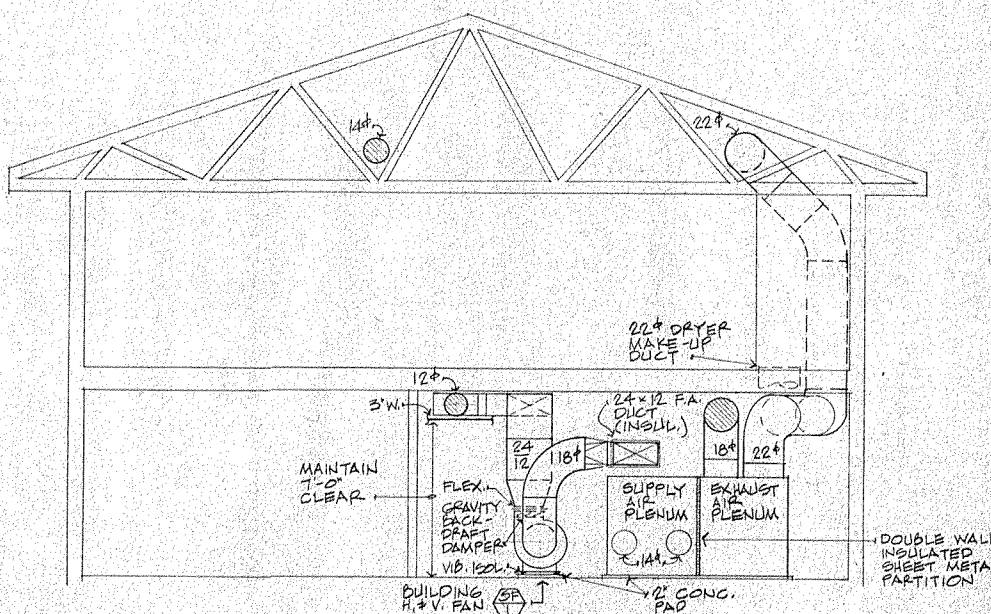


SECTION 2
SCALE: 1/4\"/>

2
H-3

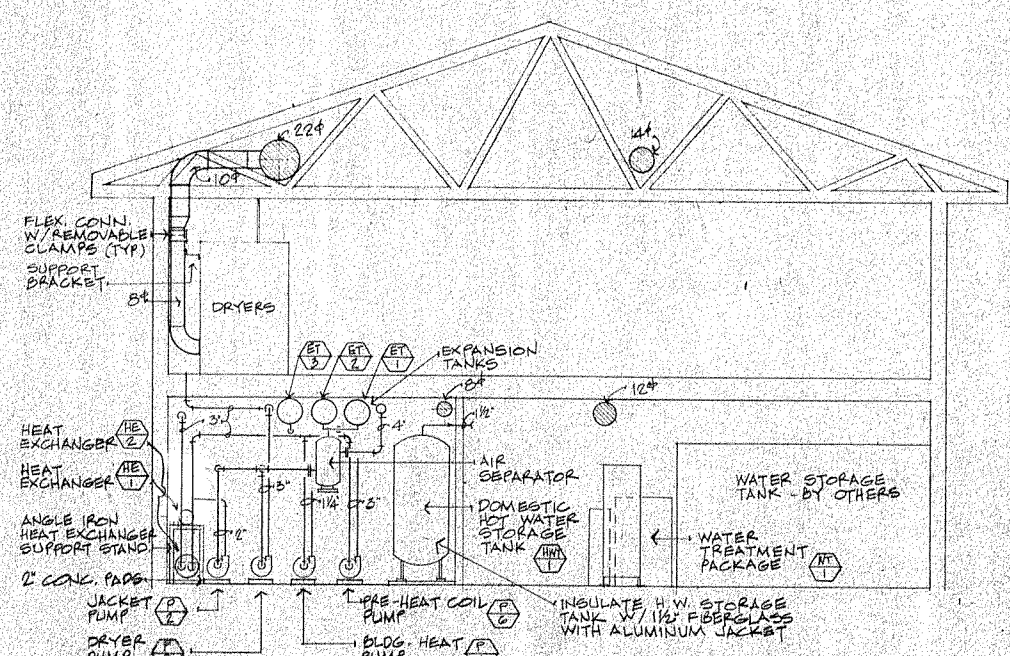

SECTION 4
SCALE: 1/4\"/>

4
H-3

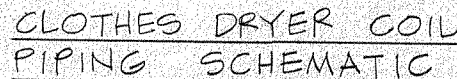

HEATING WATER SYSTEM SCHEMATIC

NO SCALE

FUEL OIL PIPING SCHEMATIC

NO SCALE



NOTES

1. INSTALL HOFFMAN #79 AUTOMATIC AIR VENTS AT SYSTEM HIGH POINTS.
2. INSTALL 1/2" DRAIN VALVES AT SYSTEM LOW POINTS.
3. BOILER ACCESSORIES (EACH BOILER) SHALL INCLUDE LOW WATER CUT-OUT, HIGH LIMIT THERMOSTAT, TEMPERATURE & PRESSURE GAUGE AND OPERATING CONTROL.


NOTE

SEE 8 1/2 X 11 SHEETS IN O & M MANUAL FOR FURTHER HEAT EXCHANGE, BOILER AND DEMINERALIZER DETAILS

MECHANICAL EQUIPMENT SCHEDULE		
SYMBOL	ITEM	DESCRIPTION
	DOMESTIC HOT WATER CIRC. PUMP (TUBES)	END SUCTION, STEEL FRAME MOUNTED, CENTRIFUGAL PUMP, 25 GPM AT 15 FT. TH. 2" SUCT., 1 1/2" DISCH. 1/2 HP, 1750 RPM, 115 V./1/60. PACO 1550-5.
	HEATING WATER PUMP (JACKET)	END SUCTION, STEEL FRAME MOUNTED, CENTRIFUGAL PUMP, 50 GPM AT 10 FT. TH. 2" SUCT., 1 1/2" DISCH. 1/2 HP, 1750 RPM, 115 V./1/60. PACO 1550-5.
	HEATING WATER PUMP (DRYERS)	END SUCTION, STEEL FRAME MOUNTED, CENTRIFUGAL PUMP, 85 GPM AT 50 FT. TH. 2" SUCT., 1 1/2" DISCH. 2 HP, 1750 RPM, 230 V./3/60. PACO 1570-1.
	HEATING WATER PUMP (BUILDING HEAT)	END SUCTION, STEEL FRAME MOUNTED, CENTRIFUGAL PUMP, 20 GPM AT 30 FT. TH. 1 1/2" SUCT., 1" DISCH. 1/2 HP, 1750 RPM, 115 V./1/60. PACO 1070-1.
	HEATING WATER PUMP (RECTRC. PUMP)	END SUCTION, STEEL FRAME MOUNTED CENTRIFUGAL PUMP, 100 GPM AT 25 FT. TH. OR 200 GPM AT 15 FT. TH. 3" SUCT. 2 1/2" DISCH. 2 HP, 1750 RPM, 230 V./3/60. PACO 2570-5.
	HEATING WATER PUMP (PRE-HEAT COIL)	END SUCTION, STEEL FRAME MOUNTED CENTRIFUGAL PUMP, 110 GPM AT 20 FT. TH. 2" SUCT. 1 1/2" DISCH. 2 HP, 1750 RPM, 230 V./3/60. PACO 1570-1.
	GLYCOL FEED PUMP	REGENERATIVE TURBINE PUMP, FRAME MOUNTED. 1/2 HP 1750 RPM 115 V./1/60. PACO MODEL C-10.
	WELL PUMP	SUBMERSTIBLE WELL PUMP, 9 STAGE, 1 1/2" DISCH. 20 GPM AT 175 FT. TH. 250 FT. S.O. HD. 1 1/2 HP 1750 RPM 230 V./1/60. MEYERS SGK 15-15 B.
	DOMESTIC WATER RECTRC. PUMP	END SUCTION, STEEL FRAME MOUNTED CENTRIFUGAL PUMP, 100 GPM AT 30 FT. TH. 2" SUCT., 1 1/2" DISCH. 2 HP 1750 RPM, 230 V./3/60. PACO 1570.
 	DOMESTIC WATER SYSTEM PRESS. PUMPS.	END SUCTION, STEEL FRAME MOUNTED, CENTRIFUGAL PUMP, 40 GPM AT 110 FT. TH. 1 1/2" SUCT. 1 1/2" DISCH. 2 HP, 3500 RPM, 230 V./3/60. PACO 1250-5.
 	SUMP PUMPS	SUBMERSTIBLE NON-CLOG DUPLEX PUMP SET, 50 GPM AT 20 FT. TH. 1 HP 1750 RPM 230 V/3/60. HYDROMATIC MODEL SK-60AD3-4 WITH CONTROL PANEL, ALTERNATOR, LEVEL CONTROLS AND HIGH LEVEL ALARM.
	WATER TREATMENT PACKAGE	PACKAGE SHALL CONSIST OF BRINE TANK, CHEMICAL TANK AND EXCHANGE TANK, WITH COMPLETE PIPING, VALVES AND CONTROLS. SERVICE FLOW RATE: 25 GPM PEAK, 12 GPM CONTINUOUS. PRESSURE RANGE: 30-100 PSI. TEMPERATURE RANGE: 40° TO 140°F. 120 V./1/60. CULLIGAN HF-20.
		
		
		
		
	DOMESTIC HOT WATER STORAGE TANK	220 GALLON ASME GLASS LINES STORAGE TANK. VERTICAL MOUNTING. 30" DIA. X 6'-0" H. FACE BUZZBLER VS30-5G.
		
	DOMESTIC HOT WATER HEAT EXCHANGER	6" Ø X 5'-0" L., 4 PASS, STRAIGHT TUBE, TUBES: 25 GPM, 40°F EWT, 140°F LWT. SHELL: 50 GPM, 220°F EWT, 180°F LWT. FOULING ALLOWANCE .001, B & G OF-65-4.
	GLYCOL SYSTEM HEAT EXCHANGER	12" Ø X 6' -0" L., 4 PASS, STRAIGHT TUBE. TUBES: 130 GPM, 148°F EWT, 165°F LWT. (GLYCOL) SHELL: 100 GPM, 175°F EWT, 155°F LWT. FOULING ALLOWANCE .001, B & G OF-126-4.

MECHANICAL EQUIPMENT SCHEDULE		
SYMBOL	ITEM	DESCRIPTION
	BOILER	PACKAGE BOILER/BURNER UNIT. NO. 2 OIL FIRED, 12.65 GPH (1771 MBH) INPUT. 1257 MBH IBR NET OUTPUT. BURNHAM AMERICA PF-509-WO. WITH RELIEF VALVE, TEMP.-PRESS. GAUGE, HIGH LIMITS AND LOW WATER CUT-OFF.
	BOILER	PACKAGE BOILER/BURNER UNIT. NO. 2 OIL FIRED, 3.95 GPH (553 MBH) INPUT. 391 MBH IBR NET OUTPUT. BURNHAM AMERICA PF-36W. WITH RELIEF VALVE, TEMP. PRESS. GAUGE, HIGH LIMITS AND LOW WATER CUT-OFF.
 	EXPANSION TANK	30 GALLON ASME EXPANSION TANK. 13" Ø X 61 1/2" L. WITH B & G TANK FITTING, GAUGE GLASS AND DRAIN VALVE.
	EXPANSION TANK	30 GALLON ASME EXPANSION TANK. 13" Ø X 61 1/2" L. WITH B & G TANK FITTING, GAUGE GLASS AND DRAIN VALVE.
		
	GRAVITY WARM AIR HEATER	75 MBH INPUT, 56.6 MBH OUTPUT, GRAVITY #2 OIL FIRED, GRAVITY WARM AIR HEATER. PREWAY MODEL DWM-75.
		
	SUPPLY AIR FILTERS	4 - 20" X 25" X 2" THICK THROW-AWAY FILTERS. FARR 30/30.
		
	BUILDING H. & V. FAN	BELT DRIVE UTILITY FAN. 2200 CFM AT 1.75" S.P. 1700 FPM O.V., 1700 RPM, CCW ROTATION, UB DISCHARGE, 15" Ø WHEEL, 2 HP 230V./3/60. WITH VIBRATION ISOLATORS AND GRAVITY BACKDRAFT DAMPER.
   	DRYER MAKE-UP AIR FAN	BELT DRIVE UTILITY FAN. 1200 CFM AT 1.5" S.P. 1900 FPM O.V. 1300 RPM, CCW ROTATION, UB DISCHARGE 10" FC WHEEL, 1 HP 230V./3/60, WITH VIBRATION ISOLATORS AND GRAVITY BACKDRAFT DAMPER.
	TOILET EXHAUST FAN	BELT DRIVE UTILITY FAN 2000 CFM AT 1.0" S.P. 1560 FPM O.V., 1770 RPM, CW ROTATION, UB DISCHARGE, 15" F.C. WHEEL 1 HP 230V./3/60 WITH VIBRATION ISOLATORS AND GRAVITY BACKDRAFT DAMPER.
		
	HEAT RECOVERY COIL	48" W X 96" NTL, 6 ROW SUPPLY: 5800 CFM, -60°F EAT, .25" WG. ΔP. EXHAUST: 5600 CFM, 135°F EAT, .25" WG. ΔP. Q-DOT WITH TILT CONTROL.
	PRE-HEAT COIL	48" W X 48" NTL, 5800 CFM, -65°F EAT, 85°F LAT, 175°F EWT, 155°F LWT. (50% GLYCOL)
	REHEAT COIL (LAUNDRY ROOM)	12" W X 24" NTL. 800 CFM, 55°F EAT, 115°F LAT, 175°F EWT, 155°F LWT. (50% GLYCOL)
	REHEAT COIL (SHOWERS)	12" W. X 24" NTL. 800 CFM, 55°F EAT, 115°F LAT, 175°F EWT, 155°F LWT (50% GLYCOL)
	REHEAT COIL (BASEMENT)	12" W. X 18" NTL. 600 CFM, 55°F EAT, 115°F LAT, 175°F EWT, 155°F LWT (50% GLYCOL)

MECHANICAL EQUIPMENT SCHEDULE		
SYMBOL	ITEM	DESCRIPTION
	WATER CLOSET	AMERICAN STANDARD CADET 2109.056, ELONGATED SIPHON JET ACTION BOWL, CLOSE COUPLED TANK, FREE STANDING, WHITE VITREOUS CHINA. WITH WHITE OPEN FRONT SEAT AND 1/4" ANGLE COMPRESSION SUPPLY.
	URINAL	AMERICAN STANDARD WASHBROOK 6500.011 WHITE VITREOUS CHINA, 3/4" TOP SPUD, 2" OUTLET. DELANEY 451 FLUSH VALVE WITH VACUUM BREAKER.
	LAVATORY	AMERICAN STANDARD SCOTIAN 0361.055, WHITE VITREOUS CHINA. FAUCET HOLES ON 4" CENTERS. 2379.018 AQUARIAN II FAUCET WITH POP-UP DRAIN, 1 1/4" TAILPIECE AND 1 1/4" P-TRAP, 1/2" ANGLE COMPRESSION SUPPLIES.
	SERVICE SINK	AMERICAN STANDARD LAKEWELL 7692.049 ENAMELED CAST IRON SERVICE SINK WITH 7798.176 TRAP AND 8340.234 SERVICE SINK FAUCET.
	DRINKING FOUNTAIN	AMERICAN STANDARD SARATOGA 8310.112 WHITE VITREOUS CHINA, ANGLE JET BUBBLER, WITH 1 1/4" TRAP.
	LAUNDRY SINK	AMERICAN STANDARD LEDGEMOUNT 7601.016 ENAMELED CAST IRON LAUNDRY SINK WITH 4200.010 AQUARIAN II SINK FAUCET. 4362.034 STOPPER BRAIN, 1 1/2" P-TRAP AND 1/2" ANGLE COMPRESSION SUPPLIES.
	SHOWER	MIXING VALVE AND SHOWER ASSEMBLY FURNISHED WITH SHOWER STALL.
	WASHING MACHINE SUPPLY AND DRAIN UNIT	GUY GRAY MODEL FB-200 WITH 1/2" HOT AND COLD WATER SUPPLIES AND 2" DRAIN.
		
	FLOOR SUPPLY REGISTERS	HART AND COOLEY 531 ALUMINUM FLOOR DIFFUSER WITH VOLUME DAMPER (2 EACH 14 X 4, 7 EACH 14 X 6)
	SIDEWALL REGISTERS	HART AND COOLEY A661 ALUMINUM DOUBLE DEFLECTION REGISTER WITH VOLUME DAMPER (3 EACH 14 X 6, 1 EACH 18 X 8)
	CEILING RETURN REGISTER	HART AND COOLEY REDS ALUMINUM GRID CORE REGISTER WITH VOLUME DAMPER (4 EACH 12 X 10, 3 EACH 8 X 6)

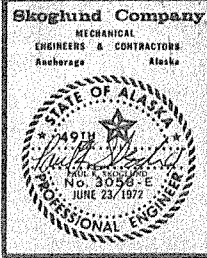


Skoglund
Company
Mechanical
Engineers & Contractors
ANCHORAGE
ALASKA

CONTRACTORS SHOP DRAWING
TANANA V.S.W. FACILITY
FOR
ARCTIC ENVIRONMENTAL ENGINEERS

MECHANICAL EQUIPMENT
SCHEDULES

JOB NO:
78286
DRAWN:
LS
CHECKED:
DATE:
7/28/78
SHEET: 38
H-5
OF 46


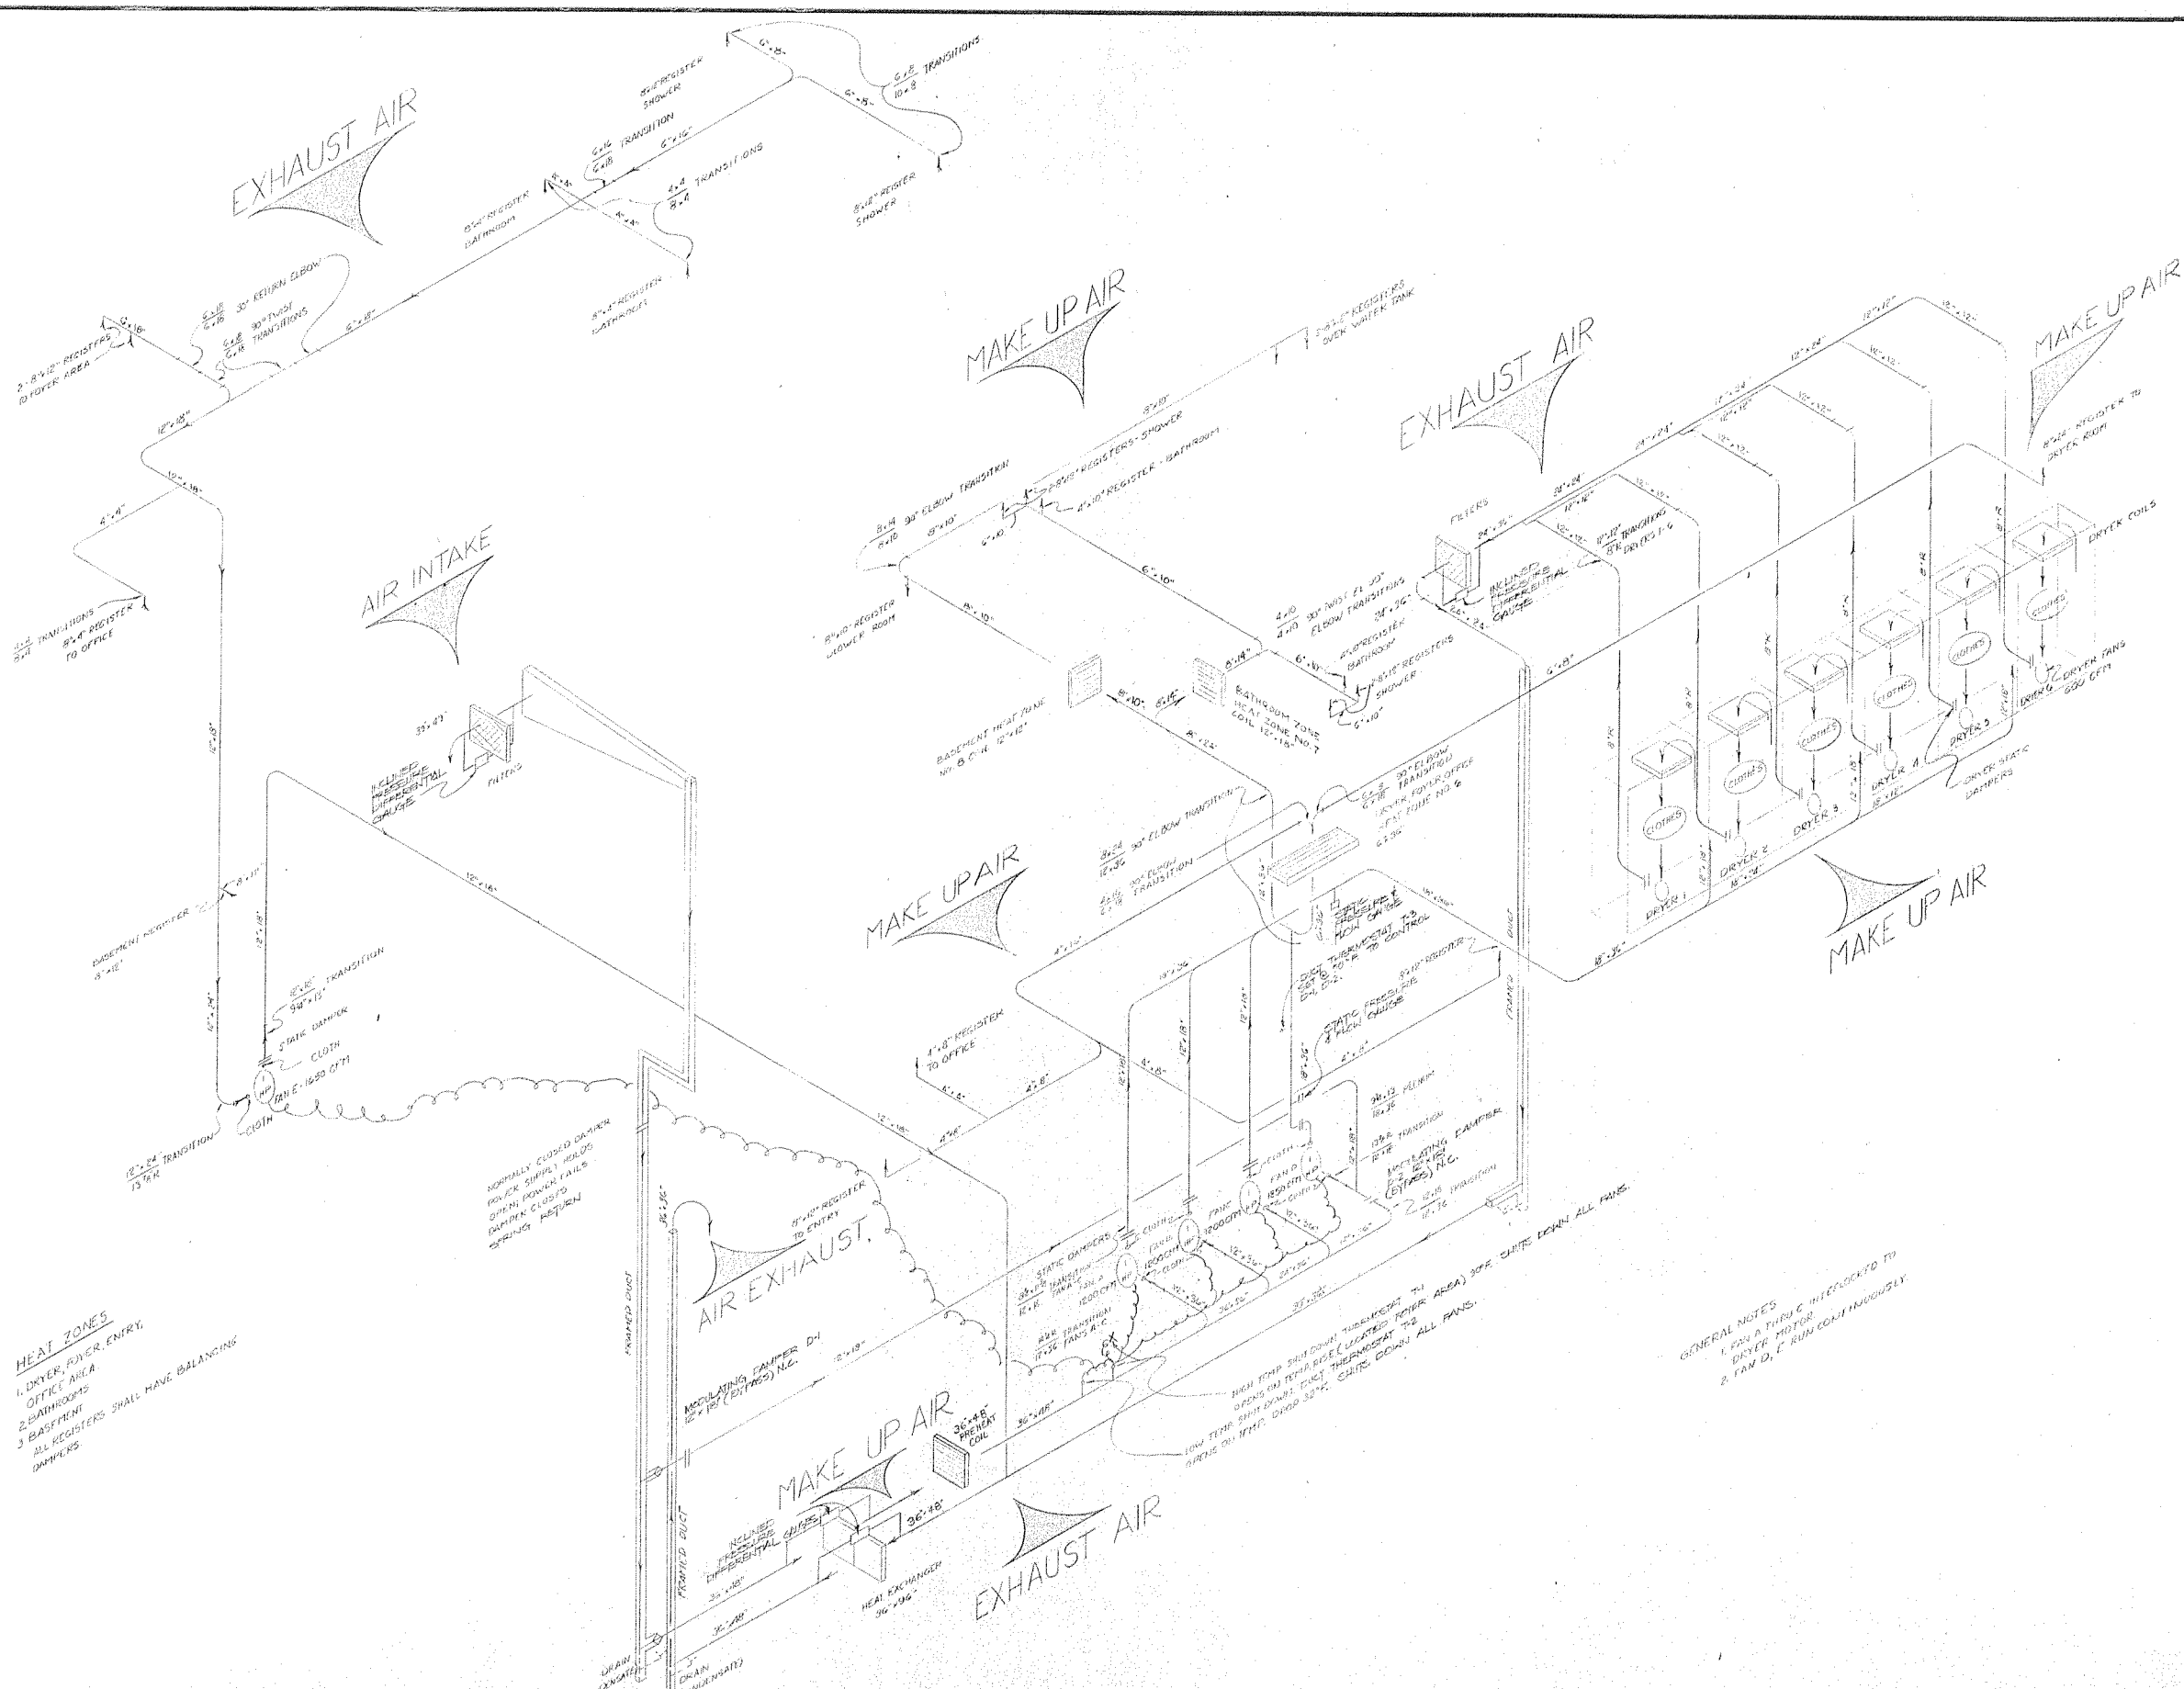


HEAT ZONES
 1. DRYER AREA
 2. BATHROOMS
 3. BASEMENT
 ALL REGISTERS SHALL HAVE BALANCING DAMPERS.

NORMALLY CLOSED DAMPER
 POWER SHUT OFF COILS
 OPENING DAMPER COILS
 DAMPER CLOSED
 DAMPER RETURN

GENERAL NOTES
 1. FAN A, B, C INTERLOCKED TO DRYER MOTOR.
 2. FAN D, E RUN CONTINUOUSLY.

2	ASBUILT	7-15-79	LM
1	SEE SKOGLUND DWG 7-15-79		
NO.	REVISION	DATE	BY

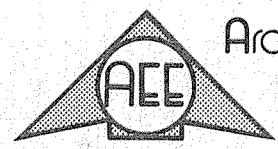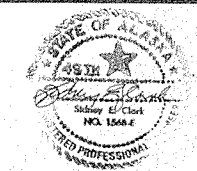


Arctic Environmental Engineers
 Anchorage, Alaska


PROJECT NO. 77-024-01 SAV
 DESIGNED : A.L.S.
 DRAWN : R.E.Z.
 CHECKED : W.S.V.H.
 DATE : MARCH 1978
 SCALE : N.T.S.

TANANA V.S.W. FACILITY
 HEATING & VENTILATING ISOMETRIC


H-6

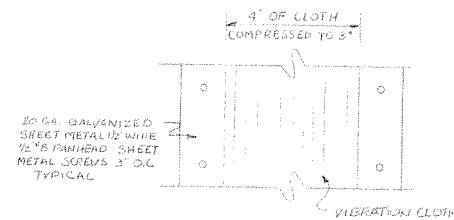

BLOWER VIBRATION CLOTH EXHAUST
& INTAKE TYPICAL ALL BLOWERS
SCALE: 1/2" = 1"

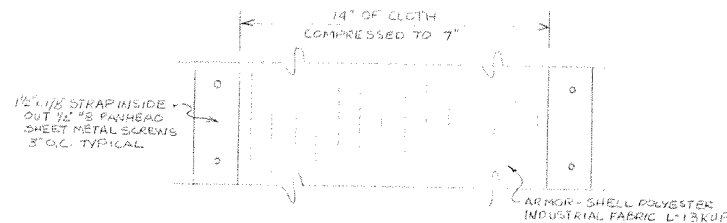


HEAT EXCHANGER EXPANSION JOINT
SCALE: 1/2" = 1"

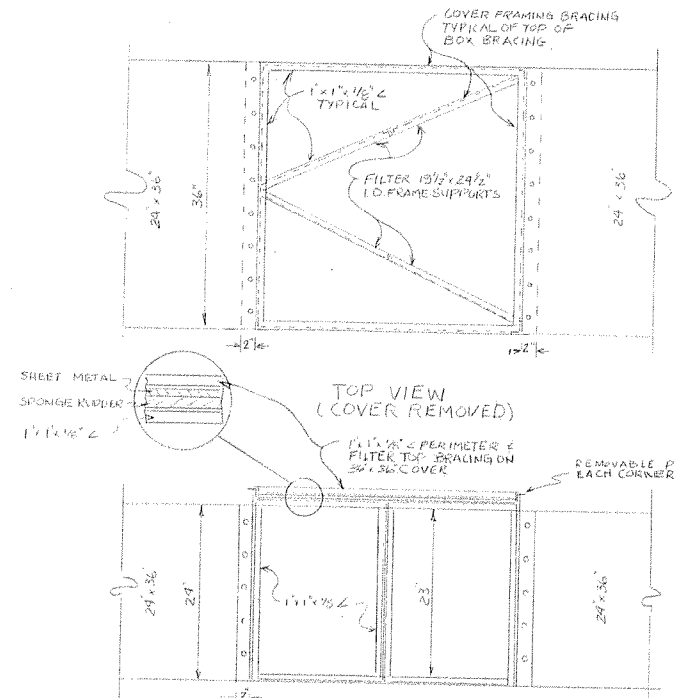


ELEVATION SECTION

DRYER EXHAUST FILTER
SCALE: 1" = 1'-0"

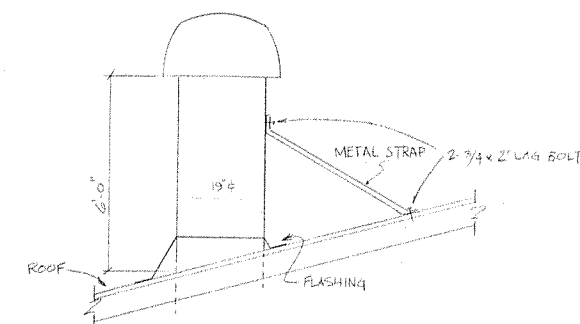

STACK DETAIL
NTS

I. ASBUILT		7-15-79	M
NO.	REVISION	DATE	BY






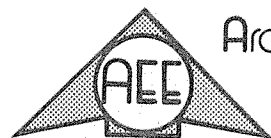


Arctic Environmental Engineers
Anchorage, Alaska

PROJECT NO. 77-024
DESIGNED: ALS
DRAWN: MP - REDRAWN
CHECKED:
DATE: AUG -79
SCALE: AS NOTED

TANANA V.S.W. FACILITY
ATTIC & BASEMENT HEATING & VENTILATION
DETAILS

H-7

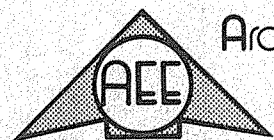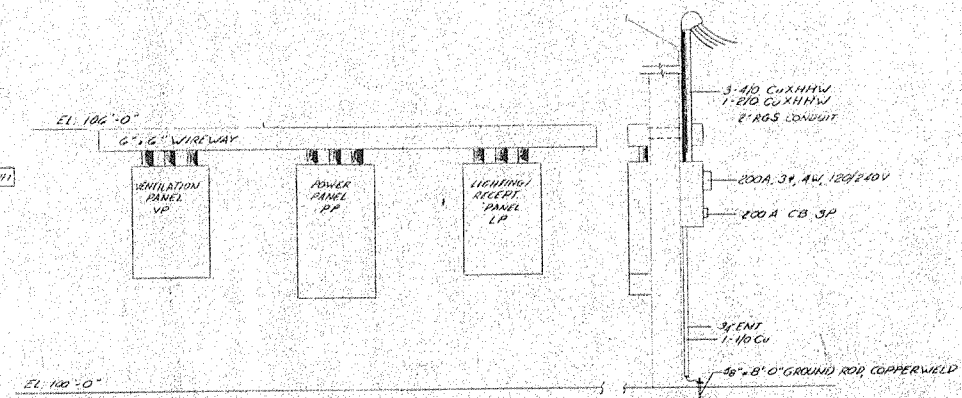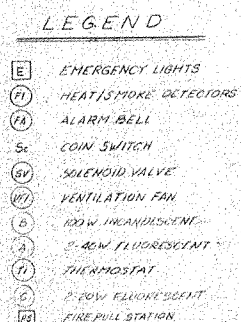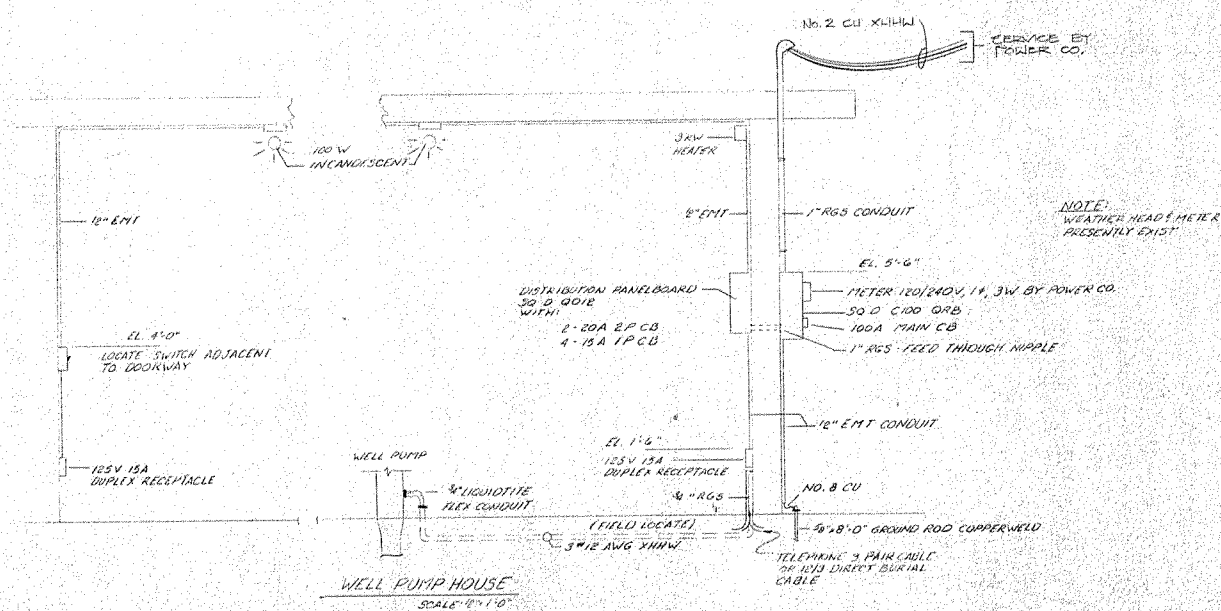
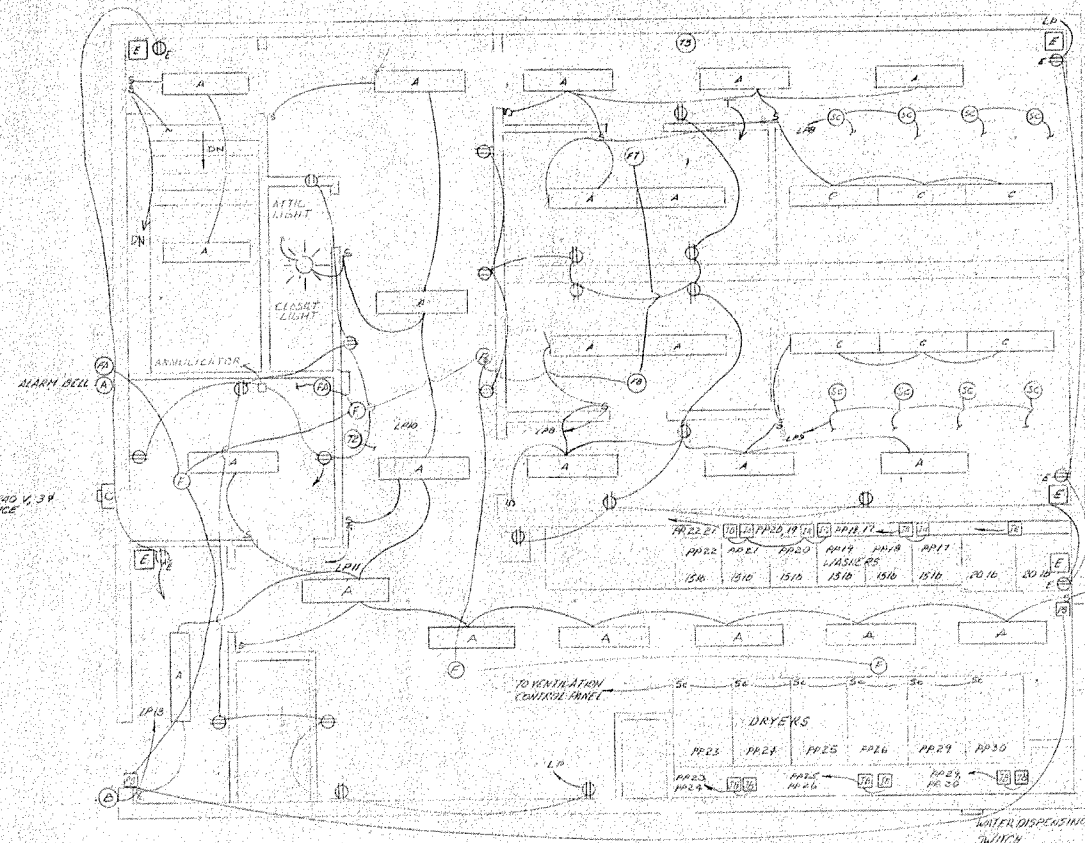
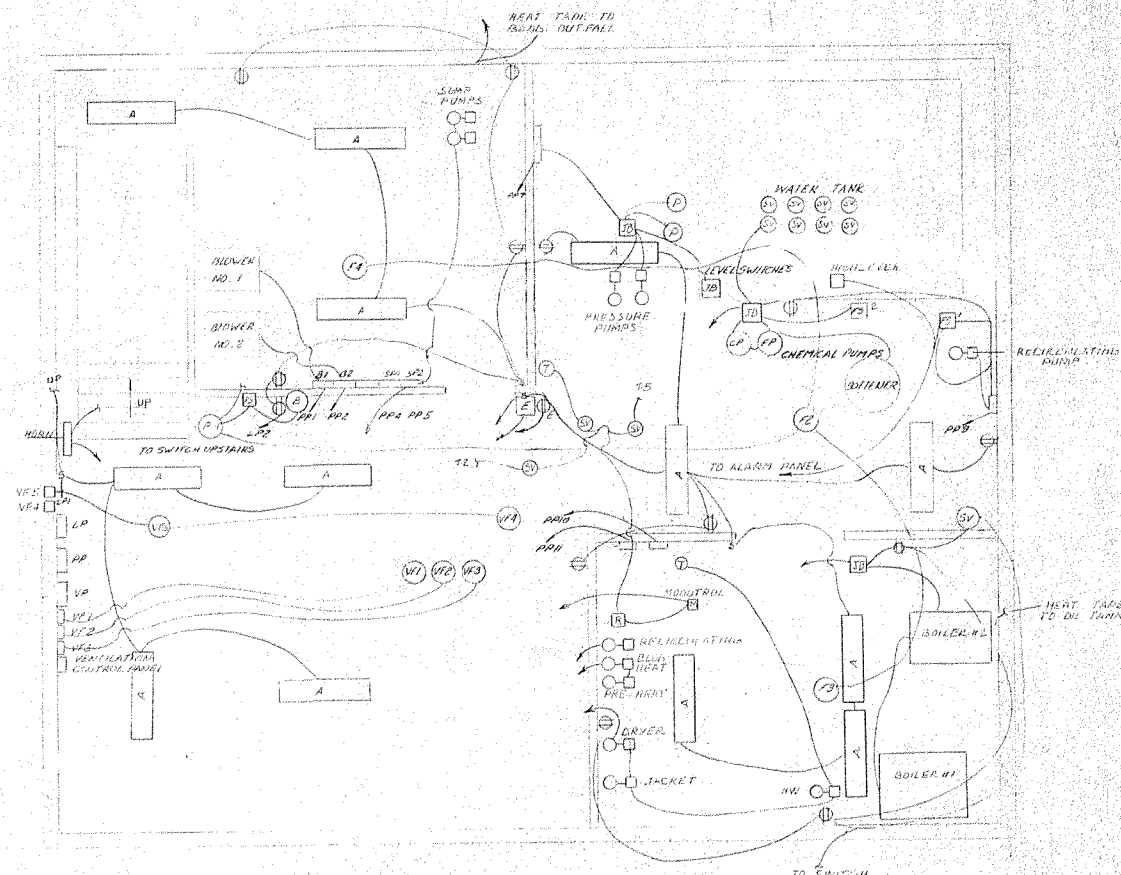


Arctic Environmental Engineers
Anchorage, Alaska




PROJECT NO. 77-024-01 SAY
DESIGNED : JAM
DRAWN : PEZ
CHECKED : W S V H
DATE : MARCH 1978
SCALE : AS NOTED

TANANA V.S.W. FACILITY
ELECTRICAL LAYOUT & DETAILS



SHEET 41 OF 47

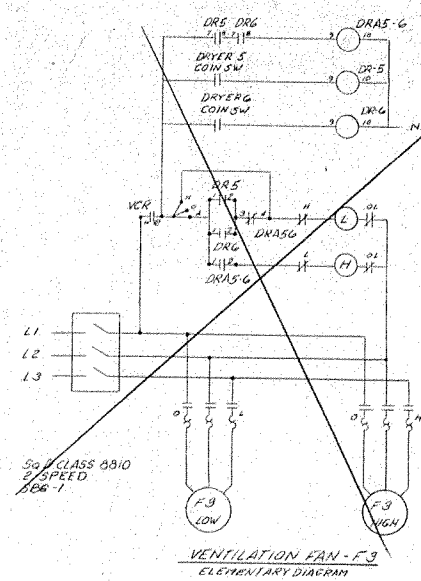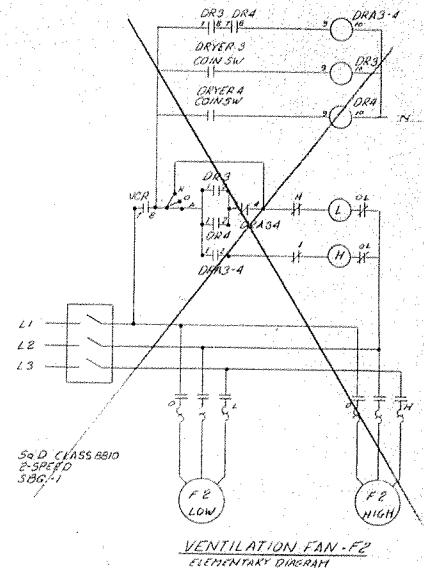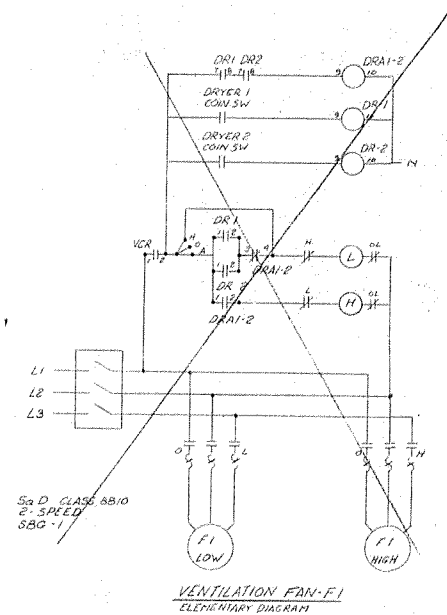

NOTE: FANS ARE ONE SPEED. EACH FAN IS CONNECTED TO TWO DRYERS AND IF EITHER OR BOTH DRYERS ARE TURNED ON, THE FAN OPERATES.

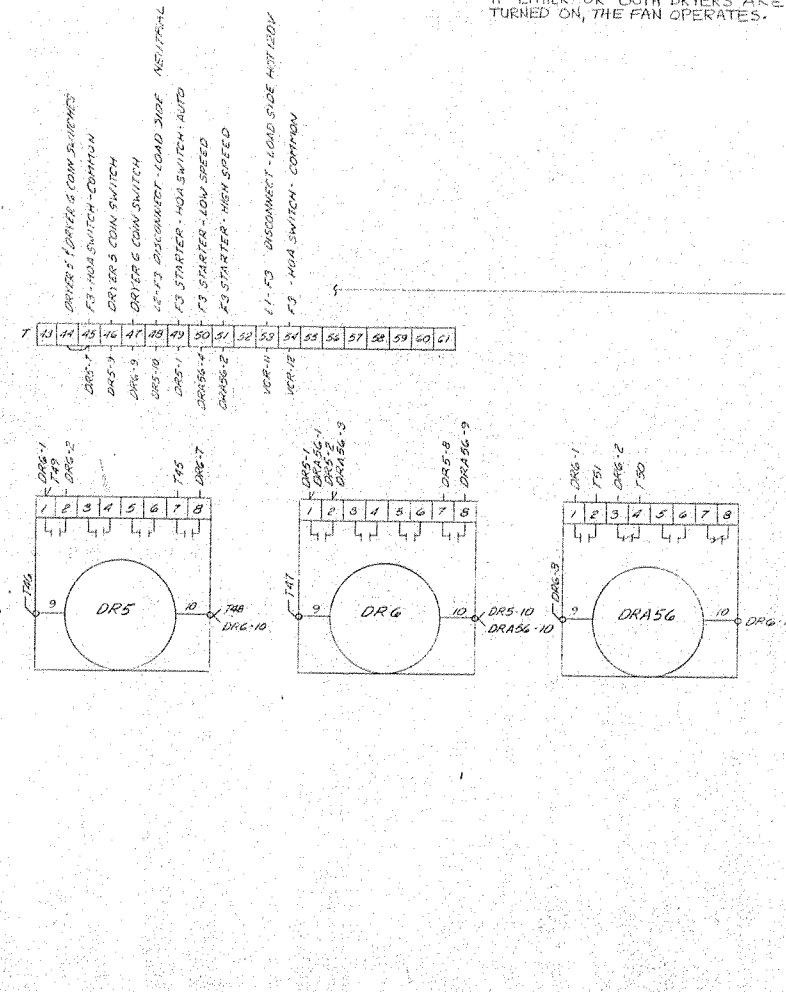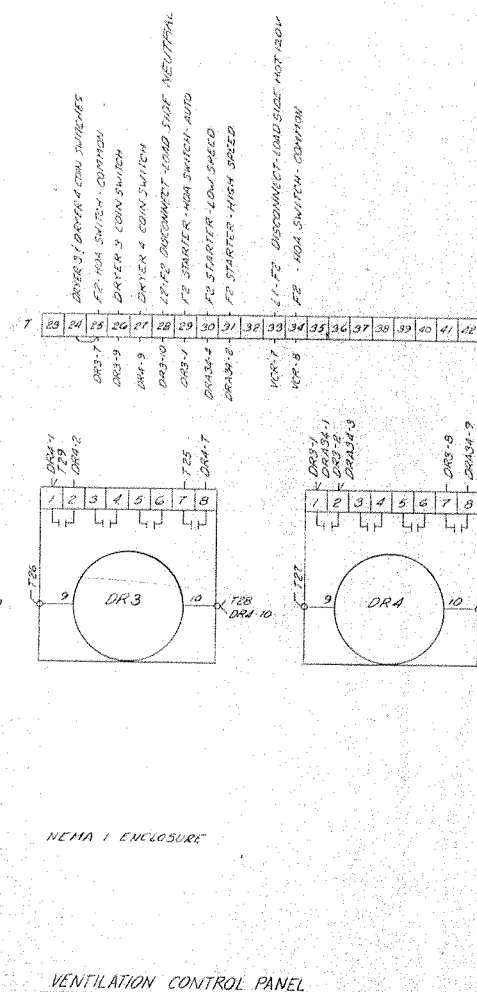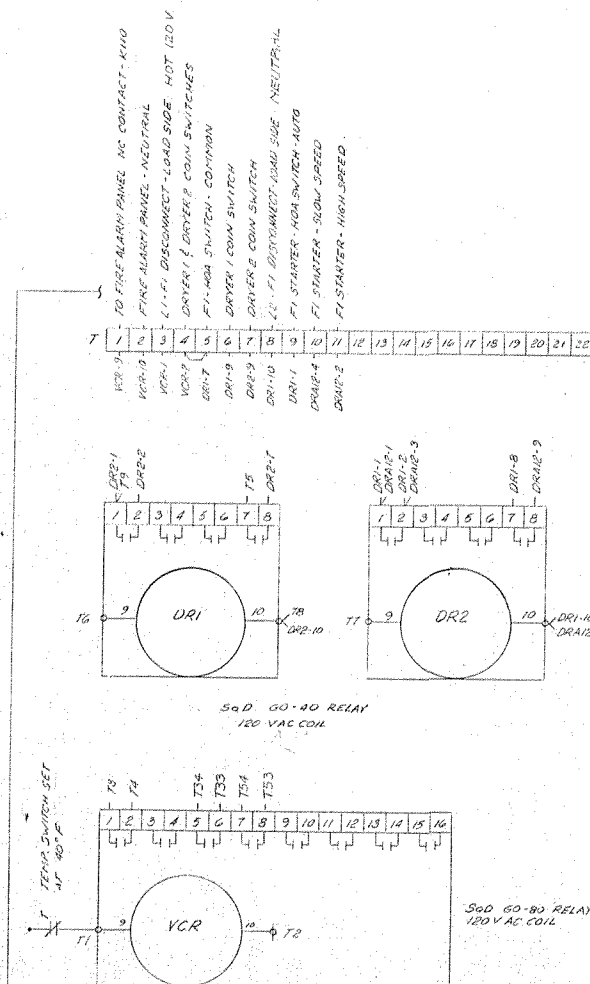

1 ASSEMBLY SEE 8 1/2 X 11 DETAIL SHEET 115 1/2
NO. REVISION DATE BY

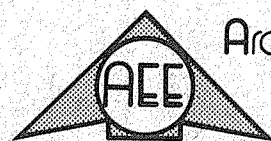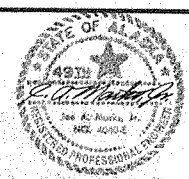

Arctic Environmental Engineers
Anchorage, Alaska


PROJECT NO. 77-029-01 SAV
DESIGNED: J.A.M.
DRAWN: P.E.L.
CHECKED: J.A.M.
DATE: MARCH 78
SCALE: N.T.S.

TANANA V.S.V. FACILITY
ELEMENTARY & INTERCONNECTION DIAGRAMS
VENTILATION SYSTEM

E-3


SHEET 43 OF 47

SEWAGE PUMPS DIAGRAM

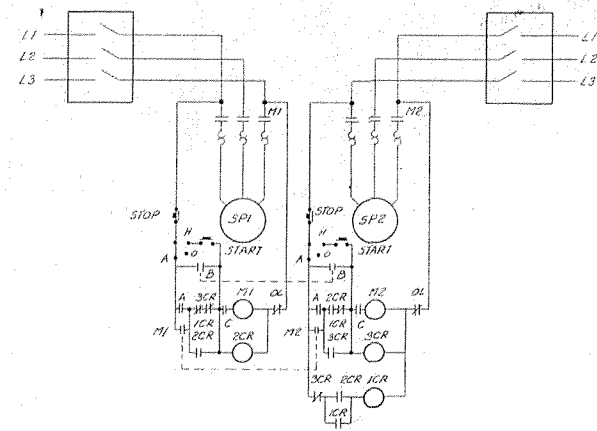


A - HIGH LEVEL SWITCH
B - HIGH LEVEL OVERRIDE SWITCH
C - LOW LEVEL SHUTOFF SWITCH

PRESSURE PUMPS 1 & 2 DIAGRAM

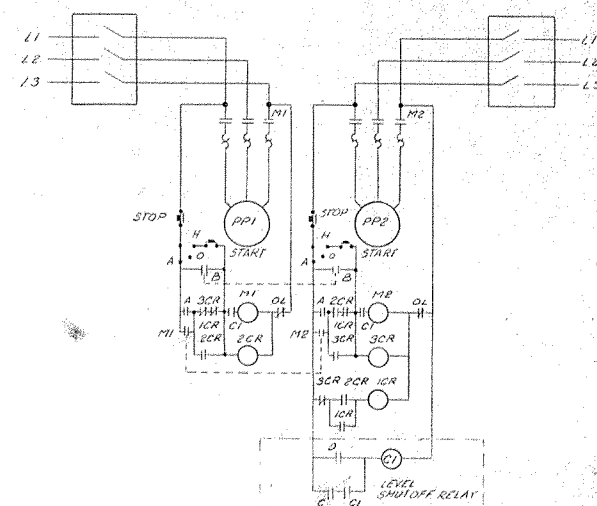



A - LOW PRESSURE SWITCH
B - LOW PRESSURE OVERRIDE SWITCH
C - LOW LEVEL SHUTOFF SWITCH
D - LOW LEVEL START SWITCH

WELL PUMP DIAGRAM

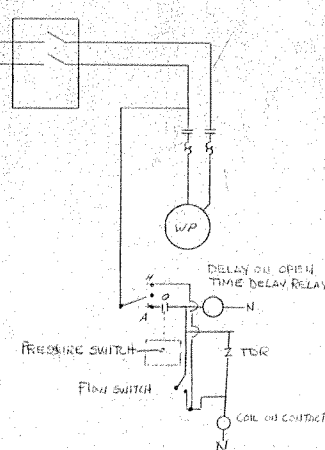


MAIN BUILDING

RECIRCULATING PUMP DIAGRAM

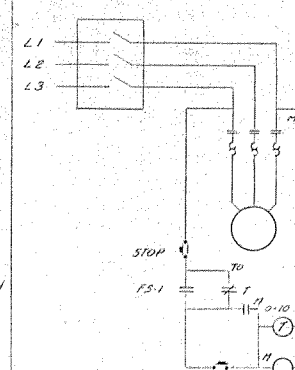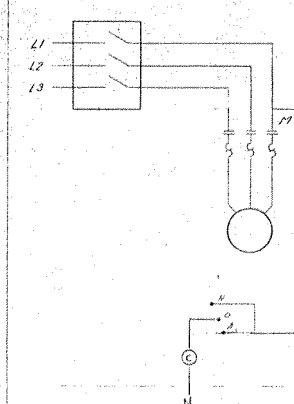
BLOWER DIAGRAM
B1, B2, B3

VENTILATION FANS F1 & F2

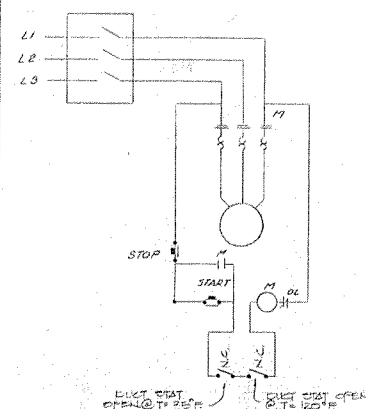


DUCT THAT OPEN @ 2" H₂O
DUCT THAT OPEN @ 1" H₂O

CHLORINE PUMP

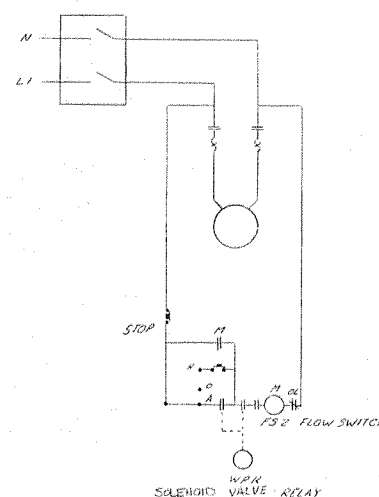


WATER SOLENOID VALVE RELAY

FLUORIDE PUMP

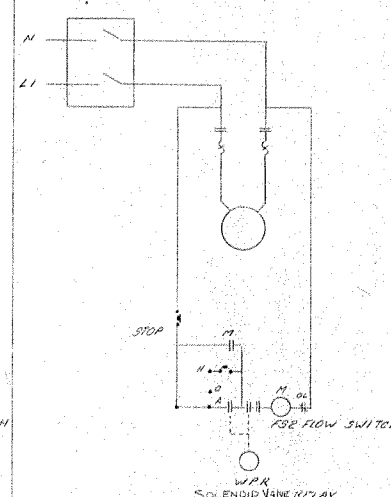


WATER SOLENOID VALVE RELAY

WATER TANK SOLENOID VALVE


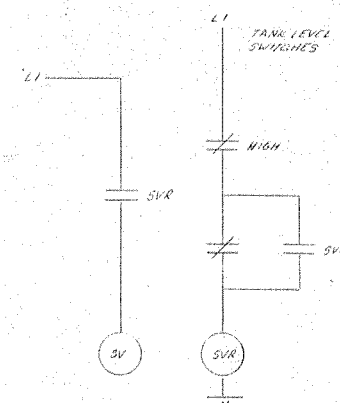


OIL DAY TANK LEVEL SWITCH

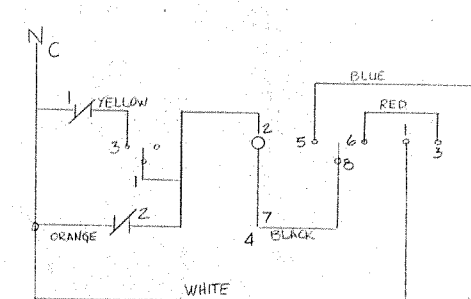

NOTE:
SEE 8 1/2 x 11 IN O&M MANUAL FOR
COMPLETE CONTROL WIRING SCHEMATICS

2 SEE 8 1/2 x 11 IN O&M MANUAL FOR CONTROL DIA
1 AS BUILT
NO. REVISION DATE BY

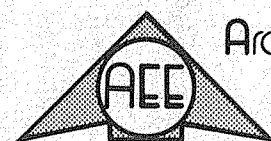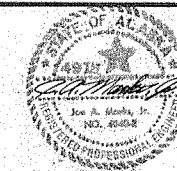


Arctic Environmental Engineers
Anchorage, Alaska

PROJECT NO. 77-029-01 SAV
DESIGNED: J.A.M.
DRAWN: P.E.L.
CHECKED: J.A.M.
DATE: MARCH 1978
SCALE: N.T.S.


TANANA V.S.V. FACILITY
MISCELLANEOUS ELECTRICAL DIAGRAMS

E-4

SHEET 44 OF 47

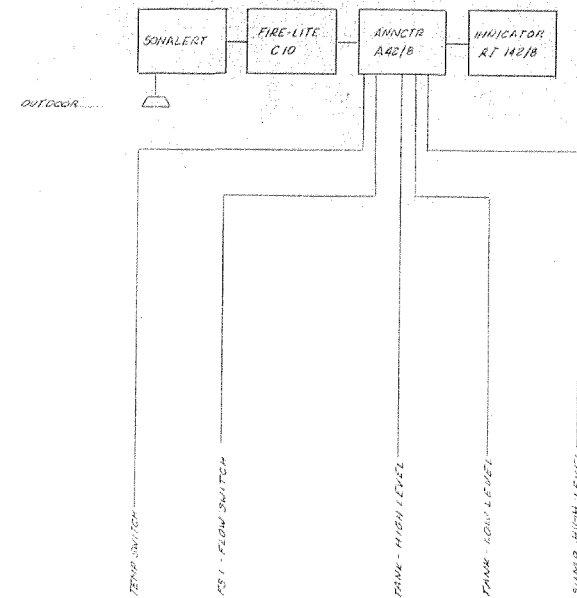



ALARM ANNUNCIATOR

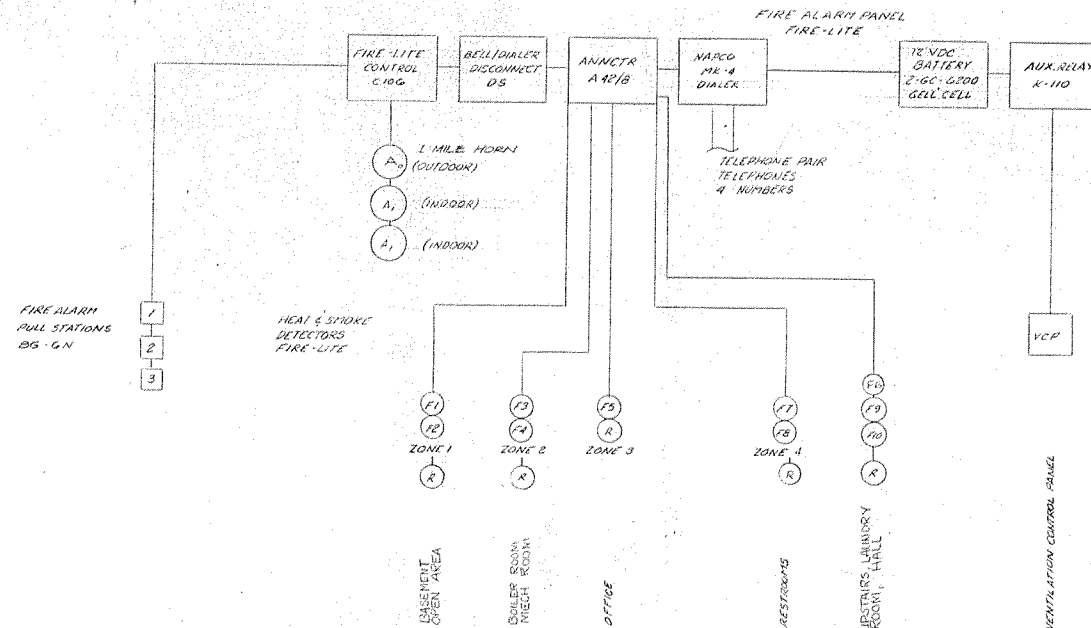

FIRE-LITE SYSTEM
FIRE ALARM SYSTEM DIAGRAM

- F1 - SD (SMOKE DETECTOR)
 F2 - SD
 F3 - HD (HEAT DETECTOR)
 F4 - SD
 F5 - SD
 F6 - SD
 F7 - HD
 F8 - HD
 F9 - SD
 F10 - SD
 R - SOLV. END OF LINE RESISTOR
 I - BS-GN
 A₁ - BD10-12VDC-WP
 A₂ - BD10-12VDC
 A₃ - SOLR/12

01	ASBUNT	7-15-79	MP
NO.	REVISION	DATE	BY

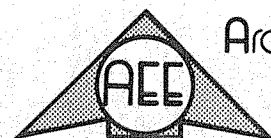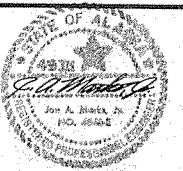


Arctic Environmental Engineers
Anchorage, Alaska


PROJECT NO. 77-029-01 SAV
 DESIGNED : J.A.M.
 DRAWN : P.E.L.
 CHECKED : J.A.M.
 DATE : MARCH 1978
 SCALE : N.T.S.

TANANA V.S.W. FACILITY
FIRE ALARM PANEL & MISCELLANEOUS DETAILS


E-5

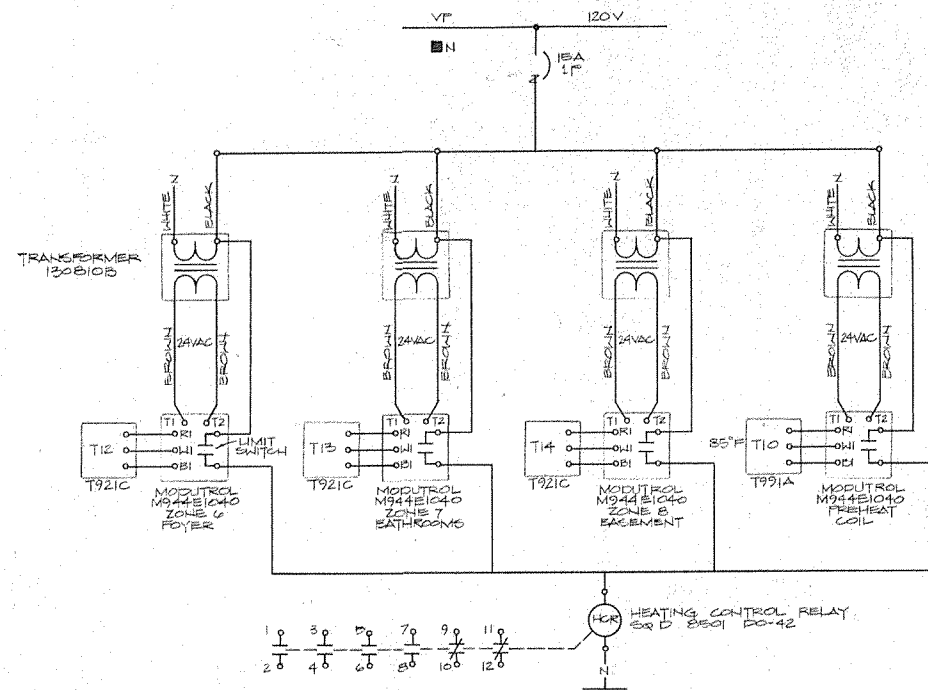


ZONE 6,7,8 AND PREHEAT COIL CONTROL DIAGRAM
NTS

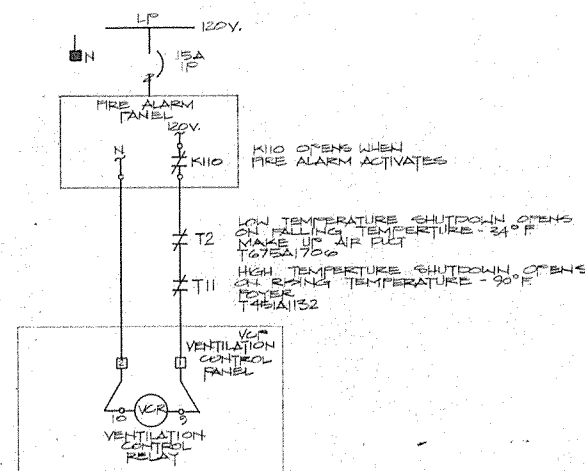


VENTILATION - FIRE ALARM
INTERLOCK DIAGRAM
NTS

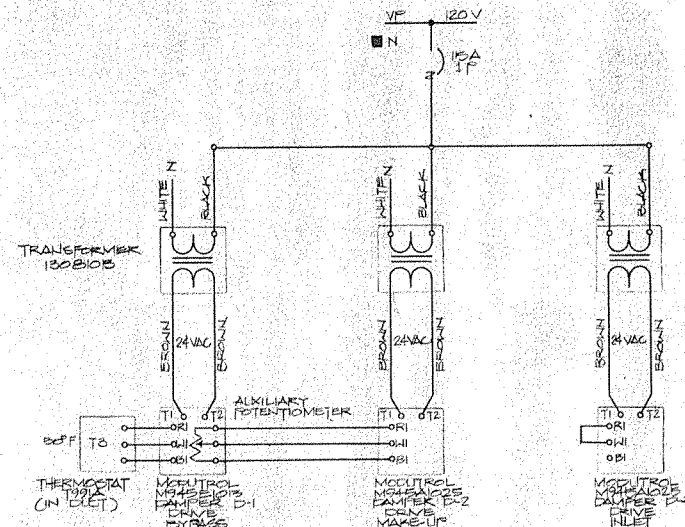


DAMPER CONTROL DIAGRAM
NTS

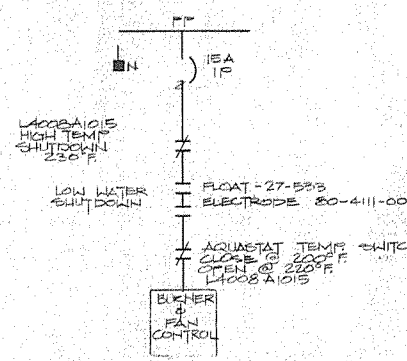


BOILER No. 1 & No. 2
NTS

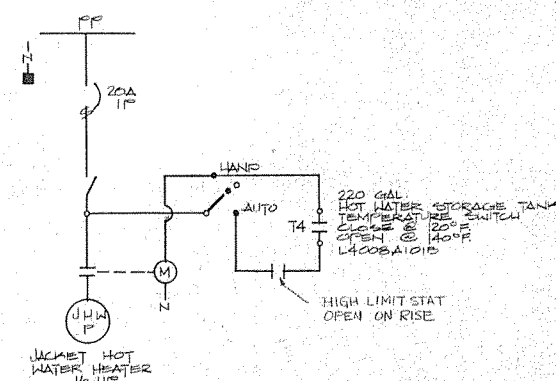


JACKET HOT WATER PUMP
CONTROL DIAGRAM
NTS

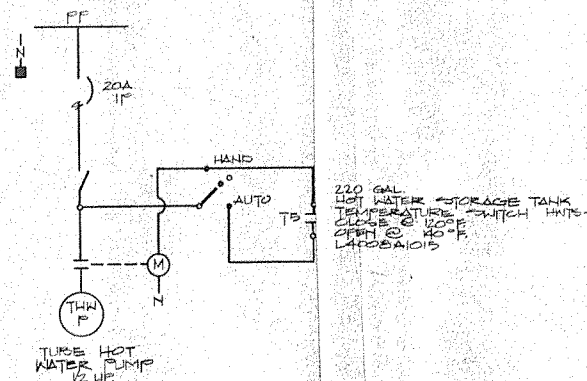

TUBE HOT WATER PUMP
CONTROL DIAGRAM
NTS

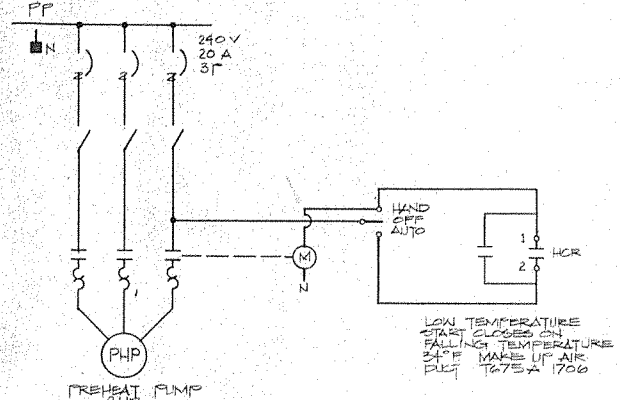


PREHEAT PUMP CONTROL DIAGRAM

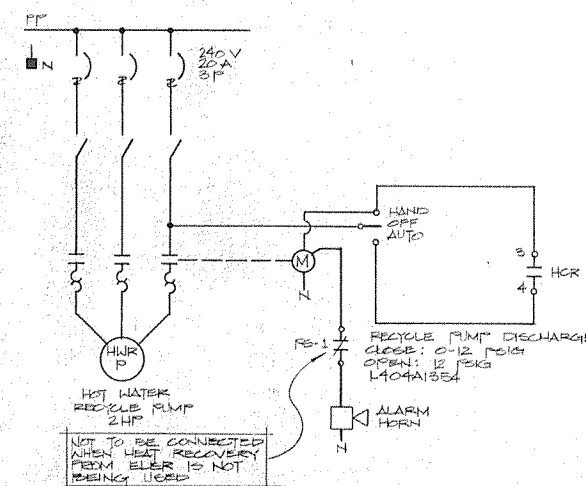

HOT WATER RECYCLE PUMP CONTROL DIAGRAM
NTS

NOTE: SEE 8 1/2" IN OEM MANUAL FOR COMPLETE CONTROL WIRING SCHEMATIC

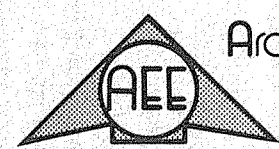


Arctic Environmental Engineers
Anchorage, Alaska

PROJECT NO. 77-02A-01 DAV
DESIGNED: J.A.M.
DRAWN: J.A.M.
CHECKED: J.A.M.
DATE: OCTOBER 4, 1978
SCALE: N.T.S.


TANANA V.S.W. FACILITY
HEATING & VENTILATION
CONTROL DIAGRAMS

E-6


SHEET 46 OF 47

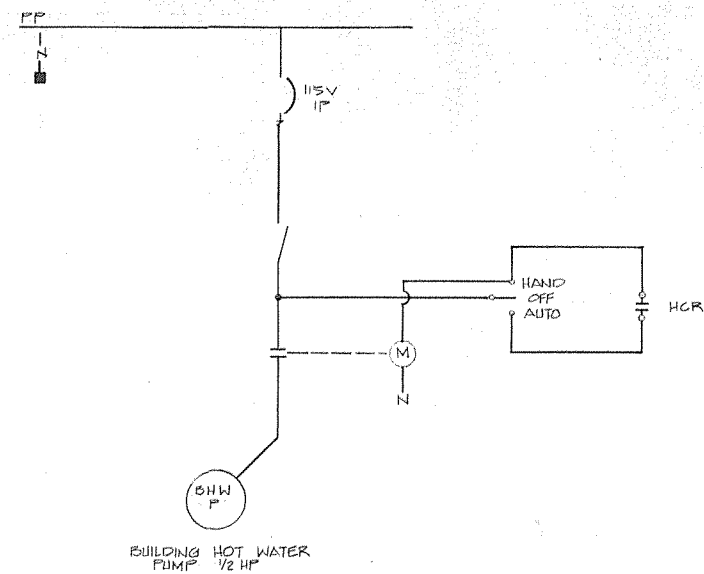

BUILDING HOT WATER PUMP CONTROL DIAGRAM

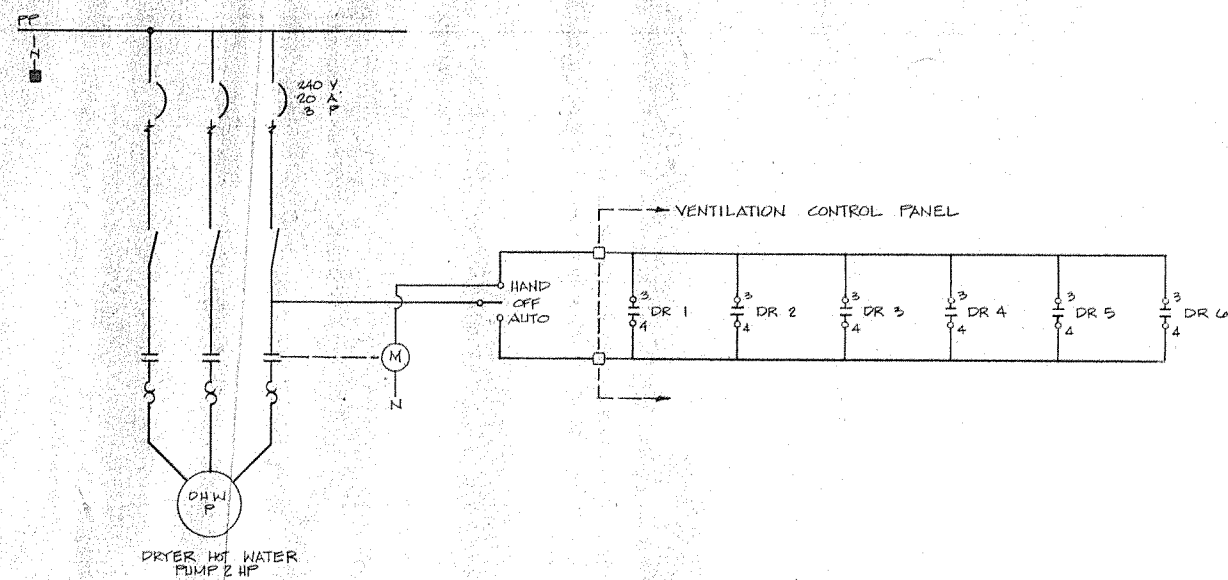


DRYER HOT WATER PUMP CONTROL DIAGRAM

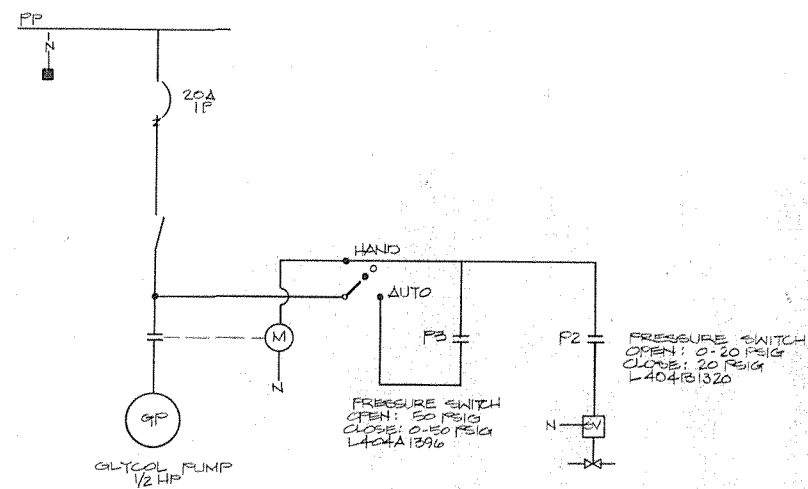

GLYCOL PUMP CONTROL DIAGRAM

NOTE:
SEE 8 1/2 x 11" IN O&M MANUAL
FOR COMPLETE CONTROL
WIRING SCHEMATIC

1	ASBULT	7-15-79	M
NO.	REVISION	DATE	BY

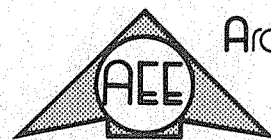


Arctic Environmental Engineers
Anchorage, Alaska

PROJECT NO. 77-024-01 EAW
DESIGNED: J.A.M.
DRAWN: L.D.M.
CHECKED: J.A.M.
DATE: OCTOBER 4, 1978
SCALE: N.T.S.


TANANA V&W FACILITY
HEATING & VENTILATION
CONTROL DIAGRAMS

E-7

SHEET 47 OF 47

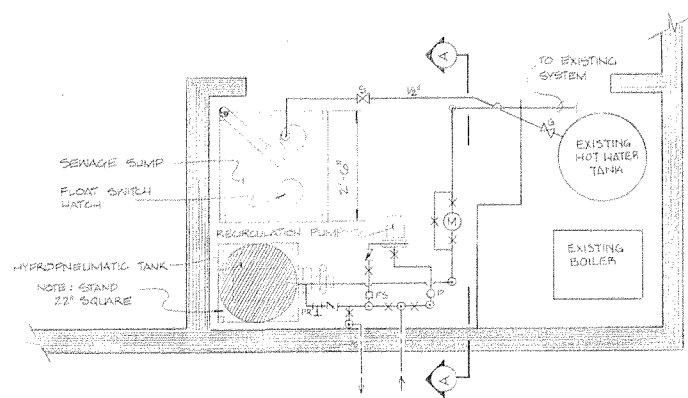

PLAN VIEW

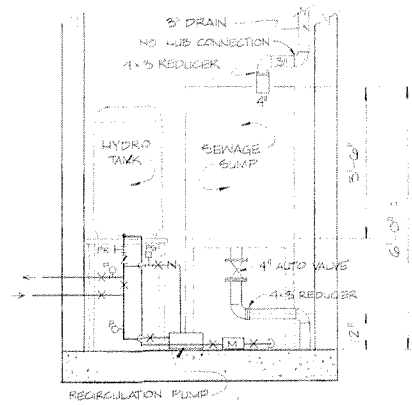


SECTION A-A

FIRE STATION PLUMBING IMPROVEMENTS

SCALE: 1/4" = 1'-0"


LEGEND

- THERMOMETER
- PRESSURE GAUGE
- FS. FLOW SWITCH
- PRV. PRESSURE REDUCING VALVE
- GLOBE VALVE
- SOLENOID VALVE

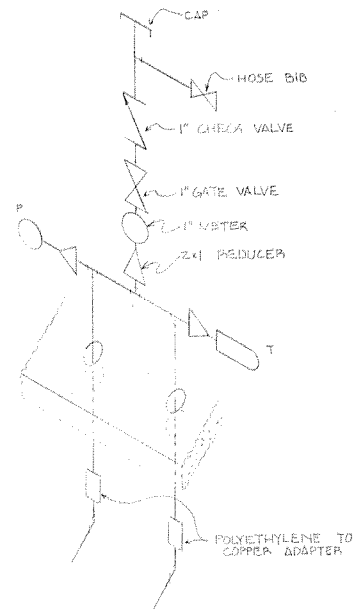


CITY BUILDING WATER SYSTEM

NTS

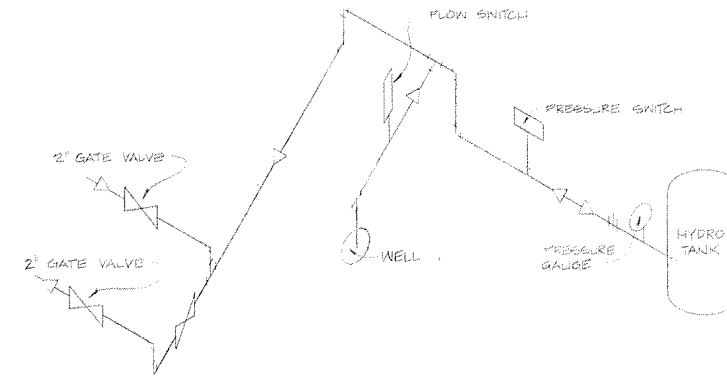

EXISTING WELL HOUSE WATER SYSTEM


NTS

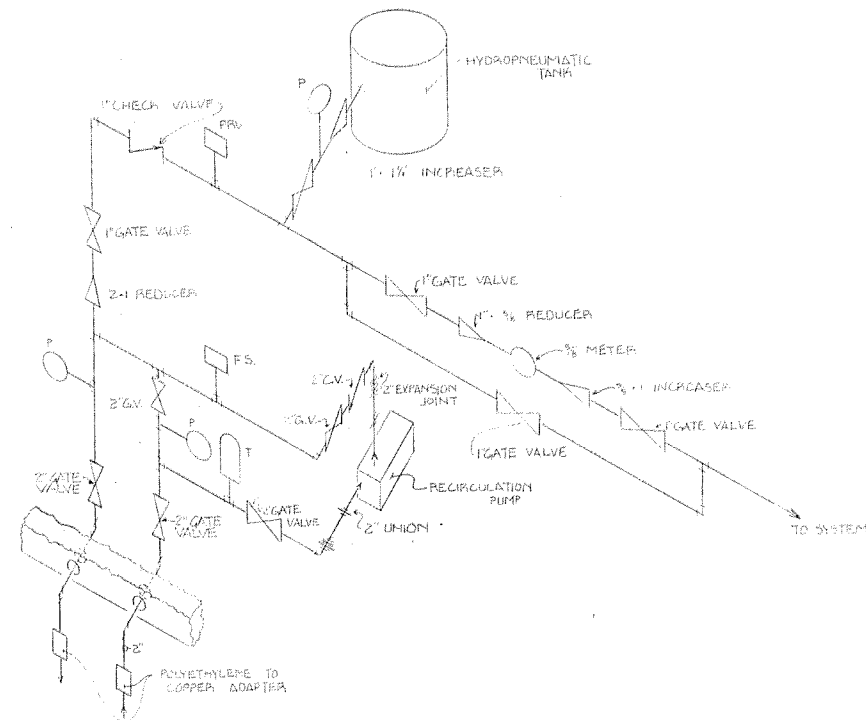

FIRE STATION WATER SYSTEM


NTS

NO.	REVISION	DATE	BY
3	DELETION OF -S&T TRADE DATA - 11-14-75	5Z	
2	AS BUILT ON CITY BUILDING WATER SYSTEM 11-14-75	5Z	
1	AS BUILT ON FIRE STATION PLUMBING 11-14-75	5Z	

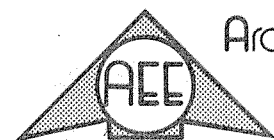

Arctic Environmental Engineers
Anchorage, Alaska


PROJECT NO. 79-010-TWS
DESIGNED: F.W.V.H.
DRAWN: B.D.L.
CHECKED: S.E.C.
DATE: AUG 4, 1979
SCALE: AS SHOWN

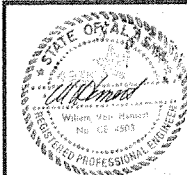

CITY OF TANANA
WATER & SEWER EXTENSION
CITY BUILDING-FIRE STATION

S-2

SHEET 2 OF 3

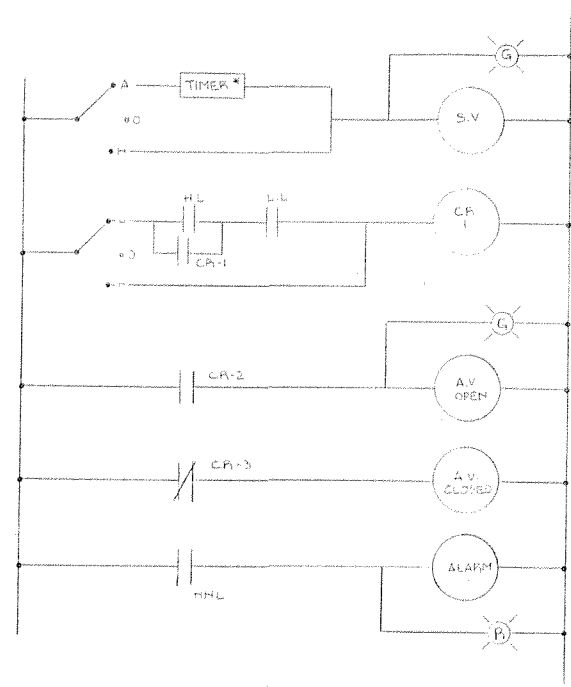


* 2 HR. TIME INCREMENTS

OPERATION

- (A) SOLENOID VALVE - SOLENOID VALVE IS ACTUATED BY A 24HR. TIMER AND FEEDS HOT WATER INTO THE SEWAGE TANK. FLOW RATE IS CONTROLLED BY A GLOBE VALVE.
- (B) AUTOMATIC VALVE - WHEN THE TANK FILLS TO THE HIGH LEVEL FLOAT, CR1 IS ACTIVATED, CAUSING THE VALVE TO OPEN. WHEN THE LOW LEVEL IS REACHED, CR1 IS DE-ENERGISED AND THE VALVE IS CLOSED THROUGH A NORMALLY CLOSED CONTACT.
- (C) IF THE HIGH LEVEL FLOAT IS REACHED AN ALARM IS ACTIVATED.


SEWAGE SYSTEM CONTROLS

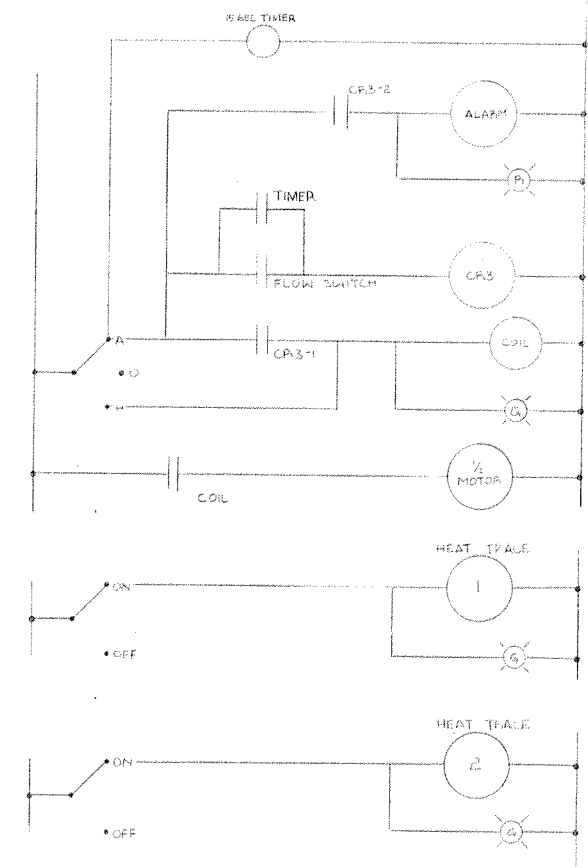

OPERATION:

- (A) REGULATION PUMP - IN AUTOMATIC PUMP IS PROTECTED WITH A FLOW SWITCH. WHEN PUMP IS TURNED ON, A SECOND TIMER ALLOWS FLOW TO BEGIN. ON HAND THE FLOW SWITCH IS BY-PASSED, PUMP RUNS CONTINUOUSLY.
- (B) HEAT TRACE - OPERATED BY ON-OFF SWITCH AND PLUG IN.

WATER SYSTEM CONTROLS

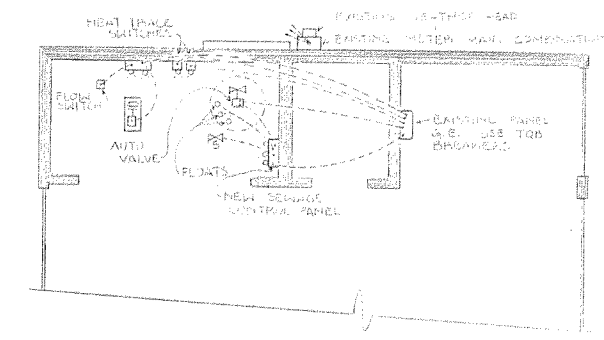

ELECTRICAL DIAGRAM

	NO. BREAKERS	SIZE	VOLTS	WIRE SIZE
WATER PUMP	1	24/2	240/40	10
SEWAGE CONTROLS	1	15/1	120	12
AUTOMATIC VALVE	1	15/1	120	12

NO.	REVISION	DATE	BY
-----	----------	------	----



Arctic Environmental Engineers
Anchorage, Alaska


PROJECT NO. 7-00-JWS
DESIGNED: W.V.H.
DRAWN: S.D.L.
CHECKED: S.E.L.
DATE: AUG 4, 1979
SCALE: AS SHOWN




CITY OF TANANA
WATER & SEWER EXTENSION
CITY BUILDING - FIRE STATION

S-3


SHEET 3 OF 3

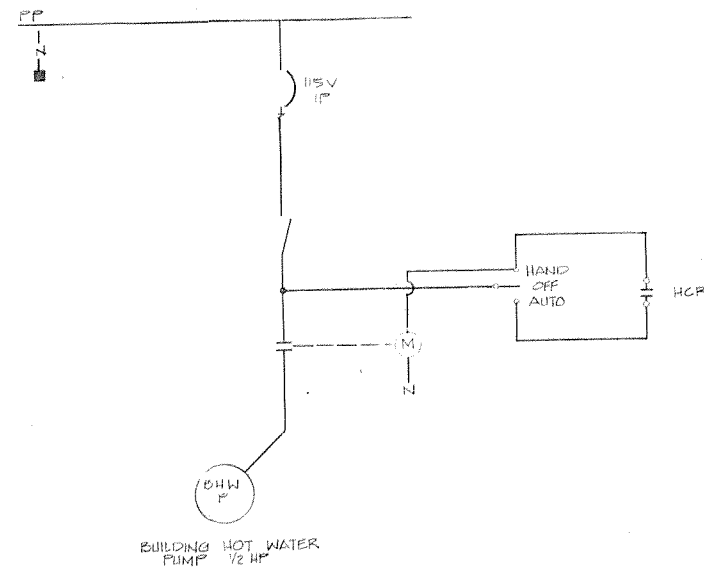


BUILDING HOT WATER PUMP CONTROL DIAGRAM

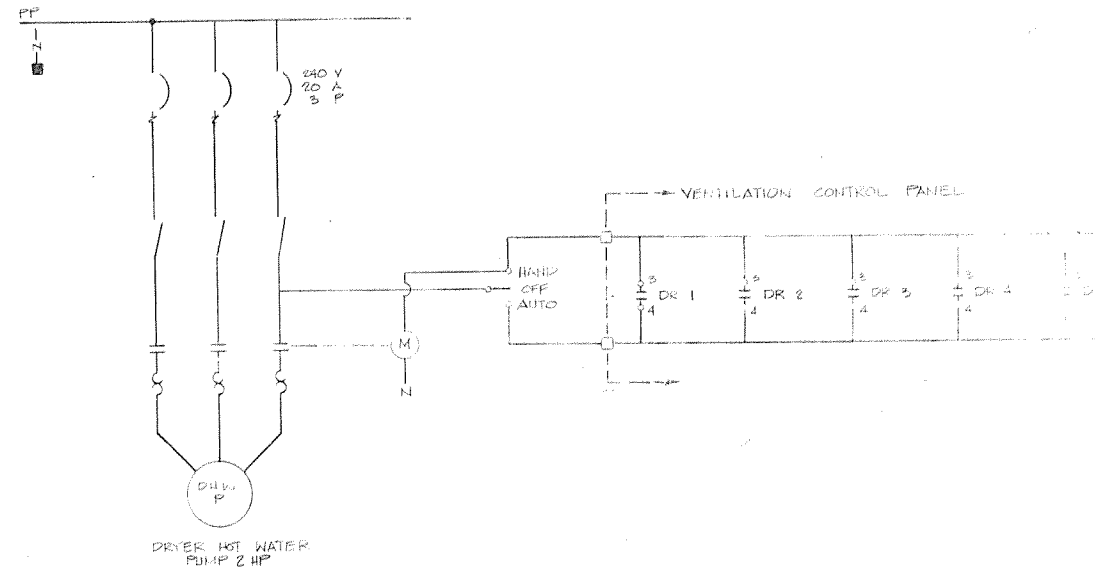

DRYER HOT WATER PUMP CONTROL DIAGRAM

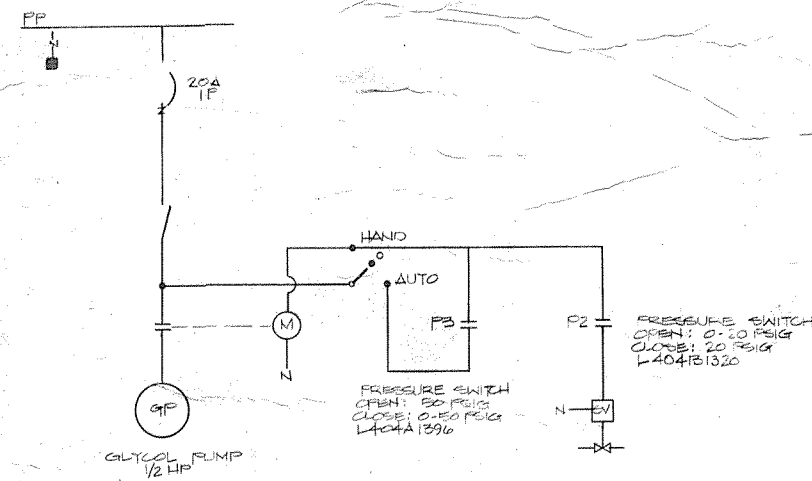

GLYCOL PUMP CONTROL DIAGRAM

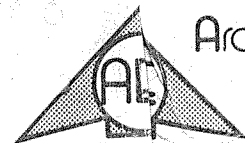

Arctic Environmental Engineers
Anchorage, Alaska


PROJECT NO. 77-08-01
DESIGNED: JAM
DRAWN: JAM
CHECKED: JAM
DATE: OCTOBER 1, 1978
SCALE: NTS

TANANA VS. WITKIN

SP/ACC/50
15 LAC/50
15 RAR/50
15 LAR/00
RAR/50
LAR/50
RER/50
LAR/50
15 RAR/50
15 LAR/00
RAR/50
LAR/50
SP/ACC/50



FRAME FOUR ION 8
BOLT HOLE $\pm 1/4"$ [6]
NOZZLE FACE DIM.

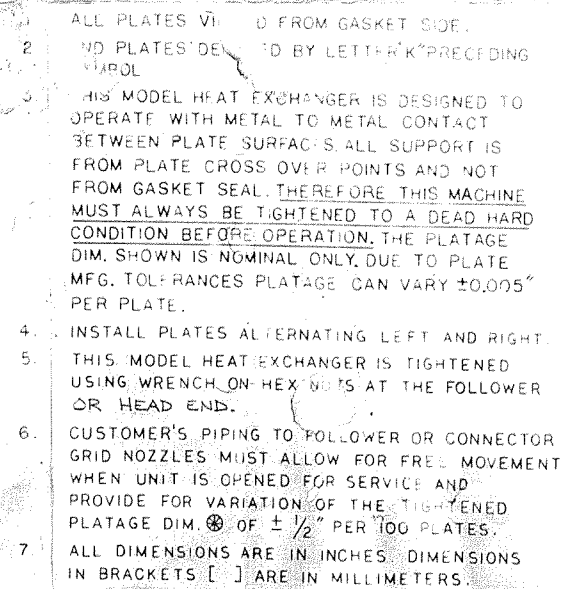

LIST OF PLATES:	1 - 10
TOTAL "L" PLATES:	10
TOTAL "R" PLATES:	10

30-LIA/00
1-LAF/50
-LAC/50
1-LFA/50
1-LAT/50

MODEL SR 50
HEAT EXCHANGER

	DATE	REVISION
E		
D		
C		
B		
A		

FRAME 57

MAX. OPERATING PRESSURE: 150 PSI.
 * PLATE FLOW: 15 INCHES
 VOL. OF PRO. 101: 30 GALS.
 WT. OF MACHINE DRY: 225 LBS.
 WT. OF MACHINE FLO. 101: 335 LBS.
 FITTINGS: 4 PL. 1/4"
 STUDS: 4 PL. 1/4"
 LBS. 100
 TIE RODS: 4 PL. 1/4"

EQUIPMENT, INC.
395 FILLMORE AVE.
TELEPHONE 4-1111