


TULUKSAK, ALASKA

2003 HONEY BUCKET DISPOSAL FACILITY

PREPARED FOR THE
TULUKSAK NATIVE COMMUNITY

In Cooperation with the State of Alaska
Department of Environmental Conservation
Village Safe Water Program

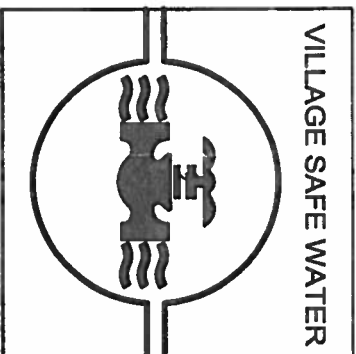

RECORD DRAWING CERTIFICATE


THESE DRAWINGS REFLECT RECORDED
INFORMATION OBTAINED DURING
CONSTRUCTION.
INFORMATION PROVIDED HEREIN IS
ACCURATE TO THE BEST OF MY
KNOWLEDGE.



NAME _____ DATE _____



CE 2
CONSULTING ENGINEERS
ANCHORAGE, ALASKA

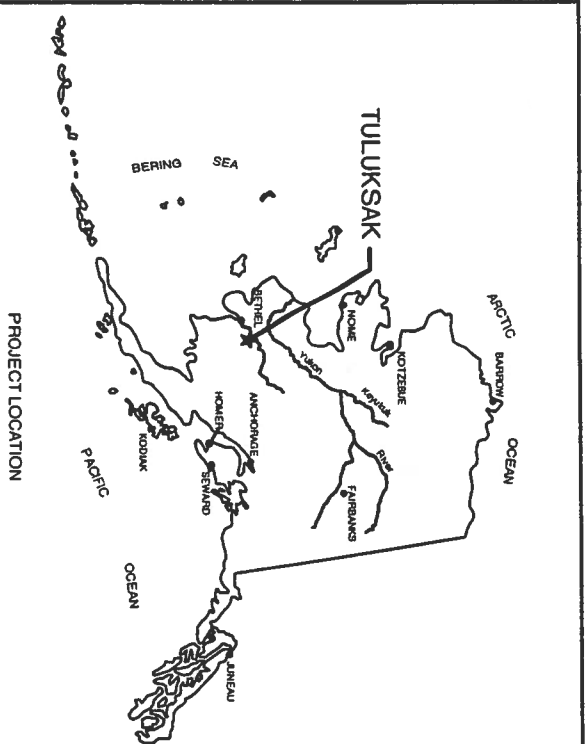

Location Map

Consultant

SHEET INDEX

No. Title

- G-1 COVER SHEET
- S-1 VICINITY MAP, NOTES, SITE PLAN, FENCE
- C-1 HONEY BUCKET DISPOSAL PIT
- C-1 SOIL LOG DATA